
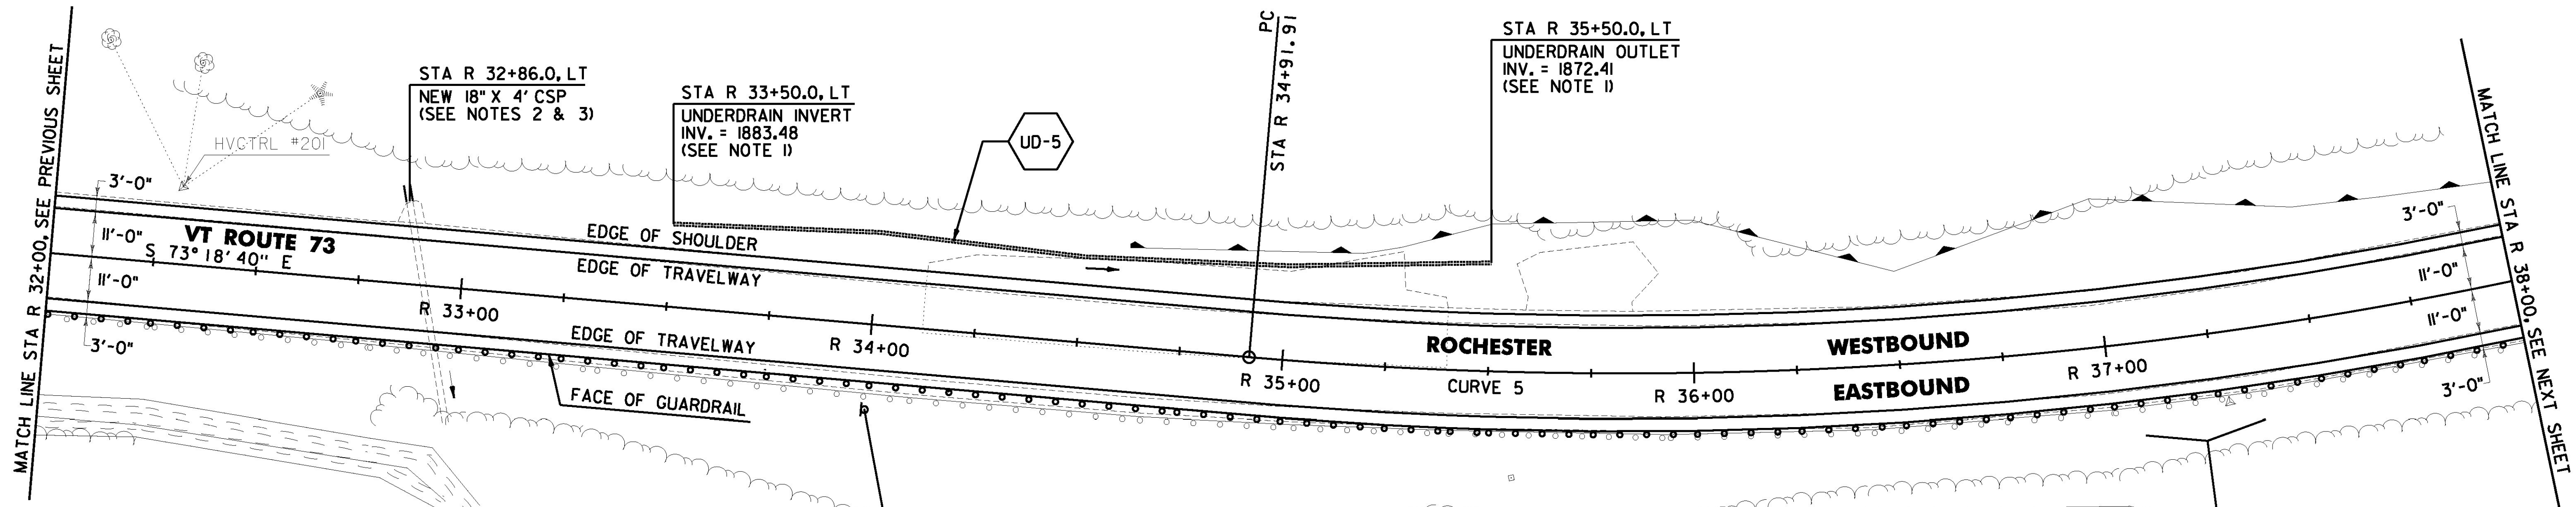


DURABLE 4 INCH WHITE LINE (OPTION ITEM)
AND TEMPORARY 4 INCH WHITE LINE, PAINT
(ALL LINES WILL INCLUDE EDGE LINE BREAKS AND
RADIUS FOR TOWN HIGHWAYS)
ROCHESTER:
STA R 32+00.00 - STA R 38+00.00 LT & RT

DURABLE 4 INCH YELLOW LINE (OPTION ITEM) AND
TEMPORARY 4 INCH YELLOW LINE, PAINT
(ALL LINES WILL INCLUDE C/L BREAKS FOR TOWN
HIGHWAYS) S = SOLID, D = DASHED
ROCHESTER:
STA R 32+00.00 - STA R 38+00.00 LT & RT
S - S

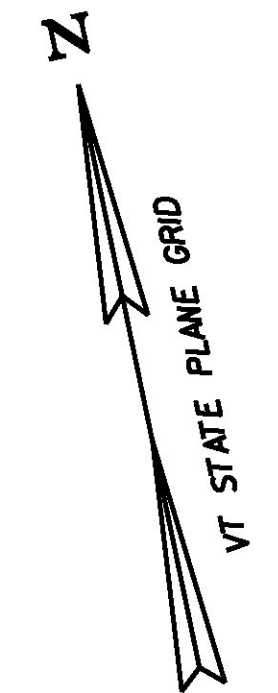

MATCH LINE STA R 32+00, SEE PREVIOUS SHEET

MATCH LINE STA R 38+00, SEE NEXT SHEET


6 INCH UNDERDRAIN PIPE
ROCHESTER:
STA R 33+50.0 - STA R 35+50.0 LT

PROJECT DEMARCATION FENCE
ROCHESTER:
~~STA R 32+00.0 - STA R 38+00.0 LT & RT~~

BARRIER FENCE
ROCHESTER:
~~STA R 33+61.0 - STA R 38+00.0 LT~~
R 36+75.0

**STEEL BEAM GUARDRAIL, GALVANIZED
W/ 8 FEET POSTS**
ROCHESTER:
STA R 32+00.0 - STA R 38+00.0 RT

REMOVAL AND DISPOSAL OF GUARDRAIL
ROCHESTER:
STA R 32+00.0 - STA R 38+00.0 RT

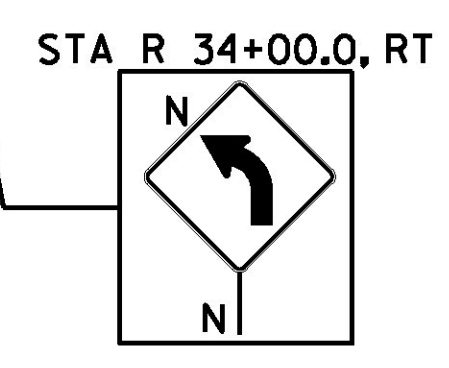


CURVE 5
Δ = 25° 04' 12" LT
D = 5° 27' 24"
R = 1050.00'
T = 233.45'
L = 459.43'
E = 25.64'
e = 0.076 FT/FT

STA R 35+50.0, LT
UNDERDRAIN OUTLET
INV. = 1872.41
(SEE NOTE 1)

STA R 32+86.0, LT
NEW 18" X 4' CSP
(SEE NOTES 2 & 3)

STA R 33+50.0, LT
UNDERDRAIN INVERT
INV. = 1883.48
(SEE NOTE 1)

PC
STA R 34+91.91

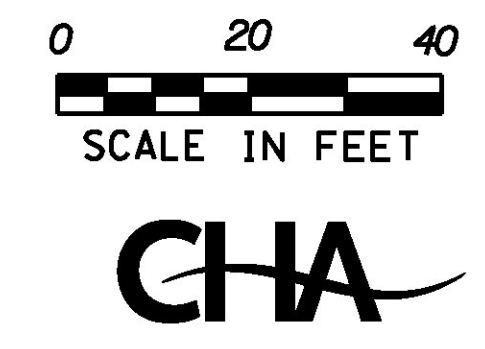

- NOTES:
- SEE SHEETS 26 & 27 FOR UNDERDRAIN DETAILS.
 - THE CONTRACTOR SHALL ADJUST THE PROPOSED SIDE SLOPE TO AVOID FILLING IN THE EXISTING PIPE AS DIRECTED BY THE ENGINEER.
 - SEE SHEET 23 FOR PIPE EXTENSION DETAILS.

PROJECT NAME: ROCHESTER	
PROJECT NUMBER: ER STP 0162(21)	
FILE NAME: z13cl76bdr.dgn	PLOT DATE: 1/11/2017
PROJECT LEADER: D. GOZALKOWSKI	DRAWN BY: J. HEALD
DESIGNED BY: J. OLSEN	CHECKED BY: J. SHIELDS
PROJECT LAYOUT SHEET #7	SHEET 39 OF 360

PI STA R 37+25.36 BK. =
PI STA R 37+17.89 AHD.