


DURABLE 4 INCH WHITE LINE (OPTION ITEM)
AND TEMPORARY 4 INCH WHITE LINE, PAINT
(ALL LINES WILL INCLUDE EDGE LINE BREAKS AND
RADIUS FOR TOWN HIGHWAYS)
ROCHESTER:
STA R 62+00.00 - STA R 68+00.00 LT & RT

DURABLE 4 INCH YELLOW LINE (OPTION ITEM) AND
TEMPORARY 4 INCH YELLOW LINE, PAINT
(ALL LINES WILL INCLUDE C/L BREAKS FOR TOWN
HIGHWAYS) S = SOLID, D = DASHED
ROCHESTER:
STA R 62+00.00 - STA R 68+00.00 LT ☒ RT
S - S

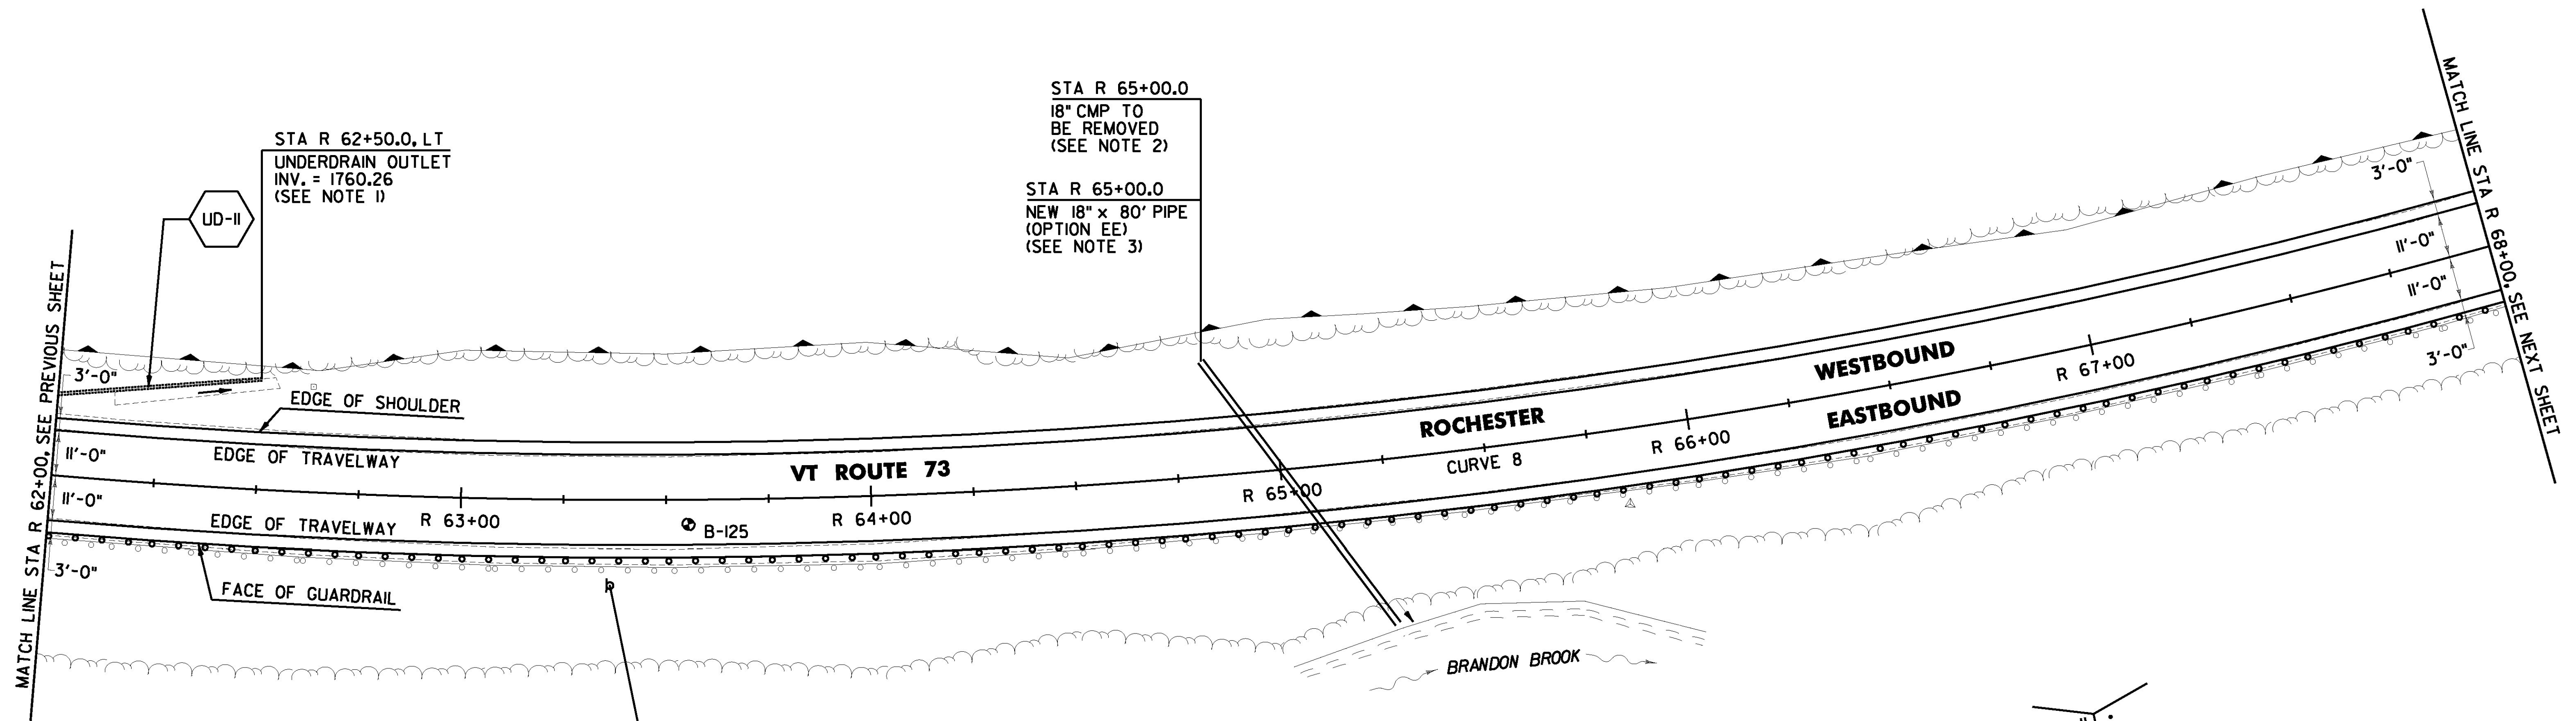

SOIL BORING DATA			
BORING #	DEPTH (FT.)	PCC	COMMENTS
B-125	5.0	NO	

6 INCH UNDERDRAIN PIPE
ROCHESTER:
STA R 62+00.0 - STA R 62+50.0 LT

STEEL BEAM GUARDRAIL, GALVANIZED
W/ 8 FEET POSTS
ROCHESTER:
STA R 62+00.0 - STA R 68+00.0 RT


REMOVAL AND DISPOSAL OF GUARDRAIL
ROCHESTER:
STA R 62+00.0 - STA R 68+00.0 RT

PROJECT DEMARCATION FENCE
ROCHESTER:
~~STA R 62+00.0 - STA R 68+00.0 LT & RT~~

BARRIER FENCE
ROCHESTER:
~~STA R 62+00.0 - STA R 68+00.0 LT~~
~~STA R 62+80.0 - STA R 65+30.0~~

CURVE 8
Δ = 36° 20' 14" LT
D = 3° 24' 38"
R = 1680.00'
T = 551.34'
L = 1065.46'
E = 88.15'
e = 0.058 FT/FT

SIGN LEGEND
R = REMOVE
S = SALVAGE
N = NEW
RET = RETAIN
B-B = BACK TO BACK
EXISTING = - - - - -
NEW = _____
R = RETURN TO TOWN
☉ OF ROCHESTER

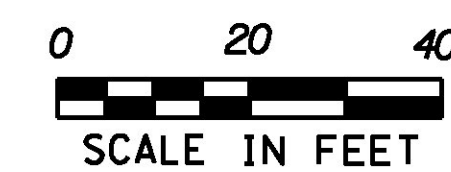

NOTES:

- SEE SHEETS 26 & 27 FOR UNDERDRAIN DETAILS.
- THE CONTRACTOR SHALL PERFORM ALL EXCAVATION REQUIRED TO REMOVE THE EXISTING PIPE AND INSTALL THE PROPOSED PIPE UNDER ITEM 204.20 TRENCH EXCAVATION OF EARTH AS DIRECTED BY THE ENGINEER.
- SEE SHEET 24 FOR CULVERT ROADWAY CROSSING DETAIL.

PROJECT NAME: ROCHESTER
PROJECT NUMBER: ER STP 0162(21)

FILE NAME: z13cl76bdr.dgn
PROJECT LEADER: D. GOZALKOWSKI
DESIGNED BY: J. OLSEN
PROJECT LAYOUT SHEET #12

PLOT DATE: 1/11/2017
DRAWN BY: J. HEALD
CHECKED BY: J. SHIELDS
SHEET 44 OF 360

PI STA R 67+01.17 BK. =
PI STA R 66+63.96 AHD.