


DURABLE 4 INCH WHITE LINE (OPTION ITEM) AND TEMPORARY 4 INCH WHITE LINE, PAINT (ALL LINES WILL INCLUDE EDGE LINE BREAKS AND RADIUS FOR TOWN HIGHWAYS)
 ROCHESTER:
 STA R 68+00.00 - STA R 74+00.00 LT & RT

DURABLE 4 INCH YELLOW LINE, (OPTION ITEM) AND TEMPORARY 4 INCH YELLOW LINE, PAINT (ALL LINES WILL INCLUDE C/L BREAKS FOR TOWN HIGHWAYS) S = SOLID, D = DASHED
 ROCHESTER:
 STA R 68+00.00 - STA R 74+00.00 LT & RT
 LT & RT
 S - S

REMOVING SIGNS AS SHOWN - I

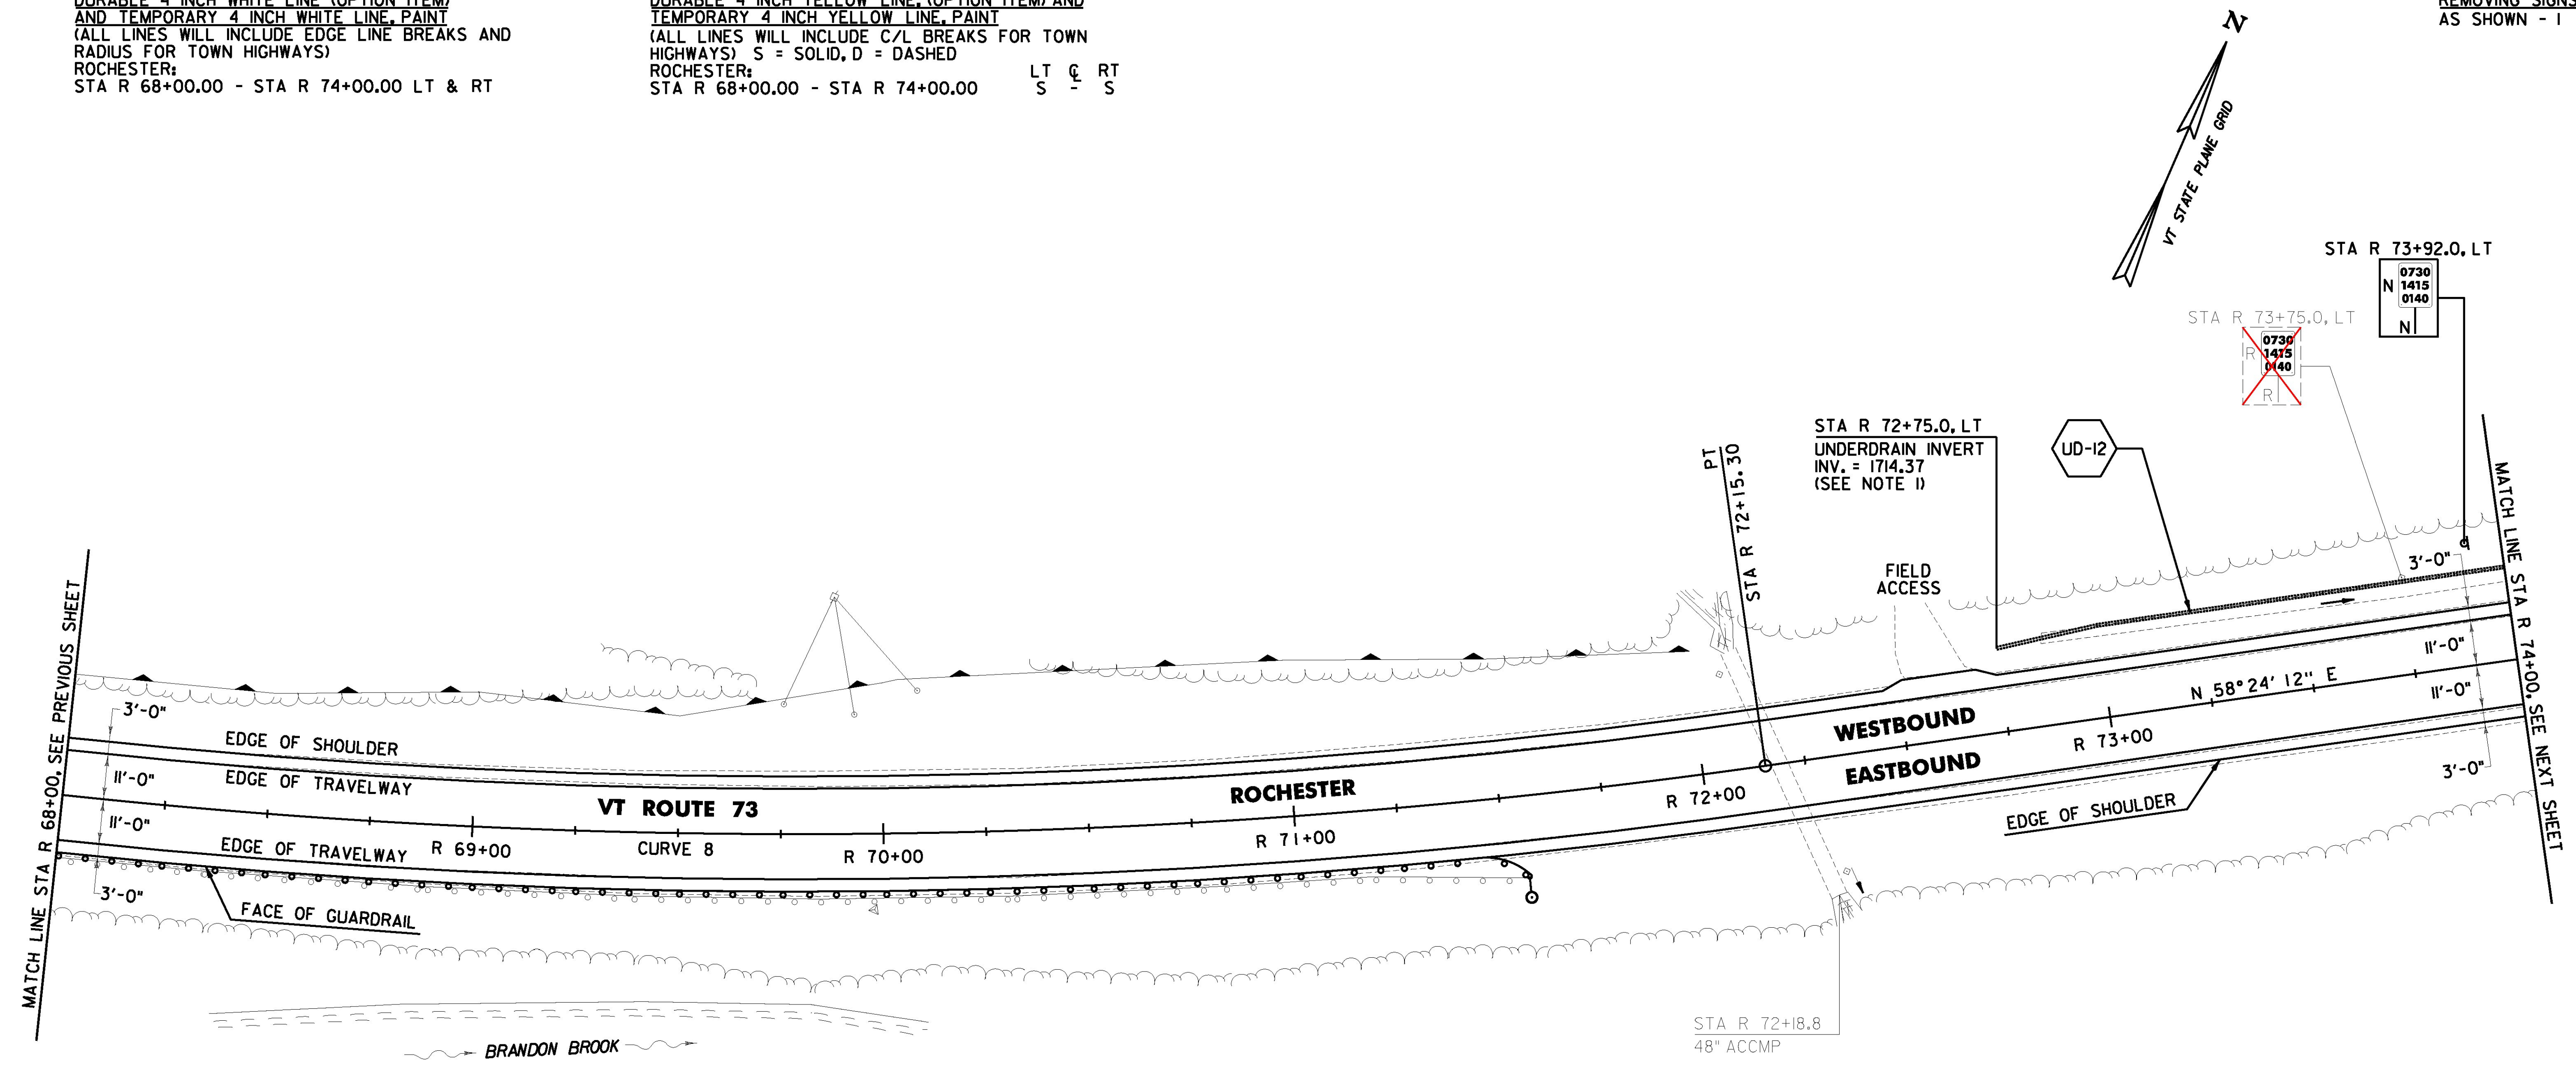

6 INCH UNDERDRAIN PIPE
 ROCHESTER:
 STA R 72+75.0 - STA R 74+00.0 LT

PROJECT DEMARCATION FENCE
 ROCHESTER:
~~STA R 68+00.0 - STA R 72+51.0 LT~~
~~STA R 68+00.0 - STA R 74+00.0 RT~~
~~STA R 72+69.0 - STA R 74+00.0 LT~~

STEEL BEAM GUARDRAIL, GALVANIZED W/ 8 FEET POSTS
 ROCHESTER:
 STA R 68+00.0 - STA R 71+56.0 RT

ANCHOR FOR STEEL BEAM RAIL
 ROCHESTER:
 STA R 71+47.5 RT

BARRIER FENCE
 ROCHESTER:
~~STA R 68+00.0 - STA R 72+51.0 LT~~
~~STA R 72+69.0 - STA R 73+01.0 LT~~

REMOVAL AND DISPOSAL OF GUARDRAIL
 ROCHESTER:
 STA R 68+00.0 - STA R 71+55.0 RT

DELINEATOR WITH STEEL POST
 ROCHESTER:
 STA R 71+56.0 RT

CURVE 8
 $\Delta = 36^{\circ}20'14''$ LT
 $D = 3^{\circ}24'38''$
 $R = 1680.00'$
 $T = 551.34'$
 $L = 1065.46'$
 $E = 88.15'$
 $e = 0.058$ FT/FT

SIGN LEGEND
 R = REMOVE
 S = SALVAGE
 N = NEW
 RET = RETAIN
 B-B = BACK TO BACK
 EXISTING = - - - - -
 NEW = _____
 R = RETURN TO TOWN OF ROCHESTER

0 20 40
 SCALE IN FEET



NOTE:
 I. SEE SHEETS 26 & 27 FOR UNDERDRAIN DETAILS.

PROJECT NAME: ROCHESTER	PLOT DATE: 1/11/2017
PROJECT NUMBER: ER STP 0162(21)	DRAWN BY: J. HEALD
FILE NAME: z13cl76bdr.dgn	DESIGNED BY: J. OLSEN
PROJECT LEADER: D. GOZALKOWSKI	CHECKED BY: J. SHIELDS
PROJECT LAYOUT SHEET #13	SHEET 45 OF 360