


DURABLE 4 INCH WHITE LINE (OPTION ITEM) AND TEMPORARY 4 INCH WHITE LINE, PAINT (ALL LINES WILL INCLUDE EDGE LINE BREAKS AND RADII FOR TOWN HIGHWAYS)
 ROCHESTER:
 STA R 80+00.00 - STA R 86+00.00 LT & RT

DURABLE 4 INCH YELLOW LINE (OPTION ITEM) AND TEMPORARY 4 INCH YELLOW LINE, PAINT (ALL LINES WILL INCLUDE C/L BREAKS FOR TOWN HIGHWAYS) S = SOLID, D = DASHED
 ROCHESTER:
 STA R 80+00.00 - STA R 86+00.00 LT ☐ RT
 S - S

REMOVING SIGNS AS SHOWN - 1

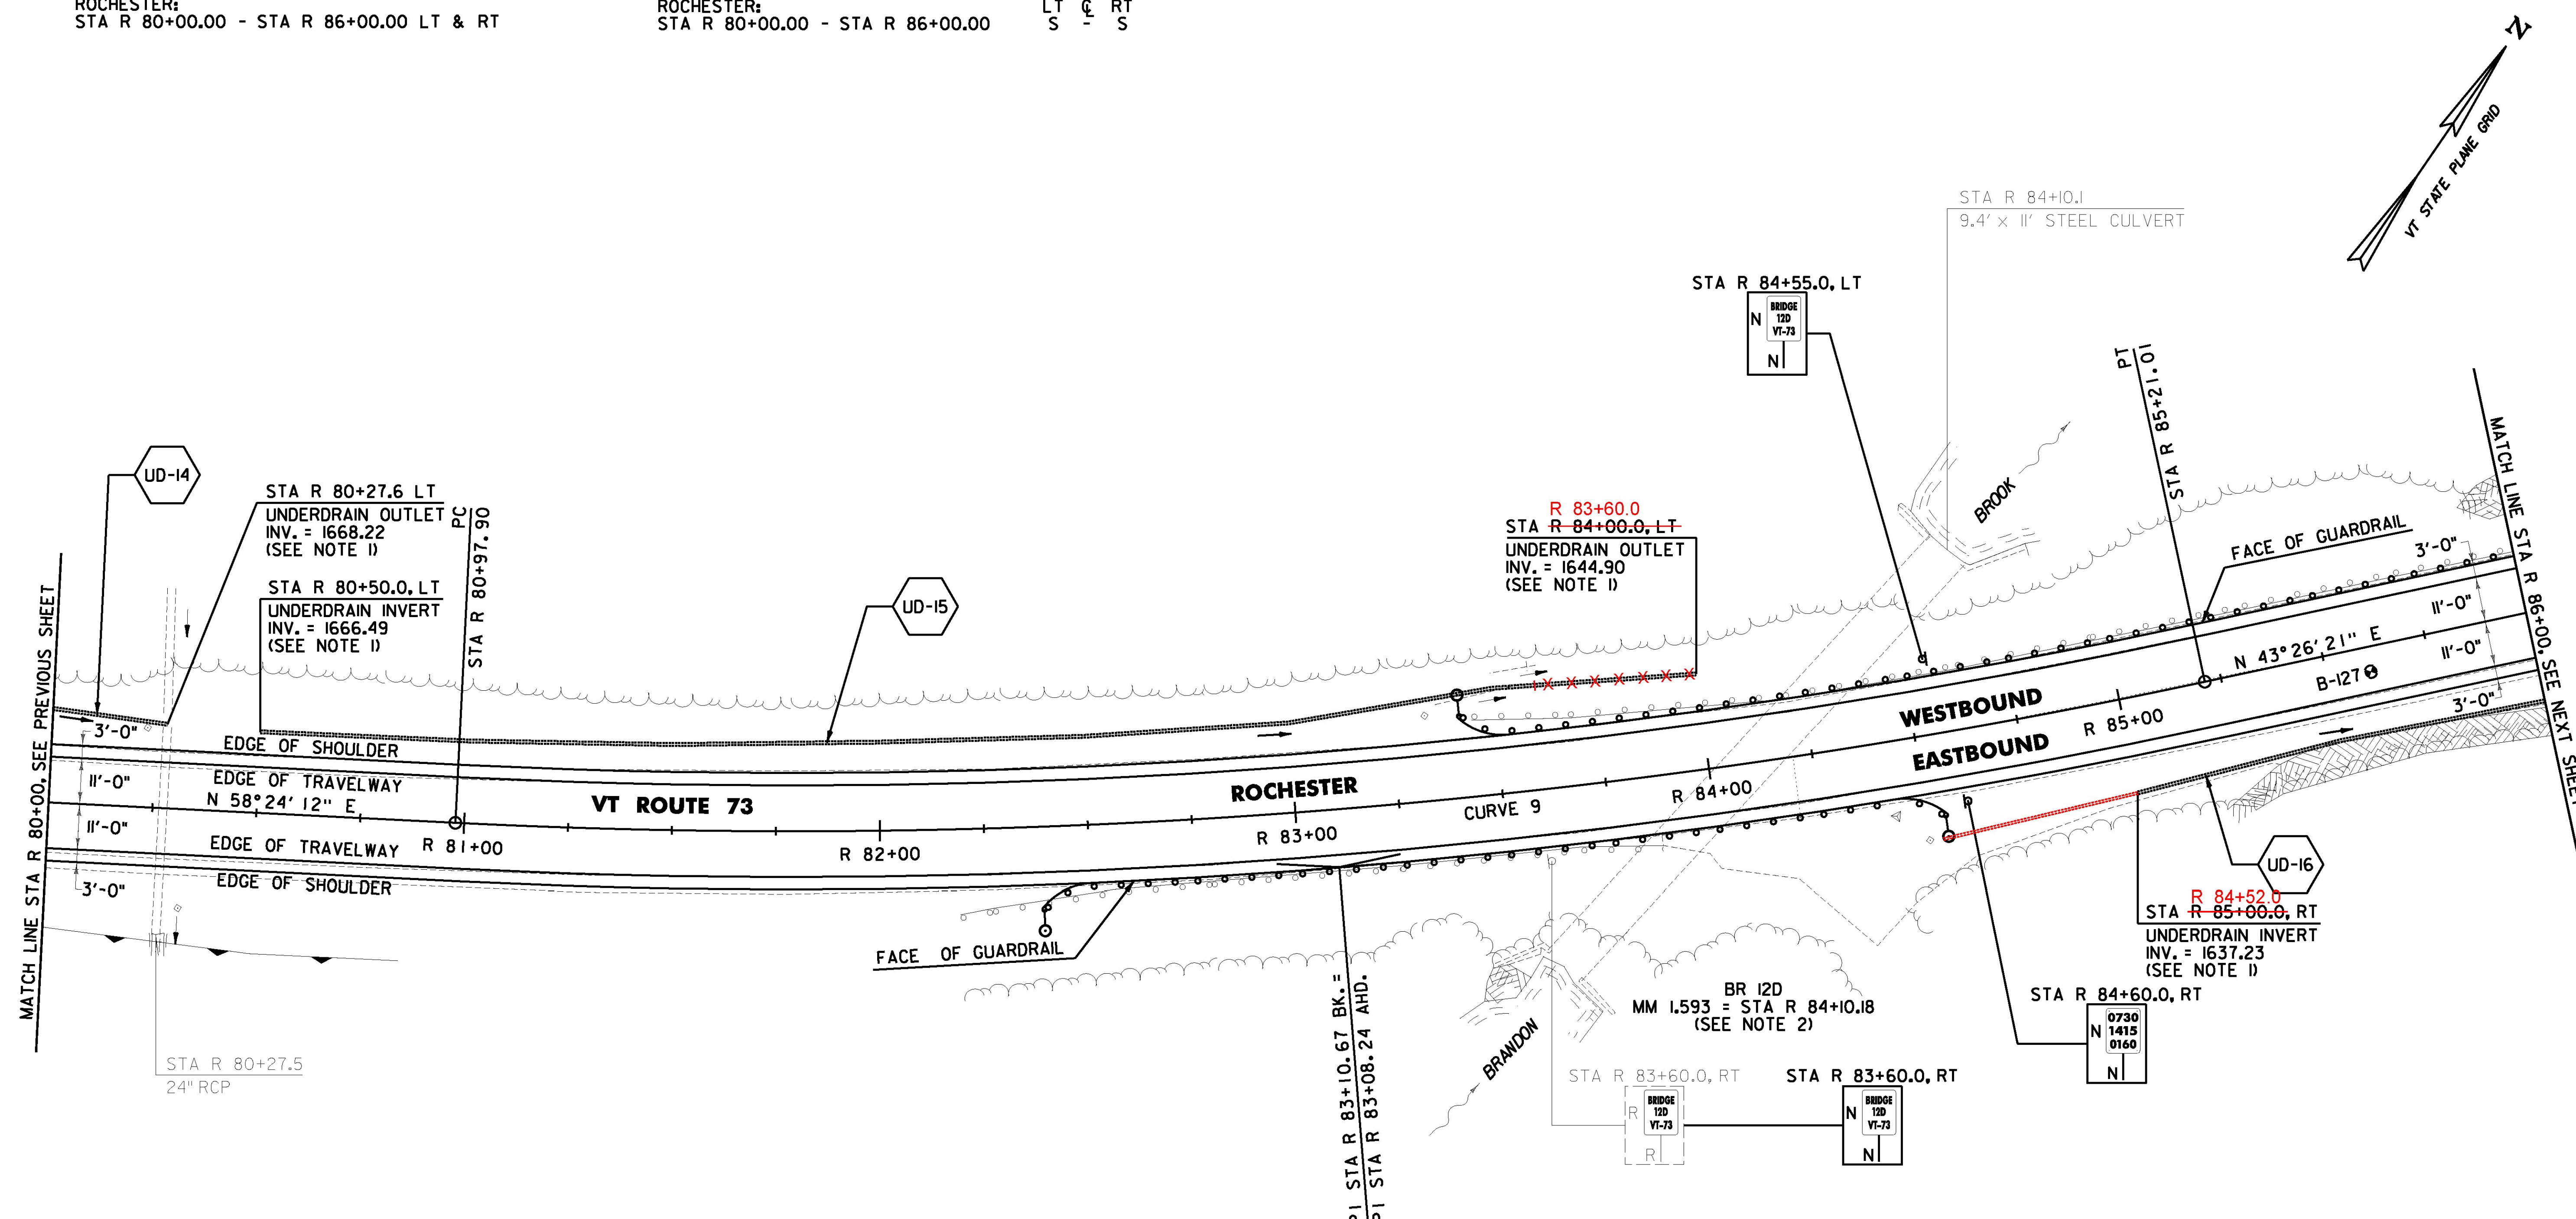

PROJECT DEMARCATION FENCE
 ROCHESTER:
~~STA R 80+00.0 - STA R 86+00.0 LT & RT~~

STEEL BEAM GUARDRAIL, GALVANIZED/NESTED W/ 8 FEET POSTS
 ROCHESTER:
~~STA R 83+46.5 - STA R 84+40.3 RT~~
~~STA R 83+80.5 - STA R 84+74.3 LT~~

STEEL BEAM GUARDRAIL, GALVANIZED W/ 8 FEET POSTS
 ROCHESTER:
 STA R 82+38.3 - STA R 83+46.5 RT
 STA R 83+41.0 - STA R 83+80.5 LT
 STA R 84+40.3 - STA R 84+54.8 RT
 STA R 84+74.3 - STA R 86+00.0 LT

ANCHOR FOR STEEL BEAM RAIL
 ROCHESTER:
 STA R 82+46.8 RT
 STA R 83+49.5 LT
 STA R 84+46.3 RT

BARRIER FENCE
 ROCHESTER:
~~STA R 80+00.0 - STA R 81+86.0 RT~~

6 INCH UNDERDRAIN PIPE
 ROCHESTER:
 STA R 80+00.0 - STA R 80+27.6 LT
 STA R 80+50.0 - STA R 84+00.0 LT
 STA R 85+00.0 - STA R 86+00.0 RT


REMOVAL AND DISPOSAL OF GUARDRAIL
 ROCHESTER:
 STA R 82+19.0 - STA R 83+87.0 RT
 STA R 83+44.0 - STA R 86+00.0 LT

DELINEATOR WITH STEEL POST
 ROCHESTER:
 STA R 82+38.3 RT
 STA R 83+41.0 LT
 STA R 84+54.8 RT

SOIL BORING DATA			
BORING #	DEPTH (FT.)	PCC	COMMENTS
B-127	5.0	NO	

CURVE 9
 $\Delta = 14^{\circ}57'52''$ LT
 $D = 3^{\circ}32'12''$
 $R = 1620.00'$
 $T = 212.77'$
 $L = 423.11'$
 $E = 13.91'$
 $e = 0.060$ FT/FT

SIGN LEGEND
 R = REMOVE
 S = SALVAGE
 N = NEW
 RET = RETAIN
 B-B = BACK TO BACK
 EXISTING = - - - - -
 NEW = _____
 R = RETURN TO TOWN OF ROCHESTER

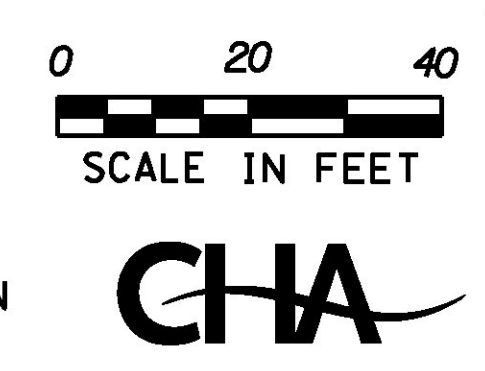

NOTES:
 1. SEE SHEETS 26 & 27 FOR UNDERDRAIN DETAILS.
 2. SEE SHEET 355 FOR LONGSPAN GUARDRAIL LOCATIONS.

PROJECT NAME: ROCHESTER
 PROJECT NUMBER: ER STP 0162(21)
 FILE NAME: z13cl76bdr.dgn
 PROJECT LEADER: D. GOZALKOWSKI
 DESIGNED BY: J. OLSEN
 PROJECT LAYOUT SHEET #15

PLOT DATE: 1/11/2017
 DRAWN BY: J. HEALD
 CHECKED BY: J. SHIELDS
 SHEET 47 OF 360