
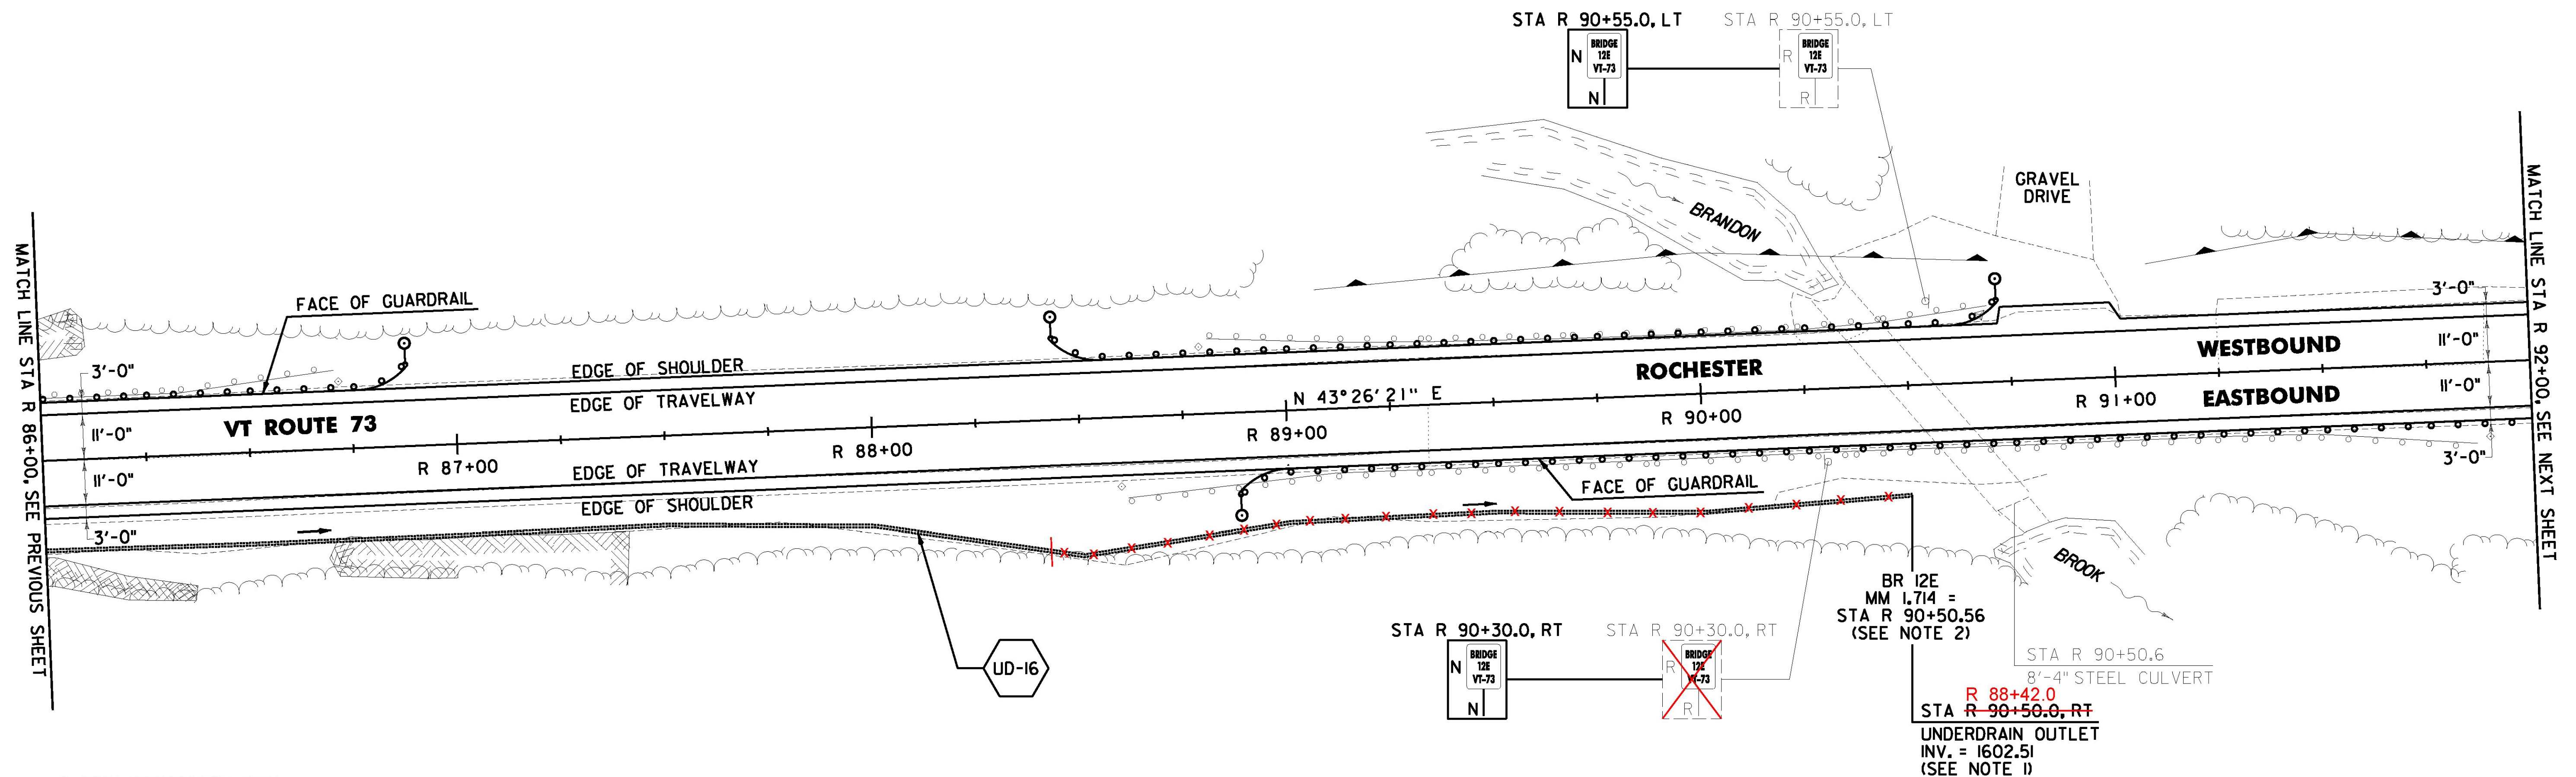


DURABLE 4 INCH WHITE LINE (OPTION ITEM) AND TEMPORARY 4 INCH WHITE LINE, PAINT (ALL LINES WILL INCLUDE EDGE LINE BREAKS AND RADIUS FOR TOWN HIGHWAYS)
 ROCHESTER:
 STA R 86+00.00 - STA R 92+00.00 LT & RT

DURABLE 4 INCH YELLOW LINE (OPTION ITEM) AND TEMPORARY 4 INCH YELLOW LINE, PAINT (ALL LINES WILL INCLUDE C/L BREAKS FOR TOWN HIGHWAYS) S = SOLID, D = DASHED
 ROCHESTER:
 STA R 86+00.00 - STA R 92+00.00 LT & RT
 S - S

REMOVING SIGNS AS SHOWN - 2

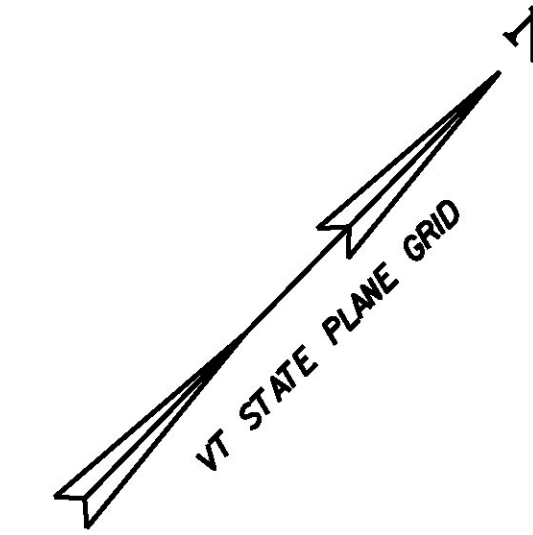

6 INCH UNDERDRAIN PIPE
 ROCHESTER:
 STA R 86+00.0 - STA R 90+50.0 RT

STEEL BEAM GUARDRAIL, GALVANIZED/NESTED W/ 8 FEET POSTS
 ROCHESTER:
~~STA R 90+14.8 - STA R 91+08.5 RT~~

HD STEEL BEAM GUARDRAIL, GALVANIZED/NESTED W/ 8 FEET POSTS
 ROCHESTER:
 STA R 90+26.7 - STA R 90+51.7 LT

STEEL BEAM GUARDRAIL, GALVANIZED W/ 8 FEET POSTS
 ROCHESTER:
 STA R 86+00.0 - STA R 86+88.8 LT
 STA R 88+43.4 - STA R 90+26.7 LT
 STA R 88+87.8 - STA R 90+14.8 RT
 STA R 90+51.7 - STA R 90+72.4 LT
 STA R 91+08.5 - STA R 92+00.0 RT

ANCHOR FOR STEEL BEAM RAIL
 ROCHESTER:
 STA R 86+80.3 LT
 STA R 88+51.9 LT
 STA R 88+96.3 RT
 STA R 90+63.9 LT

PROJECT DEMARCATION FENCE
 ROCHESTER:
~~STA R 86+00.0 - STA R 92+00.0 RT~~
~~STA R 86+00.0 - STA R 90+73.0 LT~~
~~STA R 90+99.0 - STA R 92+00.0 LT~~

BARRIER FENCE
 ROCHESTER:
~~STA R 88+08.0 - STA R 90+73.0 LT~~
~~STA R 90+99.0 - STA R 92+00.0 LT~~


REMOVAL AND DISPOSAL OF GUARDRAIL
 ROCHESTER:
 STA R 86+00.0 - STA R 86+71.0 LT
 STA R 88+61.0 - STA R 91+87.0 RT
 STA R 88+81.0 - STA R 90+70.0 LT

DELINEATOR WITH STEEL POST
 ROCHESTER:
 STA R 86+88.8 LT
 STA R 88+43.4 LT
 STA R 88+87.8 RT
 STA R 90+72.4 LT

NOTES:

- SEE SHEETS 26 & 27 FOR UNDERDRAIN DETAILS.
- SEE SHEET 355 FOR LONGSPAN GUARDRAIL LOCATIONS AND STEEL BEAM GUARDRAIL AT SMALL CULVERT DETAIL.

SIGN LEGEND
 R = REMOVE
 S = SALVAGE
 N = NEW
 RET = RETAIN
 B-B = BACK TO BACK
 EXISTING = - - - - -
 NEW = _____
 R = RETURN TO TOWN OF ROCHESTER

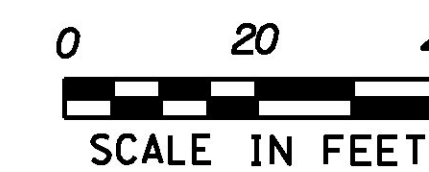

PROJECT NAME: ROCHESTER
 PROJECT NUMBER: ER STP 0162(21)

FILE NAME: z13cl76bdr.dgn
 PROJECT LEADER: D. GOZALKOWSKI
 DESIGNED BY: J. OLSEN
 PROJECT LAYOUT SHEET #16

PLOT DATE: 1/11/2017
 DRAWN BY: J. HEALD
 CHECKED BY: J. SHIELDS
 SHEET 48 OF 360