
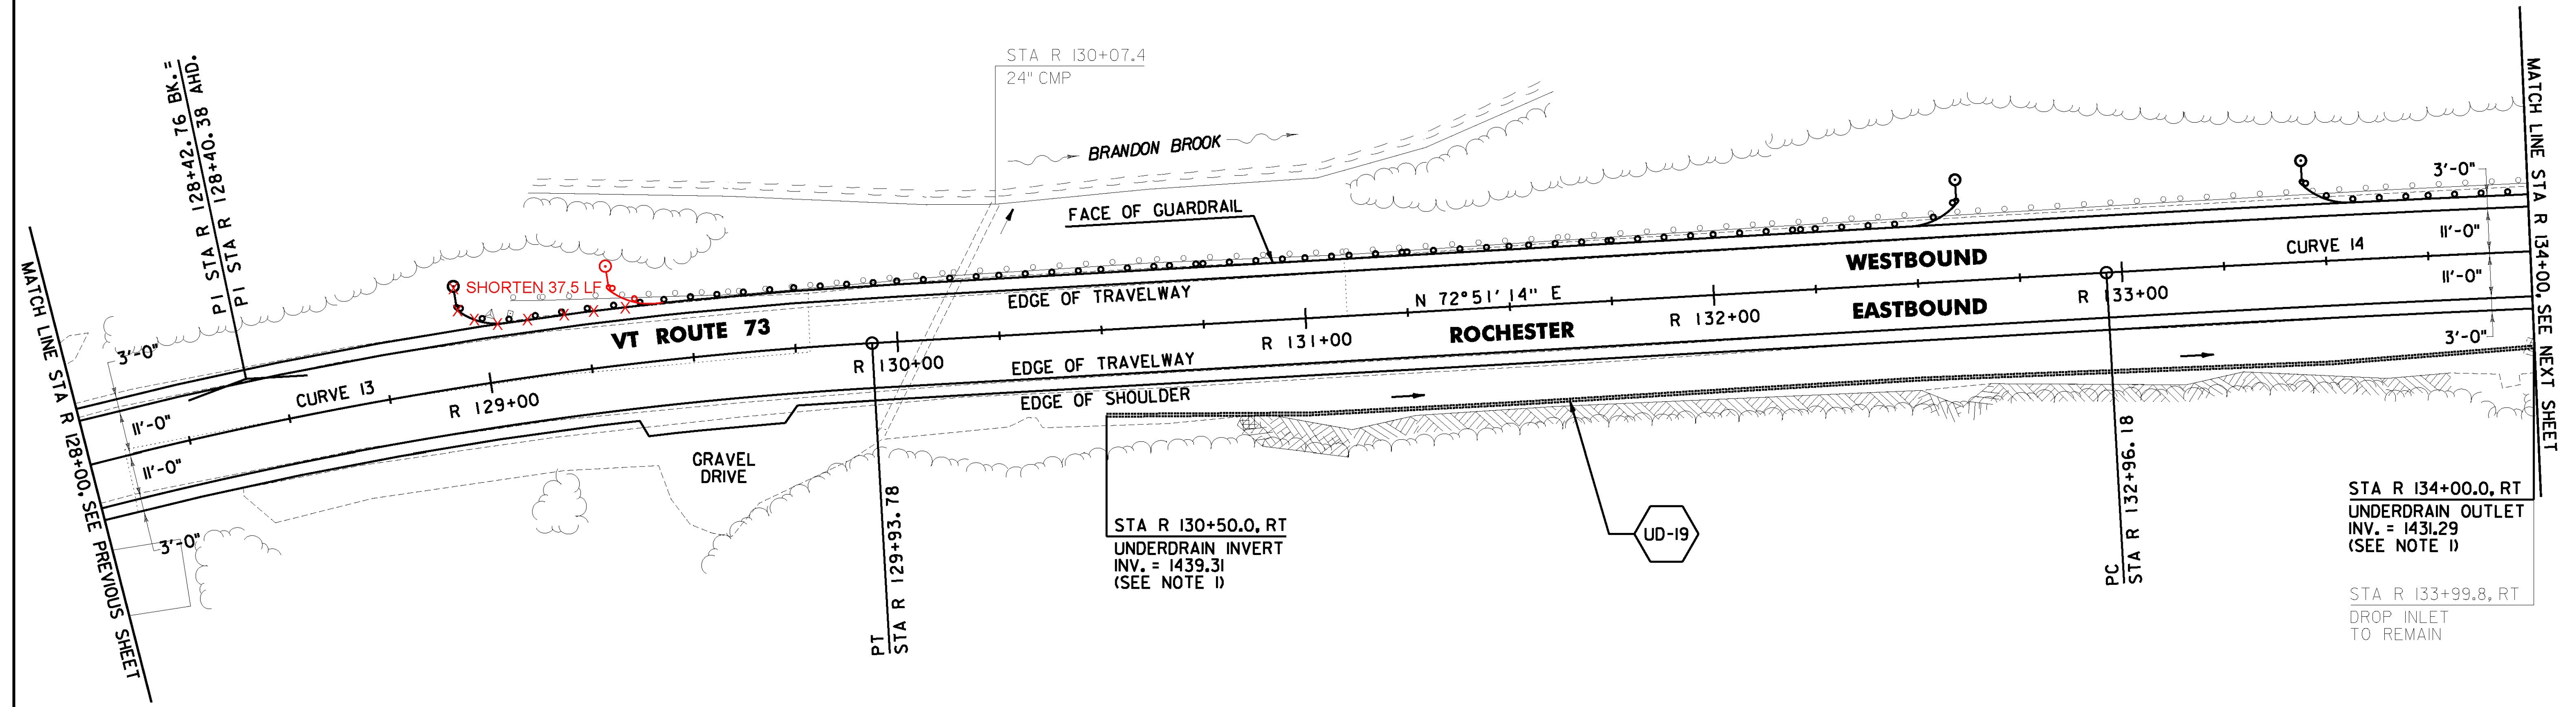


DURABLE 4 INCH WHITE LINE (OPTION ITEM)
AND TEMPORARY 4 INCH WHITE LINE, PAINT
(ALL LINES WILL INCLUDE EDGE LINE BREAKS AND
RADIUS FOR TOWN HIGHWAYS)
ROCHESTER:
STA R 128+00.00 - STA R 134+00.00 LT & RT

DURABLE 4 INCH YELLOW LINE (OPTION ITEM) AND
TEMPORARY 4 INCH YELLOW LINE, PAINT
(ALL LINES WILL INCLUDE C/L BREAKS FOR TOWN
HIGHWAYS) S = SOLID, D = DASHED
ROCHESTER:
STA R 128+00.00 - STA R 134+00.00 LT & RT
S - S

SPECIAL PROVISION (CORING CONCRETE)
ROCHESTER:
STA R 134+00.0 RT

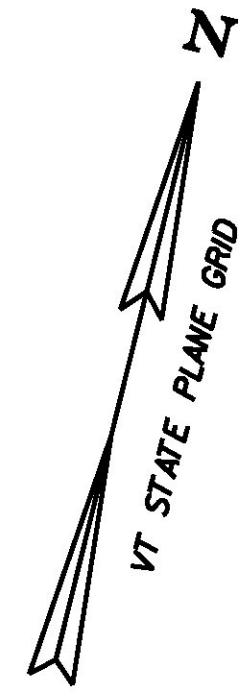

PROJECT DEMARCATION FENCE
ROCHESTER:
~~STA R 128+00.0 - STA R 134+00.0 LT~~
~~STA R 128+00.0 - STA R 129+37.0 RT~~
~~STA R 129+71.0 - STA R 134+00.0 RT~~

STEEL BEAM GUARDRAIL, GALVANIZED
ROCHESTER:
STA R 128+94.5 - STA R 132+61.0 LT
STA R 133+44.5 - STA R 134+00.0 LT

ANCHOR FOR STEEL BEAM RAIL
ROCHESTER:
STA R 129+03.0 LT
STA R 132+52.5 LT
STA R 133+53.0 LT

6 INCH UNDERDRAIN PIPE
ROCHESTER:
STA R 130+50.0 - STA R 134+00.0 RT


REMOVAL AND DISPOSAL OF GUARDRAIL
ROCHESTER:
STA R 129+08.0 - STA R 134+00.0 LT

DELINEATOR WITH STEEL POST
ROCHESTER:
STA R 128+94.5 LT
STA R 132+61.0 LT
STA R 133+44.5 LT

CURVE 13
Δ = 17° 26' 31" RT
D = 5° 43' 46"
R = 1000.00'
T = 153.40'
L = 304.42'
E = 11.70'
e = 0.076 FT/FT

CURVE 14
Δ = 4° 57' 46" RT
D = 0° 45' 50"
R = 7500.00'
T = 325.02'
L = 649.64'
E = 7.04'
e = 0.020 FT/FT

SIGN LEGEND
R = REMOVE
S = SALVAGE
N = NEW
RET = RETAIN
B-B = BACK TO BACK
EXISTING = _____
NEW = _____
R = RETURN TO TOWN
⊙ OF ROCHESTER

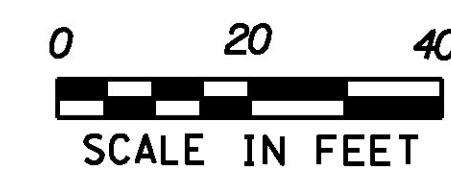

NOTE:
1. SEE SHEETS 26 & 27 FOR UNDERDRAIN DETAILS.

PROJECT NAME: ROCHESTER	FILE NAME: z13cl76bdr.dgn	PLOT DATE: 1/11/2017
PROJECT NUMBER: ER STP 0162(21)	PROJECT LEADER: D. GOZALKOWSKI	DRAWN BY: J. HEALD
	DESIGNED BY: J. OLSEN	CHECKED BY: J. SHIELDS
	PROJECT LAYOUT SHEET #23	SHEET 55 OF 360