
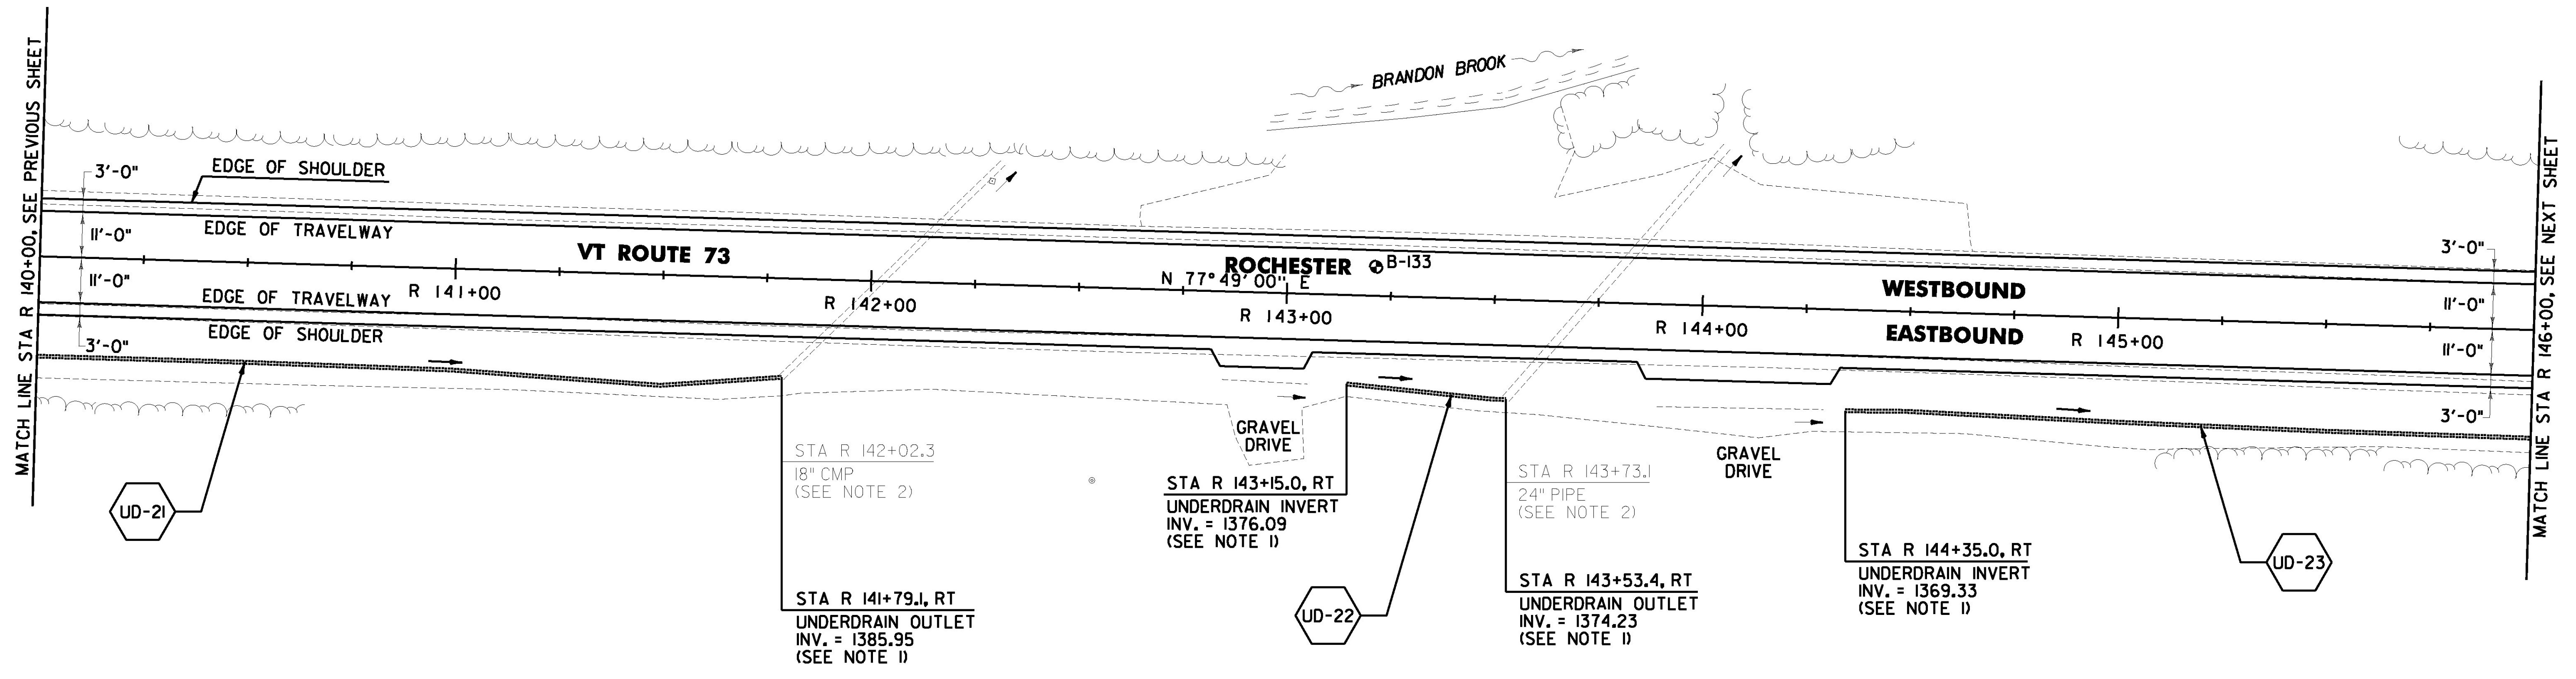


DURABLE 4 INCH WHITE LINE (OPTION ITEM)
AND TEMPORARY 4 INCH WHITE LINE, PAINT
(ALL LINES WILL INCLUDE EDGE LINE BREAKS AND
RADIUS FOR TOWN HIGHWAYS)
ROCHESTER:
STA R 140+00.00 - STA R 146+00.00 LT & RT

DURABLE 4 INCH YELLOW LINE (OPTION ITEM) AND
TEMPORARY 4 INCH YELLOW LINE, PAINT
(ALL LINES WILL INCLUDE C/L BREAKS FOR TOWN
HIGHWAYS) S = SOLID, D = DASHED
ROCHESTER:
STA R 140+00.00 - STA R 146+00.00 LT ☒ RT
S - S

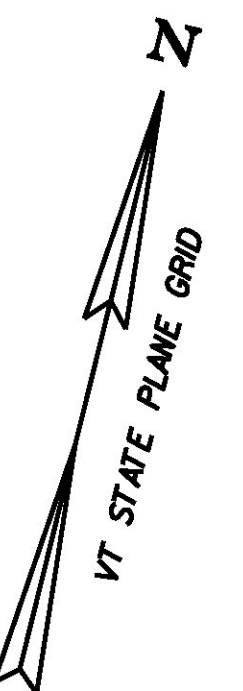


SOIL BORING DATA			
BORING #	DEPTH (FT.)	PCC	COMMENTS
B-133	5.0	NO	

6 INCH UNDERDRAIN PIPE
ROCHESTER:
STA R 140+00.0 - STA R 141+79.1 RT
STA R 143+15.0 - STA R 143+53.4 RT
STA R 144+35.0 - STA R 146+00.0 RT

PROJECT DEMARCATION FENCE
ROCHESTER:
~~STA R 140+00.0 - STA R 146+00.0 LT~~
~~STA R 140+00.0 - STA R 142+84.0 RT~~
~~STA R 143+04.0 - STA R 143+87.0 RT~~
~~STA R 144+31.0 - STA R 146+00.0 RT~~

SIGN LEGEND
R = REMOVE
S = SALVAGE
N = NEW
RET = RETAIN
B-B = BACK TO BACK
EXISTING = -----
NEW = _____
R = RETURN TO TOWN
☉ OF ROCHESTER

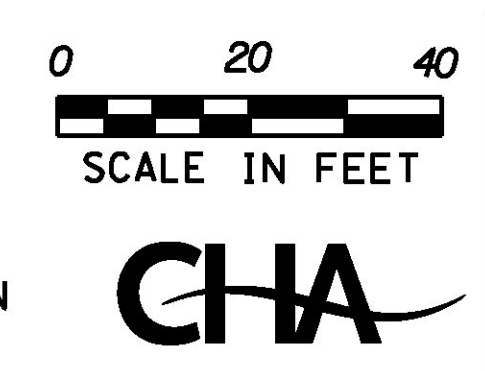

NOTES:
1. SEE SHEETS 26 & 27 FOR UNDERDRAIN DETAILS.
2. THE CONTRACTOR SHALL ADJUST THE PROPOSED SIDE SLOPE TO AVOID FILLING IN THE EXISTING PIPE AS DIRECTED BY THE ENGINEER.

PROJECT NAME: ROCHESTER	PLOT DATE: 1/11/2017
PROJECT NUMBER: ER STP 0162(21)	DRAWN BY: J. HEALD
FILE NAME: z13cl76bdr.dgn	CHECKED BY: J. SHIELDS
DESIGNED BY: J. OLSEN	PROJECT LAYOUT SHEET #25
	SHEET 57 OF 360