
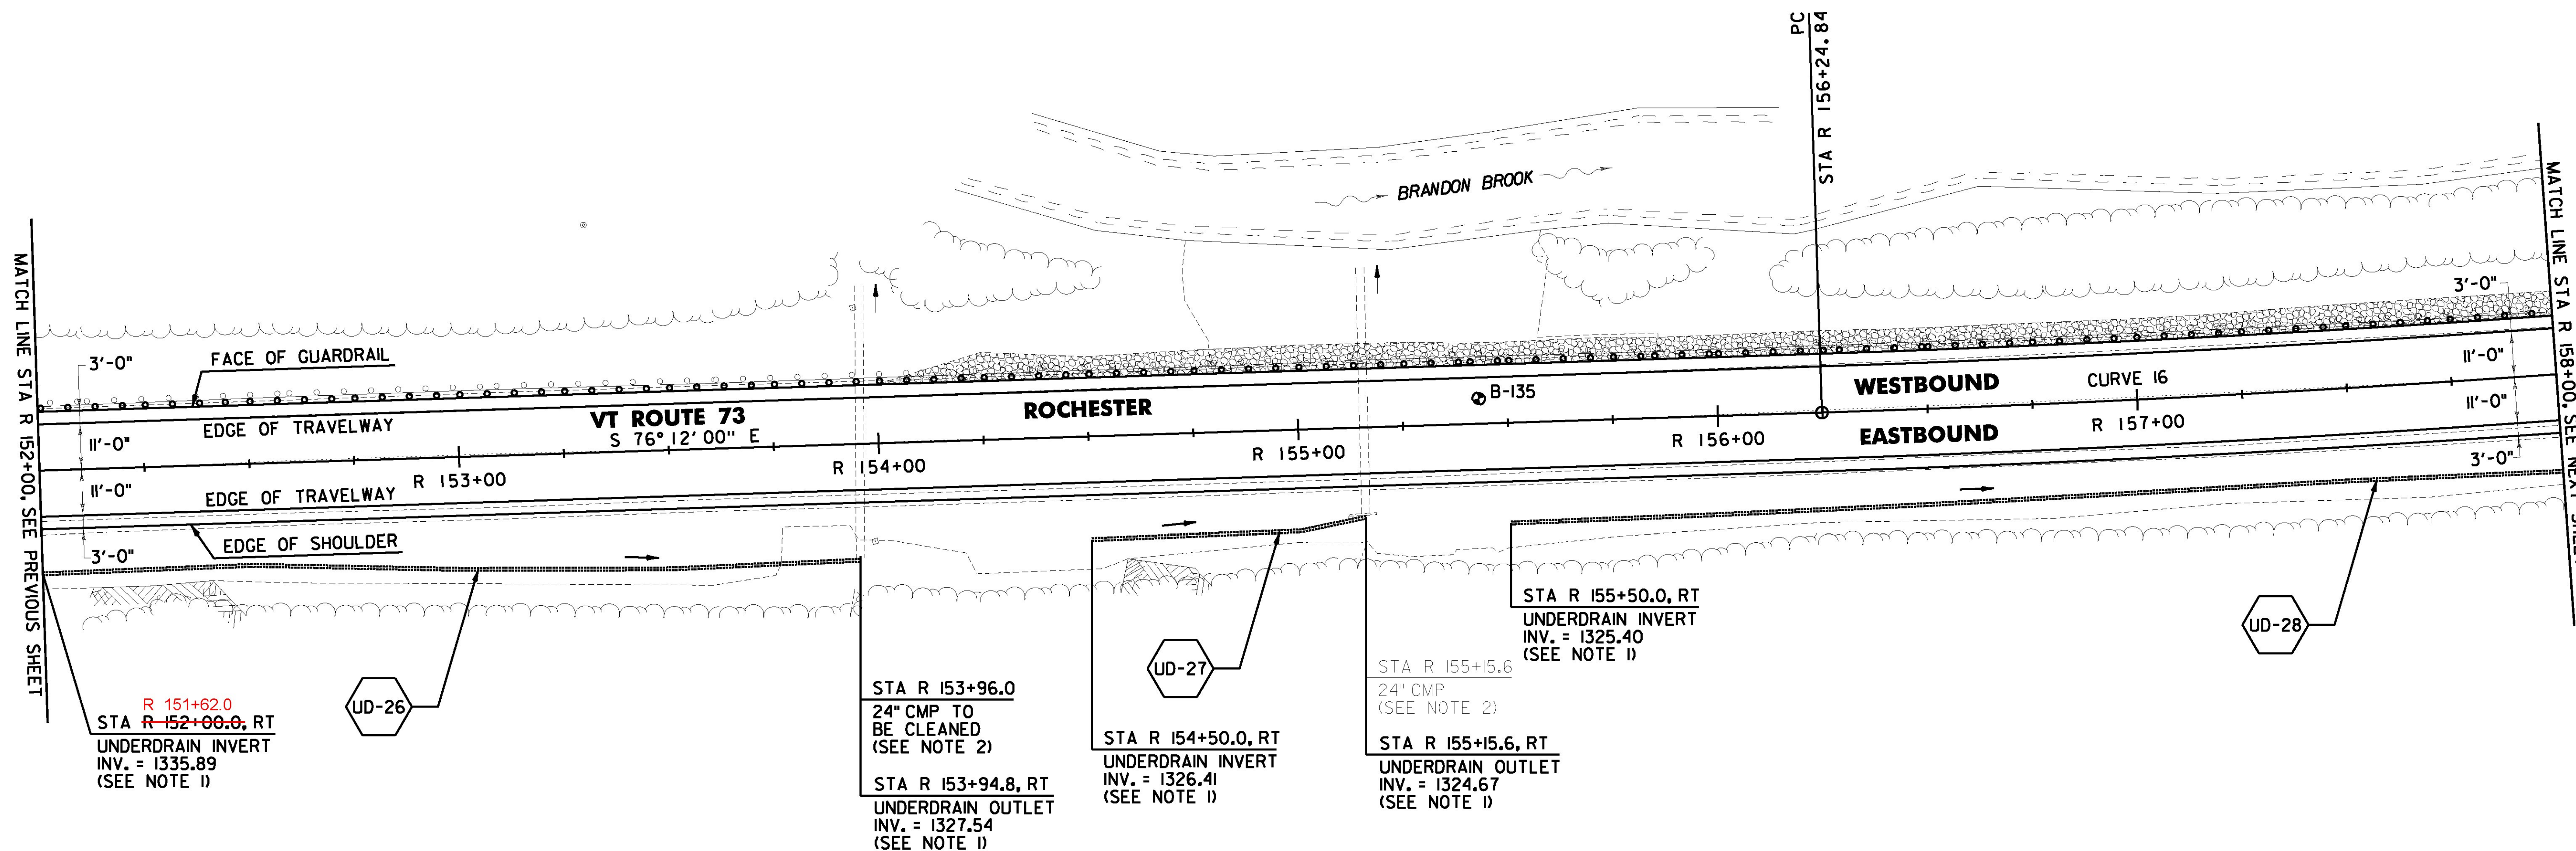


DURABLE 4 INCH WHITE LINE (OPTION ITEM) AND TEMPORARY 4 INCH WHITE LINE, PAINT (ALL LINES WILL INCLUDE EDGE LINE BREAKS AND RADIUS FOR TOWN HIGHWAYS)
 ROCHESTER:
 STA R 152+00.00 - STA R 158+00.00 LT & RT

DURABLE 4 INCH YELLOW LINE (OPTION ITEM) AND TEMPORARY 4 INCH YELLOW LINE, PAINT (ALL LINES WILL INCLUDE C/L BREAKS FOR TOWN HIGHWAYS) S = SOLID, D = DASHED
 ROCHESTER:
 STA R 152+00.00 - STA R 158+00.00 LT ☒ RT
 S - S

CLEANING CULV. PIPE IN-PLACE (0 TO 24 IN., INCL.)
 ROCHESTER:
 STA R 153+96.0 LT/RT

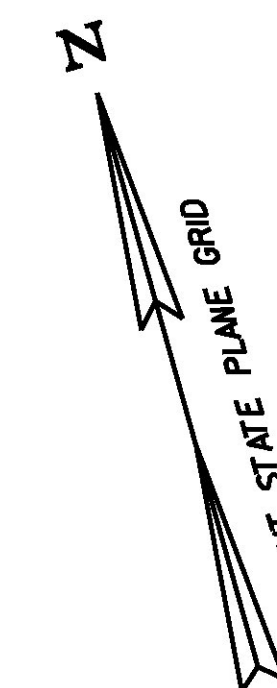

STONE FILL, TYPE I
 ROCHESTER:
 STA R 154+00.0 - STA R 158+00.0 LT
 GRUBBING MATERIAL (6\")
 ROCHESTER:
 STA R 154+00.0 - STA R 158+00.0 LT
 STEEL BEAM GUARDRAIL, GALVANIZED
 ROCHESTER:
 STA R 152+00.0 - STA R 158+00.0 LT
 REMOVAL AND DISPOSAL OF GUARDRAIL
 ROCHESTER:
 STA R 152+00.0 - STA R 158+00.0 LT

6 INCH UNDERDRAIN PIPE
 ROCHESTER:
 STA R 152+00.0 - STA R 153+94.8 RT
 SA R 154+50.0 - STA R 155+15.6 RT
 STA R 155+50.0 - STA R 158+00.0 RT
 PROJECT DEMARCATION FENCE
 ROCHESTER:
~~STA R 152+00.0 - STA R 158+00.0 LT & RT~~
 GEOTEXTILE FOR SILT FENCE
 ROCHESTER:
 STA R 154+00.0 - STA R 158+00.0 LT

SOIL BORING DATA			
BORING #	DEPTH (FT.)	PCC	COMMENTS
B-135	5.0	NO	

CURVE 16
 $\Delta = 7^{\circ}25'40''$ LT
 $D = 1^{\circ}16'24''$
 $R = 4500.00'$
 $T = 292.10'$
 $L = 583.38'$
 $E = 9.47'$
 $e = 0.026$ FT/FT

LEGEND
 ITEM 613.10
 STONE FILL, TYPE I

SIGN LEGEND
 R = REMOVE
 S = SALVAGE
 N = NEW
 RET = RETAIN
 B-B = BACK TO BACK
 EXISTING = - - - - -
 NEW = _____
 R = RETURN TO TOWN
 OF ROCHESTER

0 20 40
 SCALE IN FEET



NOTES:

- SEE SHEETS 26 & 27 FOR UNDERDRAIN DETAILS.
- THE CONTRACTOR SHALL ADJUST THE PROPOSED SIDE SLOPE TO AVOID FILLING IN THE EXISTING PIPE AS DIRECTED BY THE ENGINEER.

PROJECT NAME: ROCHESTER
 PROJECT NUMBER: ER STP 0162(21)

FILE NAME: z13cl76bdr.dgn
 PROJECT LEADER: D. GOZALKOWSKI
 DESIGNED BY: J. OLSEN
 PROJECT LAYOUT SHEET #27
 PLOT DATE: 1/11/2017
 DRAWN BY: J. HEALD
 CHECKED BY: J. SHIELDS
 SHEET 59 OF 360