
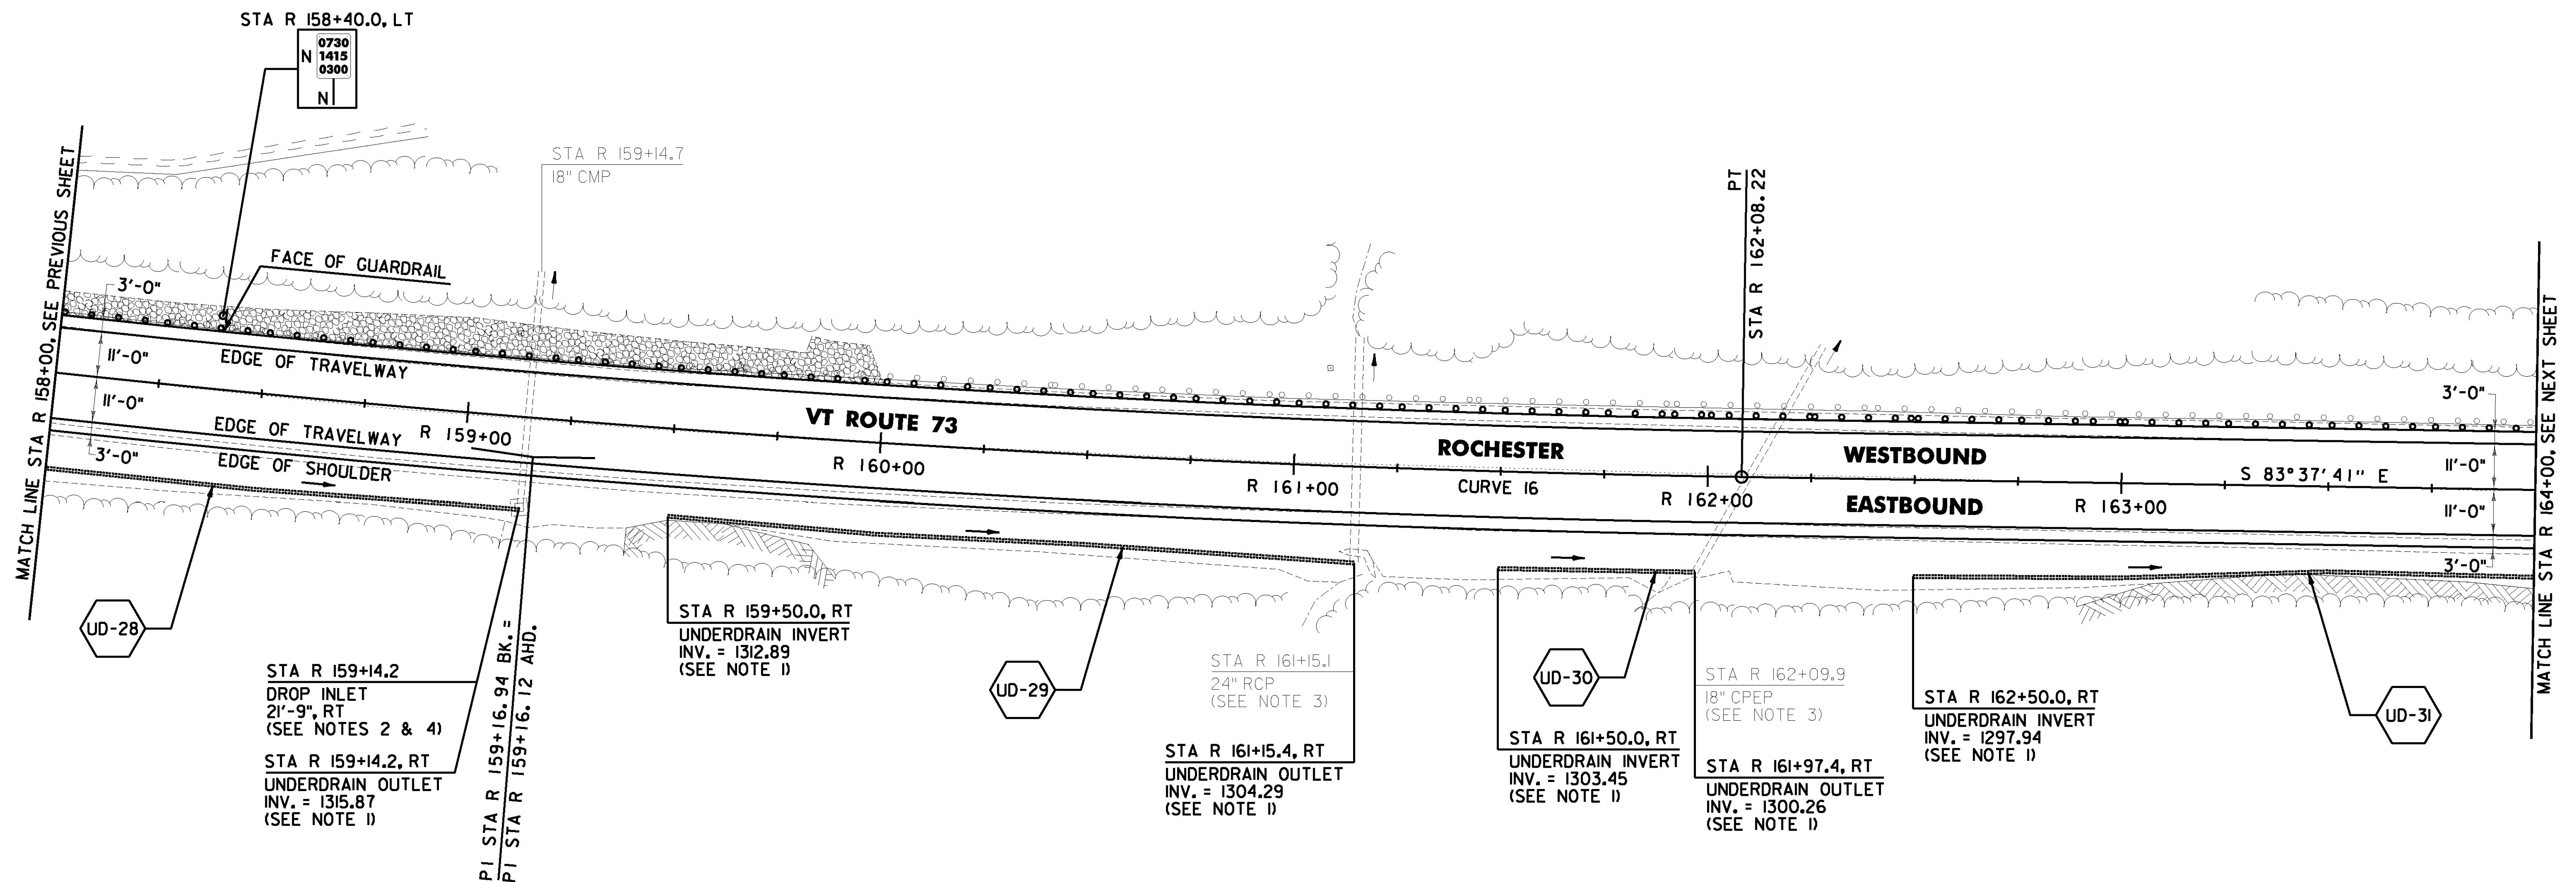


DURABLE 4 INCH WHITE LINE (OPTION ITEM) AND TEMPORARY 4 INCH WHITE LINE PAINT (ALL LINES WILL INCLUDE EDGE LINE BREAKS AND RADIUS FOR TOWN HIGHWAYS)
 ROCHESTER:
 STA R 158+00.00 - STA R 164+00.00 LT & RT

DURABLE 4 INCH YELLOW LINE (OPTION ITEM) AND TEMPORARY 4 INCH YELLOW LINE PAINT (ALL LINES WILL INCLUDE C/L BREAKS FOR TOWN HIGHWAYS) S = SOLID, D = DASHED
 ROCHESTER:
 STA R 158+00.00 - STA R 164+00.00 LT & RT
 S - S

SPECIAL PROVISION (CORING CONCRETE)
 ROCHESTER:
 STA R 159+14.2 RT

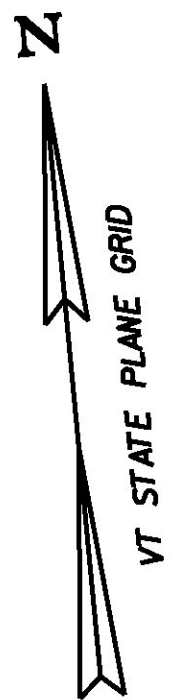

STONE FILL, TYPE I
 ROCHESTER:
 STA R 158+00.0 - STA R 160+00.0 LT

GRUBBING MATERIAL (6")
 ROCHESTER:
 STA R 158+00.0 - STA R 160+00.0 LT

REHAB DROP INLETS, CATCH BASINS OR MANHOLES CLASS I, II, OR III (SEE NOTE 4)
 ROCHESTER:
 STA R 159+14.2, RT

STEEL BEAM GUARDRAIL, GALVANIZED
 ROCHESTER:
 STA R 158+00.0 - STA R 164+00.0 LT

REMOVAL AND DISPOSAL OF GUARDRAIL
 ROCHESTER:
 STA R 158+00.0 - STA R 164+00.0 LT

6 INCH UNDERDRAIN PIPE
 ROCHESTER:
 STA R 158+00.0 - STA R 159+14.2 RT
 STA R 159+50.0 - STA R 161+5.4 RT
 STA R 161+50.0 - STA R 161+97.4 RT
 STA R 162+50.0 - STA R 164+00.0 RT

PROJECT DEMARCATION FENCE
 ROCHESTER:
~~STA R 158+00.0 - STA R 164+00.0 LT & RT~~

GEOTEXTILE FOR SILT FENCE
 ROCHESTER:
 STA R 158+00.0 - STA R 160+00.0 LT


NOTES:

- SEE SHEETS 26 & 27 FOR UNDERDRAIN DETAILS.
- THE CONTRACTOR SHALL ADJUST THE PROPOSED SIDE SLOPE TO AVOID FILLING IN THE EXISTING DROP INLET AS DIRECTED BY THE ENGINEER.
- THE CONTRACTOR SHALL ADJUST THE PROPOSED SIDE SLOPE TO AVOID FILLING IN THE EXISTING PIPE AS DIRECTED BY THE ENGINEER.
- THE CONTRACTOR SHALL REHABILITATE THE EXISTING DROP INLETS, CATCH BASINS OR MANHOLES TO A DEPTH AS DIRECTED BY THE ENGINEER. ALL REHABILITATION WORK WILL BE PAID FOR UNDER THE APPLICABLE REHABILITATION ITEM AS DIRECTED BY THE ENGINEER. ALL EXISTING UTILITIES MARKED "TO REMAIN" SHALL NOT BE ALTERED OR REHABILITATED UNLESS DIRECTED OTHERWISE BY THE ENGINEER.

LEGEND

ITEM 613.10
 STONE FILL, TYPE I

SIGN LEGEND
 R = REMOVE
 S = SALVAGE
 N = NEW
 RET = RETAIN
 B-B = BACK TO BACK
 EXISTING = - - - - -
 NEW = _____
 R = RETURN TO TOWN
 OF ROCHESTER

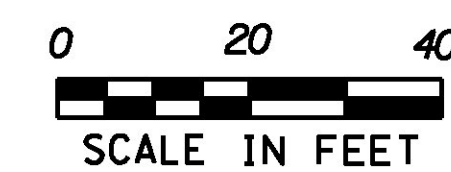

CURVE 16
 $\Delta = 7^{\circ}25'40''$ LT
 $D = 1^{\circ}16'24''$
 $R = 4500.00'$
 $T = 292.10'$
 $L = 583.38'$
 $e = 9.47'$
 $\theta = 0.026$ FT/FT

PROJECT NAME: ROCHESTER
 PROJECT NUMBER: ER STP 0162(21)

FILE NAME: z13cl76bdr.dgn
 PROJECT LEADER: D. GOZALKOWSKI
 DESIGNED BY: J. OLSEN
 PROJECT LAYOUT SHEET #28

PLOT DATE: 1/11/2017
 DRAWN BY: J. HEALD
 CHECKED BY: J. SHIELDS
 SHEET 60 OF 360