


DURABLE 4 INCH WHITE LINE (OPTION ITEM) AND TEMPORARY 4 INCH WHITE LINE, PAINT (ALL LINES WILL INCLUDE EDGE LINE BREAKS AND RADIUS FOR TOWN HIGHWAYS)  
 ROCHESTER:  
 STA R 176+00.00 - STA R 182+00.00 LT & RT

DURABLE 4 INCH YELLOW LINE (OPTION ITEM) AND TEMPORARY 4 INCH YELLOW LINE, PAINT (ALL LINES WILL INCLUDE C/L BREAKS FOR TOWN HIGHWAYS) S = SOLID, D = DASHED  
 ROCHESTER:  
 STA R 176+00.00 - STA R 182+00.00 LT ☐ RT  
 S - S

REMOVING SIGNS AS SHOWN - 1

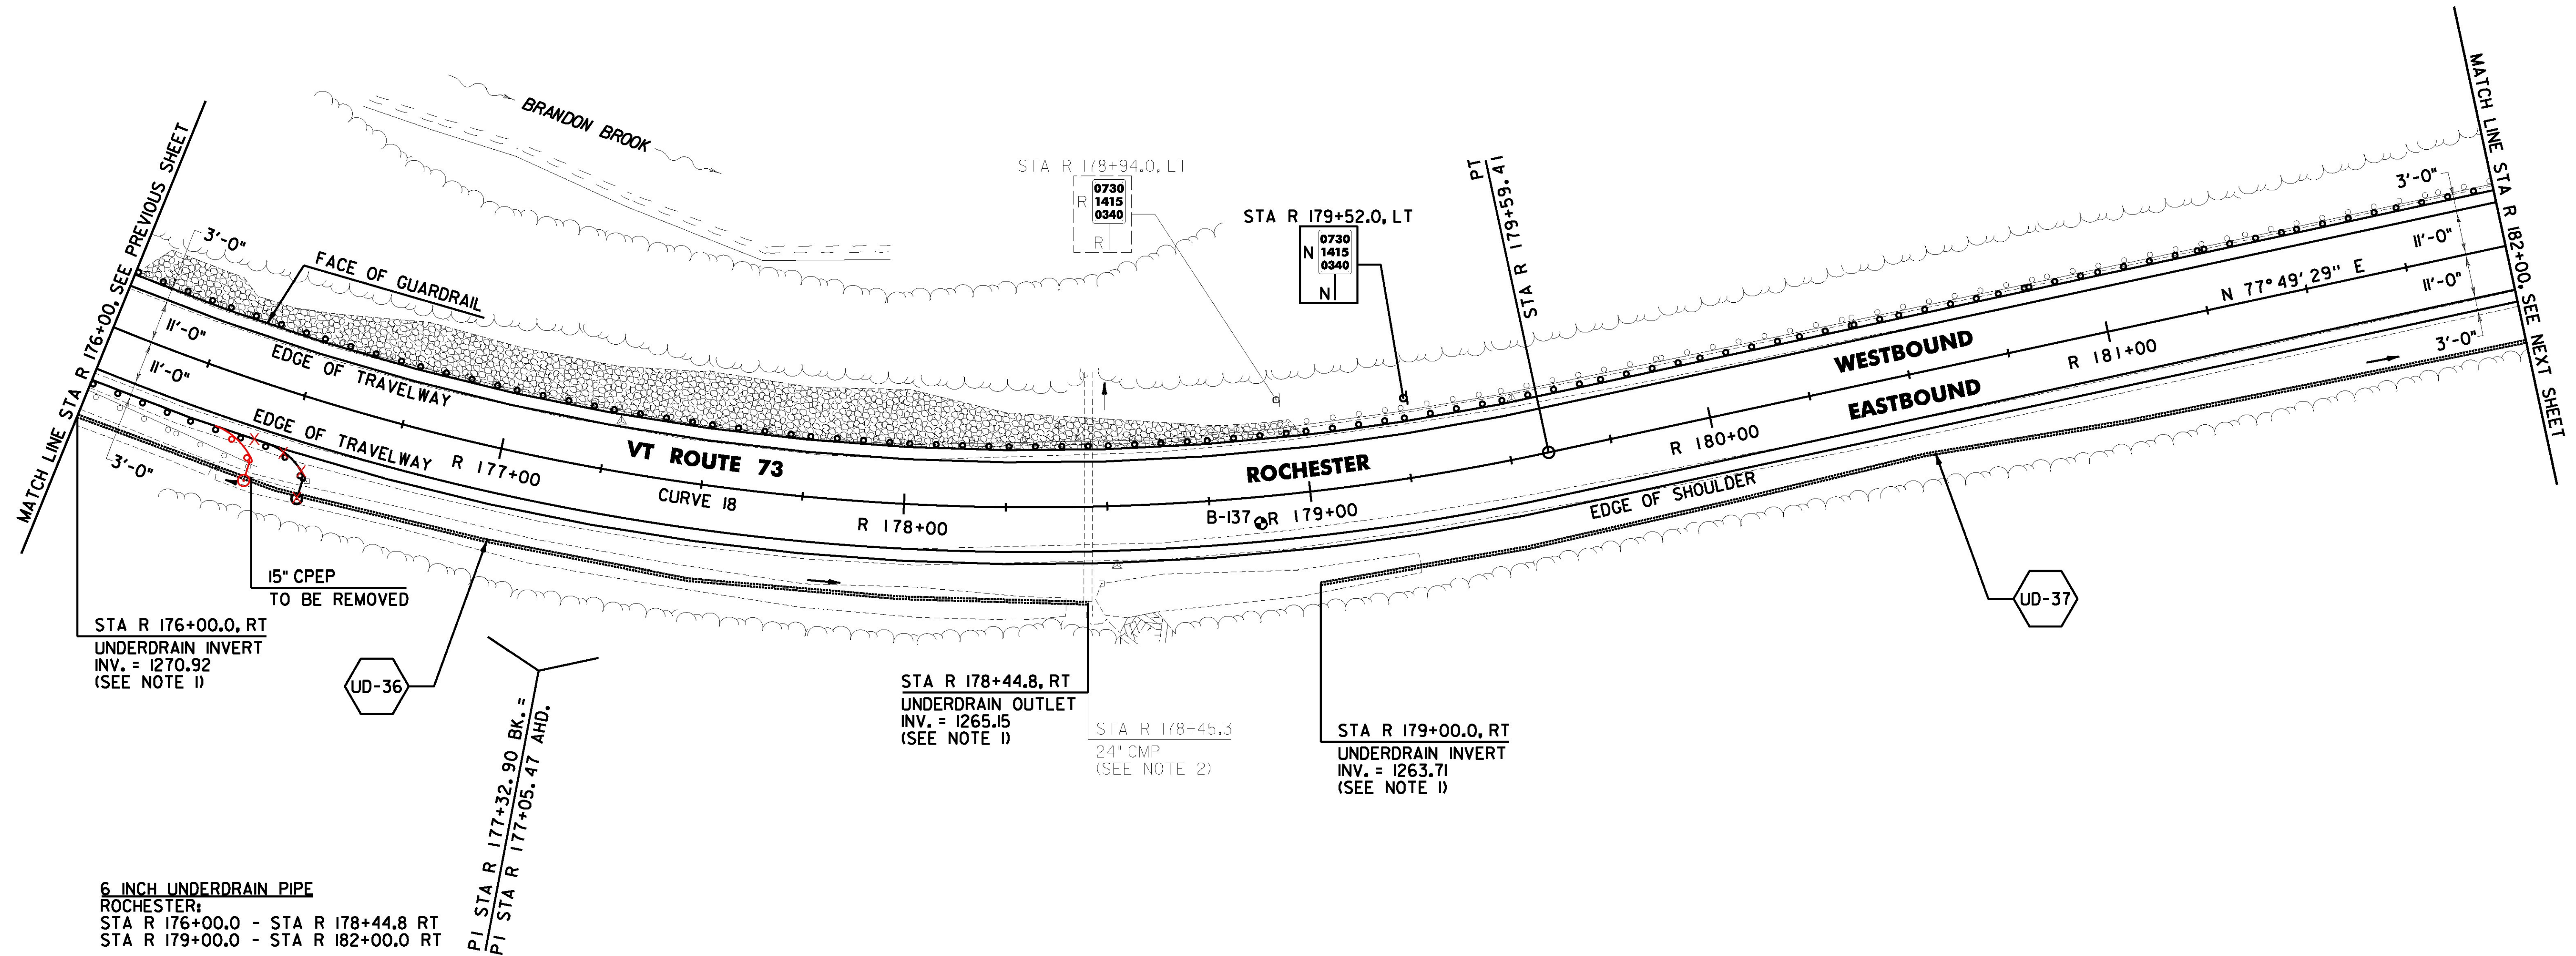

6 INCH UNDERDRAIN PIPE  
 ROCHESTER:  
 STA R 176+00.0 - STA R 178+44.8 RT  
 STA R 179+00.0 - STA R 182+00.0 RT

PROJECT DEMARCATION FENCE  
 ROCHESTER:  
~~STA R 176+00.0 - STA R 182+00.0 LT & RT~~

STONE FILL, TYPE I  
 ROCHESTER:  
 STA R 176+00.0 - STA R 179+00.0 LT

GRUBBING MATERIAL (6")  
 ROCHESTER:  
 STA R 176+00.0 - STA R 179+00.0 LT

STEEL BEAM GUARDRAIL, GALVANIZED  
 ROCHESTER:  
 STA R 176+00.0 - STA R 182+00.0 LT

ANCHOR FOR STEEL BEAM RAIL  
 ROCHESTER:  
 STA R 176+47.5 RT

GEOTEXTILE FOR SILT FENCE  
 ROCHESTER:  
 STA R 176+00.0 - STA R 179+00.0 LT

STEEL BEAM GUARDRAIL, GALVANIZED W/ 8 FEET POSTS  
 ROCHESTER:  
 STA R 176+00.0 - STA R 176+56.0 RT

REMOVAL AND DISPOSAL OF GUARDRAIL  
 ROCHESTER:  
 STA R 176+00.0 - STA R 176+44.0 RT  
 STA R 176+00.0 - STA R 182+00.0 LT

DELINEATOR WITH STEEL POST  
 ROCHESTER:  
 STA R 176+56.0 RT


SOIL BORING DATA			
BORING #	DEPTH (FT.)	PCC	COMMENTS
B-137	5.0	NO	AUGER GRINDING 0.7' - 2.5'

CURVE 18  
 $\Delta = 45^\circ 52' 47''$  LT  
 $D = 9^\circ 32' 57''$   
 $R = 600.00'$   
 $T = 253.94'$   
 $L = 480.45'$   
 $E = 51.53'$   
 $e = 0.080$  FT/FT

LEGEND

ITEM 613.10  
 STONE FILL, TYPE I

SIGN LEGEND  
 R = REMOVE  
 S = SALVAGE  
 N = NEW  
 RET = RETAIN  
 B-B = BACK TO BACK  
 EXISTING =   
 NEW =   
 R = RETURN TO TOWN OF ROCHESTER

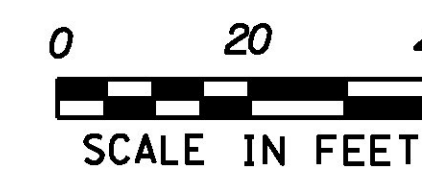

NOTES:

- SEE SHEETS 26 & 27 FOR UNDERDRAIN DETAILS
- THE CONTRACTOR SHALL ADJUST THE PROPOSED SIDE SLOPE TO AVOID FILLING IN THE EXISTING PIPE AS DIRECTED BY THE ENGINEER.

PROJECT NAME: ROCHESTER  
 PROJECT NUMBER: ER STP 0162(21)

FILE NAME: z13cl76bdr.dgn  
 PROJECT LEADER: D. GOZALKOWSKI  
 DESIGNED BY: J. OLSEN  
 PROJECT LAYOUT SHEET #31

PLOT DATE: 1/11/2017  
 DRAWN BY: J. HEALD  
 CHECKED BY: J. SHIELDS  
 SHEET 63 OF 360