
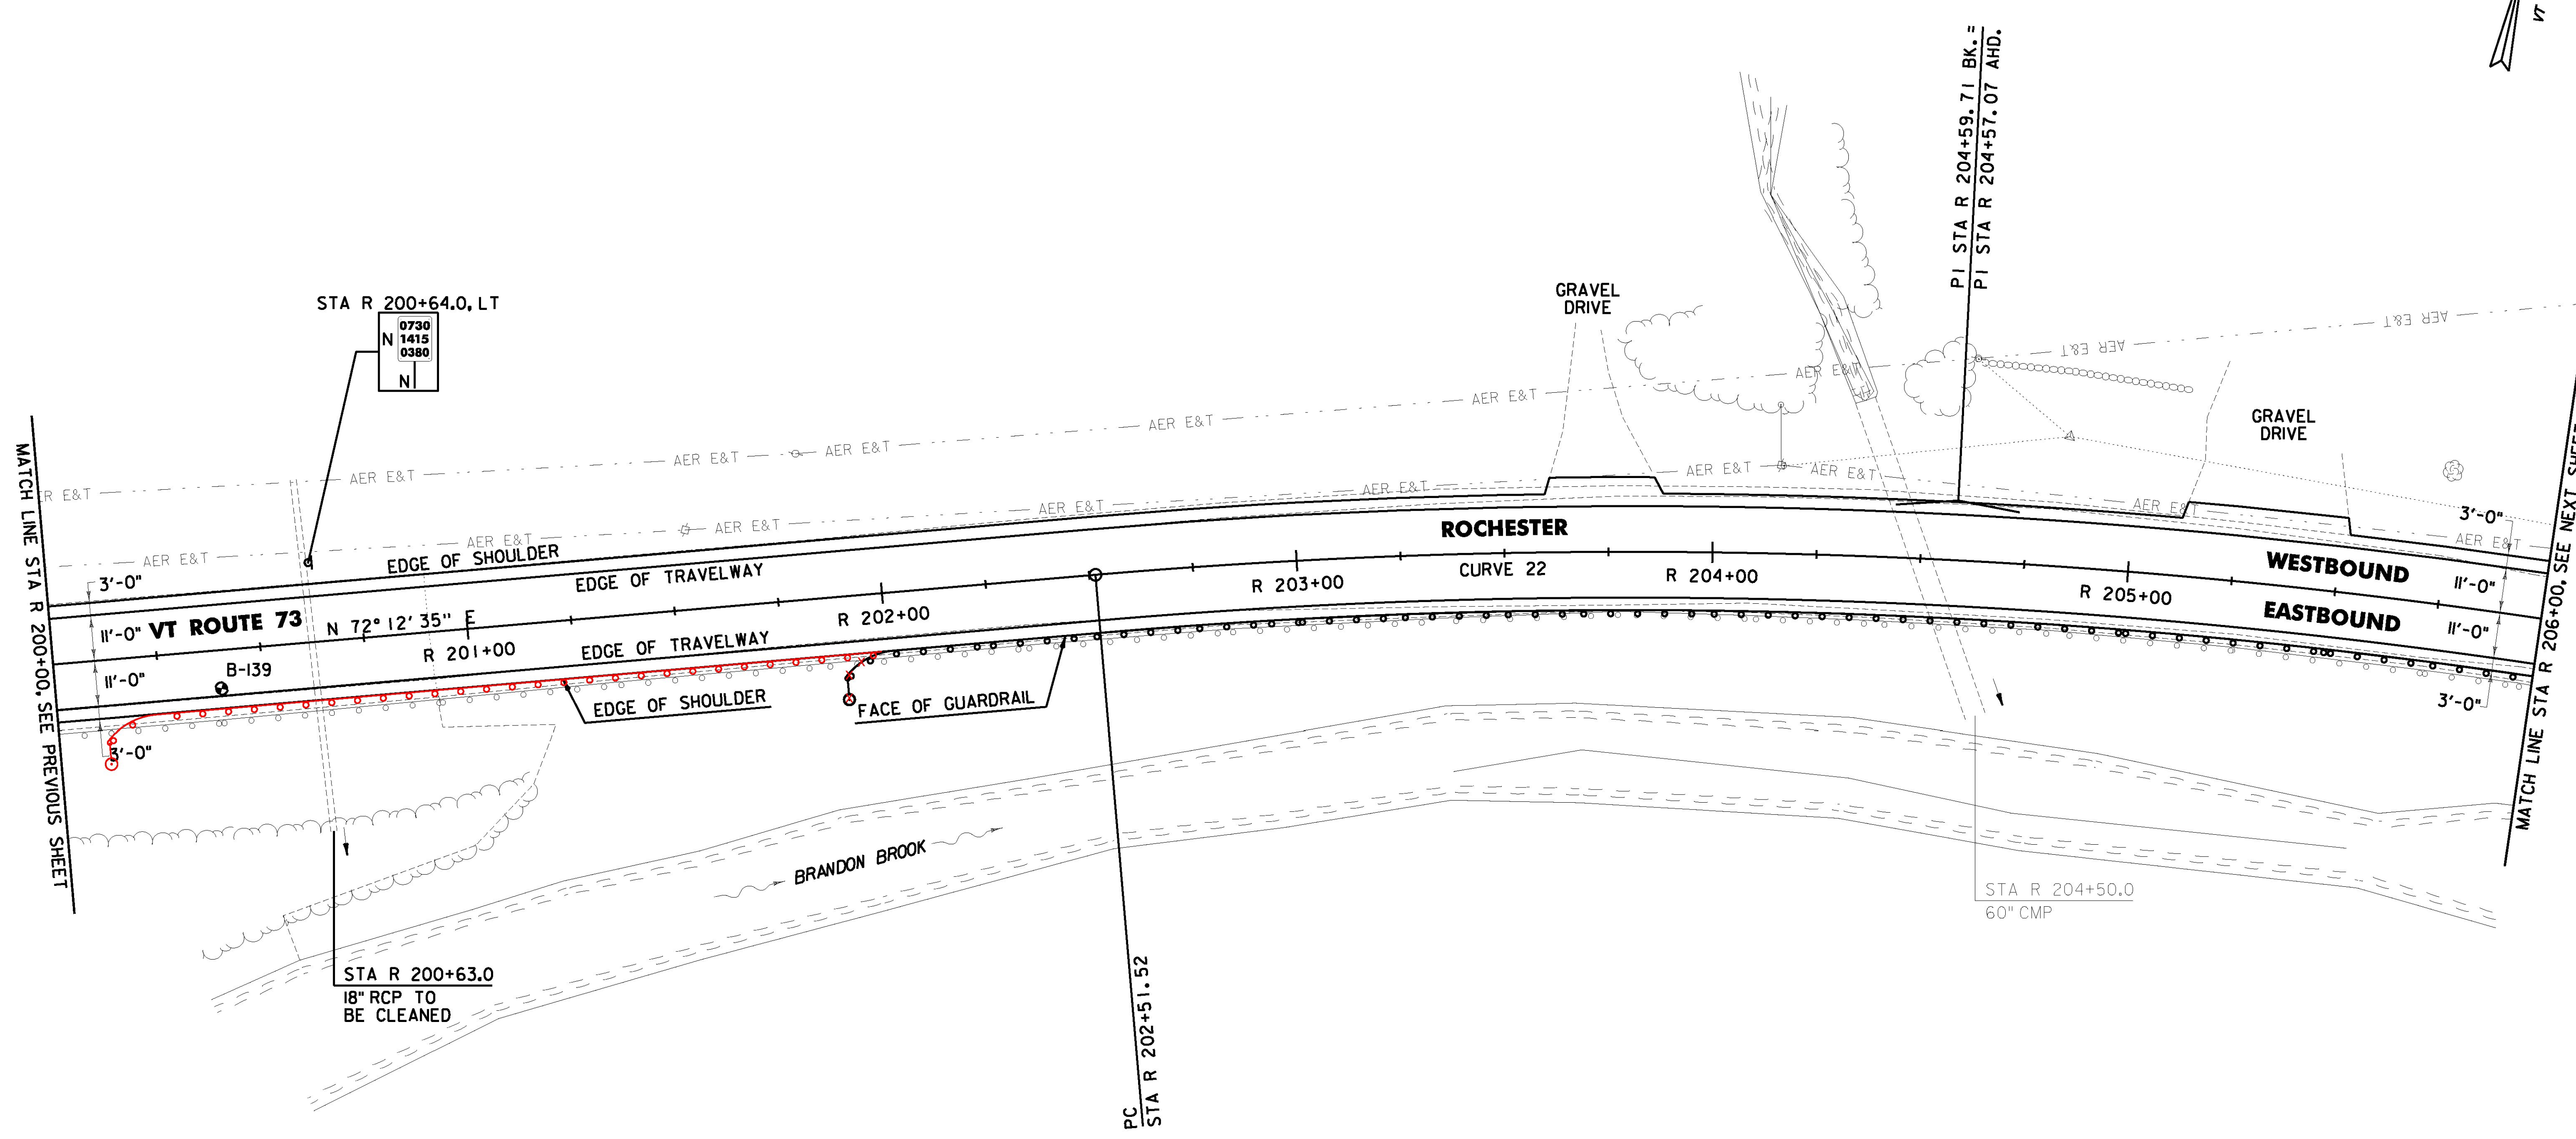


DURABLE 4 INCH WHITE LINE (OPTION ITEM) AND TEMPORARY 4 INCH WHITE LINE, PAINT (ALL LINES WILL INCLUDE EDGE LINE BREAKS AND RADIUS FOR TOWN HIGHWAYS)
 ROCHESTER:
 STA R 200+00.00 - STA R 206+00.00 LT & RT

DURABLE 4 INCH YELLOW LINE (OPTION ITEM) AND TEMPORARY 4 INCH YELLOW LINE, PAINT (ALL LINES WILL INCLUDE C/L BREAKS FOR TOWN HIGHWAYS) S = SOLID, D = DASHED
 ROCHESTER:
 STA R 200+00.00 - STA R 205+50.00 LT S
 STA R 205+50.00 - STA R 206+00.00 LT D

CLEANING CULV. PIPE IN-PLACE (0 TO 24 IN., INCL.)
 ROCHESTER:
 STA R 200+63.0 LT/RT

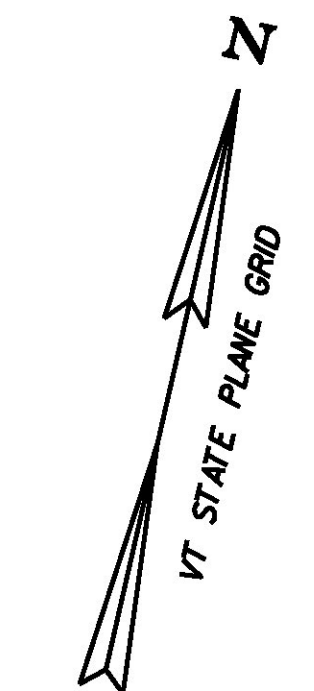

PROJECT DEMARCATION FENCE
 ROCHESTER:
~~STA R 200+00.0 - STA R 203+60.0 LT~~
~~STA R 200+00.0 - STA R 206+00.0 RT~~
~~STA R 203+88.0 - STA R 205+12.0 LT~~
~~STA R 205+51.0 - STA R 206+00.0 LT~~

STEEL BEAM GUARDRAIL, GALVANIZED W/ 8 FEET POSTS
 ROCHESTER:
 STA R 201+89.5 - STA R 206+00.0 RT

REMOVAL AND DISPOSAL OF GUARDRAIL
 ROCHESTER:
 STA R 200+00.0 - STA R 206+00.0 RT

ANCHOR FOR STEEL BEAM RAIL
 ROCHESTER:
 STA R 201+98.0 RT

DELINATOR WITH STEEL POST
 ROCHESTER:
 STA R 201+89.5 RT

SOIL BORING DATA			
BORING #	DEPTH (FT.)	PCC	COMMENTS
B-139	5.0	NO	

CURVE 22
 $\Delta = 15^{\circ} 48' 14''$ RT
 $D = 3^{\circ} 49' 11''$
 $R = 1500.00'$
 $T = 208.19'$
 $L = 413.74'$
 $E = 14.38'$
 $e = 0.062$ FT/FT

SIGN LEGEND
 R = REMOVE
 S = SALVAGE
 N = NEW
 RET = RETAIN
 B-B = BACK TO BACK
 EXISTING = - - - - -
 NEW = _____
 R = RETURN TO TOWN OF ROCHESTER



PROJECT NAME: ROCHESTER	PLOT DATE: 1/11/2017
PROJECT NUMBER: ER STP 0162(21)	DRAWN BY: J. HEALD
FILE NAME: z13cl76bdr.dgn	CHECKED BY: J. SHIELDS
DESIGNED BY: J. OLSEN	SHEET 67 OF 360
PROJECT LAYOUT SHEET #35	