
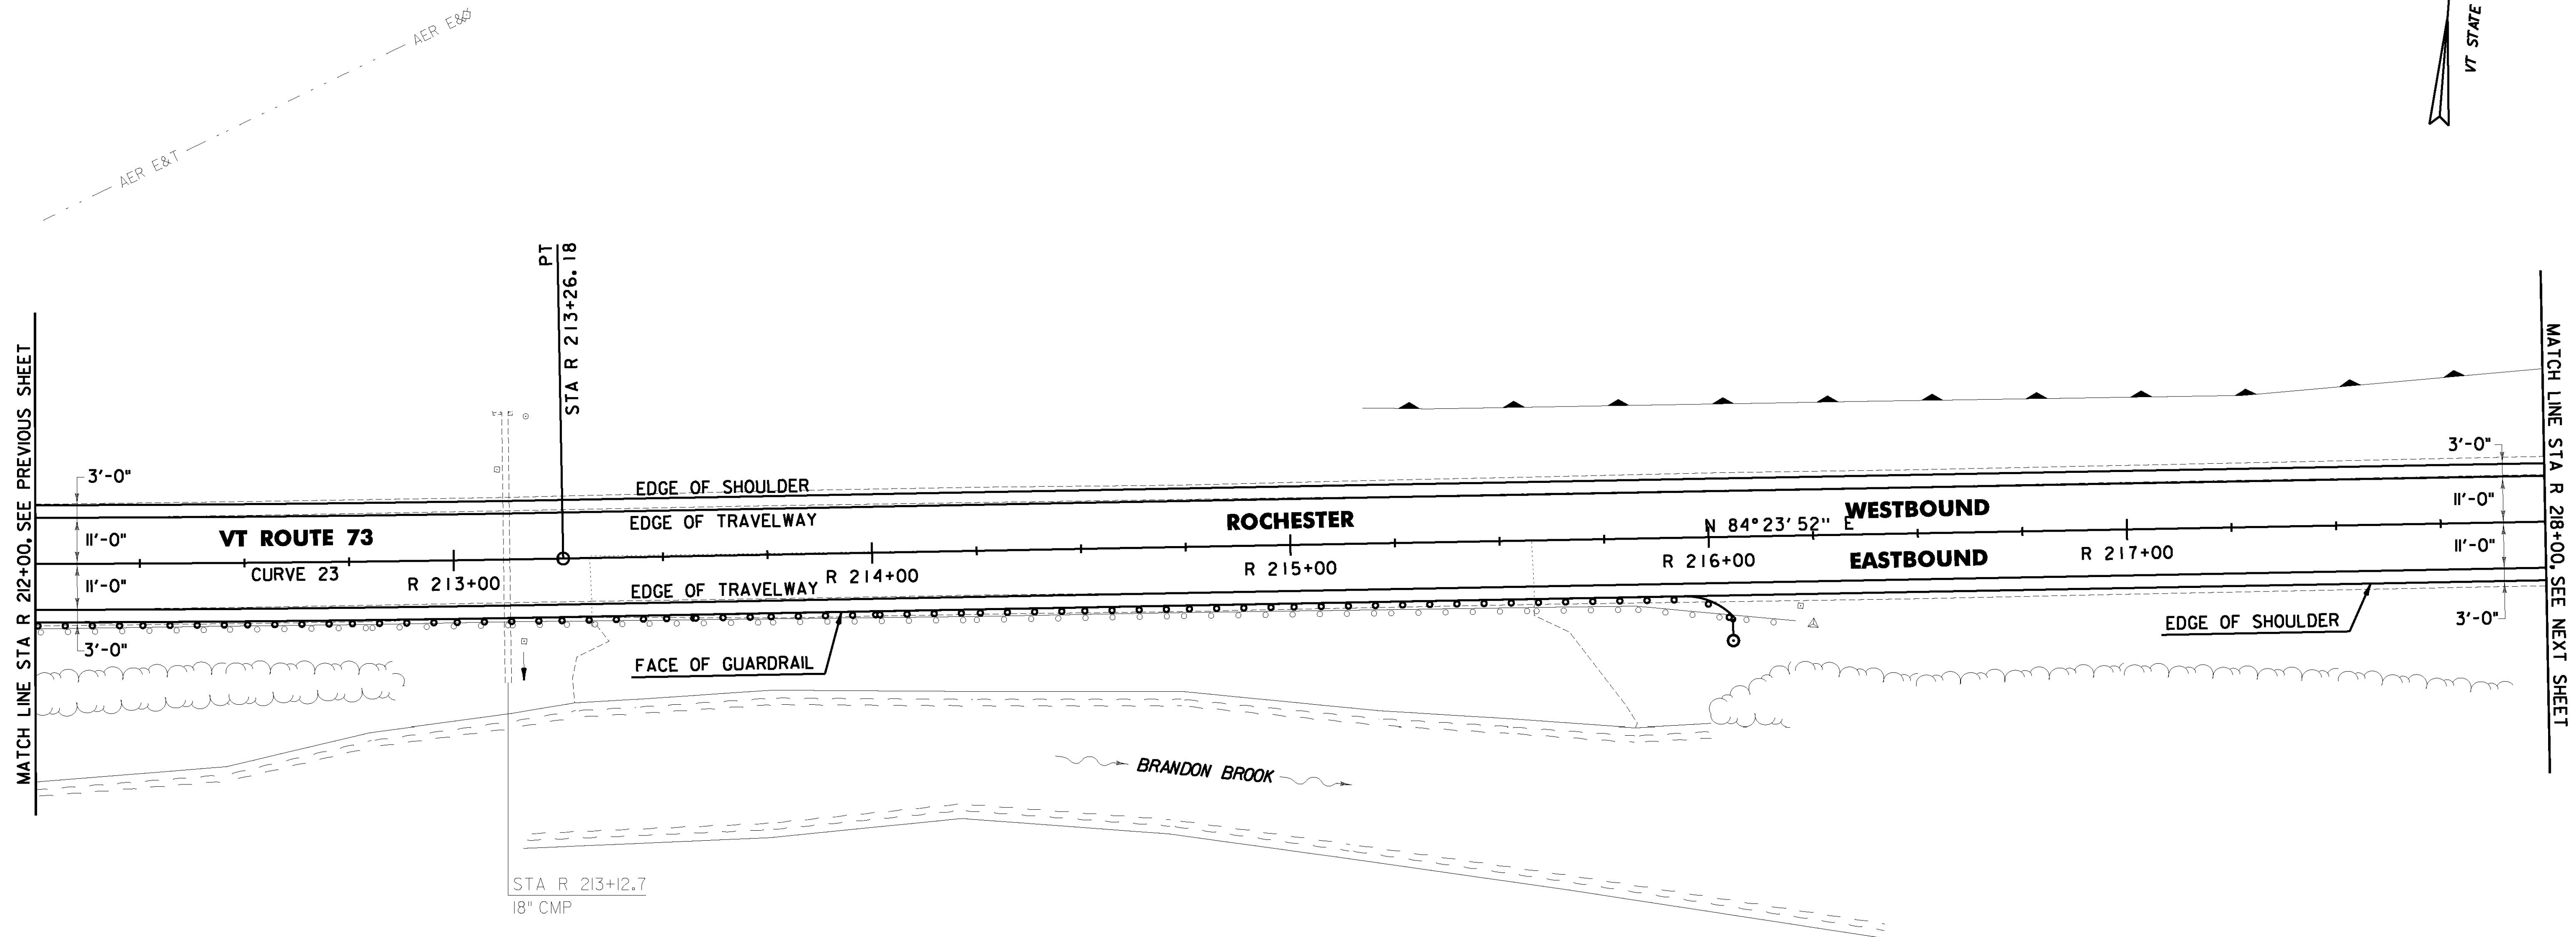


DURABLE 4 INCH WHITE LINE (OPTION ITEM)  
AND TEMPORARY 4 INCH WHITE LINE, PAINT  
(ALL LINES WILL INCLUDE EDGE LINE BREAKS AND  
RADIUS FOR TOWN HIGHWAYS)  
ROCHESTER:  
STA R 212+00.00 - STA R 218+00.00 LT & RT

DURABLE 4 INCH YELLOW LINE (OPTION ITEM) AND  
TEMPORARY 4 INCH YELLOW LINE, PAINT  
(ALL LINES WILL INCLUDE C/L BREAKS FOR TOWN  
HIGHWAYS) S = SOLID, D = DASHED  
ROCHESTER:  
STA R 212+00.00 - STA R 213+84.00 LT C RT  
- D -  
STA R 213+84.00 - STA R 218+00.00 D - S

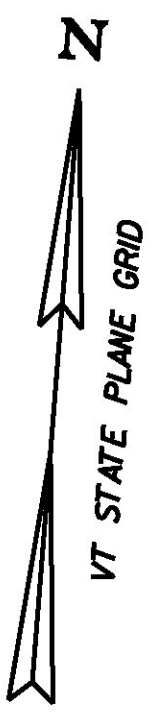

PROJECT DEMARCATION FENCE  
ROCHESTER:  
~~STA R 212+00.0 - STA R 218+00.0 LT & RT~~

BARRIER FENCE  
ROCHESTER:  
~~STA R 214+18.0 - STA R 218+00.0 LT~~

STEEL BEAM GUARDRAIL, GALVANIZED  
W/ 8 FEET POSTS  
ROCHESTER:  
STA R 212+00.0 - STA R 216+06.0 RT


ANCHOR FOR STEEL BEAM RAIL  
ROCHESTER:  
STA R 215+97.5 RT

REMOVAL AND DISPOSAL OF GUARDRAIL  
ROCHESTER:  
STA R 212+00.0 - STA R 216+20.0 RT

DELINEATOR WITH STEEL POST  
ROCHESTER:  
STA R 216+06.0 RT

**CURVE 23**  
Δ = 3°36'57" LT  
D = 0°45'50"  
R = 7500.00'  
T = 236.73'  
L = 473.31'  
E = 3.74'  
e = 0.020 FT/FT

**SIGN LEGEND**  
R = REMOVE  
S = SALVAGE  
N = NEW  
RET = RETAIN  
B-B = BACK TO BACK  
EXISTING = - - - - -  
NEW = \_\_\_\_\_  
R = RETURN TO TOWN  
⊙ OF ROCHESTER

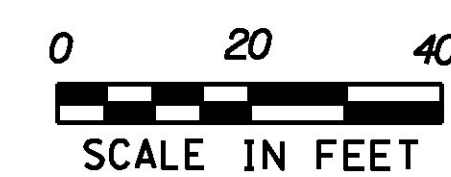

PROJECT NAME: ROCHESTER	
PROJECT NUMBER: ER STP 0162(21)	
FILE NAME: z13cl76bdr.dgn	PLOT DATE: 1/11/2017
PROJECT LEADER: D. GOZALKOWSKI	DRAWN BY: J. HEALD
DESIGNED BY: J. OLSEN	CHECKED BY: J. SHIELDS
PROJECT LAYOUT SHEET #37	SHEET 69 OF 360