



DURABLE 4 INCH WHITE LINE (OPTION ITEM) AND TEMPORARY 4 INCH WHITE LINE PAINT (ALL LINES WILL INCLUDE EDGE LINE BREAKS AND RADIUS FOR TOWN HIGHWAYS)
 ROCHESTER:
 STA R 224+00.00 - STA R 230+00.00 LT & RT

DURABLE 4 INCH YELLOW LINE (OPTION ITEM) AND TEMPORARY 4 INCH YELLOW LINE PAINT (ALL LINES WILL INCLUDE C/L BREAKS FOR TOWN HIGHWAYS) S = SOLID, D = DASHED
 ROCHESTER:
 STA R 224+00.00 - STA R 230+00.00 S - S

LT C RT
 S - S

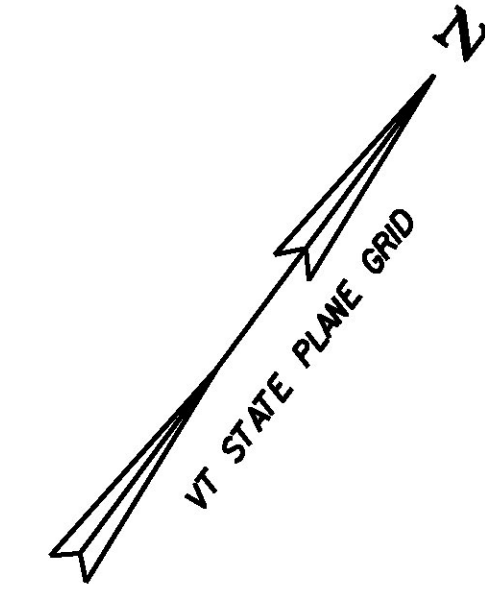

PI STA R 229+61.06 BK. =
 PI STA R 229+60.25 AHD.

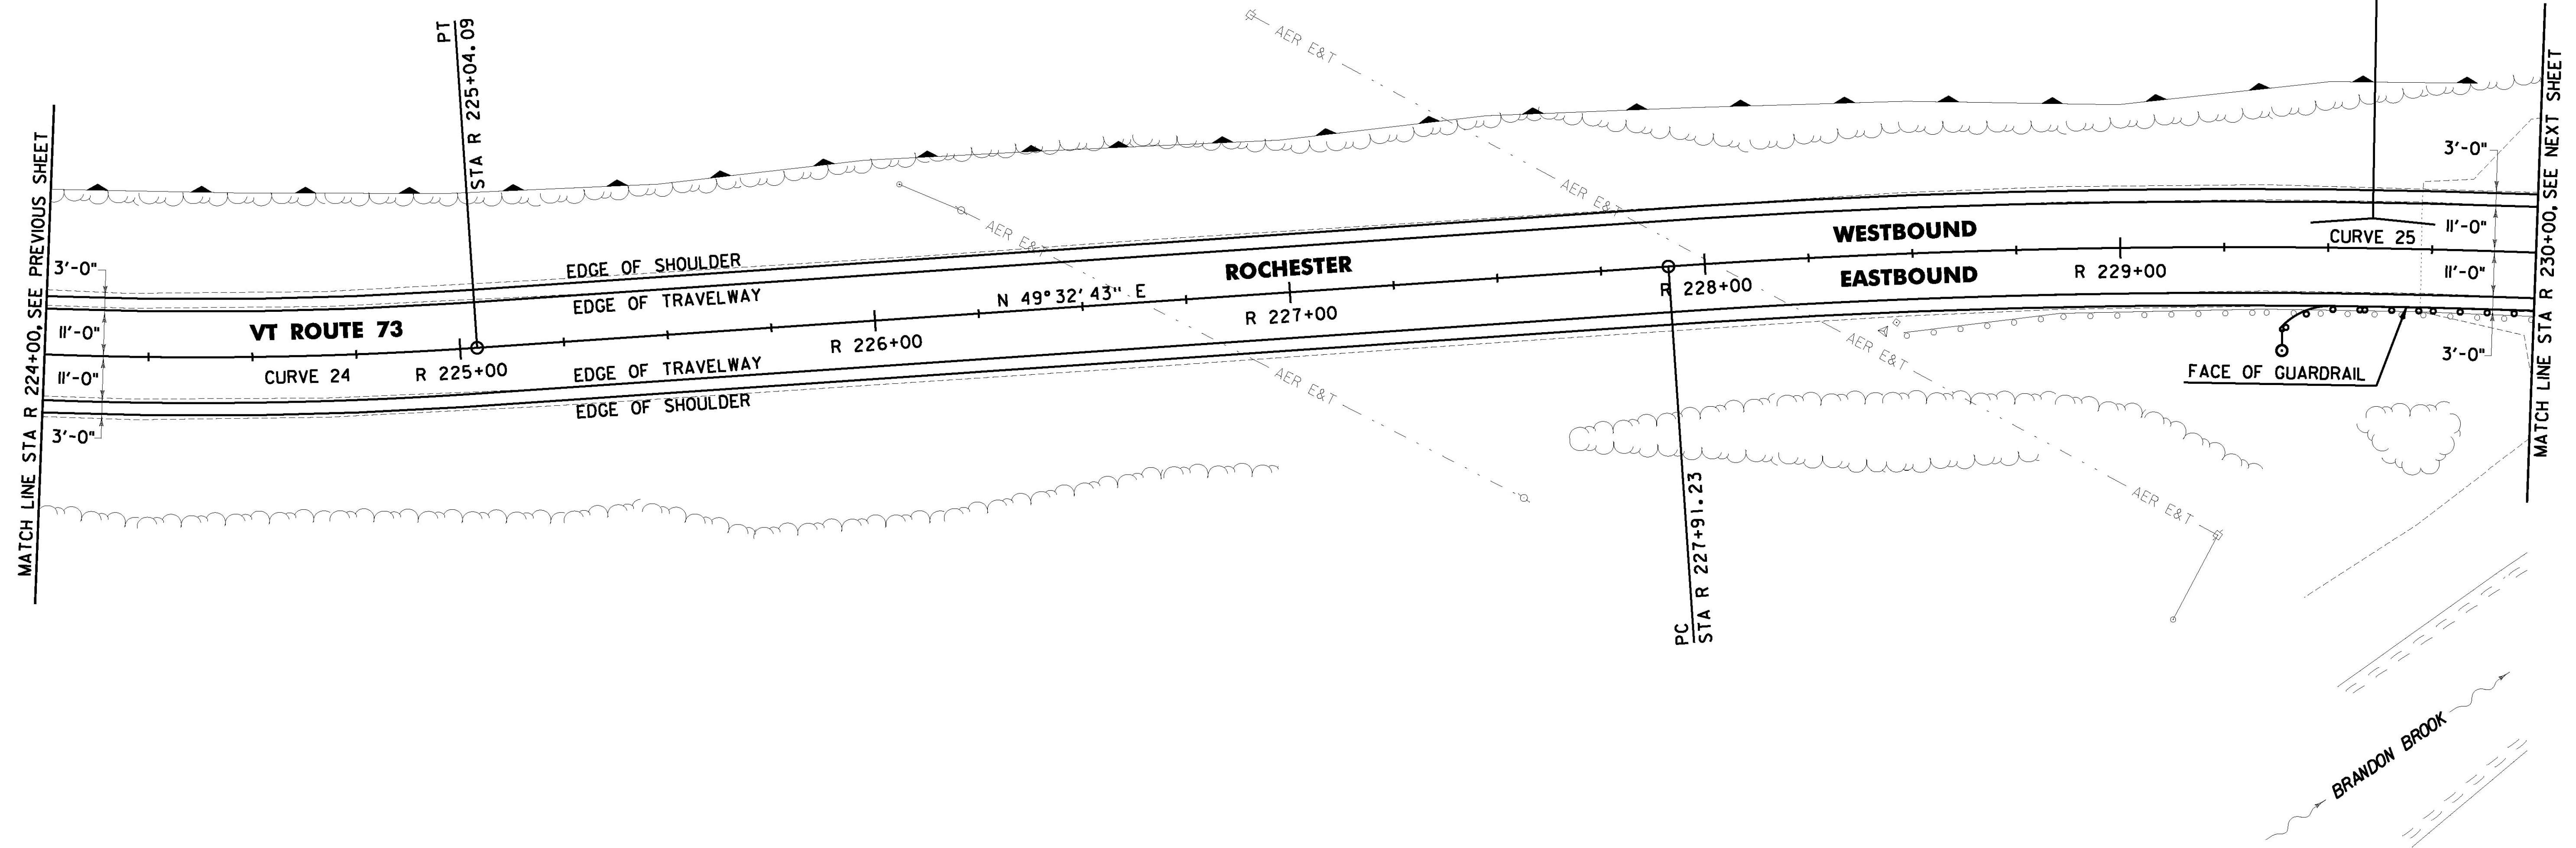

PROJECT DEMARCATION FENCE
 ROCHESTER:
~~STA R 224+00.0 - STA R 230+00.0 LT & RT~~

BARRIER FENCE
 ROCHESTER:
~~STA R 224+00.0 - STA R 230+00.0 LT~~
 R 226+30.0

STEEL BEAM GUARDRAIL, GALVANIZED
 W/ 8 FEET POSTS
 ROCHESTER:
 STA R 229+38.5 - STA R 230+00.0 RT

ANCHOR FOR STEEL BEAM RAIL
 ROCHESTER:
 STA R 229+47.0 RT


REMOVAL AND DISPOSAL OF GUARDRAIL
 ROCHESTER:
 STA R 228+47.0 - STA R 230+00.0 RT

DELINEATOR WITH STEEL POST
 ROCHESTER:
 STA R 229+38.5 RT

CURVE 24
 $\Delta = 34^{\circ}51'09''$ LT
 $D = 5^{\circ}50'47''$
 $R = 980.00'$
 $T = 307.61'$
 $L = 596.12'$
 $E = 47.14'$
 $e = 0.076$ FT/FT

CURVE 25
 $\Delta = 9^{\circ}42'26''$ RT
 $D = 2^{\circ}51'53''$
 $R = 2000.00'$
 $T = 169.83'$
 $L = 338.85'$
 $E = 7.20'$
 $e = 0.052$ FT/FT

SIGN LEGEND
 R = REMOVE
 S = SALVAGE
 N = NEW
 RET = RETAIN
 B-B = BACK TO BACK
 EXISTING = _____
 NEW = _____
 R = RETURN TO TOWN
 O = OF ROCHESTER

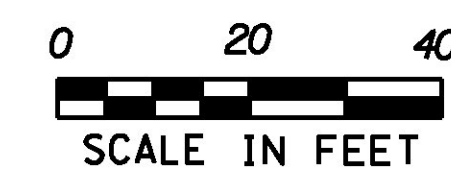

PROJECT NAME: ROCHESTER
 PROJECT NUMBER: ER STP 0162(21)

FILE NAME: z13cl76bdr.dgn
 PROJECT LEADER: D. GOZALKOWSKI
 DESIGNED BY: J. OLSEN
 PROJECT LAYOUT SHEET #39

PLOT DATE: 1/11/2017
 DRAWN BY: J. HEALD
 CHECKED BY: J. SHIELDS
 SHEET 71 OF 360