
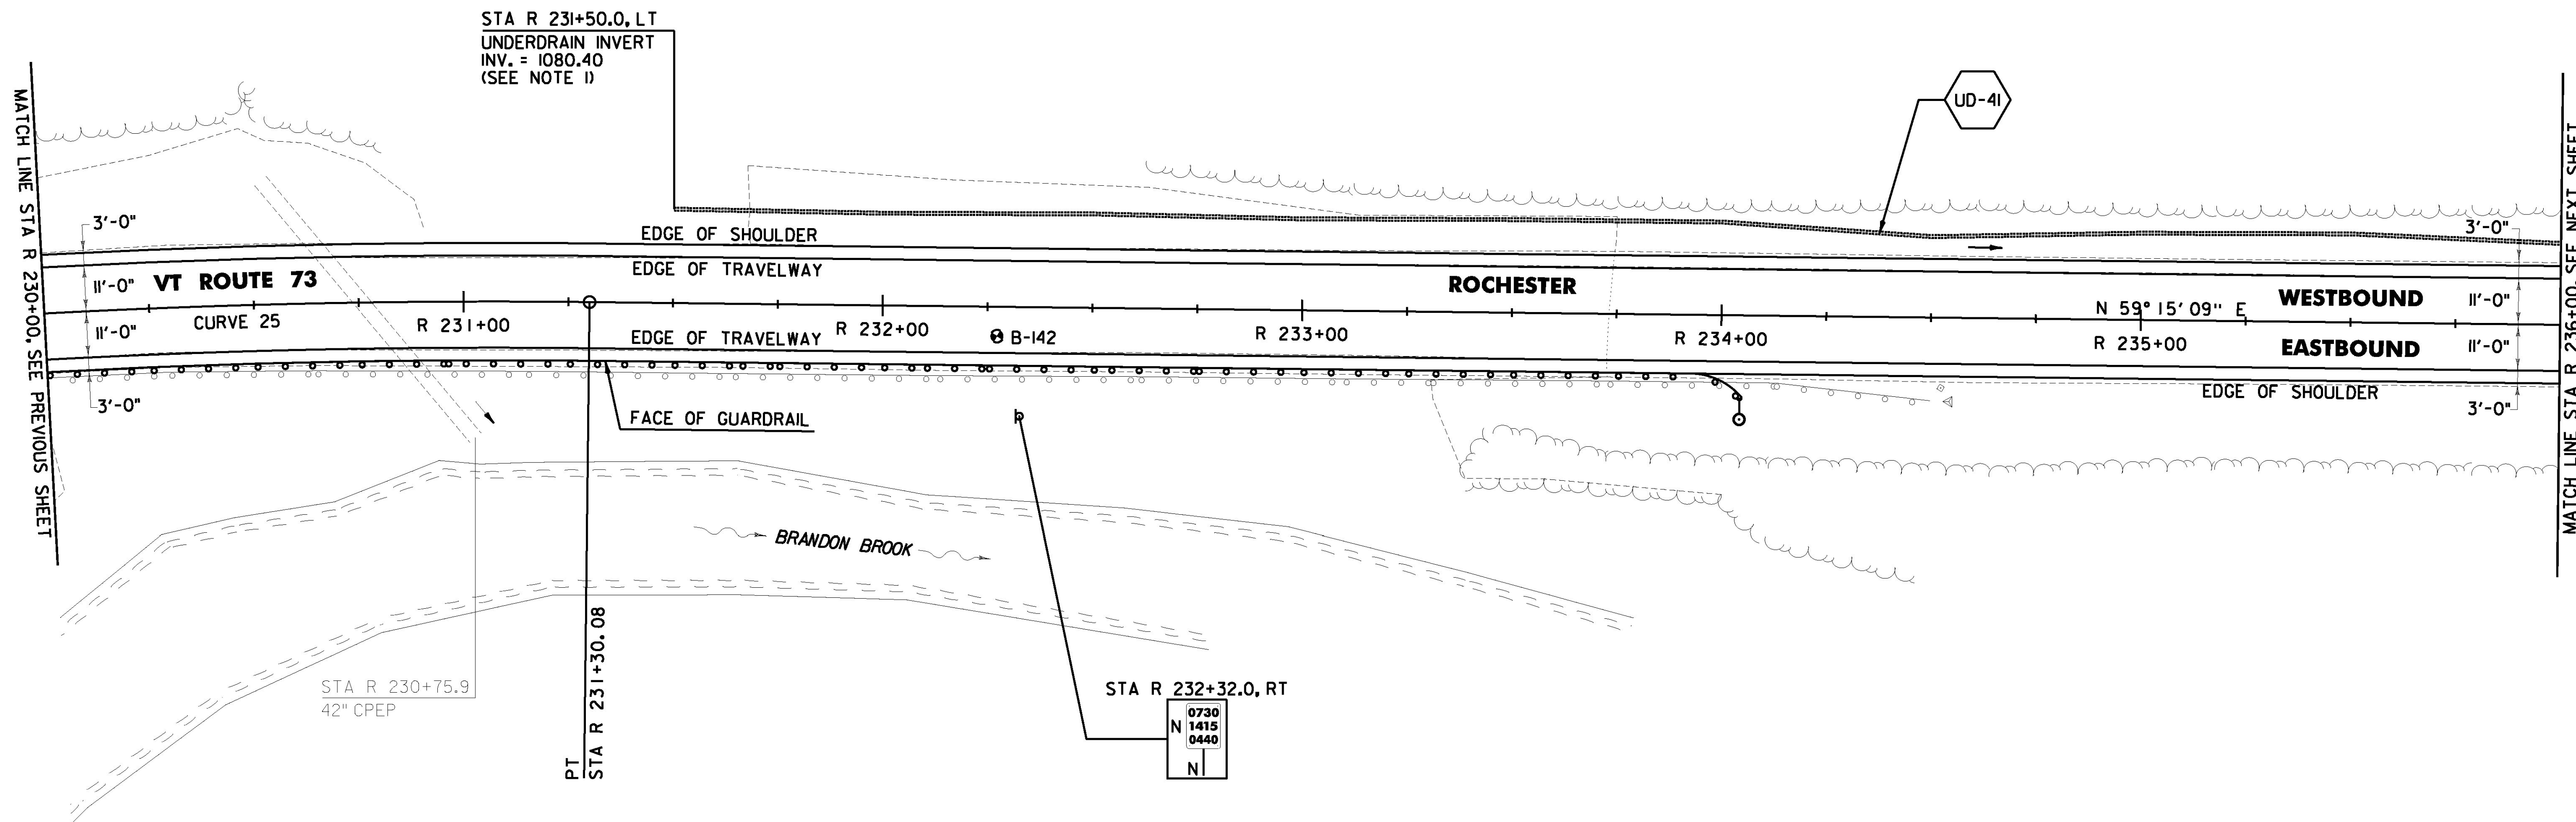


DURABLE 4 INCH WHITE LINE (OPTION ITEM)
AND TEMPORARY 4 INCH WHITE LINE, PAINT
(ALL LINES WILL INCLUDE EDGE LINE BREAKS AND
RADIUS FOR TOWN HIGHWAYS)
ROCHESTER:
STA R 230+00.00 - STA R 236+00.00 LT & RT

DURABLE 4 INCH YELLOW LINE (OPTION ITEM) AND
TEMPORARY 4 INCH YELLOW LINE, PAINT
(ALL LINES WILL INCLUDE C/L BREAKS FOR TOWN
HIGHWAYS) S = SOLID, D = DASHED
ROCHESTER:
STA R 230+00.00 - STA R 236+00.00 LT C RT
S S S

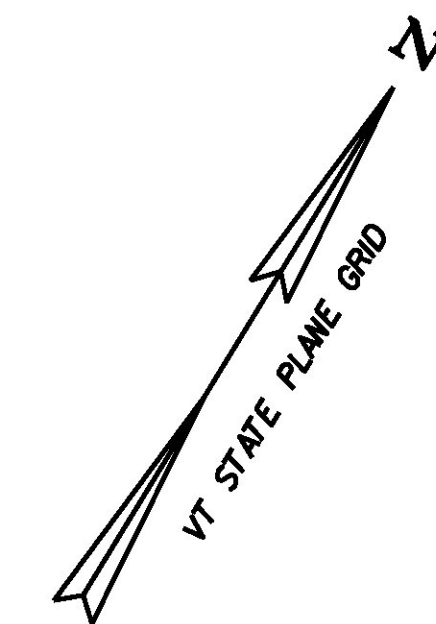

PROJECT DEMARCATION FENCE
ROCHESTER:
~~STA R 230+00.0 - STA R 236+00.0 LT & RT~~

BARRIER FENCE
ROCHESTER: R 230+30.0
STA R 230+00.0 - STA R 230+85.0 LT

STEEL BEAM GUARDRAIL, GALVANIZED
W/ 8 FEET POSTS
ROCHESTER:
STA R 230+00.0 - STA R 234+05.0 RT

ANCHOR FOR STEEL BEAM RAIL
ROCHESTER:
STA R 233+96.5 RT


6 INCH UNDERDRAIN PIPE
ROCHESTER:
STA R 231+50.0 - STA R 236+00.0 LT

REMOVAL AND DISPOSAL OF GUARDRAIL
ROCHESTER:
STA R 230+00.0 - STA R 234+50.0 RT

DELINEATOR WITH STEEL POST
ROCHESTER:
STA R 234+05.0 RT

SOIL BORING DATA			
BORING #	DEPTH (FT.)	PCC	COMMENTS
B-142	5.0	NO	

CURVE 25
 $\Delta = 9^{\circ} 42' 26''$ RT
 $D = 2^{\circ} 51' 53''$
 $R = 2000.00'$
 $T = 169.83'$
 $L = 338.85'$
 $E = 7.20'$
 $e = 0.052$ FT/FT

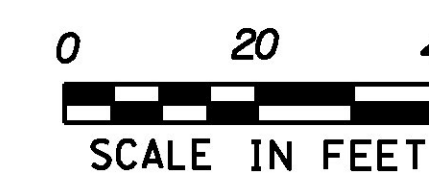

NOTE:
I. SEE SHEETS 26 & 27 FOR UNDERDRAIN DETAILS.

PROJECT NAME: ROCHESTER	PLOT DATE: 1/11/2017
PROJECT NUMBER: ER STP 0162(21)	DRAWN BY: J. HEALD
FILE NAME: z13cl76bdr.dgn	CHECKED BY: J. SHIELDS
PROJECT LEADER: D. GOZALKOWSKI	SHEET 72 OF 360
DESIGNED BY: J. OLSEN	
PROJECT LAYOUT SHEET #40	