
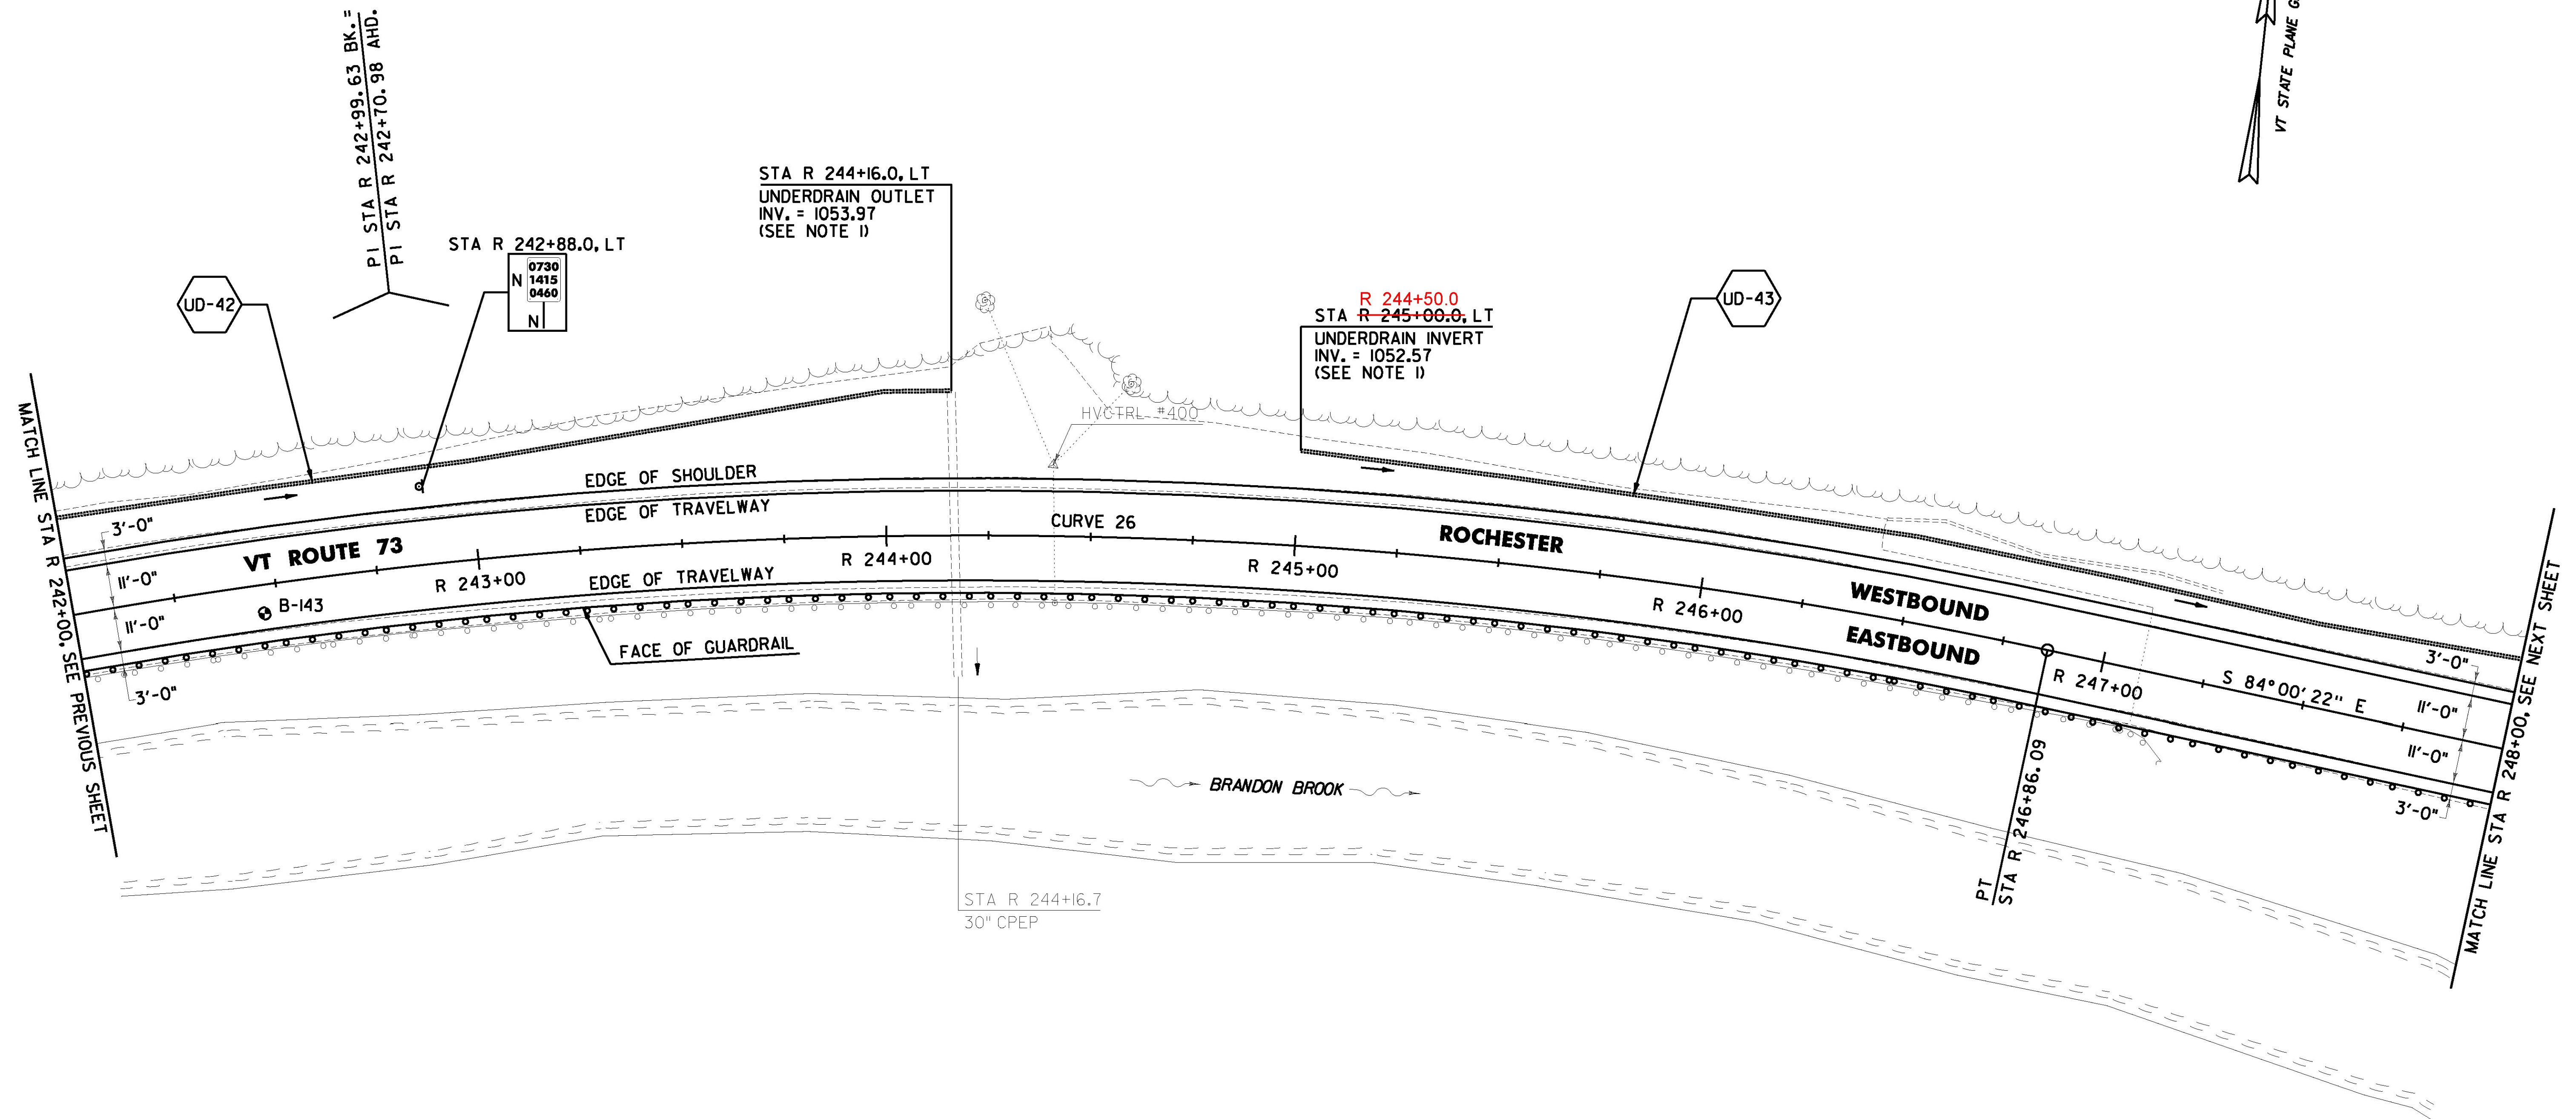


DURABLE 4 INCH WHITE LINE (OPTION ITEM)  
AND TEMPORARY 4 INCH WHITE LINE, PAINT  
(ALL LINES WILL INCLUDE EDGE LINE BREAKS AND  
RADIUS FOR TOWN HIGHWAYS)  
ROCHESTER:  
STA R 242+00.00 - STA R 248+00.00 LT & RT

DURABLE 4 INCH YELLOW LINE (OPTION ITEM) AND  
TEMPORARY 4 INCH YELLOW LINE, PAINT  
(ALL LINES WILL INCLUDE C/L BREAKS FOR TOWN  
HIGHWAYS) S = SOLID, D = DASHED  
ROCHESTER:  
STA R 242+00.00 - STA R 248+00.00 LT & RT  
LT C RT  
S - S

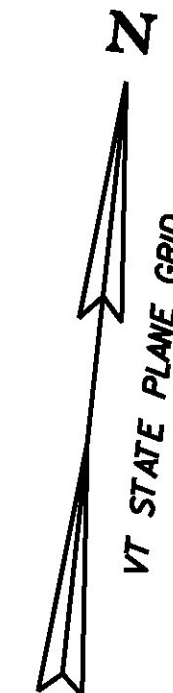

SOIL BORING DATA			
BORING #	DEPTH (FT.)	PCC	COMMENTS
B-143	5.0	NO	


NOTE:  
1. SEE SHEETS 26 & 27 FOR UNDERDRAIN DETAILS.

PROJECT DEMARCATION FENCE  
ROCHESTER:  
~~STA R 242+00.0 - STA R 248+00.0 LT & RT~~  
STEEL BEAM GUARDRAIL, GALVANIZED  
W/ 8 FEET POSTS  
ROCHESTER:  
STA R 242+00.0 - STA R 248+00.0 RT

6 INCH UNDERDRAIN PIPE  
ROCHESTER:  
STA R 242+00.0 - STA R 244+16.0 LT  
STA R 245+00.0 - STA R 248+00.0 LT  
REMOVAL AND DISPOSAL OF GUARDRAIL  
ROCHESTER:  
STA R 242+00.0 - STA R 247+19.0 RT

CURVE 26  
Δ = 36° 44' 28" RT  
D = 4° 35' 01"  
R = 1250.00'  
T = 415.11'  
L = 801.57'  
E = 67.12'  
e = 0.070 FT/FT

SIGN LEGEND  
R = REMOVE  
S = SALVAGE  
N = NEW  
RET = RETAIN  
B-B = BACK TO BACK  
EXISTING = \_\_\_\_\_  
NEW = \_\_\_\_\_  
R = RETURN TO TOWN  
⊙ OF ROCHESTER

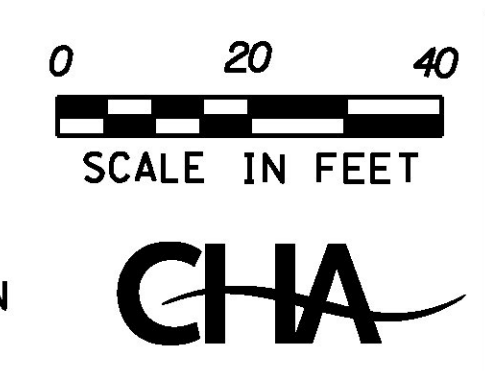

PROJECT NAME: ROCHESTER  
PROJECT NUMBER: ER STP 0162(21)  
FILE NAME: z13cl76bdr.dgn  
PROJECT LEADER: D. GOZALKOWSKI  
DESIGNED BY: J. OLSEN  
PROJECT LAYOUT SHEET #42  
PLOT DATE: 1/11/2017  
DRAWN BY: J. HEALD  
CHECKED BY: J. SHIELDS  
SHEET 74 OF 360