

DURABLE 4 INCH WHITE LINE (OPTION ITEM) AND TEMPORARY 4 INCH WHITE LINE, PAINT
 (ALL LINES WILL INCLUDE EDGE LINE BREAKS AND RADIUS FOR TOWN HIGHWAYS)
 CHITTENDEN:
 STA C 7+00.00 - STA C 7+04.54 LT & RT
 ROCHESTER:
 STA R 252+17.87 - STA R 258+00.00 LT & RT

DURABLE 4 INCH YELLOW LINE (OPTION ITEM) AND TEMPORARY 4 INCH YELLOW LINE, PAINT
 (ALL LINES WILL INCLUDE C/L BREAKS FOR TOWN HIGHWAYS) S = SOLID, D = DASHED
 CHITTENDEN: LT C RT
 STA C 7+00.00 - STA C 7+04.54 S - S
 ROCHESTER:
 STA R 252+17.87 - STA R 258+00.00 S - S

DURABLE LETTER OR SYMBOL (OPTION ITEM)
 ROCHESTER:
 STA R 256+81.50 RT, "S,L,O,W" (4 EA)
 STA R 256+97.25 RT, ARROW (1EA)
TEMPORARY LETTER OR SYMBOL, PAINT
 ROCHESTER:
 STA R 256+81.50 RT, "S,L,O,W" (8 EA)
 STA R 256+97.25 RT, ARROW (2 EA)


DURABLE 24 INCH STOP BAR (OPTION ITEM) AND 24 INCH STOP BAR, PAINT
 ROCHESTER:
 STA R 257+74.00 RT
 STA R 257+07.50 RT

REMOVING SIGNS AS SHOWN - 4

END CHITTENDEN
 VT. ROUTE 73
 MM 0.133 = STA C 7+04.54
 RESUME ROCHESTER
 VT. ROUTE 73
 MM 4.776 = STA R 252+17.87

STA R 252+17.87, LT	
R	CHITTENDEN
R	ROCHESTER
R	RUTLAND CO. WINDSOR CO.
R	0730
R	1415
R	0477
R	0730
R	1104
R	0014

STA R 252+17.87, LT	
N	Chittenden
N	Rochester
N	Rutland Co Windsor Co
N	0730
N	1104
N	0014
N	0730
N	1415
N	0477

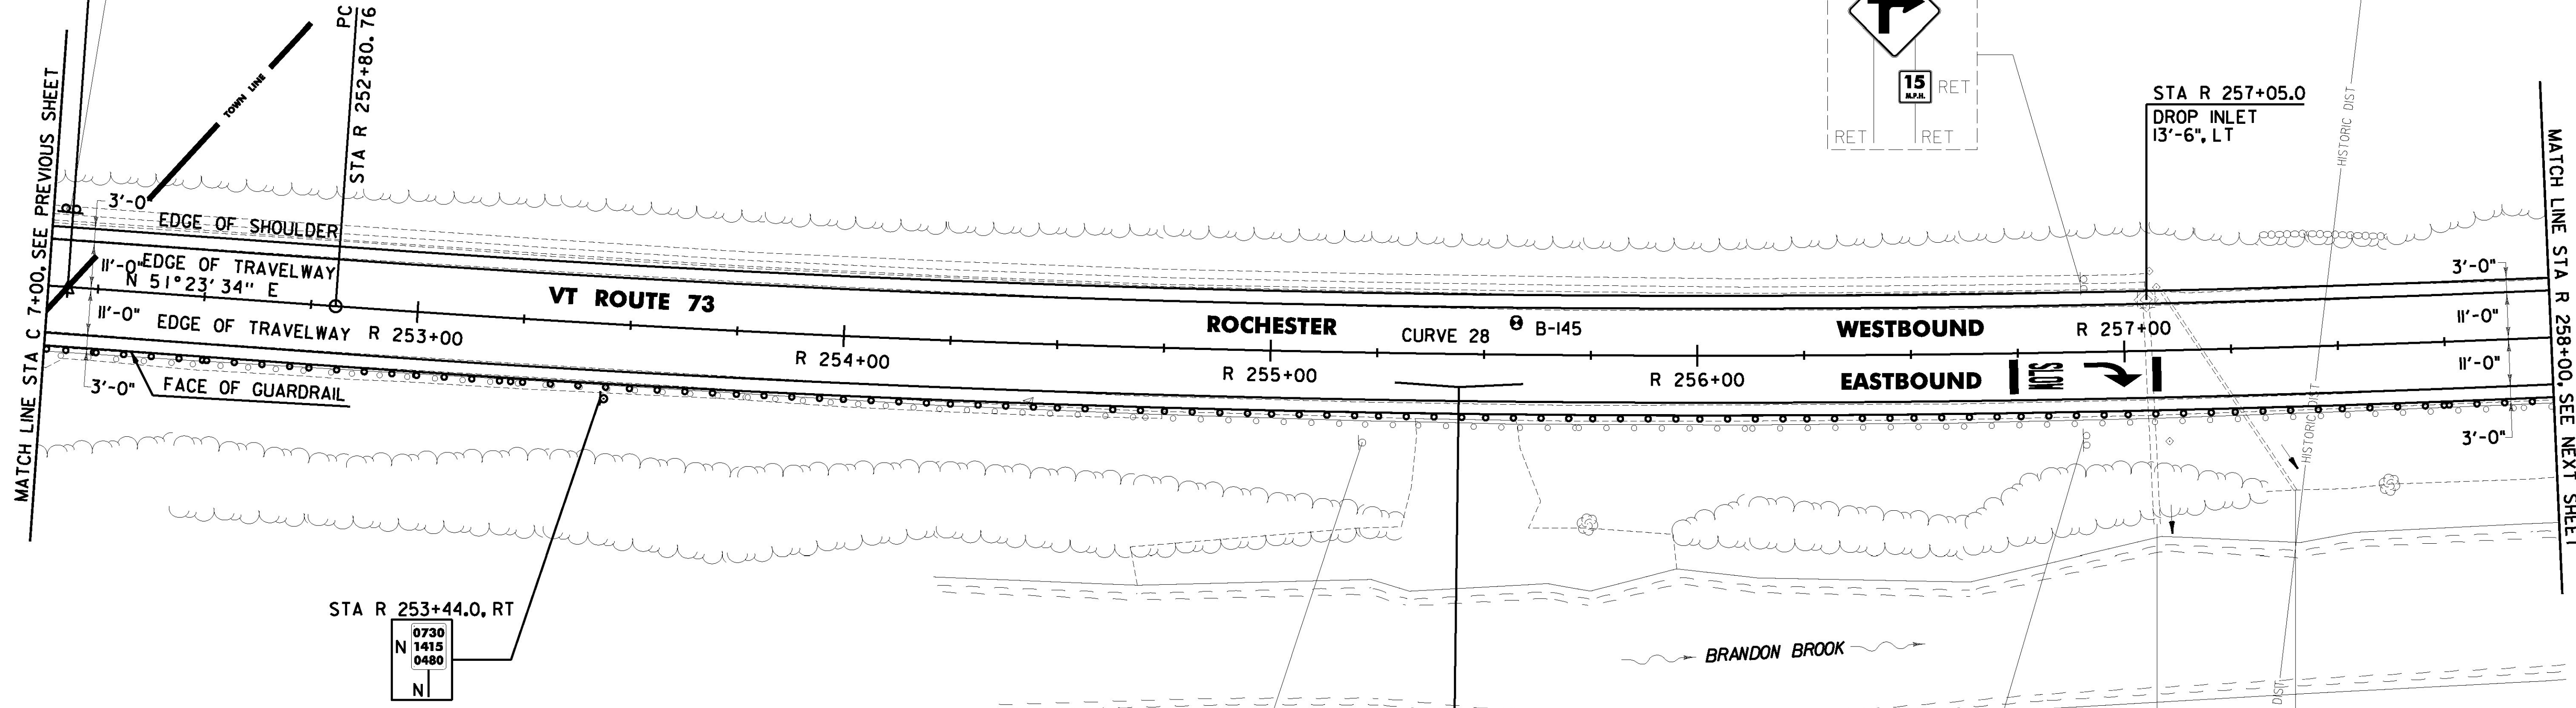

PROJECT DEMARCATION FENCE
 CHITTENDEN:
 STA C 7+00.0 - STA C 7+04.54 LT & RT
 ROCHESTER:
 STA R 252+17.87 - STA R 258+00.0 LT & RT
BARRIER FENCE
 ROCHESTER:
 STA R 256+46.0 - STA R 258+00.0 LT & RT
REHAB DROP INLETS, CATCH BASINS OR MANHOLES CLASS I, II OR III (SEE NOTE 1)
 ROCHESTER:
 STA R 257+05.0, LT


STEEL BEAM GUARDRAIL, GALVANIZED W/ 8 FEET POSTS
 CHITTENDEN:
 STA C 7+00.0 - STA C 7+04.54 RT
 ROCHESTER:
 STA R 252+17.87 - STA R 258+00.0 RT

REMOVAL AND DISPOSAL OF GUARDRAIL
 CHITTENDEN:
 STA C 7+00.0 - STA C 7+04.54 RT
 ROCHESTER:
 STA R 252+17.87 - STA R 258+00.0 RT

SOIL BORING DATA			
BORING #	DEPTH (FT.)	PCC	COMMENTS
B-145	5.0	NO	AUGERS GRINDING 0.7' TO 5.0'

NOTE:
 1. THE CONTRACTOR SHALL REHABILITATE THE EXISTING DROP INLETS, CATCH BASINS OR MANHOLES TO A DEPTH AS DIRECTED BY THE ENGINEER. ALL REHABILITATION WORK WILL BE PAID FOR UNDER THE APPLICABLE REHABILITATION ITEM AS DIRECTED BY THE ENGINEER. ALL EXISTING UTILITIES MARKED "TO REMAIN" SHALL NOT BE ALTERED OR REHABILITATED UNLESS DIRECTED OTHERWISE BY THE ENGINEER.

SIGN LEGEND
 R = REMOVE
 S = SALVAGE
 N = NEW
 RET = RETAIN
 B-B = BACK TO BACK
 EXISTING = _____
 NEW = _____
 R = RETURN TO TOWN OF ROCHESTER

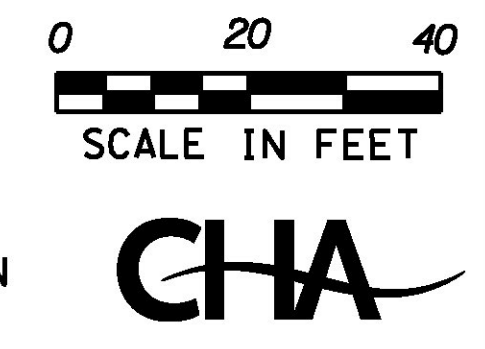

CURVE 28
 Δ = 6° 42' 32" LT
 D = 1° 16' 24"
 R = 4500.00'
 T = 263.76'
 L = 526.91'
 E = 7.72'
 e = 0.026 FT/FT

PROJECT NAME: ROCHESTER
 PROJECT NUMBER: ER STP 0162(21)
 FILE NAME: z13cl76bdr.dgn
 PROJECT LEADER: D. GOZALKOWSKI
 DESIGNED BY: J. OLSEN
 PROJECT LAYOUT SHEET #45
 PLOT DATE: 1/11/2017
 DRAWN BY: J. HEALD
 CHECKED BY: J. SHIELDS
 SHEET 77 OF 360