
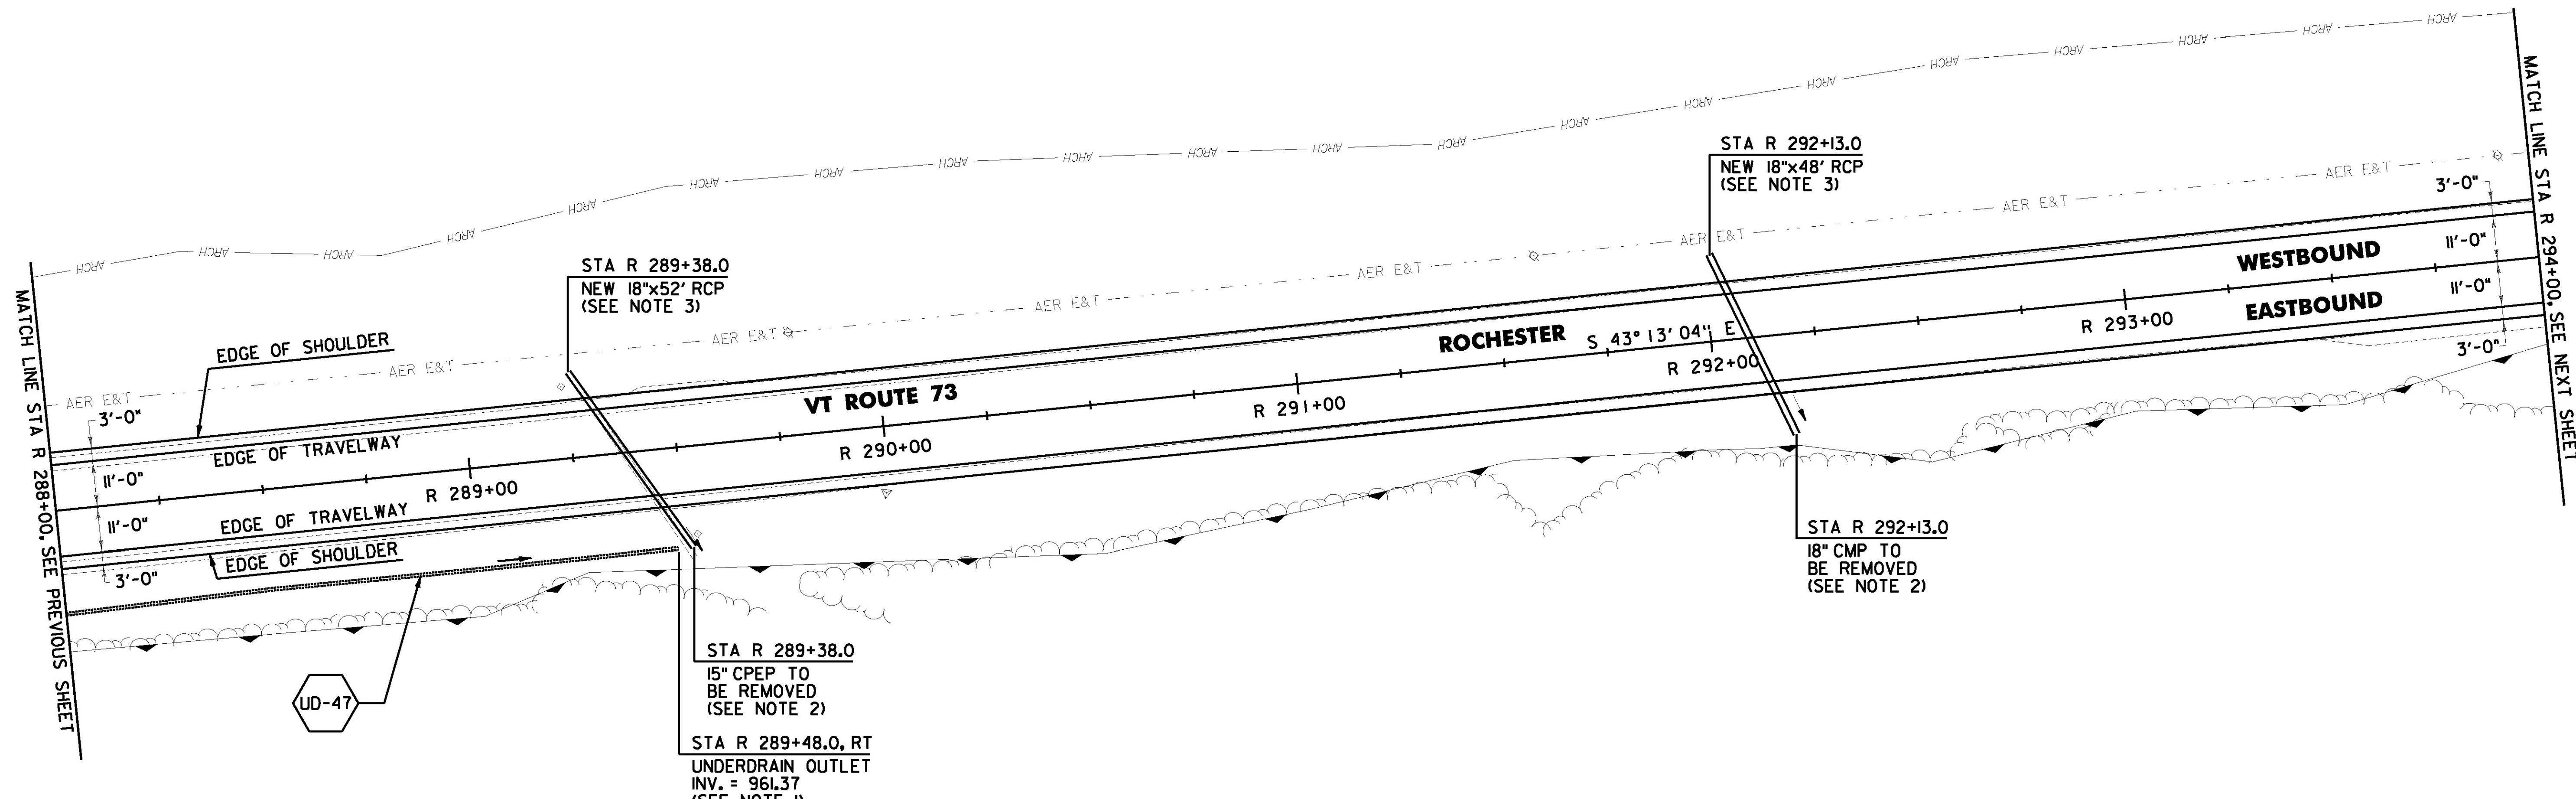


DURABLE 4 INCH WHITE LINE (OPTION ITEM)
AND TEMPORARY 4 INCH WHITE LINE, PAINT
(ALL LINES WILL INCLUDE EDGE LINE BREAKS AND
RADIUS FOR TOWN HIGHWAYS)
ROCHESTER:
STA R 288+00.00 - STA R 294+00.00 LT & RT

DURABLE 4 INCH YELLOW LINE (OPTION ITEM) AND
TEMPORARY 4 INCH YELLOW LINE, PAINT
(ALL LINES WILL INCLUDE C/L BREAKS FOR TOWN
HIGHWAYS) S = SOLID, D = DASHED
ROCHESTER:
STA R 288+00.00 - STA R 290+40.00 LT $\frac{C}{S}$ RT
STA R 290+40.00 - STA R 291+98.00 - D -
STA R 291+98.00 - STA R 294+00.00 D - S

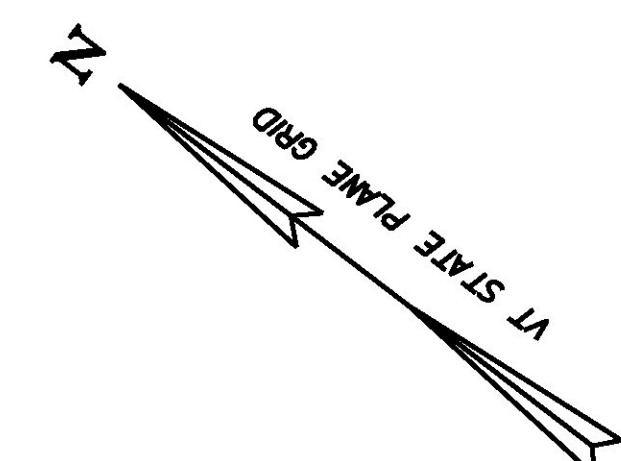

6 INCH UNDERDRAIN PIPE
ROCHESTER:
STA R 288+00.0 - STA R 289+48.0 RT
PROJECT DEMARCATION FENCE
ROCHESTER:
STA R 288+00.0 - STA R 294+00.0 LT & RT
R 292+75.0 LT & RT
BARRIER FENCE
ROCHESTER:
~~STA R 288+00.0 - STA R 294+00.0 LT & RT~~

SIGN LEGEND
R = REMOVE
S = SALVAGE
N = NEW
RET = RETAIN
B-B = BACK TO BACK
EXISTING =
NEW =
R = RETURN TO TOWN
OF ROCHESTER

0 20 40
SCALE IN FEET
CHA

- NOTES:**
- SEE SHEETS 26 & 27 FOR UNDERDRAIN DETAILS.
 - THE CONTRACTOR SHALL PERFORM ALL EXCAVATION REQUIRED TO REMOVE THE EXISTING PIPE AND INSTALL THE PROPOSED PIPE UNDER ITEM 204.20 TRENCH EXCAVATION OF EARTH AS DIRECTED BY THE ENGINEER.
 - SEE SHEET 24 FOR CULVERT ROADWAY CROSSING DETAIL.

PROJECT NAME: ROCHESTER
PROJECT NUMBER: ER STP 0162(21)
FILE NAME: z13cl76bdr.dgn PLOT DATE: 1/11/2017
PROJECT LEADER: D. GOZALKOWSKI DRAWN BY: J. HEALD
DESIGNED BY: J. OLSEN CHECKED BY: J. SHIELDS
PROJECT LAYOUT SHEET #51 SHEET 83 OF 360