
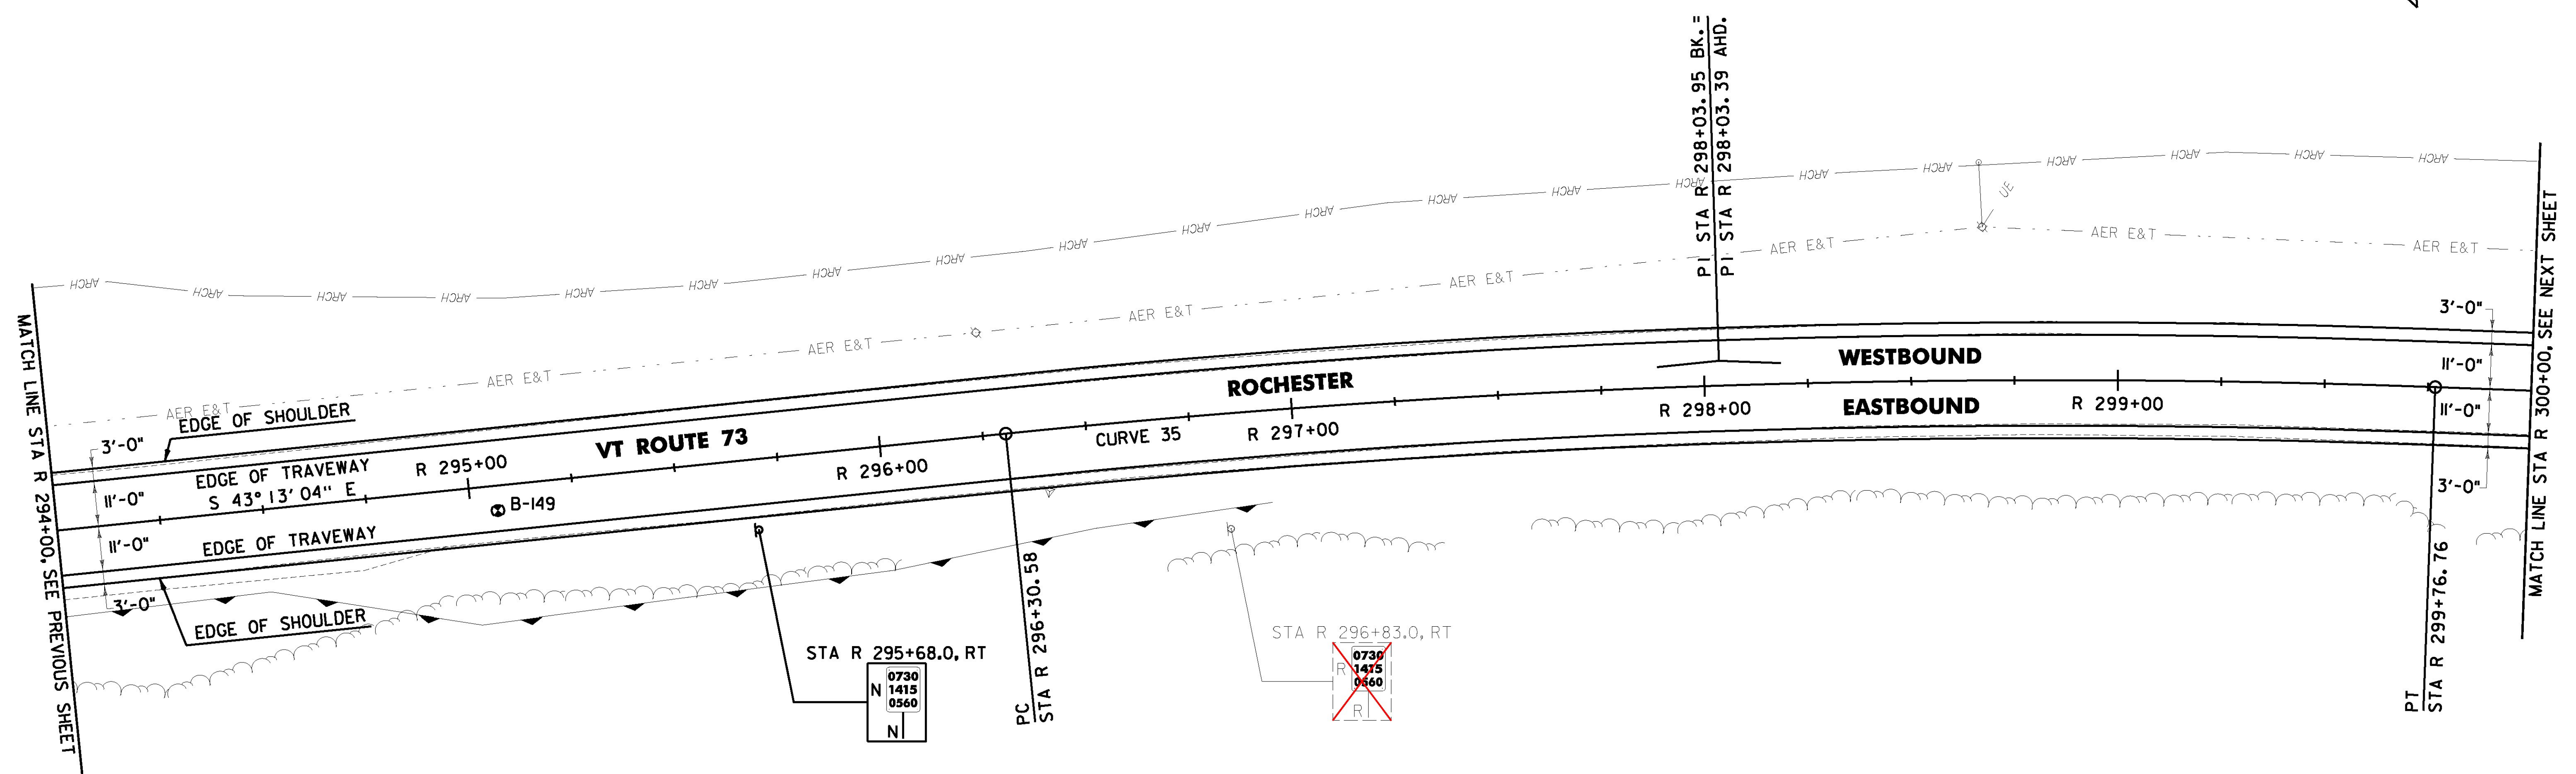


DURABLE 4 INCH WHITE LINE (OPTION ITEM)  
AND TEMPORARY 4 INCH WHITE LINE, PAINT  
(ALL LINES WILL INCLUDE EDGE LINE BREAKS AND  
RADIUS FOR TOWN HIGHWAYS)  
ROCHESTER:  
STA R 294+00.00 - STA R 300+00.00 LT & RT

DURABLE 4 INCH YELLOW LINE (OPTION ITEM) AND  
TEMPORARY 4 INCH YELLOW LINE, PAINT  
(ALL LINES WILL INCLUDE C/L BREAKS FOR TOWN  
HIGHWAYS) S = SOLID, D = DASHED  
ROCHESTER:  
STA R 294+00.00 - STA R 299+11.00 LT S  
STA R 299+11.00 - STA R 300+00.00 S S

REMOVING SIGNS  
AS SHOWN - 1

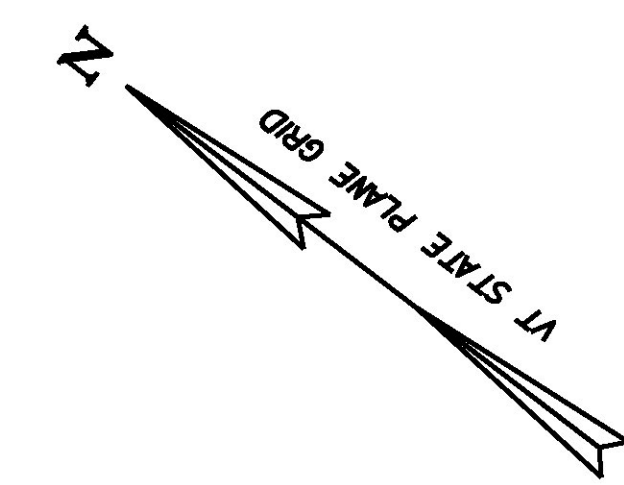

PROJECT DEMARCATION FENCE  
ROCHESTER:  
~~STA R 294+00.0 - STA R 300+00.0 LT & RT~~

BARRIER FENCE  
ROCHESTER:  
~~STA R 294+00.0 - STA R 297+94.0 RT~~  
~~STA R 294+00.0 - STA R 300+00.0 LT~~

SOIL BORING DATA			
BORING #	DEPTH (FT.)	PCC	COMMENTS
B-149	5.0	NO	

CURVE 35  
 $\Delta = 7^{\circ} 56' 02''$  RT  
 $D = 2^{\circ} 17' 31''$   
 $R = 2500.00'$   
 $T = 173.37'$   
 $L = 346.18'$   
 $E = 6.00'$   
 $e = 0.044$  FT/FT

SIGN LEGEND  
 R = REMOVE  
 S = SALVAGE  
 N = NEW  
 RET = RETAIN  
 B-B = BACK TO BACK  
 EXISTING = \_\_\_\_\_  
 NEW = \_\_\_\_\_  
 R = RETURN TO TOWN  
 OF ROCHESTER



PROJECT NAME: ROCHESTER	PLOT DATE: 1/11/2017
PROJECT NUMBER: ER STP 0162(21)	DRAWN BY: J. HEALD
FILE NAME: z13cl76bdr.dgn	DESIGNED BY: J. OLSEN
PROJECT LEADER: D. GOZALKOWSKI	CHECKED BY: J. SHIELDS
PROJECT LAYOUT SHEET #52	SHEET 84 OF 360