


DURABLE 4 INCH WHITE LINE (OPTION ITEM)
AND TEMPORARY 4 INCH WHITE LINE PAINT
(ALL LINES WILL INCLUDE EDGE LINE BREAKS AND
RADIUS FOR TOWN HIGHWAYS)
ROCHESTER:
STA R 300+00.00 - STA R 306+00.00 LT & RT

DURABLE 4 INCH YELLOW LINE (OPTION ITEM) AND
TEMPORARY 4 INCH YELLOW LINE PAINT
(ALL LINES WILL INCLUDE C/L BREAKS FOR TOWN
HIGHWAYS) S = SOLID, D = DASHED
ROCHESTER:
STA R 300+00.00 - STA R 306+00.00 LT ☉ RT
S - S

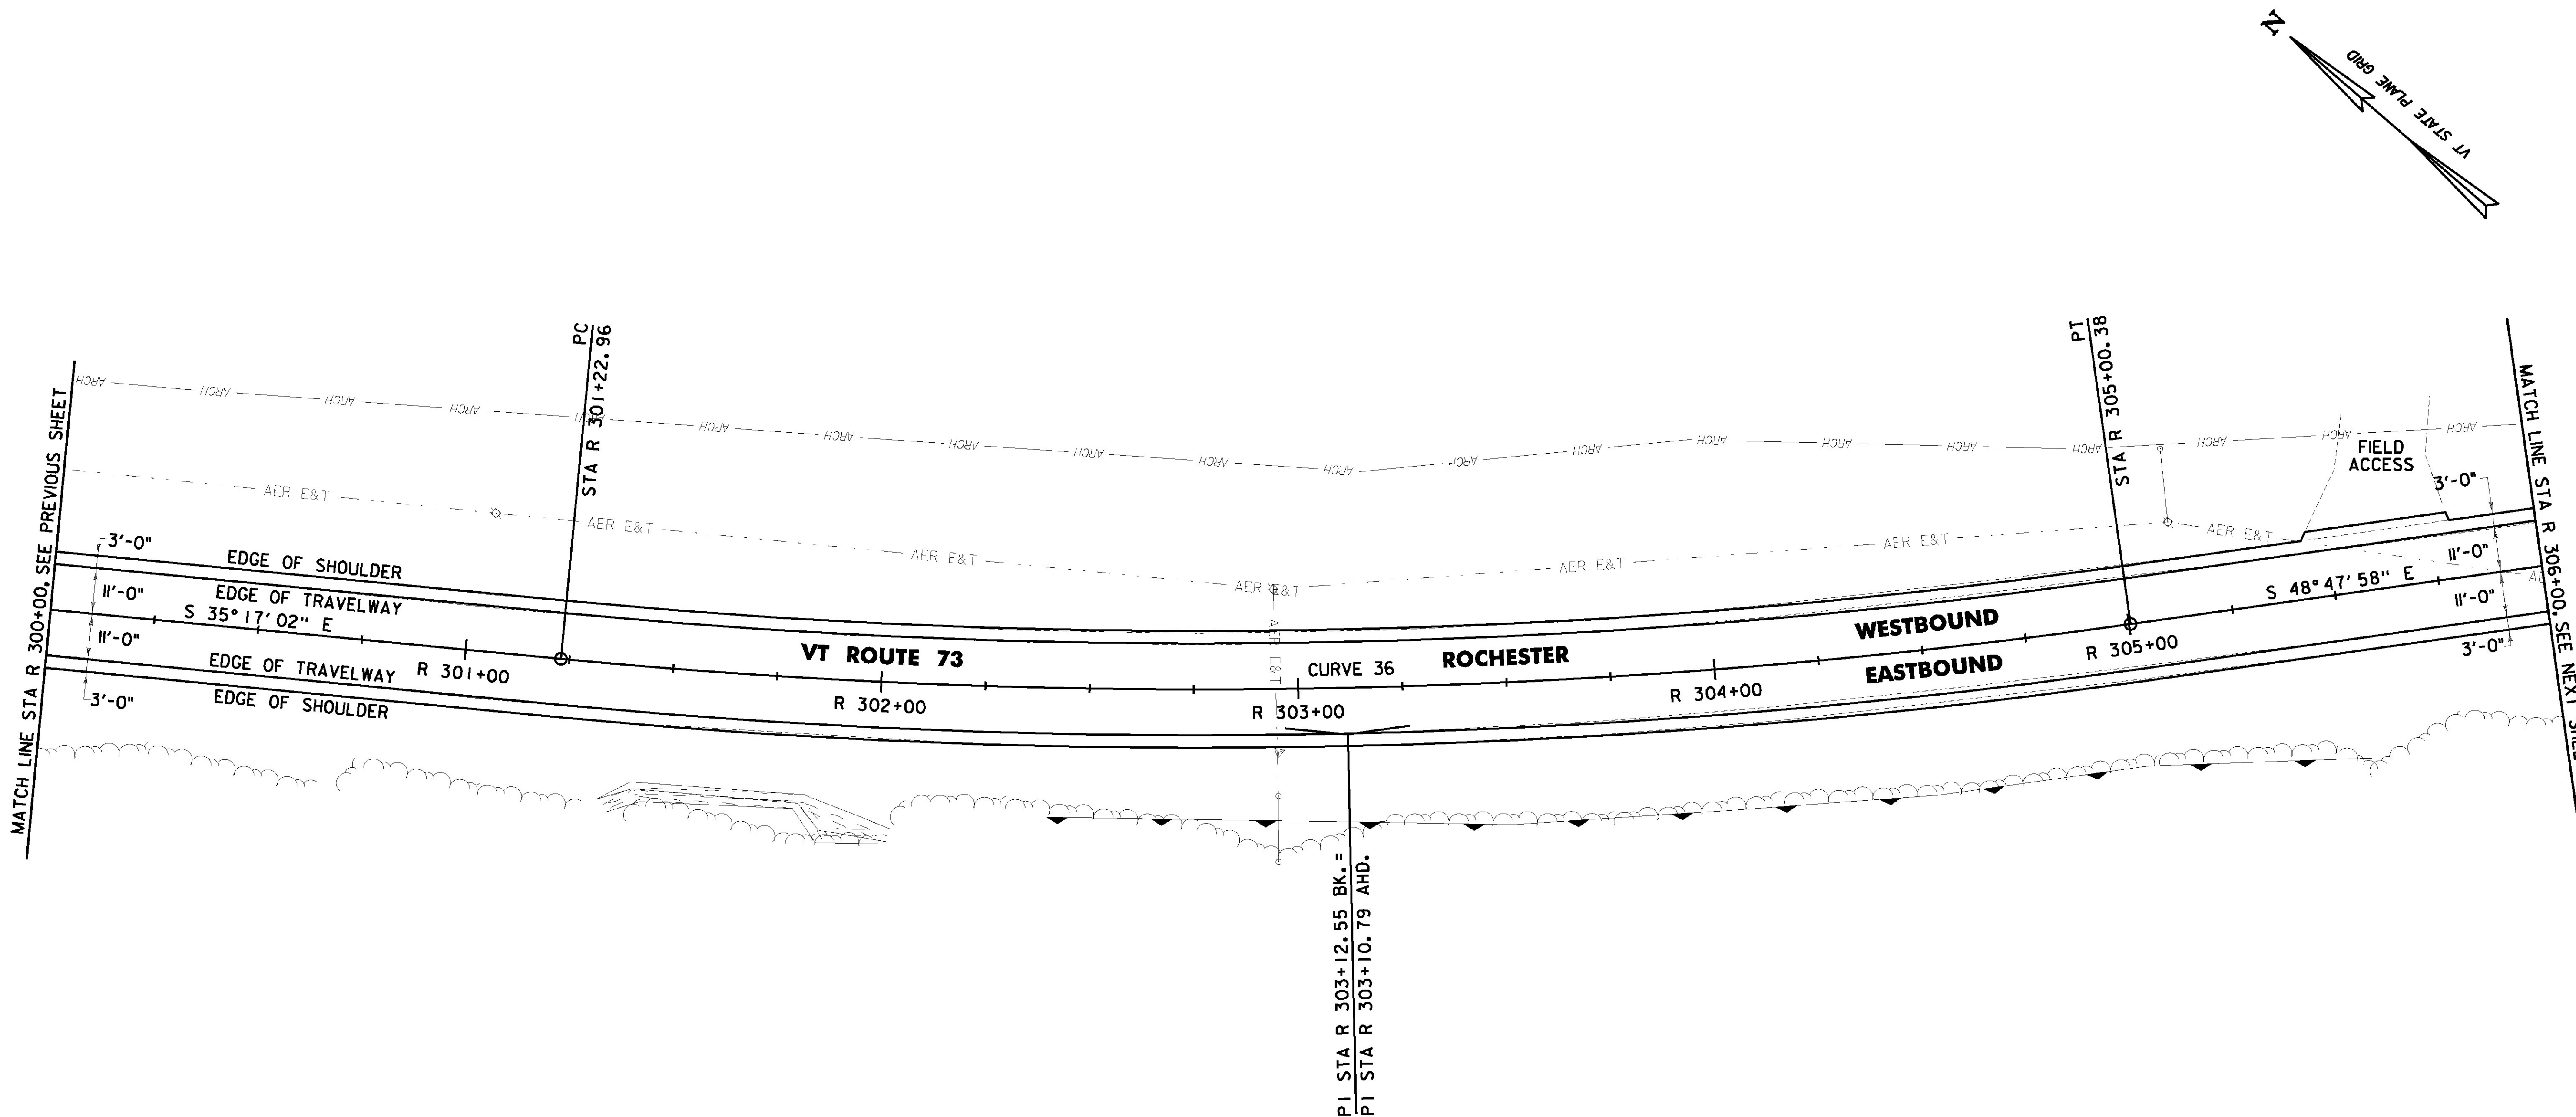


PROJECT DEMARCATION FENCE
ROCHESTER:
~~STA R 300+00.0 - STA R 305+45.0 LT~~
~~STA R 300+00.0 - STA R 306+00.0 RT~~
~~STA R 305+79.0 - STA R 306+00.0 RT~~

BARRIER FENCE
ROCHESTER:
~~STA R 300+00.0 - STA R 306+00.0 LT~~
~~STA R 304+42.0 - STA R 306+00.0 RT~~

CURVE 36
Δ = 13° 30' 56" LT
D = 3° 34' 52"
R = 1600.00'
T = 189.59'
L = 377.42'
E = 11.19'
e = 0.060 FT/FT

SIGN LEGEND
R = REMOVE
S = SALVAGE
N = NEW
RET = RETAIN
B-B = BACK TO BACK
EXISTING = _____
NEW = _____
☉ = RETURN TO TOWN
OF ROCHESTER

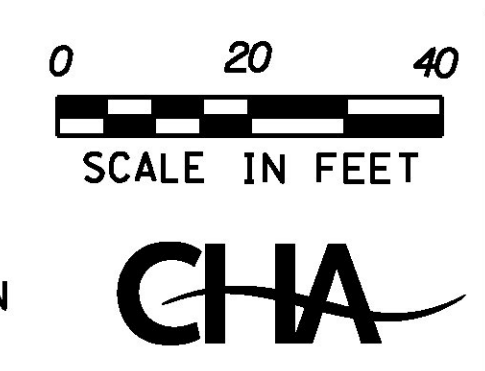

PROJECT NAME: ROCHESTER	PLOT DATE: 1/11/2017
PROJECT NUMBER: ER STP 0162(21)	DRAWN BY: J. HEALD
FILE NAME: z13cl76bdr.dgn	CHECKED BY: J. SHIELDS
PROJECT LEADER: D. GOZALKOWSKI	SHEET 85 OF 360
DESIGNED BY: J. OLSEN	
PROJECT LAYOUT SHEET #53	