


DURABLE 4 INCH WHITE LINE (OPTION ITEM)
AND TEMPORARY 4 INCH WHITE LINE PAINT
(ALL LINES WILL INCLUDE EDGE LINE BREAKS AND
RADIUS FOR TOWN HIGHWAYS)
ROCHESTER:
STA R 306+00.00 - STA R 312+00.00 LT & RT

DURABLE 4 INCH YELLOW LINE (OPTION ITEM) AND
TEMPORARY 4 INCH YELLOW LINE PAINT
(ALL LINES WILL INCLUDE C/L BREAKS FOR TOWN
HIGHWAYS) S = SOLID, D = DASHED
ROCHESTER:
STA R 306+00.00 - STA R 312+00.00 LT & RT
S - S

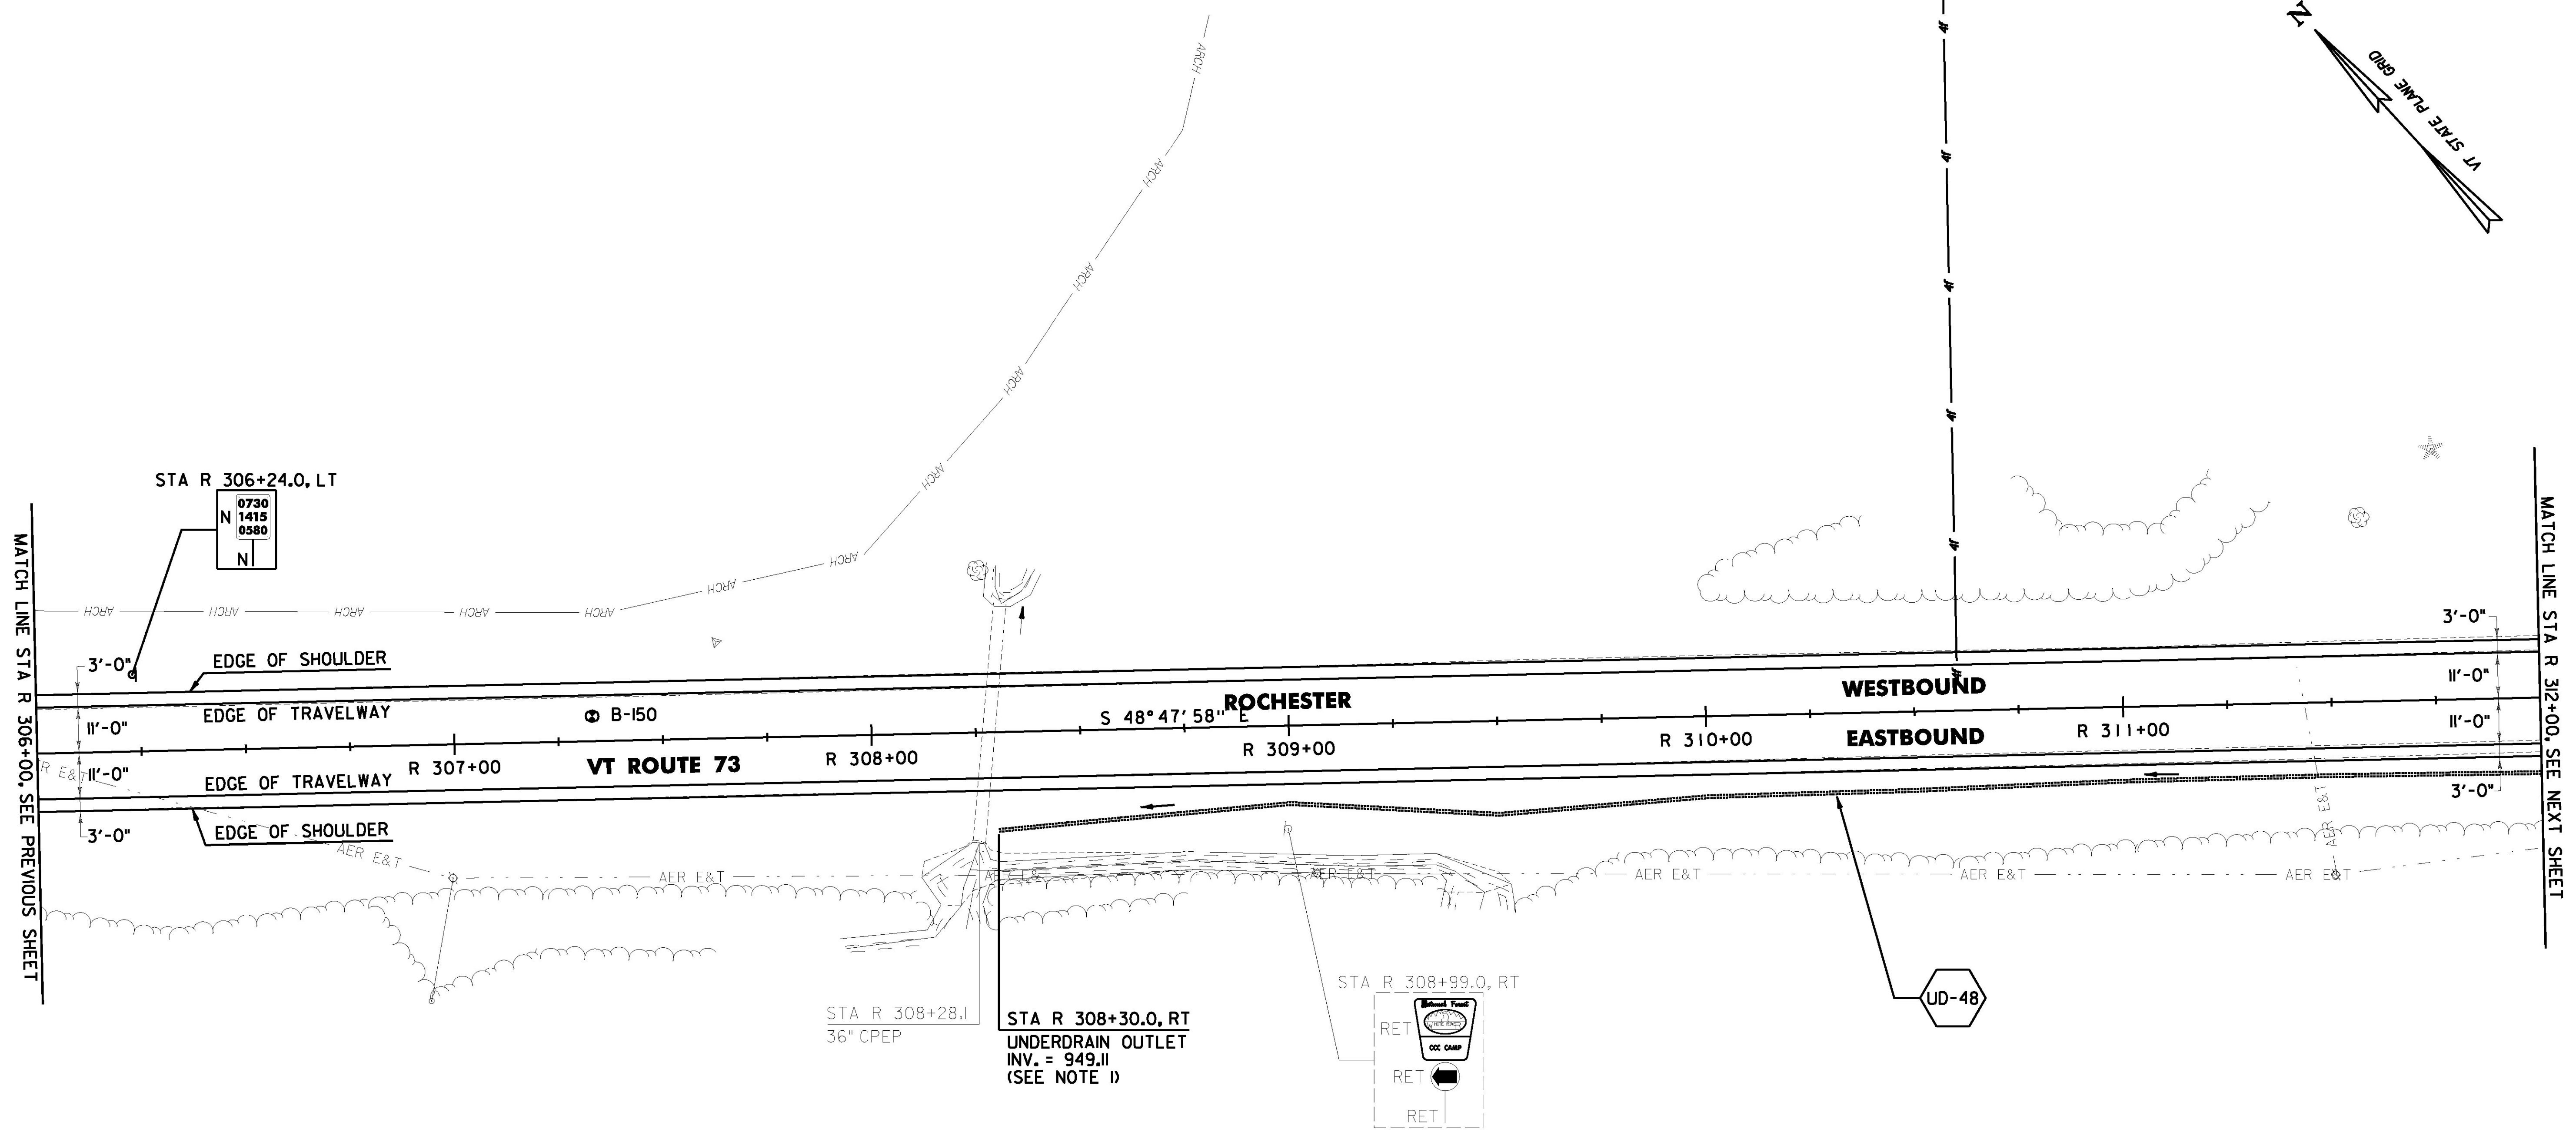

6 INCH UNDERDRAIN PIPE
ROCHESTER:
STA R 308+30.0 - STA R 312+00.0 RT

PROJECT DEMARCATION FENCE
ROCHESTER:
~~STA R 306+00.0 - STA R 312+00.0 LT & RT~~

BARRIER FENCE
ROCHESTER:
~~STA R 306+00.0 - STA R 306+57.0 RT~~
~~STA R 306+00.0 - STA R 310+00.0 LT~~
~~STA R 311+00.0 - STA R 312+00.0 LT~~

SOIL BORING DATA			
BORING #	DEPTH (FT.)	PCC	COMMENTS
B-150	5.0	NO	

SIGN LEGEND
R = REMOVE
S = SALVAGE
N = NEW
RET = RETAIN
B-B = BACK TO BACK
EXISTING = - - - - -
NEW = _____
R = RETURN TO TOWN
O = OF ROCHESTER



NOTE:
I. SEE SHEETS 26 & 27 FOR UNDERDRAIN DETAILS.

PROJECT NAME: ROCHESTER
PROJECT NUMBER: ER STP 0162(21)

FILE NAME: z13cl76bdr.dgn
PROJECT LEADER: D. GOZALKOWSKI
DESIGNED BY: J. OLSEN
PROJECT LAYOUT SHEET #54

PLOT DATE: 1/11/2017
DRAWN BY: J. HEALD
CHECKED BY: J. SHIELDS
SHEET 86 OF 360