
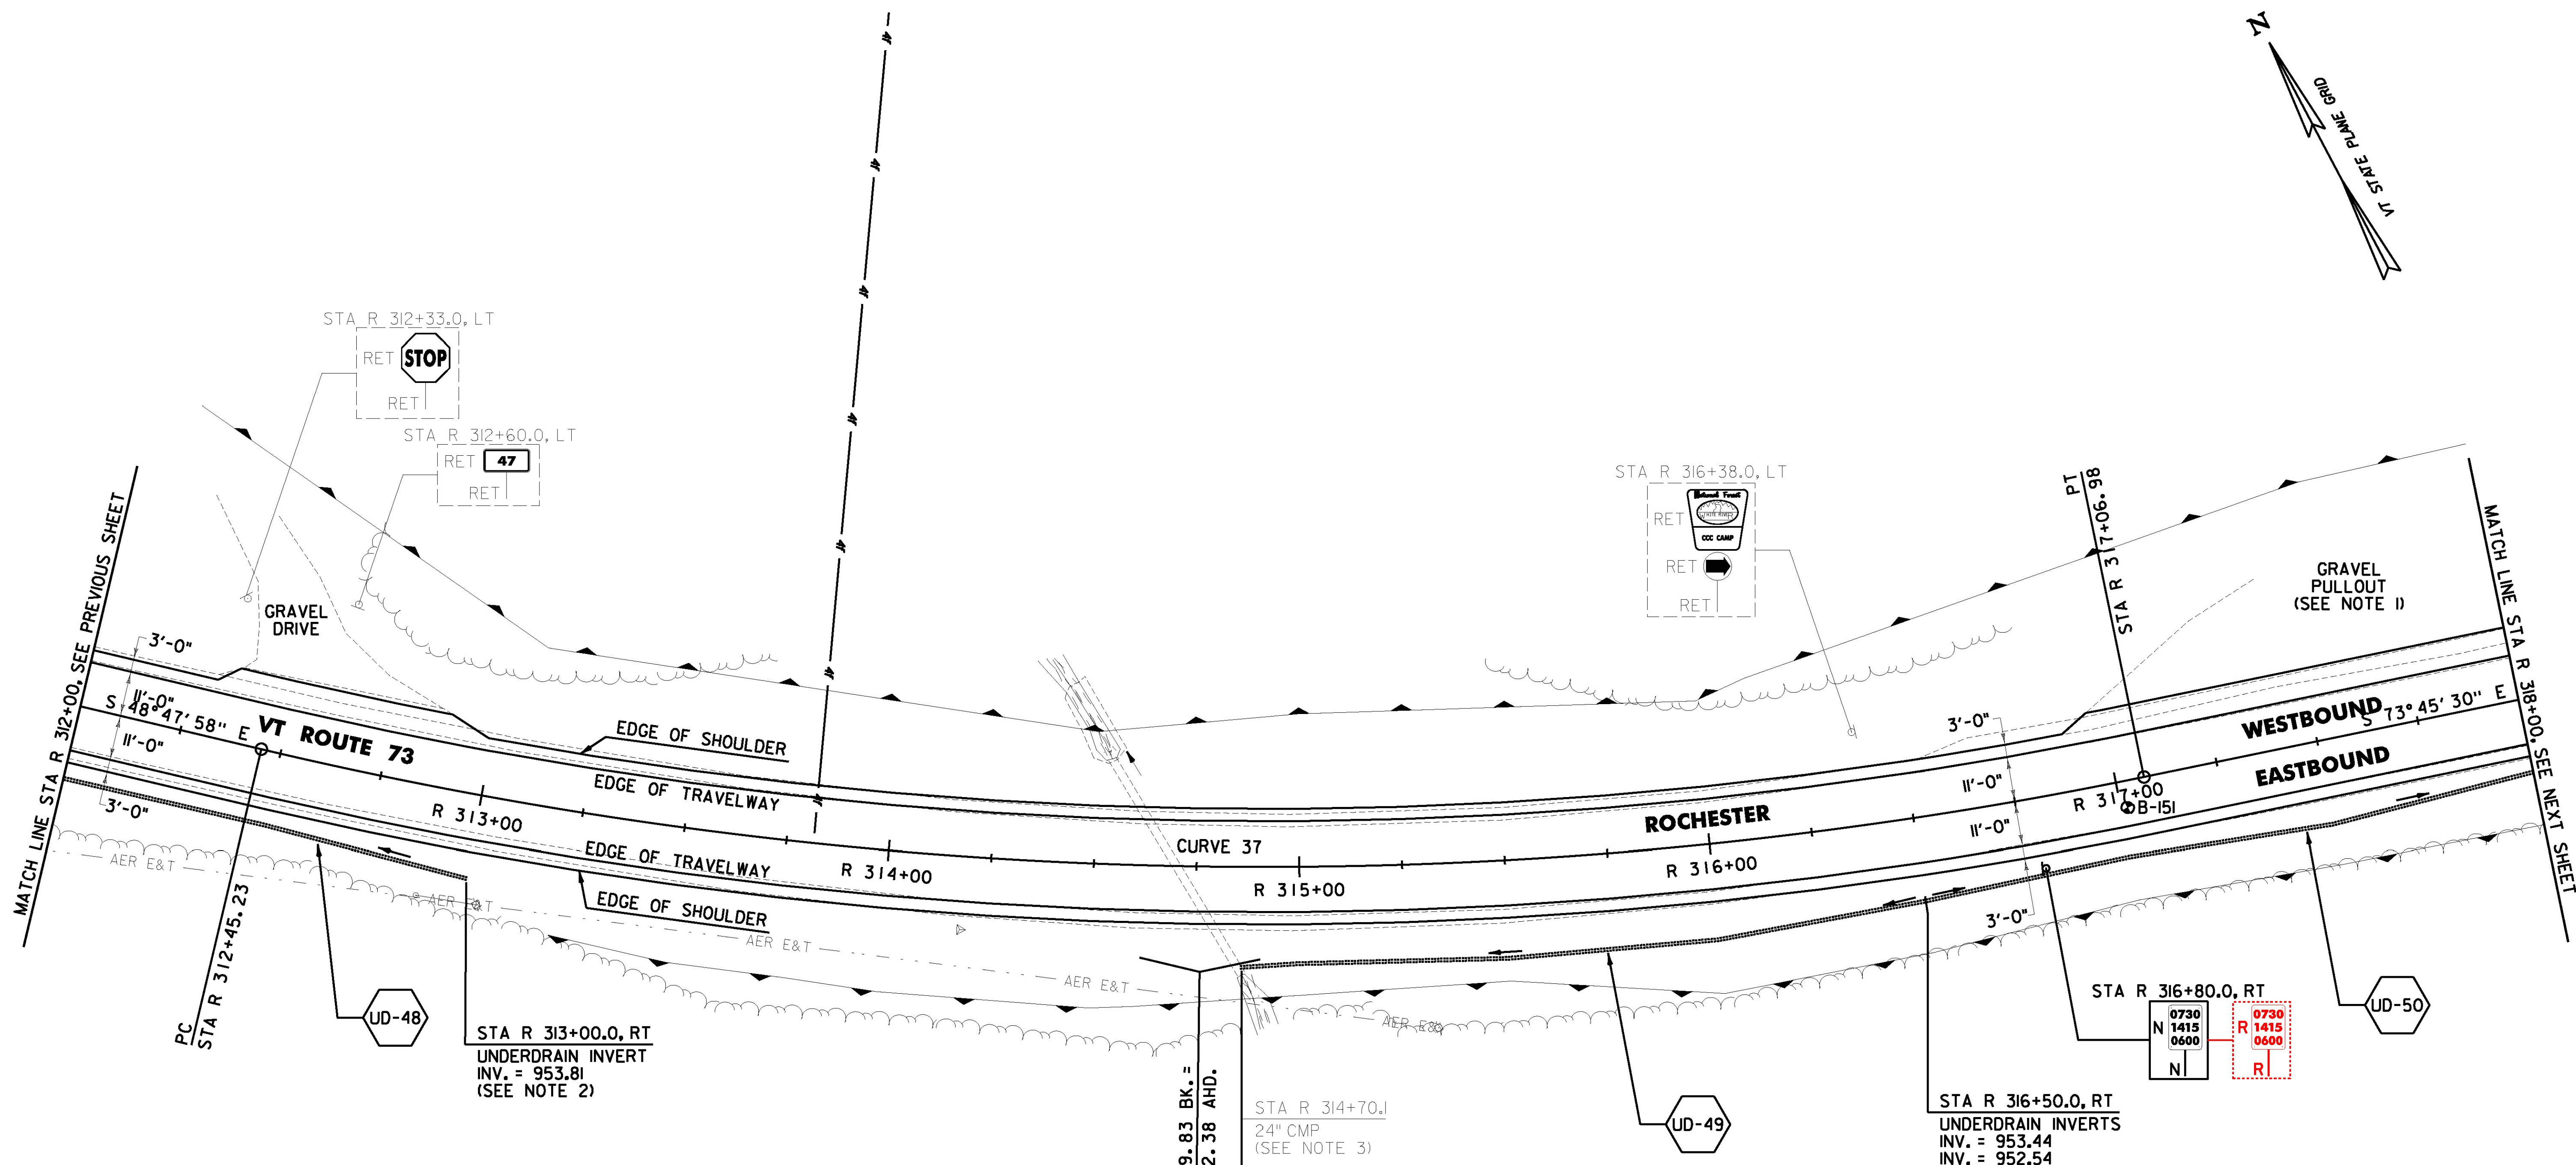


DURABLE 4 INCH WHITE LINE (OPTION ITEM) AND TEMPORARY 4 INCH WHITE LINE, PAINT (ALL LINES WILL INCLUDE EDGE LINE BREAKS AND RADIUS FOR TOWN HIGHWAYS)
 ROCHESTER:
 STA R 312+00.00 - STA R 318+00.00 LT & RT

DURABLE 4 INCH YELLOW LINE (OPTION ITEM) AND TEMPORARY 4 INCH YELLOW LINE, PAINT (ALL LINES WILL INCLUDE C/L BREAKS FOR TOWN HIGHWAYS) S = SOLID, D = DASHED
 ROCHESTER:
 STA R 312+00.00 - STA R 318+00.00 LT ☐ RT
 S - S

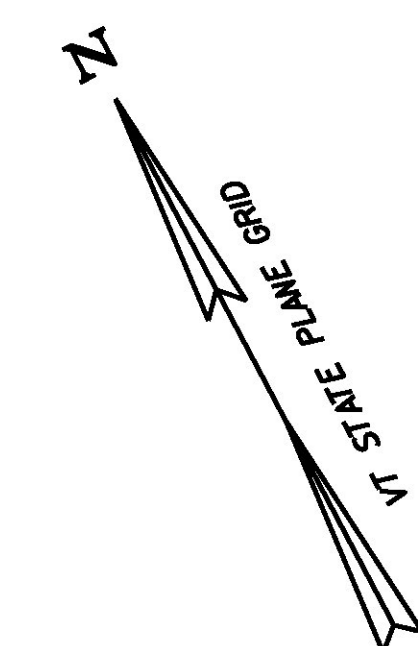

6 INCH UNDERDRAIN PIPE
 ROCHESTER:
 STA R 312+00.0 - STA R 313+00.0 RT
 STA R 314+86.1 - STA R 316+50.0 RT
 STA R 316+50.0 - STA R 318+00.0 RT


PROJECT DEMARCATION FENCE
 ROCHESTER:
~~STA R 312+00.0 - STA R 318+00.0 RT~~
~~STA R 312+00.0 - STA R 312+36.0 LT~~
~~STA R 312+89.0 - STA R 316+96.0 LT~~

BARRIER FENCE
 ROCHESTER:
~~STA R 312+00.0 - STA R 312+36.0 LT~~
~~STA R 312+89.0 - STA R 316+96.0 LT~~
~~STA R 312+22.0 - STA R 318+00.0 RT~~

SOIL BORING DATA			
BORING #	DEPTH (FT.)	PCC	COMMENTS
B-151	5.0	NO	AUGER GRINDING 0.7' - 5.0'

CURVE 37
 $\Delta = 24^{\circ}57'32''$ LT
 $D = 5^{\circ}24'19''$
 $R = 1060.00'$
 $T = 234.60'$
 $L = 461.75'$
 $E = 25.65'$
 $e = 0.074$ FT/FT

SIGN LEGEND
 R = REMOVE
 S = SALVAGE
 N = NEW
 RET = RETAIN
 B-B = BACK TO BACK
 EXISTING =
 NEW =
 R = RETURN TO TOWN OF ROCHESTER

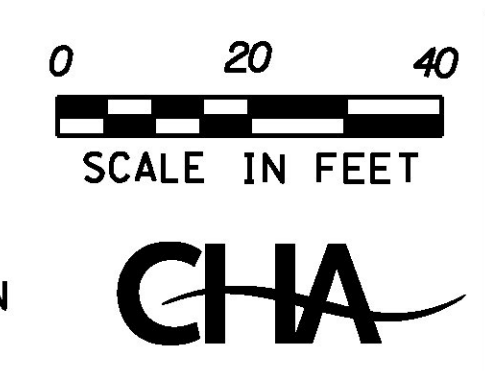

- NOTES:**
- PROVIDE A FOUR FT WIDE, 1/2" TYPE IVS APRON FOR THE EXISTING GRAVEL PULLOUT. ANY REQUIRED EXCAVATION SHALL BE PERFORMED AS DIRECTED BY THE ENGINEER AND PAID FOR UNDER ITEM 608.25 ALL PURPOSE EXCAVATOR RENTAL, TYPE I.
 - SEE SHEETS 26 & 27 FOR UNDERDRAIN DETAILS.
 - THE CONTRACTOR SHALL ADJUST THE PROPOSED SIDE SLOPE TO AVOID FILLING IN THE EXISTING PIPE AS DIRECTED BY THE ENGINEER.

PROJECT NAME: ROCHESTER
 PROJECT NUMBER: ER STP 0162(21)
 FILE NAME: z13cl76bdr.dgn PLOT DATE: 1/11/2017
 PROJECT LEADER: D. GOZALKOWSKI DRAWN BY: J. HEALD
 DESIGNED BY: J. OLSEN CHECKED BY: J. SHIELDS
 PROJECT LAYOUT SHEET #55 SHEET 87 OF 360