
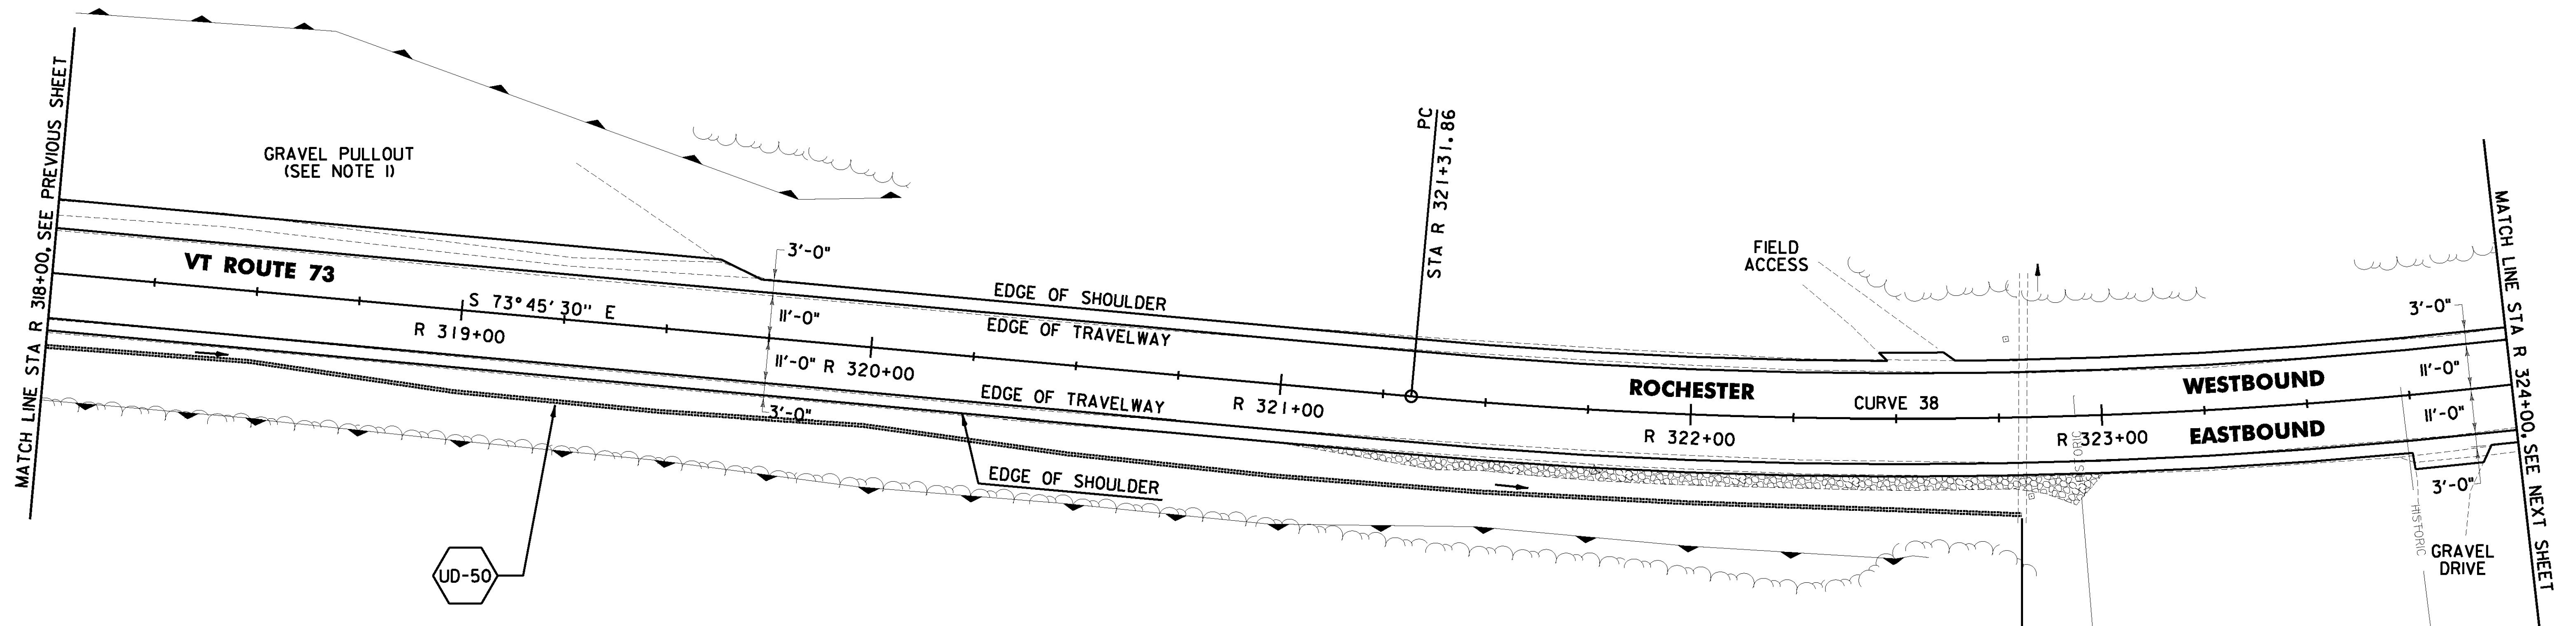


DURABLE 4 INCH WHITE LINE (OPTION ITEM)  
AND TEMPORARY 4 INCH WHITE LINE, PAINT  
(ALL LINES WILL INCLUDE EDGE LINE BREAKS AND  
RADIUS FOR TOWN HIGHWAYS)  
ROCHESTER:  
STA R 318+00.00 - STA R 324+00.00 LT & RT

DURABLE 4 INCH YELLOW LINE (OPTION ITEM) AND  
TEMPORARY 4 INCH YELLOW LINE, PAINT  
(ALL LINES WILL INCLUDE C/L BREAKS FOR TOWN  
HIGHWAYS) S = SOLID, D = DASHED  
ROCHESTER:  
STA R 318+00.00 - STA R 324+00.00 LT ☉ RT  
S - S

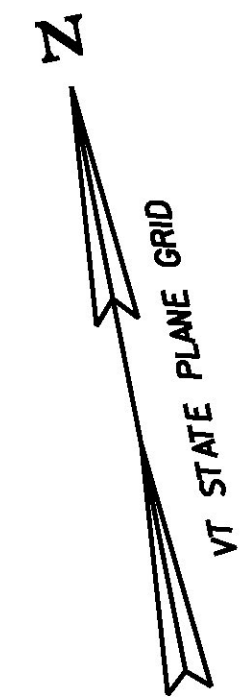

**6 INCH UNDERDRAIN PIPE**  
ROCHESTER:  
STA R 318+00.0 - STA R 322+80.1 RT

**PROJECT DEMARCATION FENCE**  
ROCHESTER:  
~~STA R 318+00.0 - STA R 323+75.0 RT~~  
~~STA R 319+62.0 - STA R 322+47.0 LT~~  
~~STA R 322+62.0 - STA R 324+00.0 LT~~  
~~STA R 323+91.0 - STA R 324+00.0 RT~~

**BARRIER FENCE**  
ROCHESTER:  
~~STA R 319+62.0 - STA R 321+04.0 LT~~  
~~STA R 318+00.0 - STA R 323+75.0 RT~~  
~~STA R 323+00.0 - STA R 324+00.0 LT~~  
~~STA R 323+91.0 - STA R 324+00.0 RT~~

**STONE FILL, TYPE I**  
ROCHESTER:  
STA R 321+00.0 - STA R 323+00.0 RT

**GRUBBING MATERIAL (6")**  
ROCHESTER:  
STA R 321+00.0 - STA R 323+00.0 RT

**EROSION LOG**  
ROCHESTER:  
STA R 321+00.0 - STA R 323+00.0 RT

- NOTES:**
- PROVIDE A FOUR FT WIDE, 1/2" TYPE IVS APRON FOR THE EXISTING GRAVEL PULLOUT. ANY REQUIRED EXCAVATION SHALL BE PERFORMED AS DIRECTED BY THE ENGINEER AND PAID FOR UNDER ITEM 608.25 ALL PURPOSE EXCAVATOR RENTAL, TYPE I.
  - SEE SHEETS 26 & 27 FOR UNDERDRAIN DETAILS.
  - THE CONTRACTOR SHALL ADJUST THE PROPOSED SIDE SLOPE TO AVOID FILLING IN THE EXISTING PIPE AS DIRECTED BY THE ENGINEER.

**CURVE 38**  
Δ = 25° 59' 53" LT  
D = 4° 19' 27"  
R = 1325.00'  
T = 305.88'  
L = 601.22'  
E = 34.85'  
e = 0.068 FT/FT

**LEGEND**  
[Pattern] ITEM 613.10  
STONE FILL, TYPE I

**SIGN LEGEND**  
R = REMOVE  
S = SALVAGE  
N = NEW  
RET = RETAIN  
B-B = BACK TO BACK  
EXISTING = \_\_\_\_\_  
NEW = \_\_\_\_\_  
R = RETURN TO TOWN  
☉ OF ROCHESTER



PROJECT NAME: ROCHESTER  
PROJECT NUMBER: ER STP 0162(21)  
FILE NAME: z13cl76bdr.dgn  
PROJECT LEADER: D. GOZALKOWSKI  
DESIGNED BY: J. OLSEN  
PROJECT LAYOUT SHEET #56  
PLOT DATE: 1/11/2017  
DRAWN BY: J. HEALD  
CHECKED BY: J. SHIELDS  
SHEET 88 OF 360