


DURABLE 4 INCH WHITE LINE (OPTION ITEM) AND TEMPORARY 4 INCH WHITE LINE, PAINT (ALL LINES WILL INCLUDE EDGE LINE BREAKS AND RADIUS FOR TOWN HIGHWAYS)
 ROCHESTER:
 STA R 330+00.00 - STA R 336+00.00 LT & RT

DURABLE 4 INCH YELLOW LINE (OPTION ITEM) AND TEMPORARY 4 INCH YELLOW LINE, PAINT (ALL LINES WILL INCLUDE C/L BREAKS FOR TOWN HIGHWAYS) S = SOLID, D = DASHED
 ROCHESTER:
 STA R 330+00.00 - STA R 331+58.00 S - L D
 STA R 331+58.00 - STA R 336+00.00 S - - S

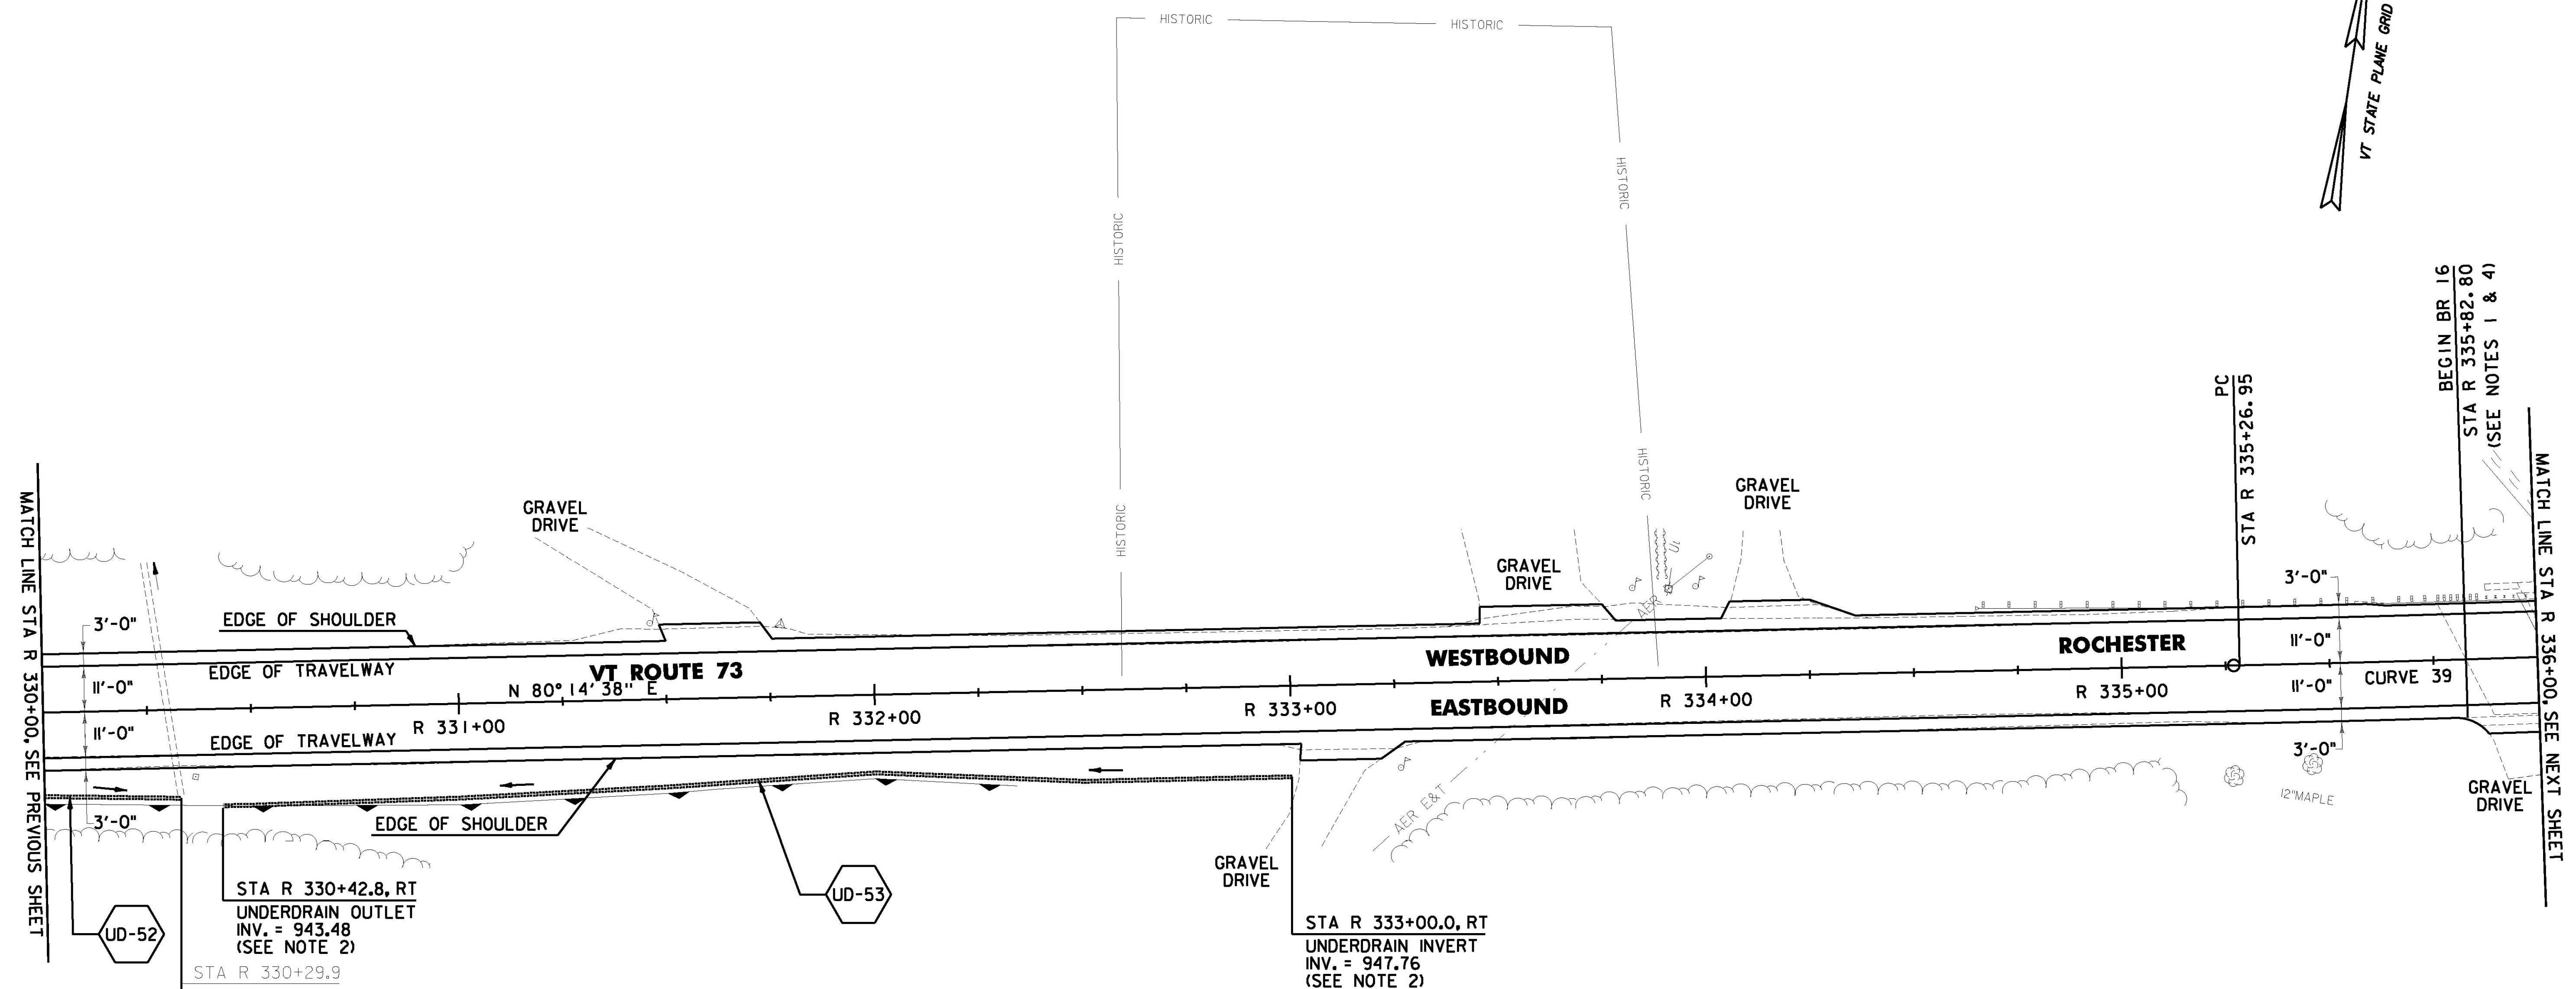


6 INCH UNDERDRAIN PIPE
 ROCHESTER:
 STA R 330+00.0 - STA R 330+32.8 RT
 STA R 330+42.8 - STA R 333+00.0 RT

PROJECT DEMARCATION FENCE
 ROCHESTER:
~~STA R 330+00.0 - STA R 331+49.0 LT~~
~~STA R 330+00.0 - STA R 333+02.0 RT~~ R 333+00.0 RT
~~STA R 331+73.0 - STA R 333+46.0 LT~~
~~STA R 333+22.0 - STA R 335+88.0 RT~~
~~STA R 333+75.0 - STA R 334+06.0 LT~~
~~STA R 334+25.0 - STA R 336+00.0 LT~~

BARRIER FENCE
 ROCHESTER:
~~STA R 330+00.0 - STA R 333+02.0 RT~~
~~STA R 331+73.0 - STA R 333+46.0 LT~~
~~STA R 333+22.0 - STA R 333+34.0 RT~~
~~STA R 333+75.0 - STA R 334+06.0 LT~~
~~STA R 334+25.0 - STA R 334+87.0 LT~~

CURVE 39
 $\Delta = 4^{\circ}05'17''$ LT
 $D = 1^{\circ}00'00''$
 $R = 5729.58'$
 $T = 204.49'$
 $L = 408.81'$
 $E = 3.65'$
 $e = 0.022$ FT/FT

SIGN LEGEND
 R = REMOVE
 S = SALVAGE
 N = NEW
 RET = RETAIN
 B-B = BACK TO BACK
 EXISTING = - - - - -
 NEW = _____
 R = RETURN TO TOWN OF ROCHESTER

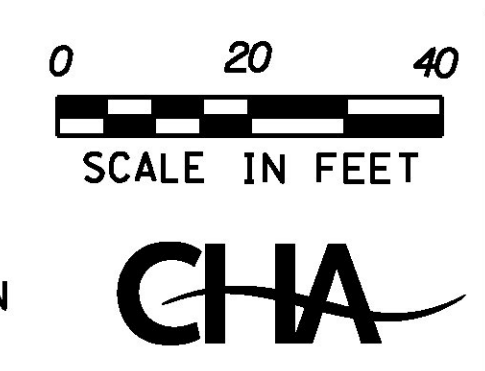

- NOTES:**
- SEE SHEET 20 FOR COLD PLANE BRIDGE TRANSITION AREA DETAIL.
 - SEE SHEETS 26 & 27 FOR UNDERDRAIN DETAILS.
 - THE CONTRACTOR SHALL ADJUST THE PROPOSED SIDE SLOPE TO AVOID FILLING IN THE EXISTING PIPE AS DIRECTED BY THE ENGINEER.
 - SEE STRUCTURES DETAIL SHEET SD-516.10 FOR DETAILS FOR ITEM 516.10 BRIDGE EXPANSION JOINT, ASPHALTIC PLUG, TO BE INSTALLED AT STA R 335+82.80.

PROJECT NAME: ROCHESTER
 PROJECT NUMBER: ER STP 0162(21)

FILE NAME: z13cl76bdr.dgn
 PROJECT LEADER: D. GOZALKOWSKI
 DESIGNED BY: J. OLSEN
 PROJECT LAYOUT SHEET #58

PLOT DATE: 1/11/2017
 DRAWN BY: J. HEALD
 CHECKED BY: J. SHIELDS
 SHEET 90 OF 360