
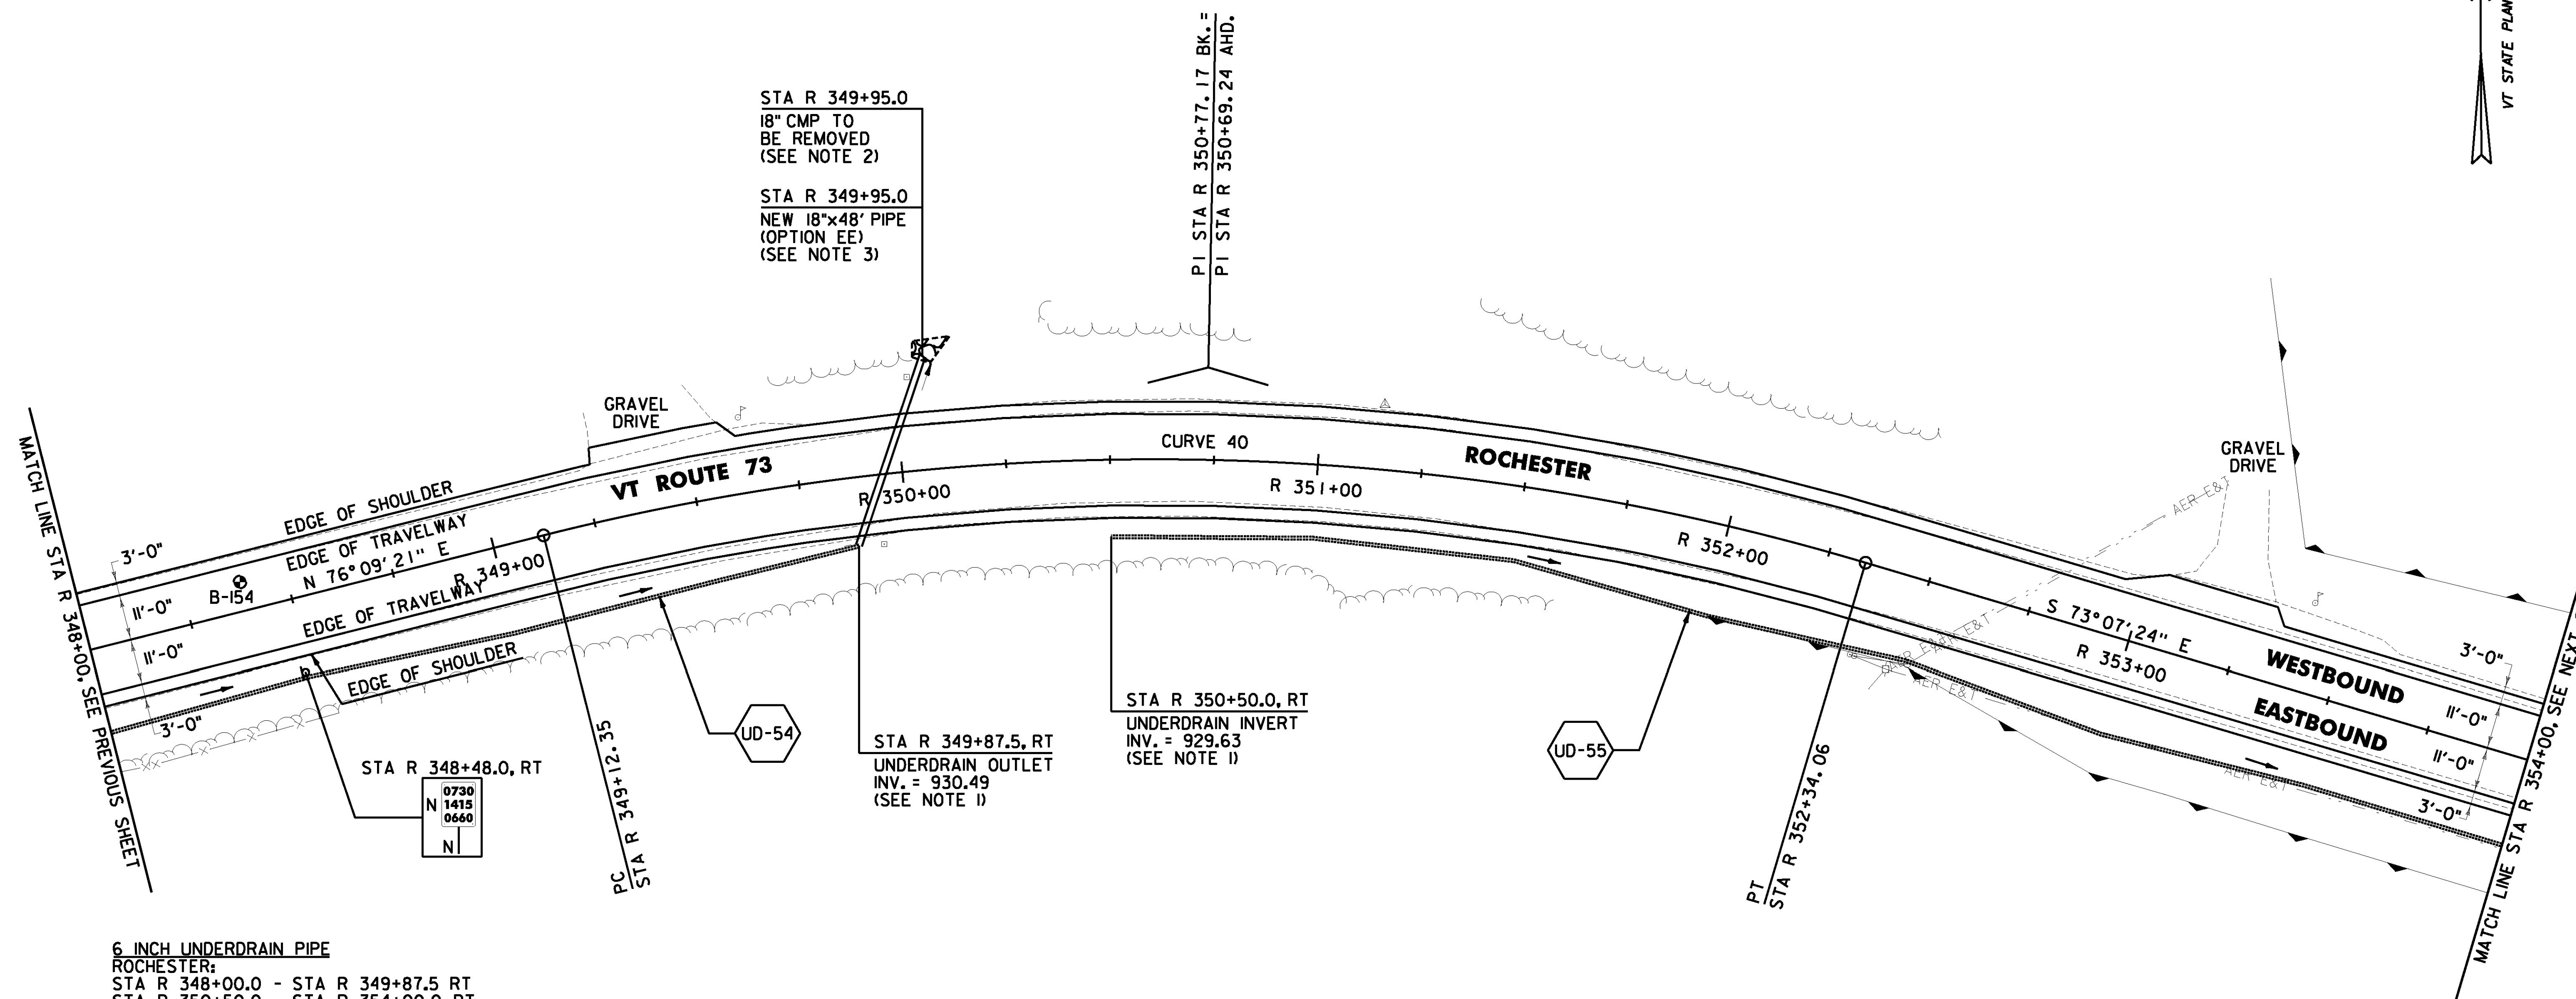


DURABLE 4 INCH WHITE LINE (OPTION ITEM)
AND TEMPORARY 4 INCH WHITE LINE, PAINT
(ALL LINES WILL INCLUDE EDGE LINE BREAKS AND
RADIUS FOR TOWN HIGHWAYS)
ROCHESTER:
STA R 348+00.00 - STA R 354+00.00 LT & RT

DURABLE 4 INCH YELLOW LINE (OPTION ITEM) AND
TEMPORARY 4 INCH YELLOW LINE, PAINT
(ALL LINES WILL INCLUDE C/L BREAKS FOR TOWN
HIGHWAYS) S = SOLID, D = DASHED
ROCHESTER:
STA R 348+00.00 - STA R 354+00.00 LT ☉ RT S - S

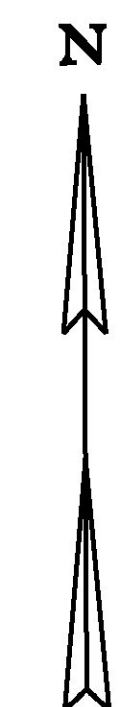

6 INCH UNDERDRAIN PIPE
ROCHESTER:
STA R 348+00.0 - STA R 349+87.5 RT
STA R 350+50.0 - STA R 354+00.0 RT

PROJECT DEMARCATION FENCE
ROCHESTER:
~~STA R 348+00.0 - STA R 349+28.0 LT~~
~~STA R 348+00.0 - STA R 354+00.0 RT~~
~~STA R 349+58.0 - STA R 353+05.0 LT~~
~~STA R 353+32.0 - STA R 354+00.0 LT~~

BARRIER FENCE
ROCHESTER:
~~STA R 351+00.0 - STA R 354+00.0 RT~~
~~STA R 352+08.0 - STA R 353+05.0 LT~~
~~STA R 353+32.0 - STA R 354+00.0 LT~~


STONE FILL, TYPE II
ROCHESTER:
STA R 349+95.0, LT

SOIL BORING DATA			
BORING #	DEPTH (FT.)	PCC	COMMENTS
B-154	5.0	NO	

CURVE 40
Δ = 30° 43' 15" RT
D = 9° 32' 57"
R = 600.00'
T = 164.82'
L = 321.71'
E = 22.23'
e = 0.080 FT/FT

LEGEND
ITEM 613.11
STONE FILL, TYPE II

SIGN LEGEND
R = REMOVE
S = SALVAGE
N = NEW
RET = RETAIN
B-B = BACK TO BACK
EXISTING = - - - - -
NEW = _____
R = RETURN TO TOWN
OF ROCHESTER

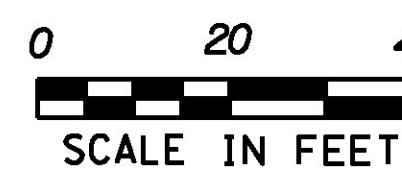

NOTES:

- SEE SHEETS 26 & 27 FOR UNDERDRAIN DETAILS
- THE CONTRACTOR SHALL PERFORM ALL EXCAVATION REQUIRED TO REMOVE THE EXISTING PIPE AND INSTALL THE PROPOSED PIPE UNDER ITEM 204.20 TRENCH EXCAVATION OF EARTH AS DIRECTED BY THE ENGINEER.
- SEE SHEET 24 FOR CULVERT ROADWAY CROSSING DETAIL.

PROJECT NAME: ROCHESTER
PROJECT NUMBER: ER STP 0162(21)

FILE NAME: z13cl76bdr.dgn
PROJECT LEADER: D. GOZALKOWSKI
DESIGNED BY: J. OLSEN
PROJECT LAYOUT SHEET #61

PLOT DATE: 1/11/2017
DRAWN BY: J. HEALD
CHECKED BY: J. SHIELDS
SHEET 93 OF 360