
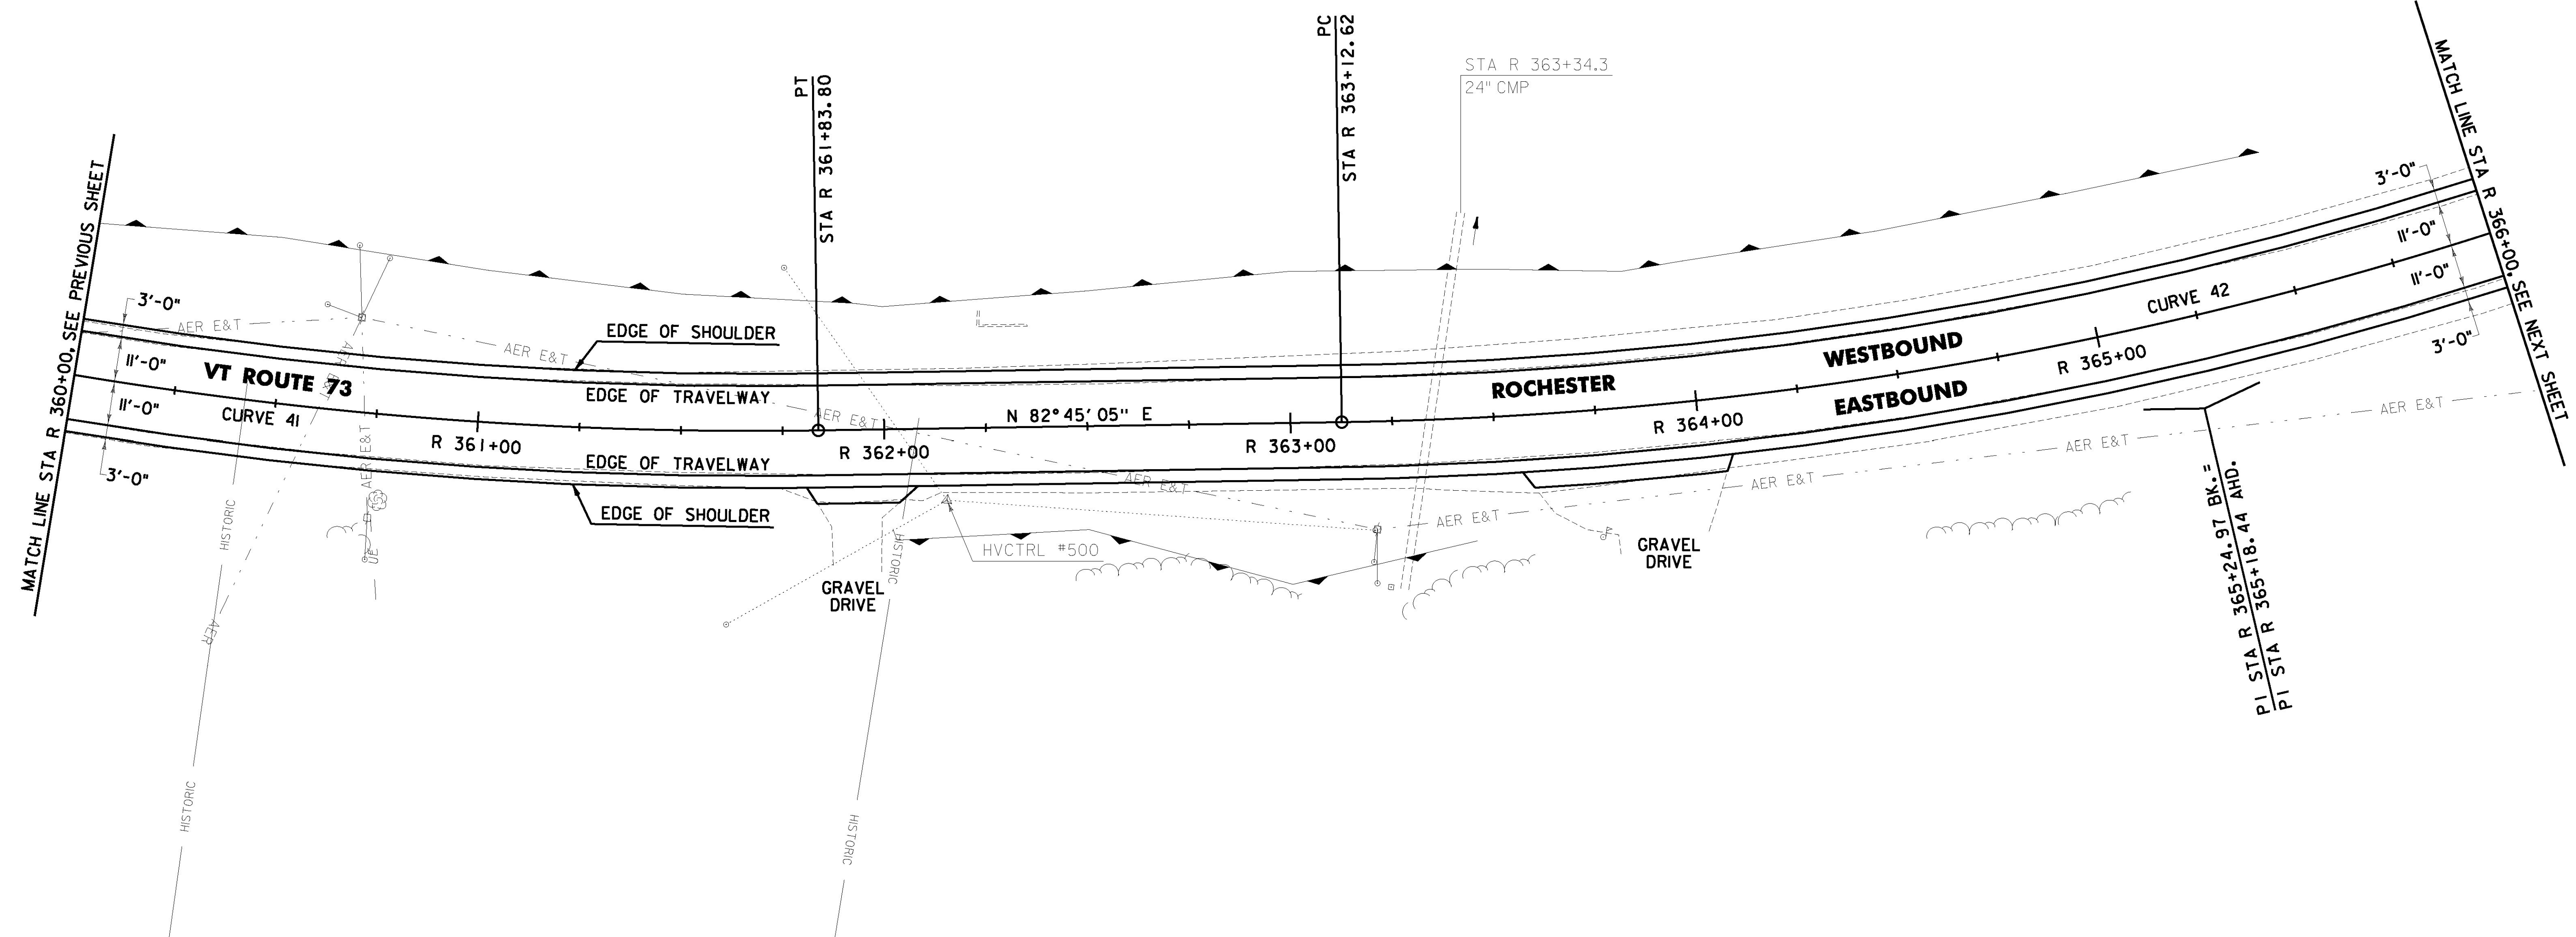


DURABLE 4 INCH WHITE LINE (OPTION ITEM) AND TEMPORARY 4 INCH WHITE LINE, PAINT (ALL LINES WILL INCLUDE EDGE LINE BREAKS AND RADIUS FOR TOWN HIGHWAYS)
 ROCHESTER:
 STA R 360+00.00 - STA R 366+00.00 LT & RT

DURABLE 4 INCH YELLOW LINE (OPTION ITEM) AND TEMPORARY 4 INCH YELLOW LINE, PAINT (ALL LINES WILL INCLUDE C/L BREAKS FOR TOWN HIGHWAYS) S = SOLID, D = DASHED
 ROCHESTER:
 STA R 360+00.00 - STA R 363+79.00 LT S
 STA R 363+79.00 - STA R 366+00.00 LT S
 STA R 360+00.00 - STA R 363+79.00 RT S
 STA R 363+79.00 - STA R 366+00.00 RT D

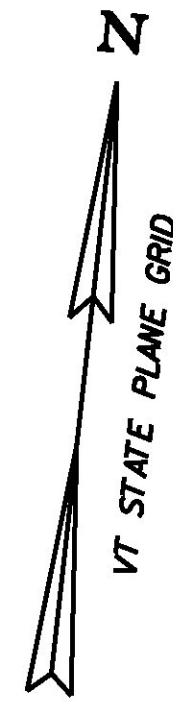


PROJECT DEMARCATION FENCE
 ROCHESTER:
~~STA R 360+00.0 - STA R 366+00.0 LT~~
~~STA R 360+00.0 - STA R 361+83.0 RT~~
~~STA R 362+04.0 - STA R 363+59.0 RT~~
~~STA R 364+06.0 - STA R 366+00.0 RT~~

BARRIER FENCE
 ROCHESTER:
~~STA R 360+00.0 - STA R 361+83.0 RT~~
~~STA R 360+00.0 - STA R 366+00.0 LT~~
~~STA R 362+04.0 - STA R 363+59.0 RT~~
~~STA R 364+06.0 - STA R 364+46.0 RT~~

CURVE 41
 $\Delta = 24^{\circ}07'31''$ LT
 $D = 5^{\circ}37'02''$
 $R = 1020.00'$
 $T = 217.97'$
 $L = 429.49'$
 $E = 23.03'$
 $e = 0.076$ FT/FT

CURVE 42
 $\Delta = 24^{\circ}34'24''$ LT
 $D = 5^{\circ}52'35''$
 $R = 975.00'$
 $T = 212.35'$
 $L = 418.16'$
 $E = 22.86'$
 $e = 0.078$ FT/FT

SIGN LEGEND
 R = REMOVE
 S = SALVAGE
 N = NEW
 RET = RETAIN
 B-B = BACK TO BACK
 EXISTING = _____
 NEW = _____
 R = RETURN TO TOWN OF ROCHESTER

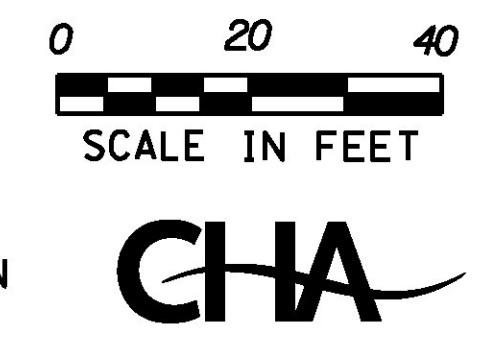

PROJECT NAME: ROCHESTER
 PROJECT NUMBER: ER STP 0162(21)

FILE NAME: z13cl76bdr.dgn
 PROJECT LEADER: D. GOZALKOWSKI
 DESIGNED BY: J. OLSEN
 PROJECT LAYOUT SHEET #63

PLOT DATE: 1/11/2017
 DRAWN BY: J. HEALD
 CHECKED BY: J. SHIELDS
 SHEET 95 OF 360