


DURABLE 4 INCH WHITE LINE (OPTION ITEM)
AND TEMPORARY 4 INCH WHITE LINE, PAINT
(ALL LINES WILL INCLUDE EDGE LINE BREAKS AND
RADIUS FOR TOWN HIGHWAYS)
ROCHESTER:
STA R 408+00.00 - STA R 414+00.00 LT & RT

DURABLE 4 INCH YELLOW LINE (OPTION ITEM) AND
TEMPORARY 4 INCH YELLOW LINE, PAINT
(ALL LINES WILL INCLUDE C/L BREAKS FOR TOWN
HIGHWAYS) S = SOLID, D = DASHED
ROCHESTER:
STA R 408+00.00 - STA R 414+00.00 LT & RT
S - S

REMOVING SIGNS
AS SHOWN - I

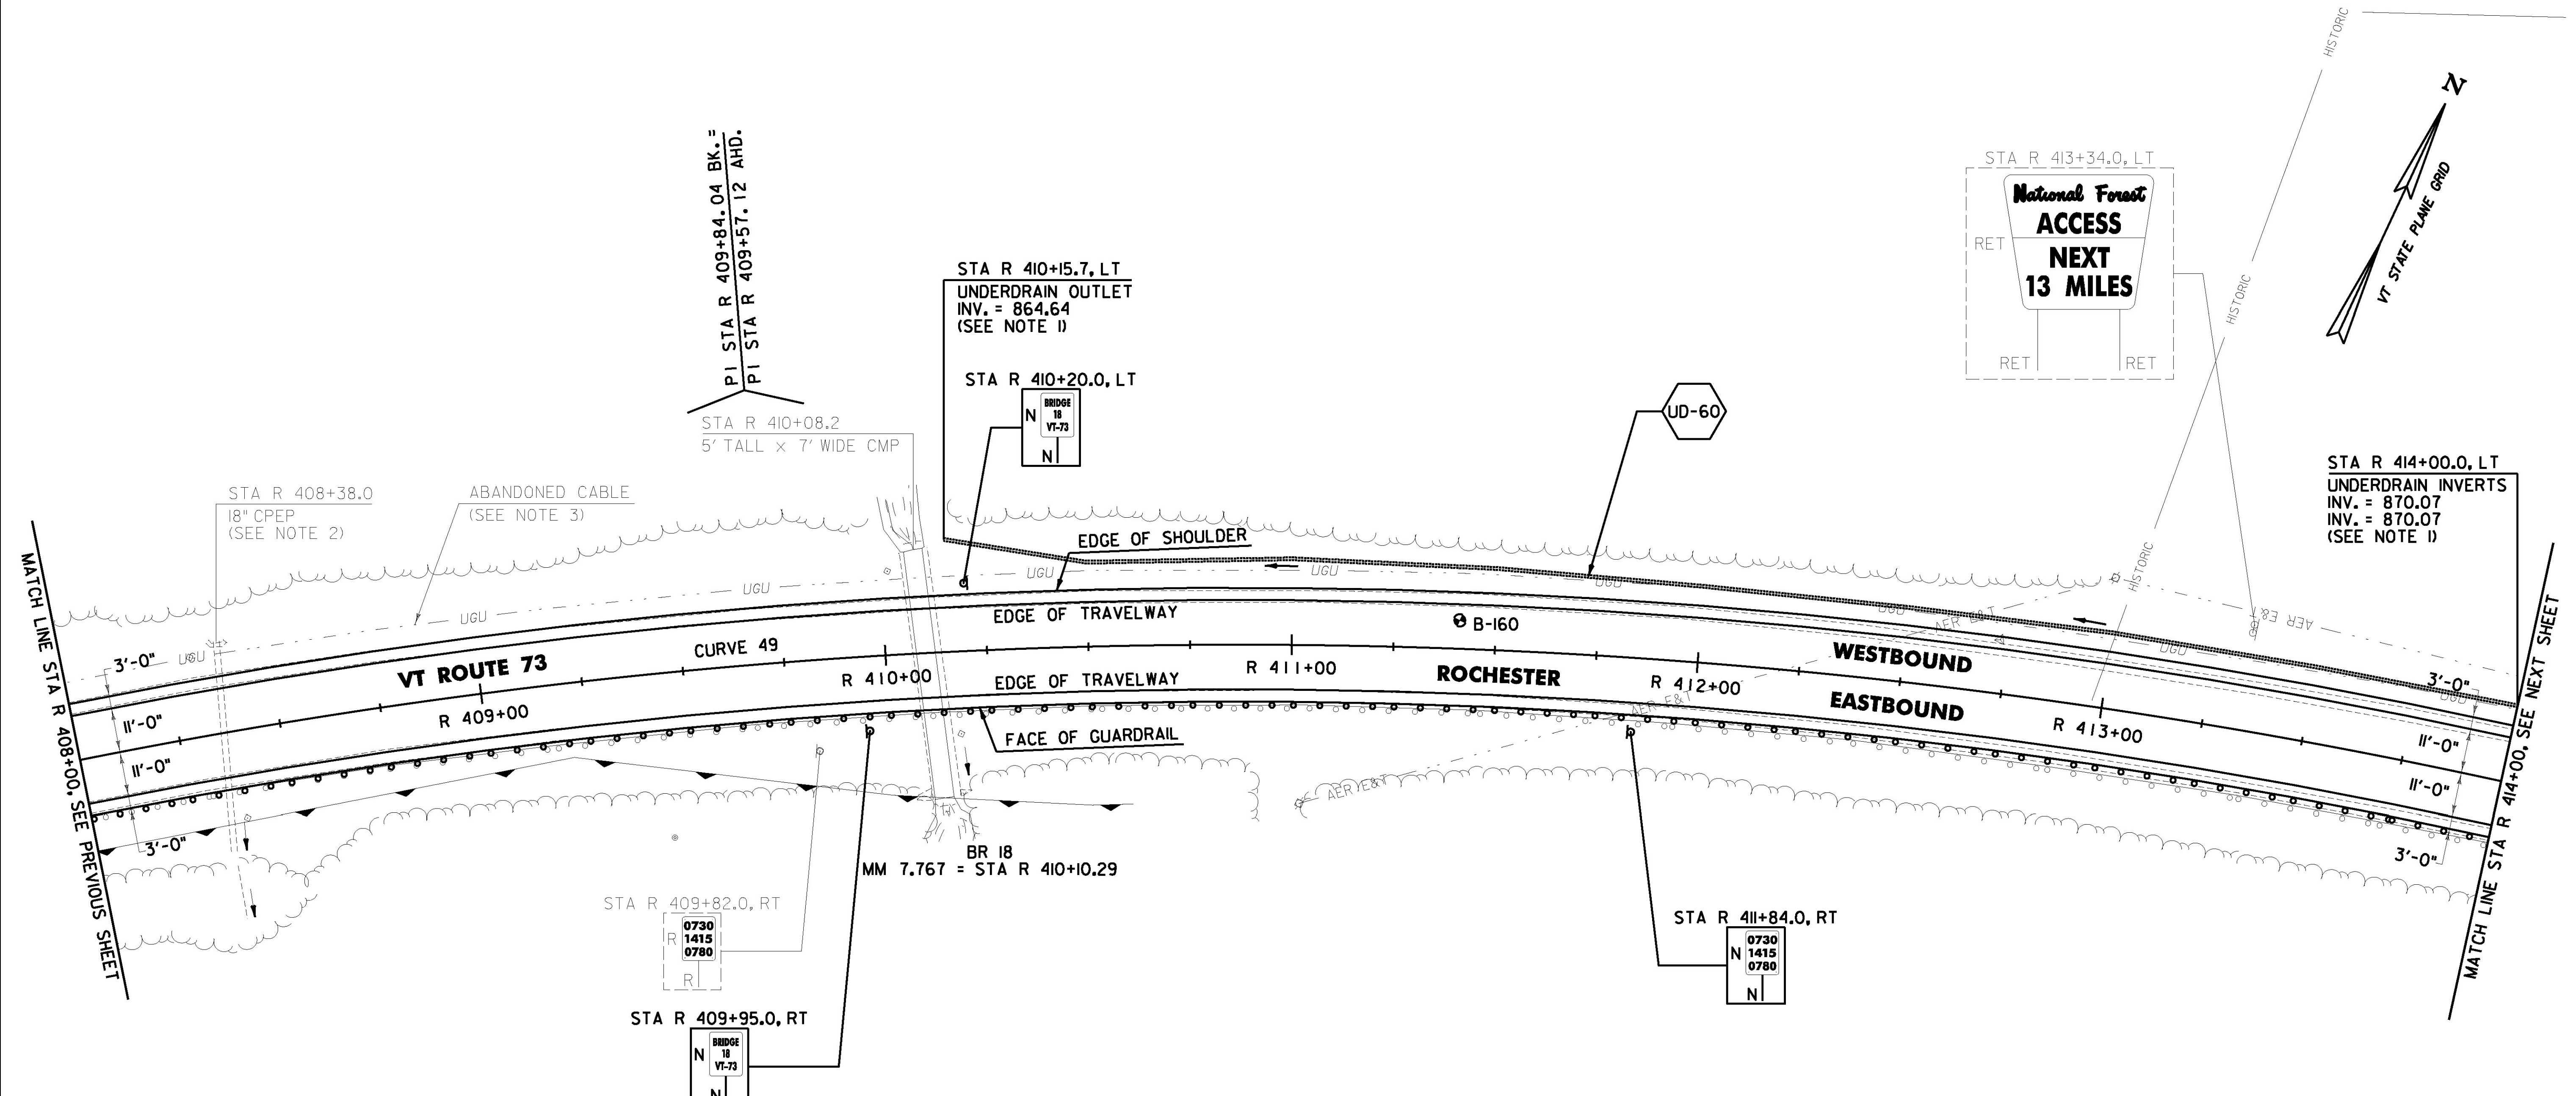

6 INCH UNDERDRAIN PIPE
ROCHESTER:
STA R 410+15.7 - STAR 414+00.0 LT

PROJECT DEMARCATION FENCE
ROCHESTER:
STA R ~~408+00.0~~ - STA R 414+00.0 LT & RT
410+16.00

BARRIER FENCE
ROCHESTER:
~~STA R 408+00.0 - STA R 411+60.0 RT~~
~~STA R 411+97.0 - STA R 414+00.0 LT~~


**STEEL BEAM GUARDRAIL, GALVANIZED
W/ 8 FEET POSTS**
ROCHESTER:
STA R 408+00.0 - STA R 414+00.0 RT

REMOVAL AND DISPOSAL OF GUARDRAIL
ROCHESTER:
STA R 408+00.0 - STA R 414+00.0 RT

SOIL BORING DATA			
BORING #	DEPTH (FT.)	PCC	COMMENTS
B-160	5.0	NO	

CURVE 49
 $\Delta = 34^\circ 18' 54''$ RT
 $D = 3^\circ 57' 05''$
 $R = 1450.00'$
 $T = 447.67'$
 $L = 868.42'$
 $E = 67.53'$
 $e = 0.064$ FT/FT

SIGN LEGEND
R = REMOVE
S = SALVAGE
N = NEW
RET = RETAIN
B-B = BACK TO BACK
EXISTING = - - - - -
NEW = _____
R = RETURN TO TOWN
O = OF ROCHESTER

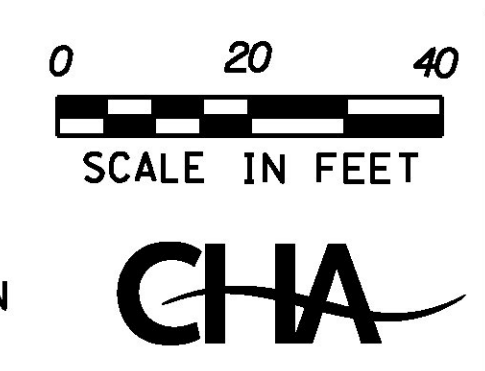

- NOTES:**
- SEE SHEETS 26 & 27 FOR UNDERDRAIN DETAILS.
 - THE CONTRACTOR SHALL ADJUST THE PROPOSED SIDE SLOPE TO AVOID FILLING IN THE EXISTING PIPE AS DIRECTED BY THE ENGINEER.
 - THE CONTRACTOR SHALL CALL DIG SAFE AT 811 TO VERIFY LOCATION OF BURIED ABANDONED CABLE.

PROJECT NAME: ROCHESTER
PROJECT NUMBER: ER STP 0162(21)

FILE NAME: z13cl76bdr.dgn
PROJECT LEADER: D. GOZALKOWSKI
DESIGNED BY: J. OLSEN
PROJECT LAYOUT SHEET #71

PLOT DATE: 1/11/2017
DRAWN BY: J. HEALD
CHECKED BY: J. SHIELDS
SHEET 103 OF 360