
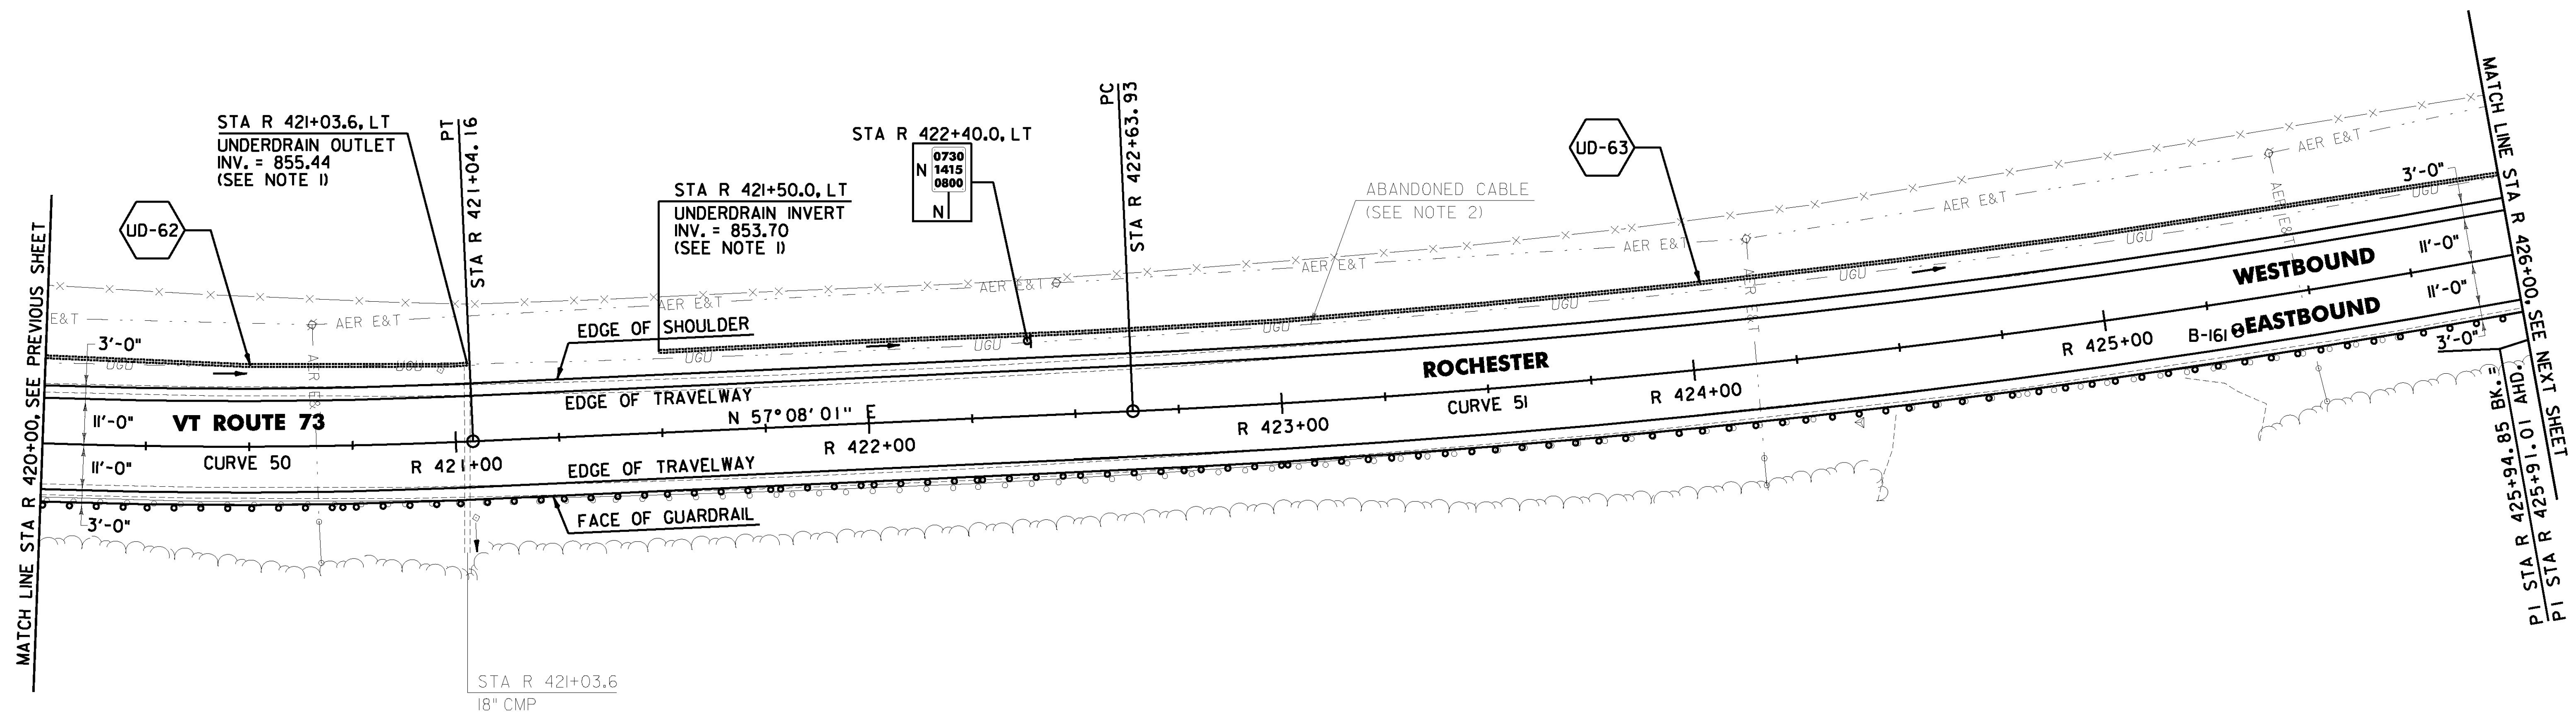


DURABLE 4 INCH WHITE LINE (OPTION ITEM) AND TEMPORARY 4 INCH WHITE LINE, PAINT (ALL LINES WILL INCLUDE EDGE LINE BREAKS AND RADIUS FOR TOWN HIGHWAYS)
 ROCHESTER:
 STA R 420+00.00 - STA R 426+00.00 LT & RT

DURABLE 4 INCH YELLOW LINE (OPTION ITEM) AND TEMPORARY 4 INCH YELLOW LINE, PAINT (ALL LINES WILL INCLUDE C/L BREAKS FOR TOWN HIGHWAYS) S = SOLID, D = DASHED
 ROCHESTER:
 STA R 420+00.00 - STA R 426+00.00 LT & RT
 S - S

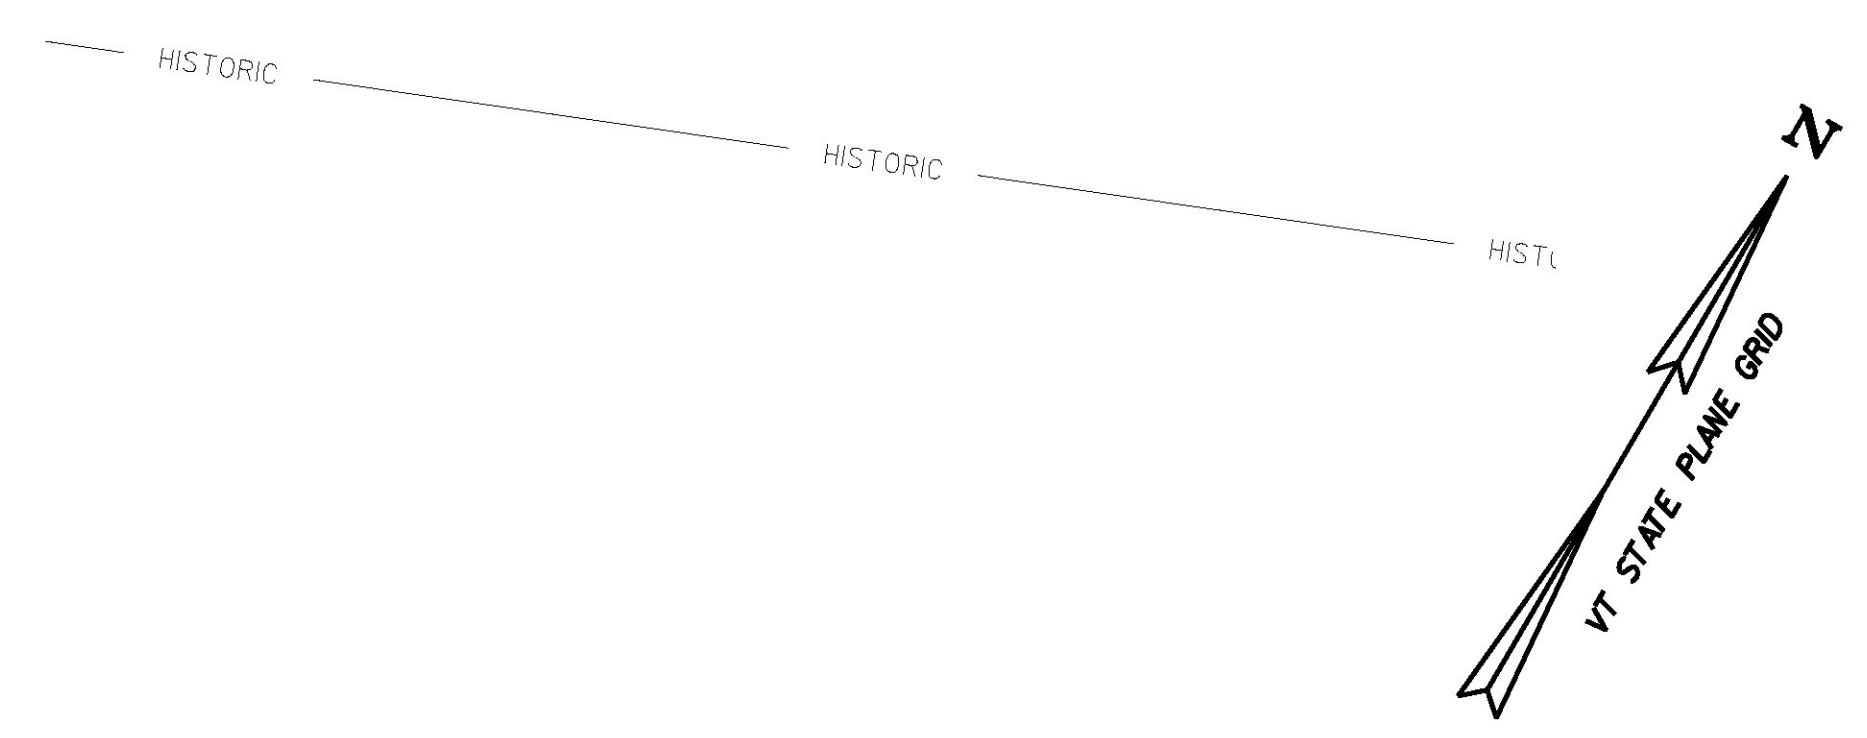

6 INCH UNDERDRAIN PIPE
 ROCHESTER:
 STA R 420+00.0 - STA R 421+03.6 LT
 STA R 421+50.0 - STA R 426+00.0 LT

PROJECT DEMARCATION FENCE
 ROCHESTER:
~~STA R 420+00.0 - STA R 426+00.0 LT & RT~~

BARRIER FENCE
 ROCHESTER:
~~STA R 420+00.0 - STA R 426+00.0 LT~~

STEEL BEAM GUARDRAIL, GALVANIZED W/ 8 FEET POSTS
 ROCHESTER:
 STA R 420+00.0 - STA R 426+00.0 RT

REMOVAL AND DISPOSAL OF GUARDRAIL
 ROCHESTER:
 STA R 420+00.0 - STA R 426+00.0 RT

SOIL BORING DATA			
BORING #	DEPTH (FT.)	PCC	COMMENTS
B-161	5.0	NO	AUGER GRINDING 0.6' - 2.5'

CURVE 50	CURVE 51
Δ = 20°22'59" LT	Δ = 15°04'49" LT
D = 4°30'41"	D = 2°17'31"
R = 1270.00'	R = 2500.00'
T = 228.32'	T = 330.92'
L = 451.81'	L = 658.01'
E = 20.36'	E = 21.81'
e = 0.068 FT/FT	e = 0.044 FT/FT

SIGN LEGEND
 R = REMOVE
 S = SALVAGE
 N = NEW
 RET = RETAIN
 B-B = BACK TO BACK
 EXISTING = _____
 NEW = _____
 R = RETURN TO TOWN OF ROCHESTER



NOTES:

- SEE SHEETS 26 & 27 FOR UNDERDRAIN DETAILS.
- THE CONTRACTOR SHALL CALL DIG SAFE AT 811 TO VERIFY LOCATION OF BURIED ABANDONED CABLE.

PROJECT NAME: ROCHESTER
 PROJECT NUMBER: ER STP 0162(21)

FILE NAME: z13cl76bdr.dgn
 PROJECT LEADER: D. GOZALKOWSKI
 DESIGNED BY: J. OLSEN
 PROJECT LAYOUT SHEET #73

PLOT DATE: 1/11/2017
 DRAWN BY: J. HEALD
 CHECKED BY: J. SHIELDS
 SHEET 105 OF 360