
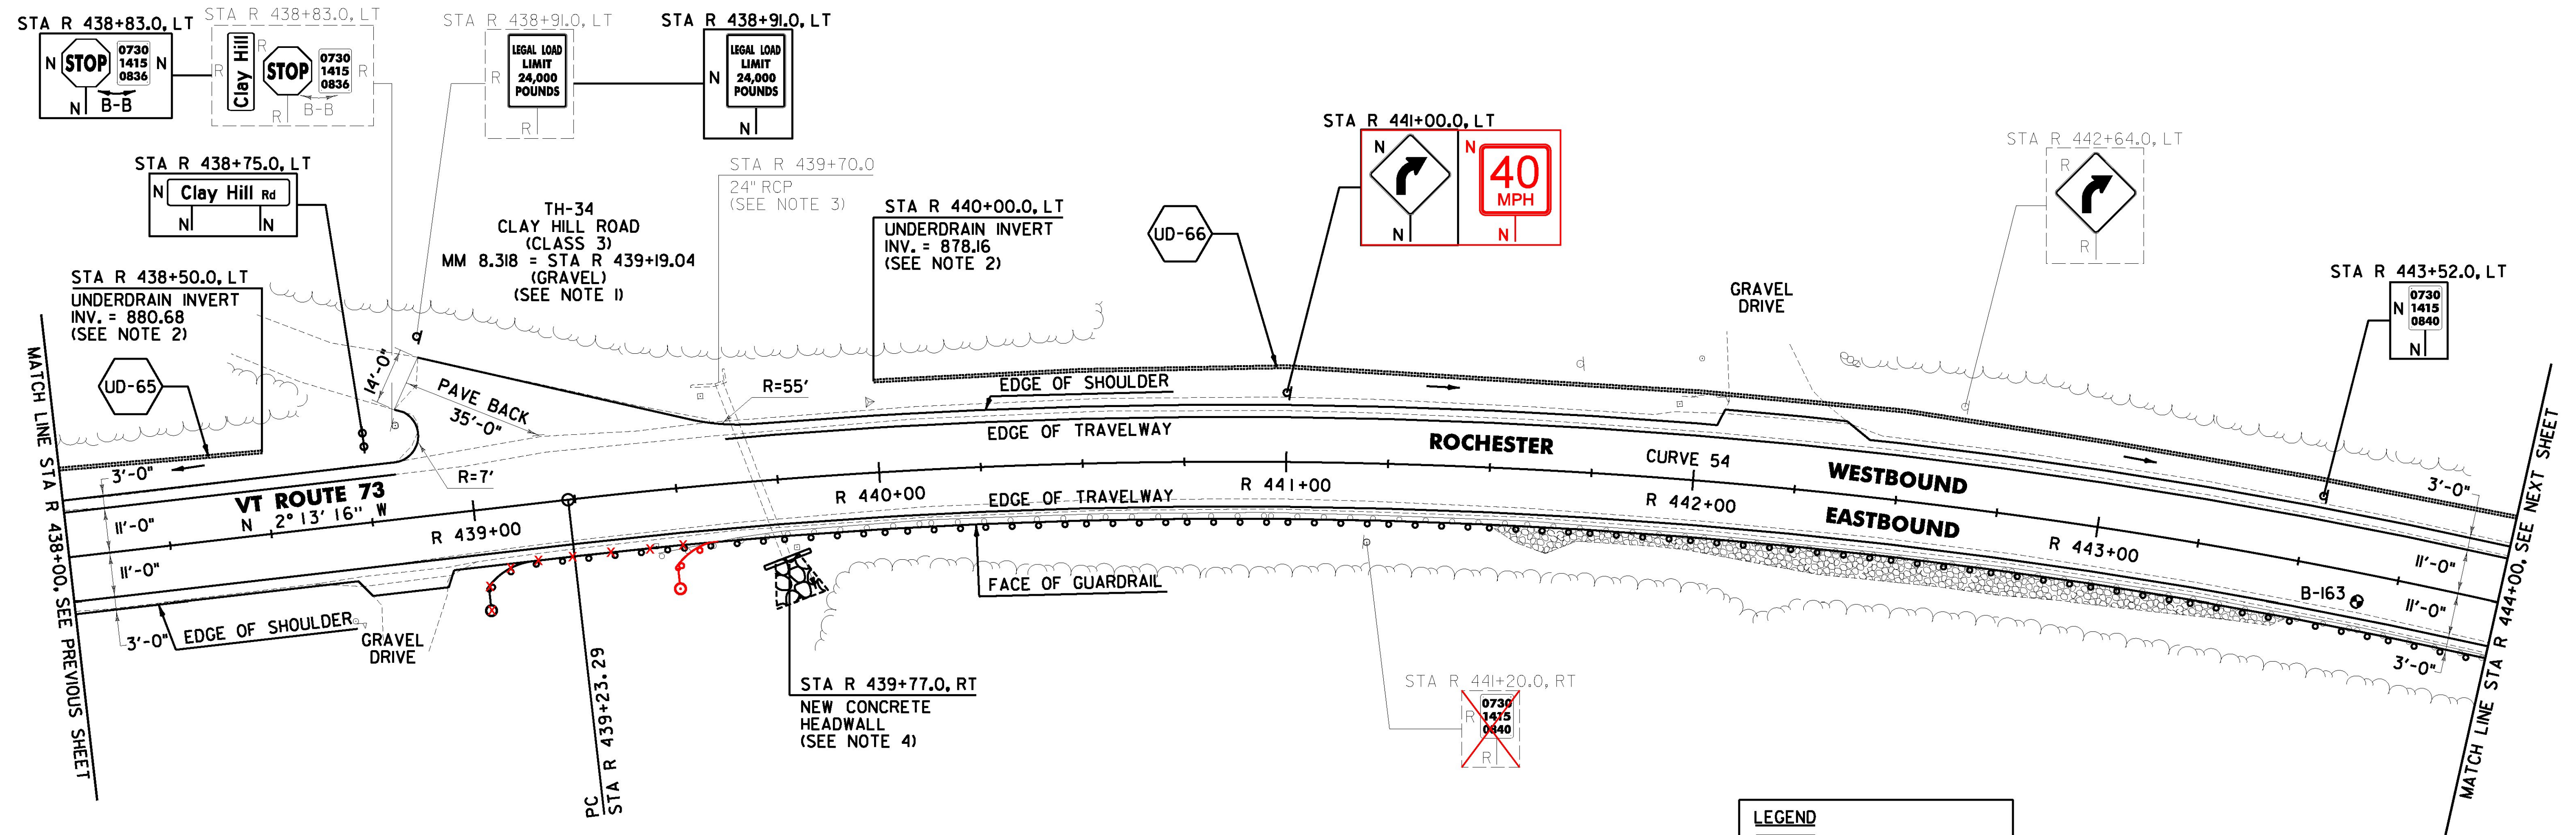


DURABLE 4 INCH WHITE LINE (OPTION ITEM) AND TEMPORARY 4 INCH WHITE LINE, PAINT (ALL LINES WILL INCLUDE EDGE LINE BREAKS AND RADIUS FOR TOWN HIGHWAYS)
 ROCHESTER:
 STA R 438+00.00 - STA R 444+00.00 LT & RT

DURABLE 4 INCH YELLOW LINE (OPTION ITEM) AND TEMPORARY 4 INCH YELLOW LINE, PAINT (ALL LINES WILL INCLUDE C/L BREAKS FOR TOWN HIGHWAYS) S = SOLID, D = DASHED
 ROCHESTER:
 STA R 438+00.00 - STA R 444+00.00 LT & RT
 S - S

REMOVING SIGNS AS SHOWN - 6

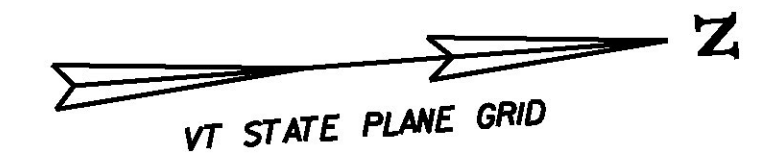

EROSION LOG
 ROCHESTER:
 STA R 441+50.0 - STA R 443+50.0 RT

STONE FILL, TYPE I
 ROCHESTER:
 STA R 441+50.0 - STA R 443+50.0 RT

STONE FILL, TYPE II
 ROCHESTER:
 STA R 439+77.0 RT

GRUBBING MATERIAL (6")
 ROCHESTER:
 STA R 441+50.0 - STA R 443+50.0 RT

STEEL BEAM GUARDRAIL, GALVANIZED W/ 8 FEET POSTS
 ROCHESTER:
 STA R 439+01.0 - STA R 444+00.0 RT

ANCHOR FOR STEEL BEAM RAIL
 ROCHESTER:
 STA R 439+09.5 RT

6 INCH UNDERDRAIN PIPE
 ROCHESTER:
 STA R 438+00.0 - STA R 438+50.0 LT
 STA R 440+00.0 - STA R 444+00.0 LT

PROJECT DEMARCATION FENCE
 ROCHESTER:
~~STA R 438+00.0 - STA R 438+89.0 LT~~
~~STA R 438+00.0 - STA R 438+73.0 RT~~
~~STA R 438+91.0 - STA R 442+06.0 LT~~
~~STA R 438+92.0 - STA R 444+00.0 RT~~
~~STA R 442+36.0 - STA R 444+00.0 LT~~

BARRIER FENCE
 ROCHESTER:
 STA R 440+33.0 - STA R 444+00.0 RT

REMOVAL AND DISPOSAL OF GUARDRAIL
 ROCHESTER:
 STA R 439+44.0 - STA R 444+00.0 RT

DELINATOR WITH STEEL POST
 ROCHESTER:
 STA R 439+01.0 RT

CURVE 54
 $\Delta = 39^{\circ}53'22''$ RT
 $D = 4^{\circ}02'06''$
 $R = 1420.00'$
 $T = 515.29'$
 $L = 988.61'$
 $E = 90.60'$
 $e = 0.052$ FT/FT

SOIL BORING DATA			
BORING #	DEPTH (FT.)	PCC	COMMENTS
B-163	5.0	NO	

LEGEND

ITEM 613.II
 STONE FILL, TYPE I

ITEM 613.II
 STONE FILL, TYPE II

- NOTES:**
- PAVING LIMIT ON ALL TOWN HIGHWAYS SHALL BE MEASURED 25 FT BACK FROM VT. ROUTE 73 EDGE OF SHOULDER UNLESS DENOTED OTHERWISE ON THE PLANS OR AS DIRECTED BY THE ENGINEER.
 - SEE SHEETS 26 & 27 FOR UNDERDRAIN DETAILS.
 - THE CONTRACTOR SHALL ADJUST THE PROPOSED SIDE SLOPE TO AVOID FILLING IN THE EXISTING PIPE AS DIRECTED BY THE ENGINEER.
 - THE CONTRACTOR SHALL ADJUST THE PROPOSED SIDE SLOPE IN ORDER TO PLACE HEADWALL IN PROPOSED LOCATION AS DIRECTED BY THE ENGINEER.

SIGN LEGEND

R = REMOVE
 S = SALVAGE
 N = NEW
 RET = RETAIN
 B-B = BACK TO BACK
 EXISTING = _____
 NEW = _____
 R = RETURN TO TOWN OF ROCHESTER

0 20 40
 SCALE IN FEET

PROJECT NAME: ROCHESTER
 PROJECT NUMBER: ER STP 0162(21)

FILE NAME: z13cl76bdr.dgn
 PROJECT LEADER: D. GOZALKOWSKI
 DESIGNED BY: J. OLSEN
 PROJECT LAYOUT SHEET #76

PLOT DATE: 1/11/2017
 DRAWN BY: J. HEALD
 CHECKED BY: J. SHIELDS
 SHEET 108 OF 360