




R 6+00.00

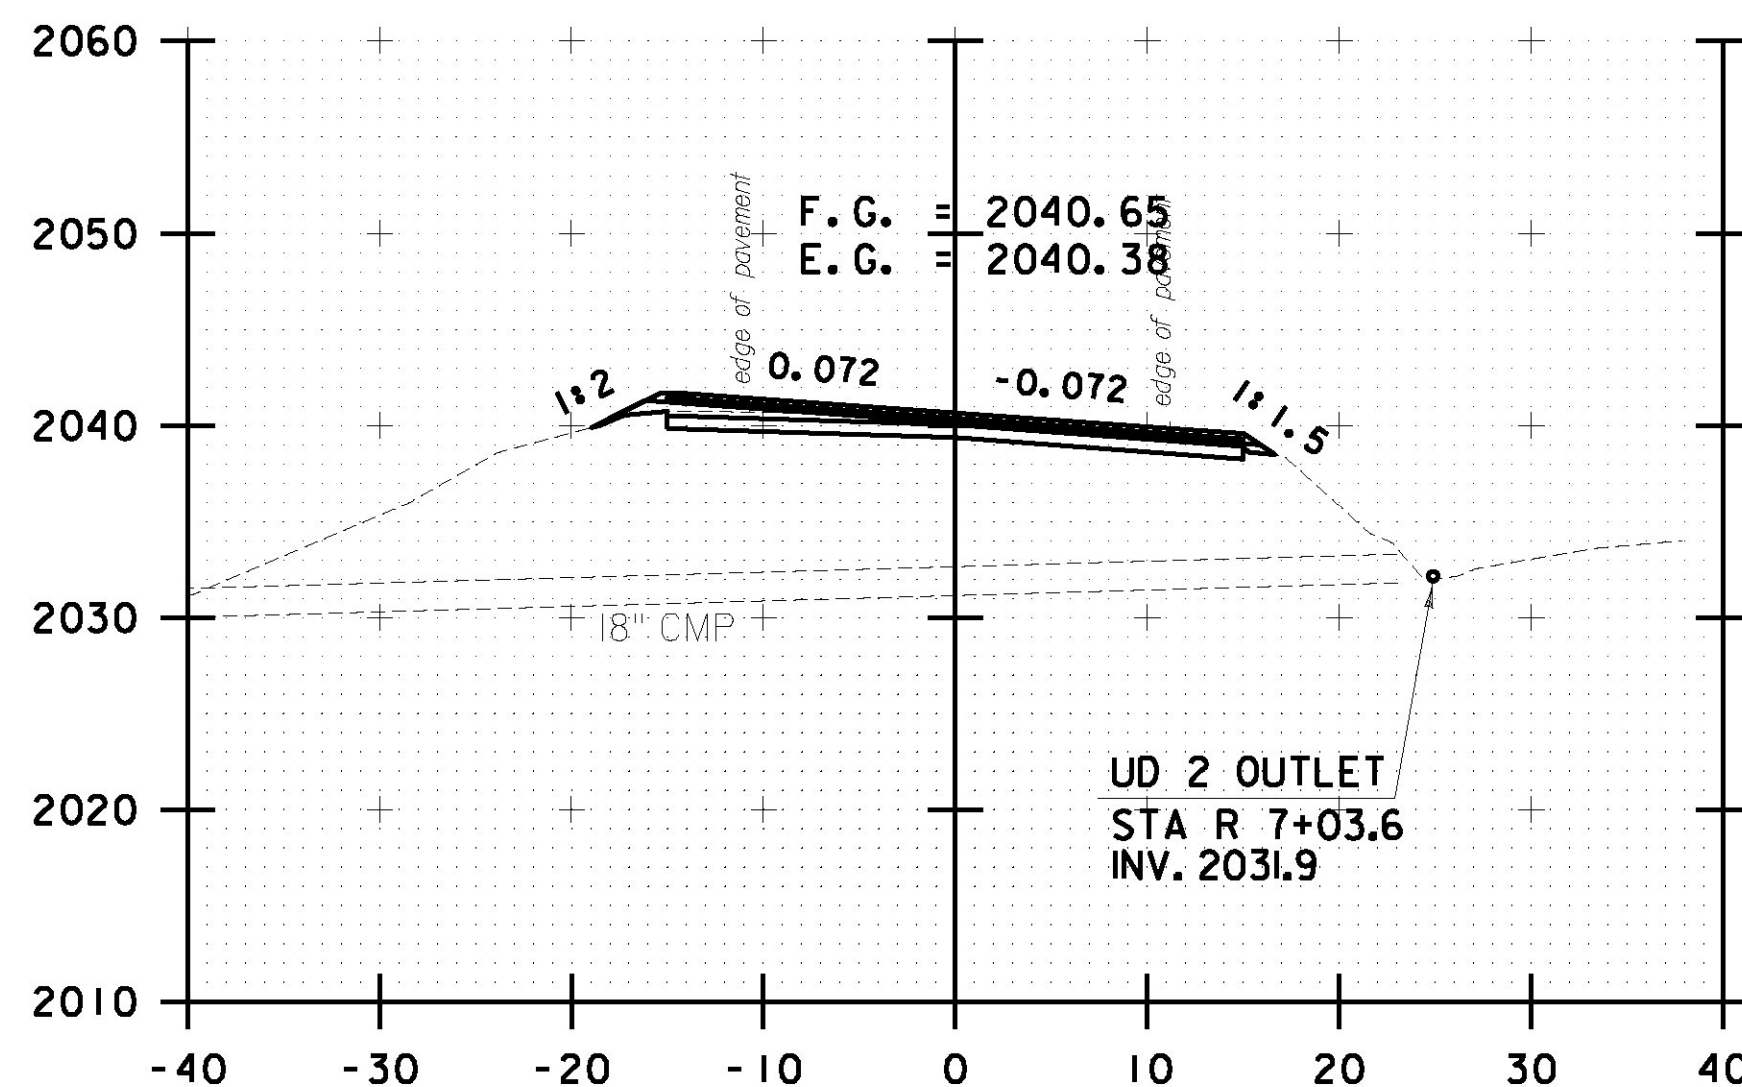


R 7+00.00

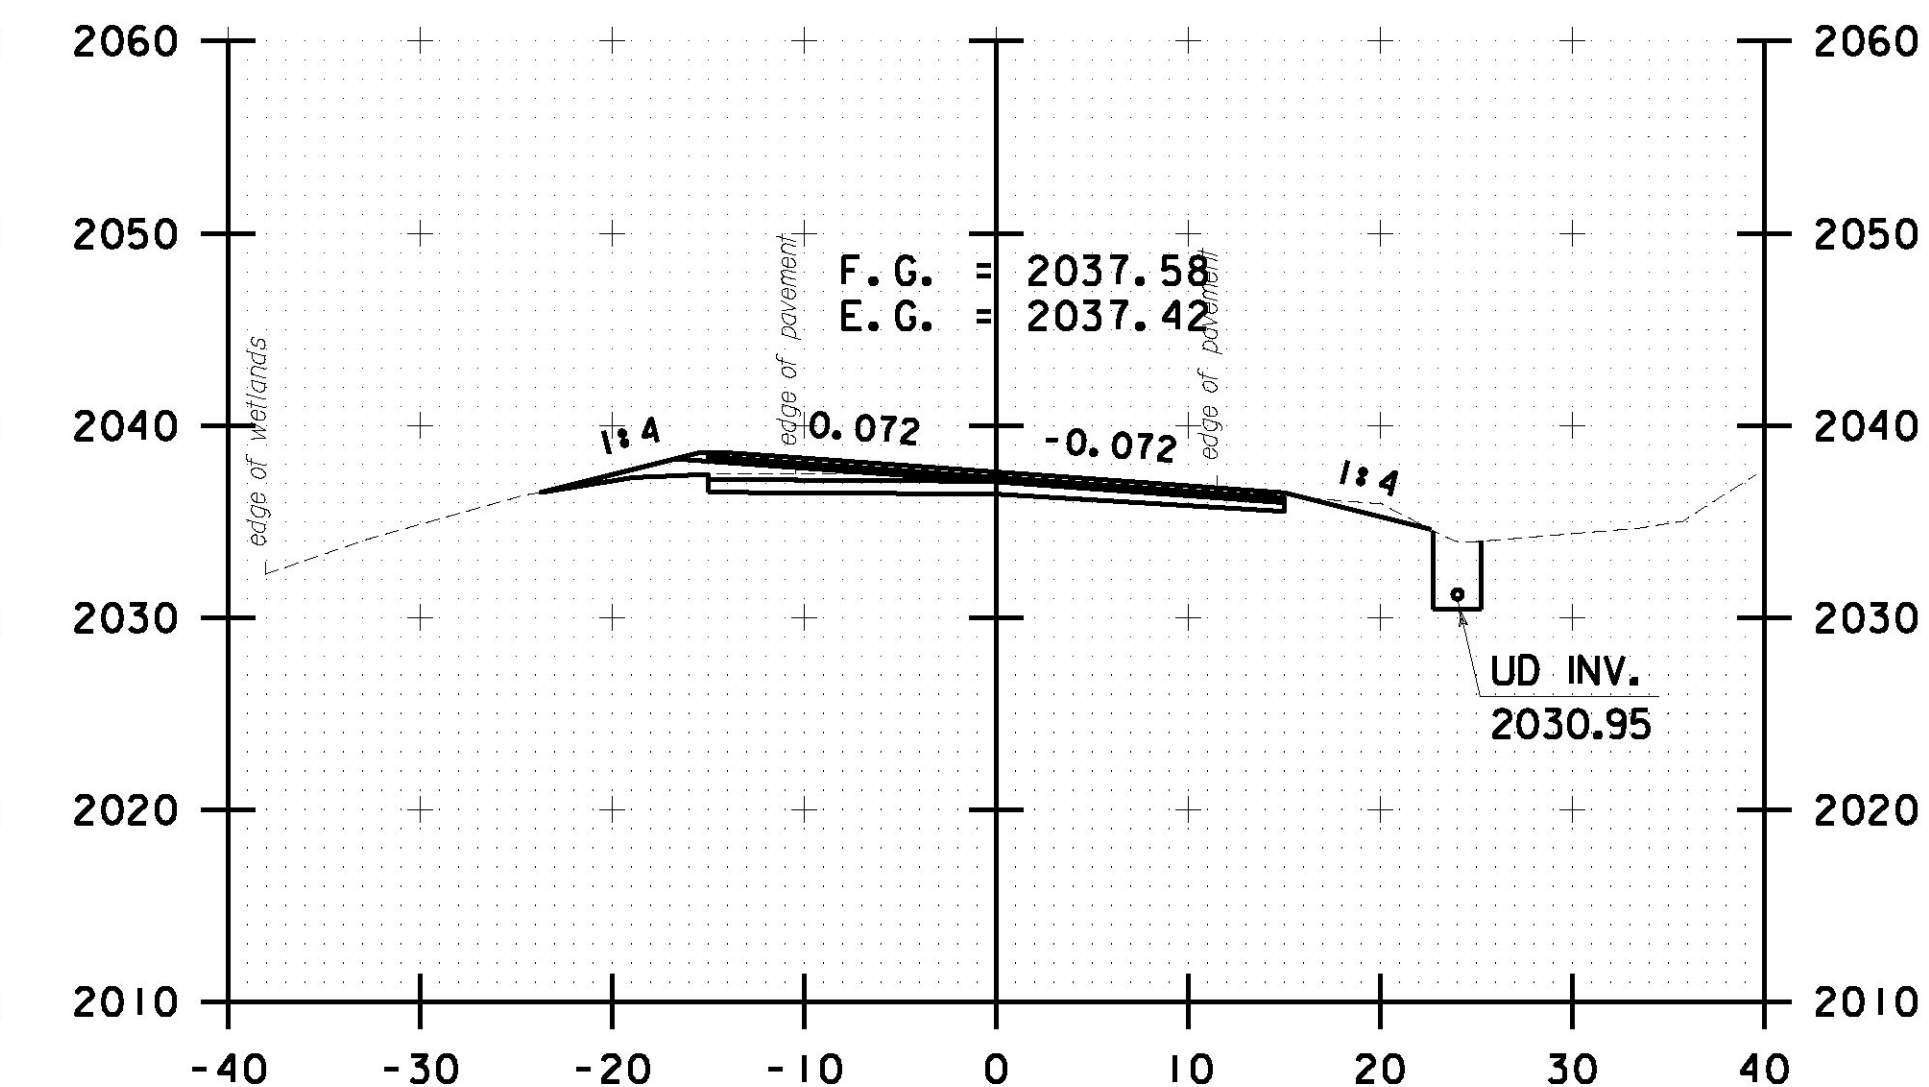


R 8+00.00

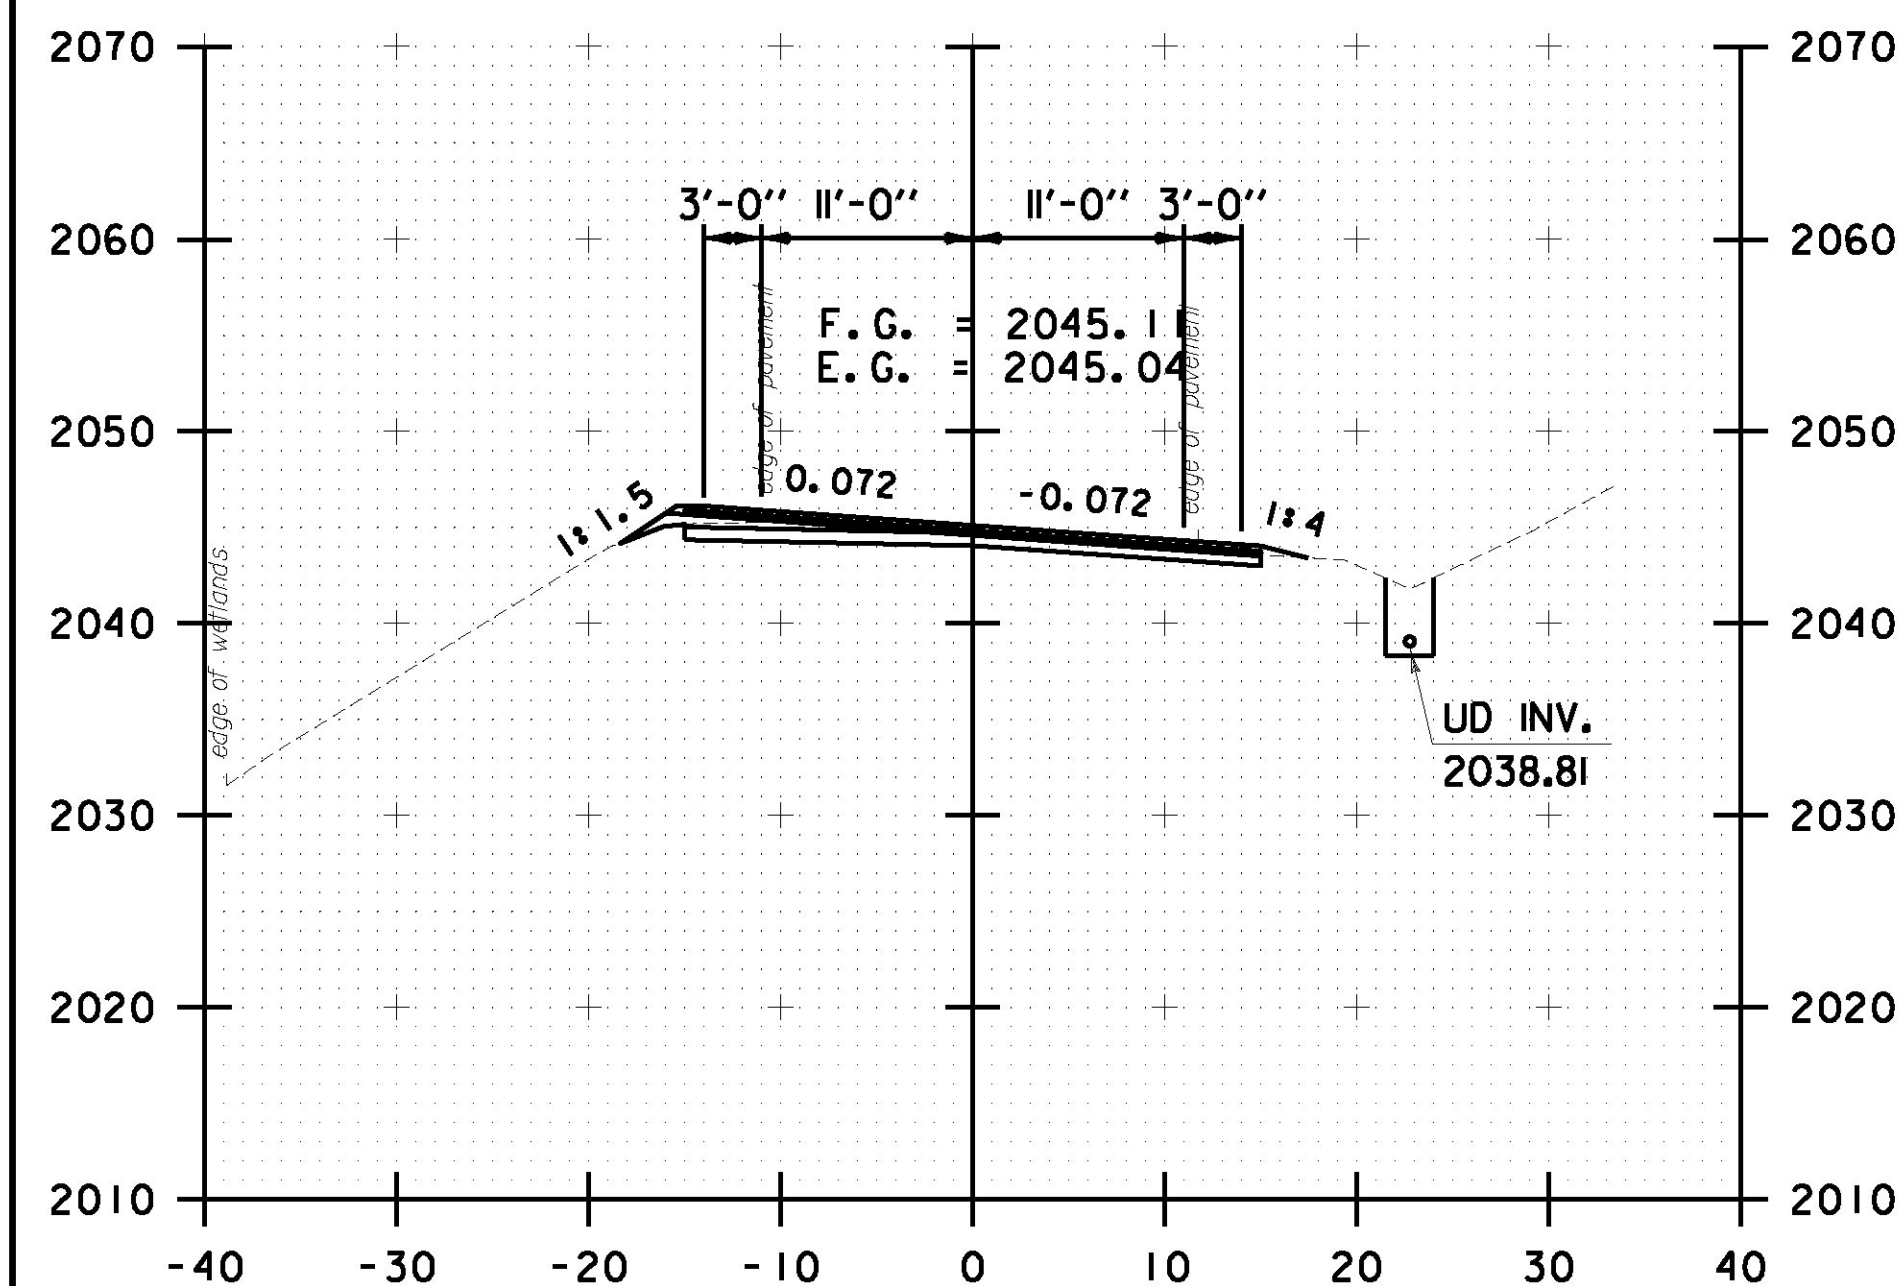


R 5+50.00

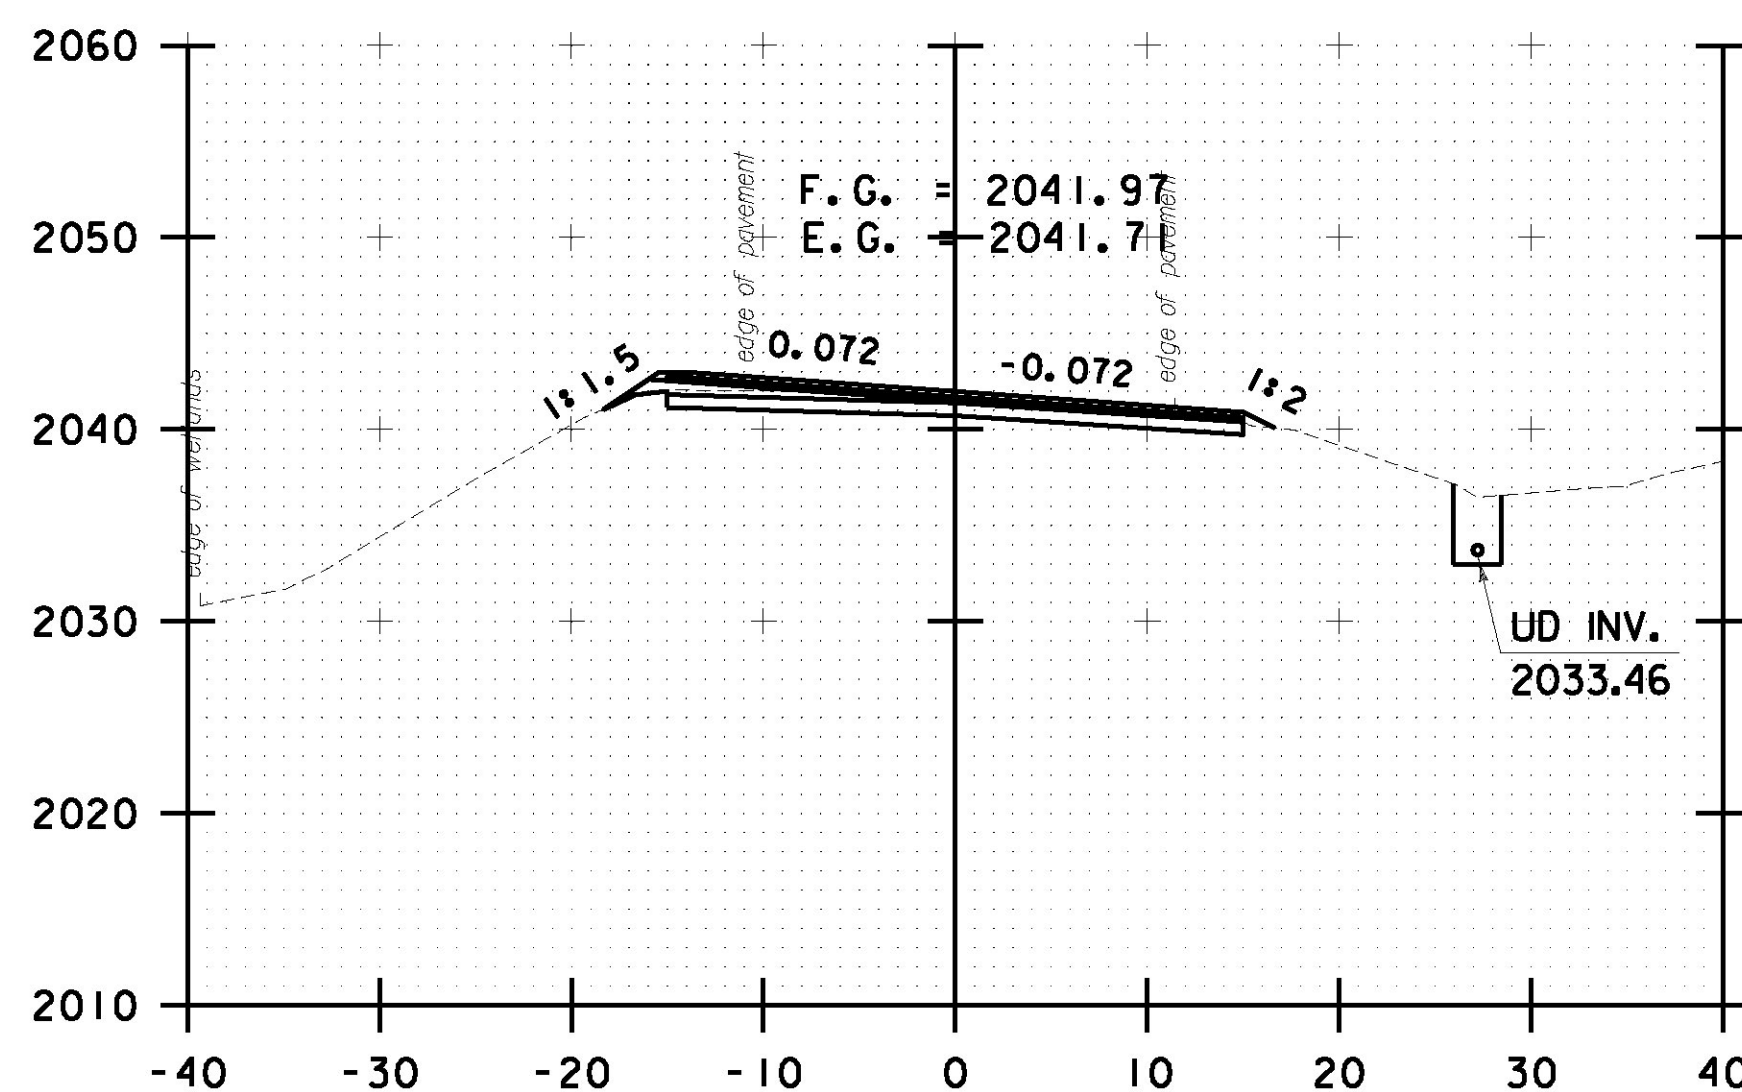

R 6+50.00

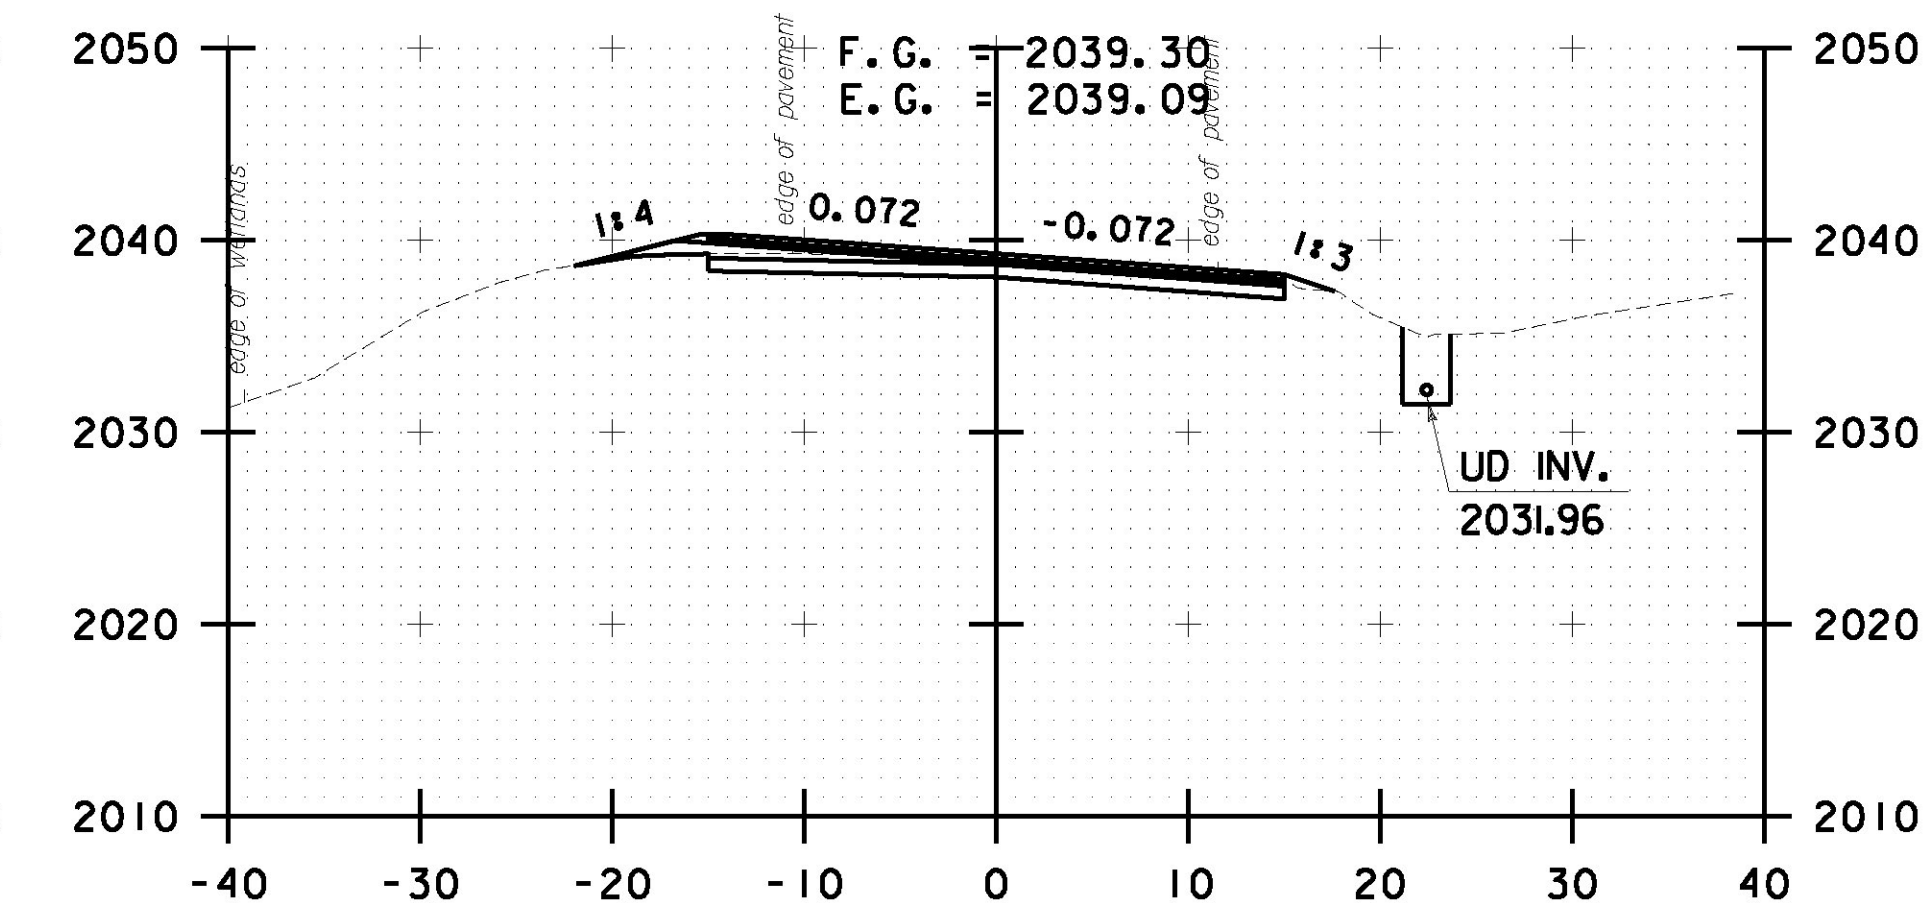

R 7+50.00

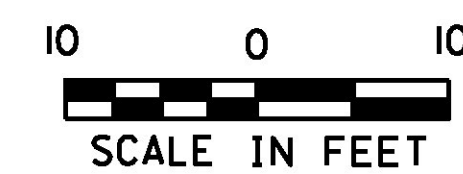

PROJECT NAME: ROCHESTER  
PROJECT NUMBER: ER STP 0162(21)

FILE NAME: z13cl76xc.dgn  
PROJECT LEADER: D. GOZALKOWSKI  
DESIGNED BY: J. OLSEN  
ROCHESTER CROSS SECTION SHEET #3

PLOT DATE: 1/12/2017  
DRAWN BY: J. HEALD  
CHECKED BY: J. SHIELDS  
SHEET 189 OF 360