




R 55+50.00

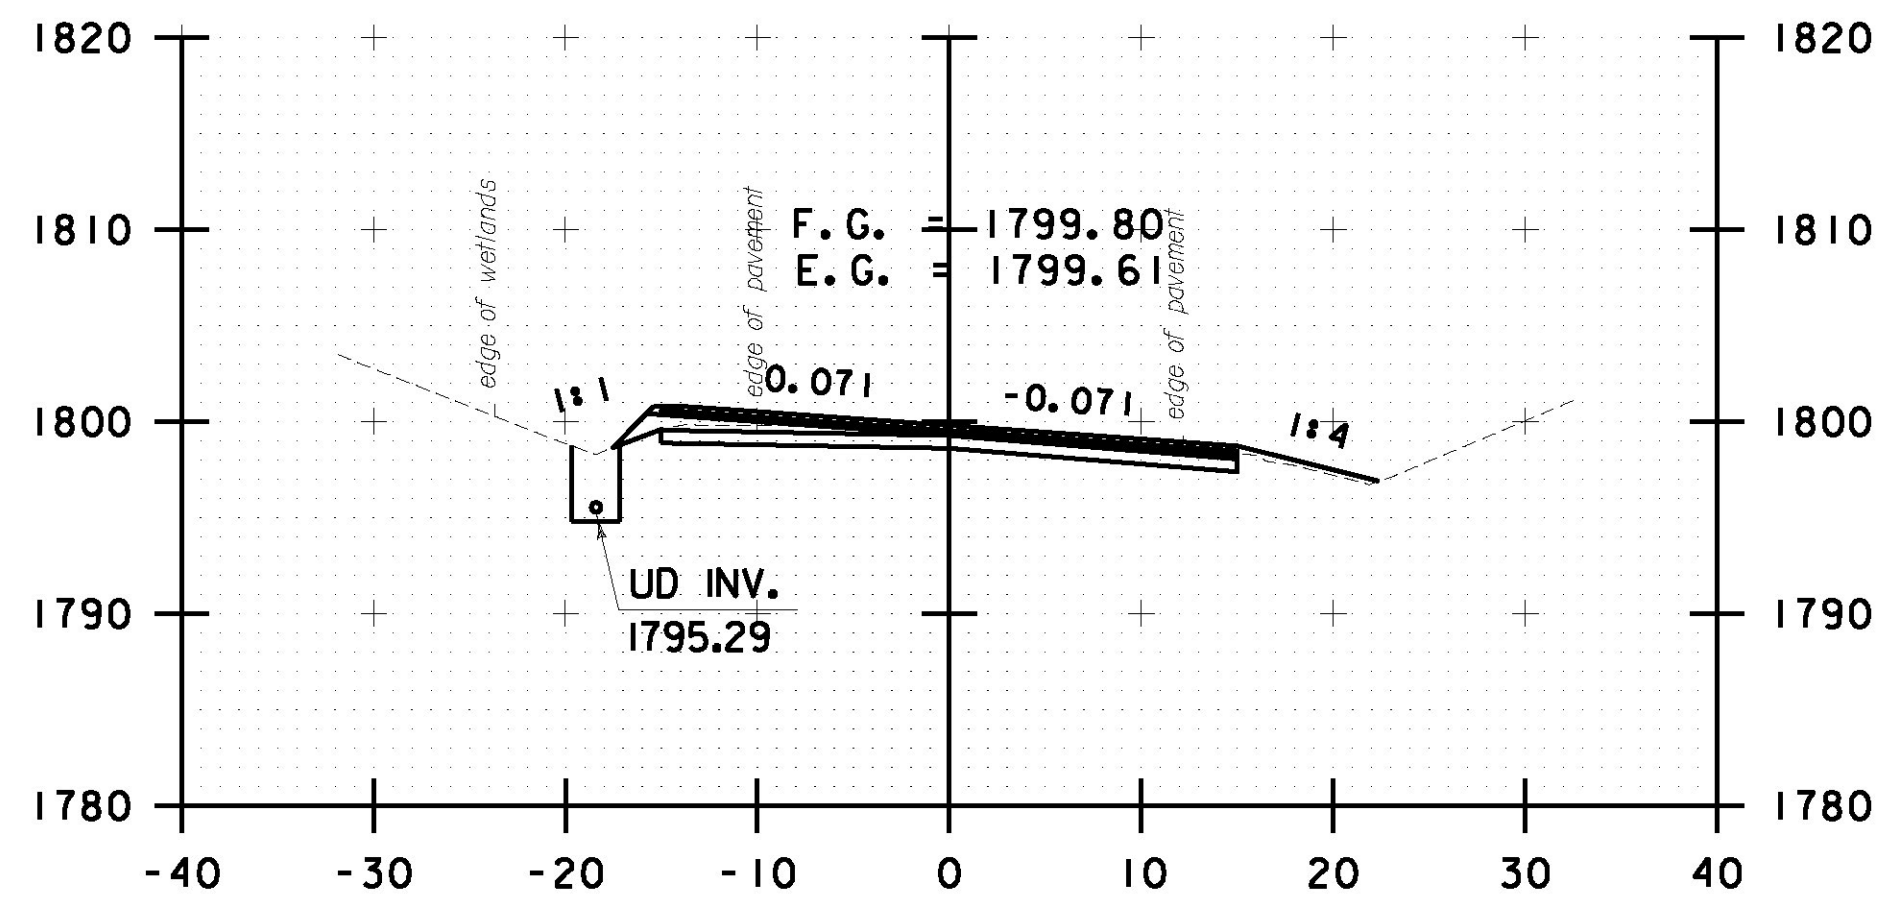


R 57+00.00

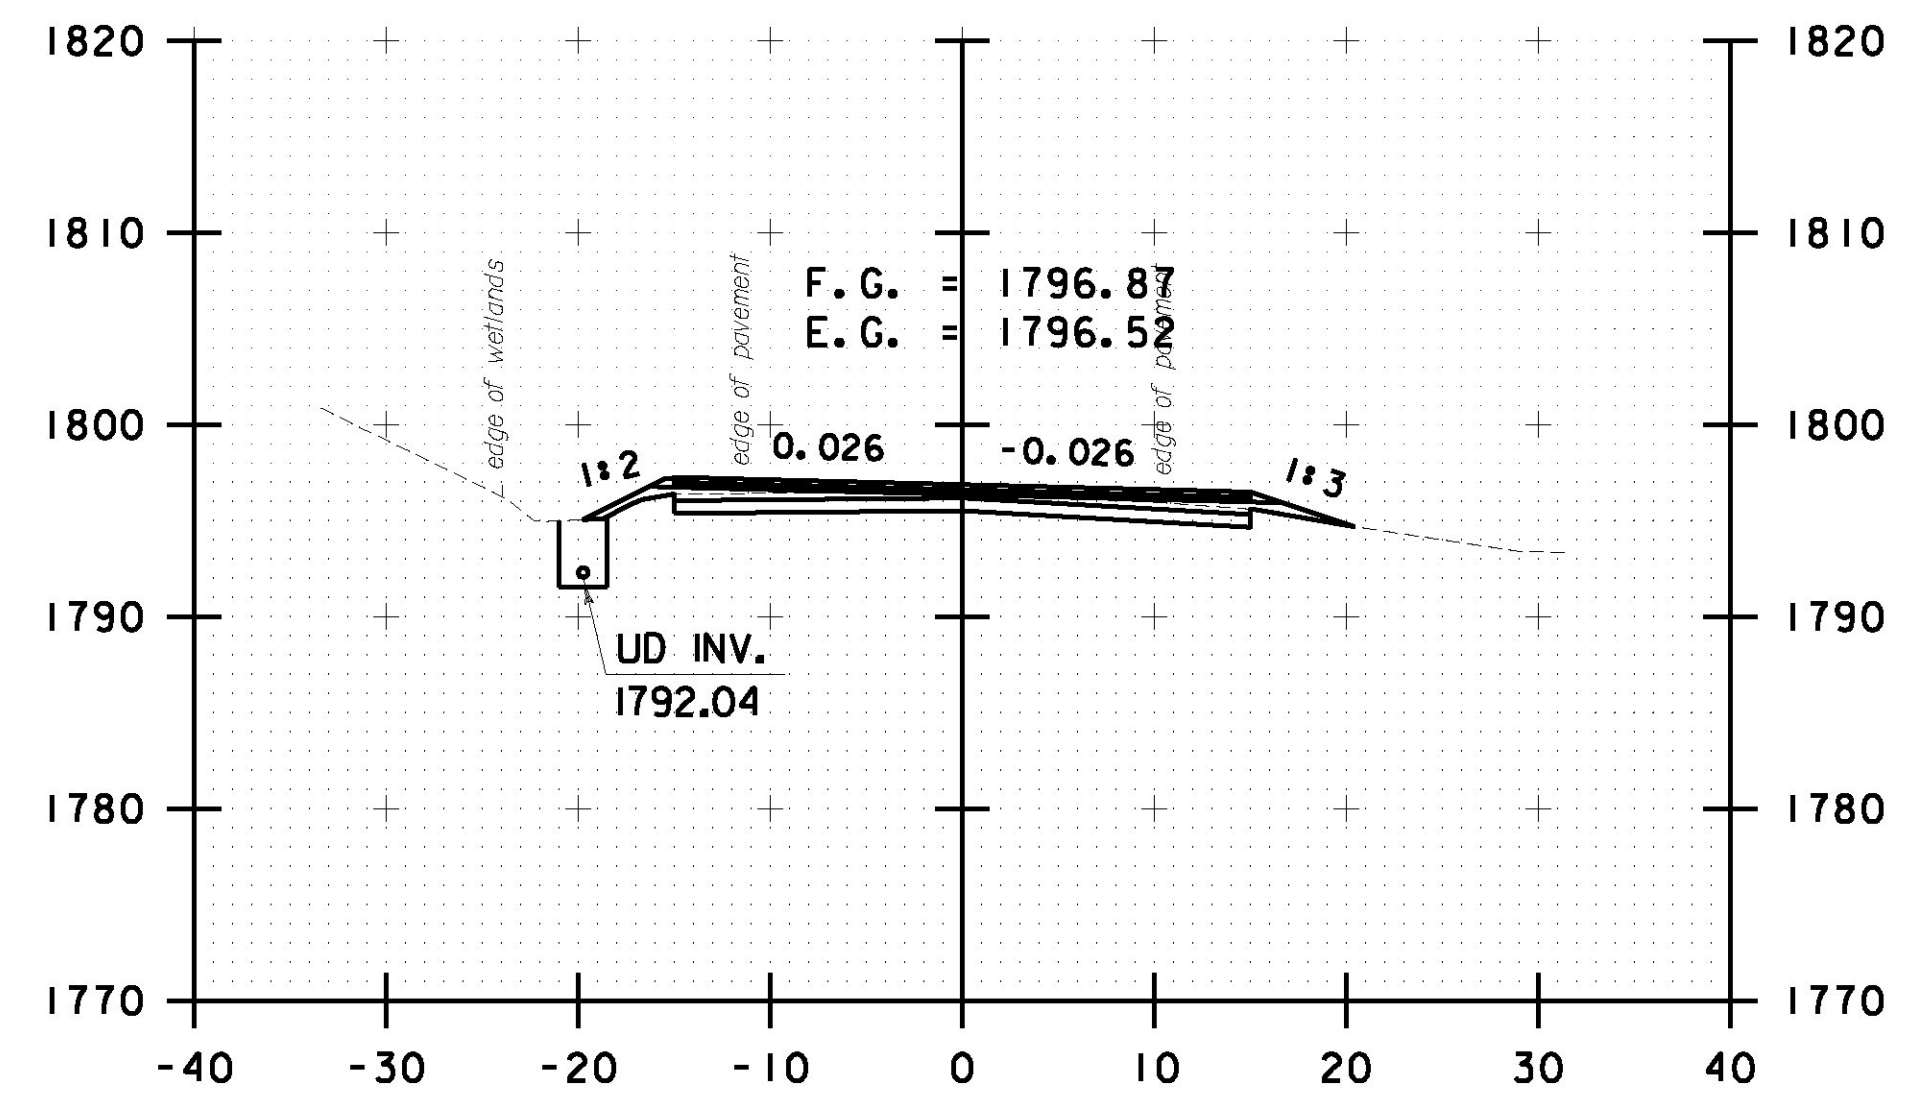


R 58+00.00

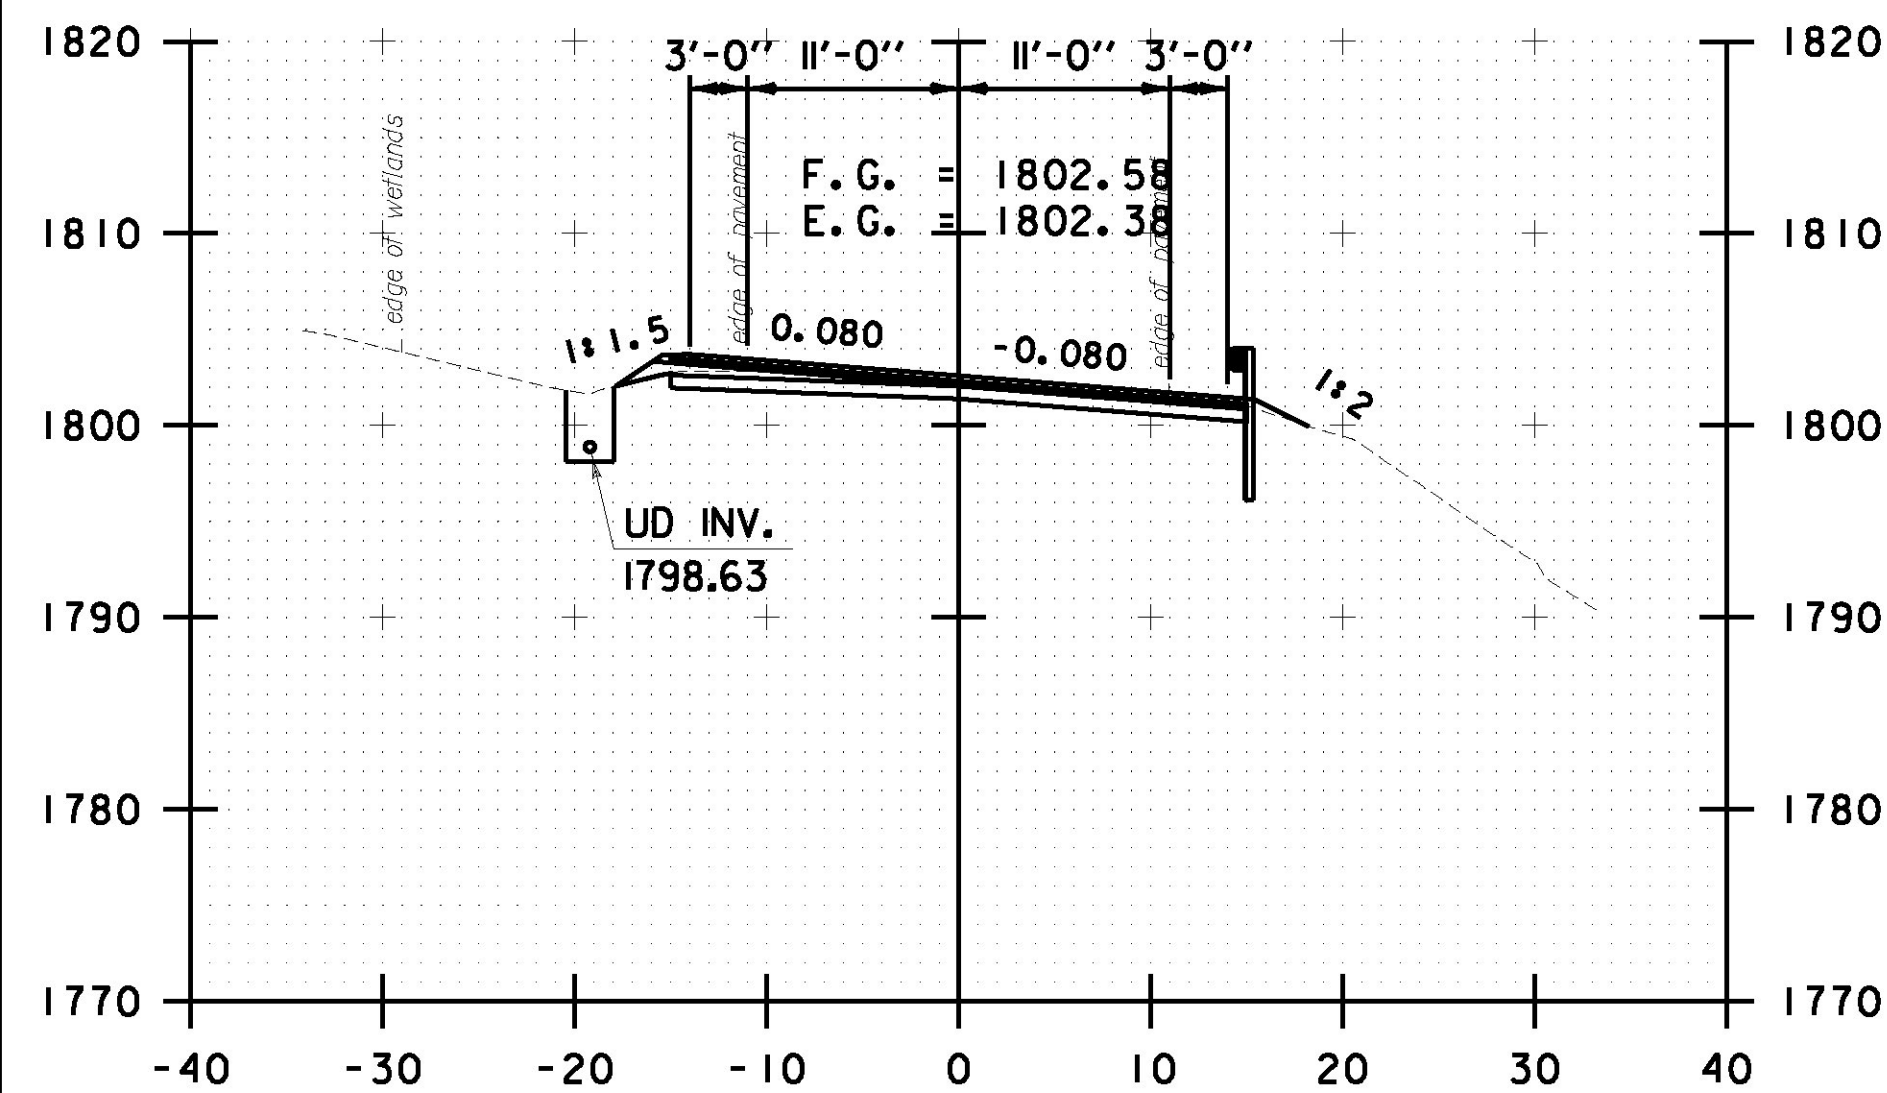


R 55+00.00

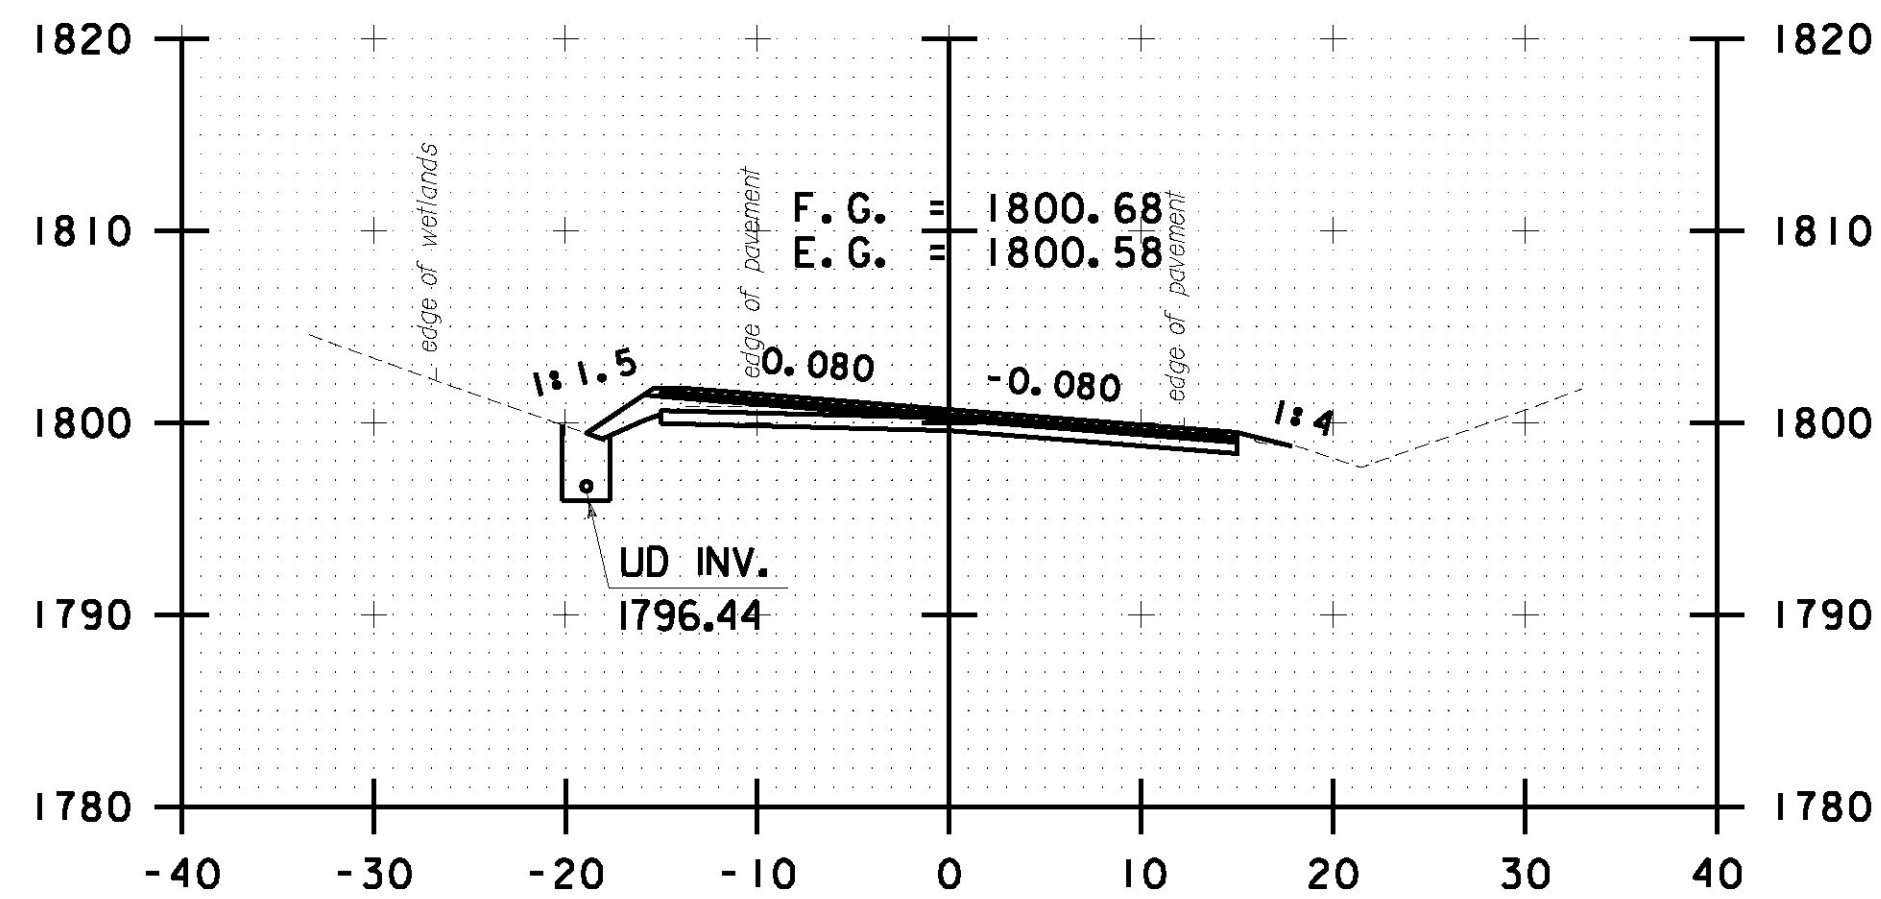


R 56+50.00

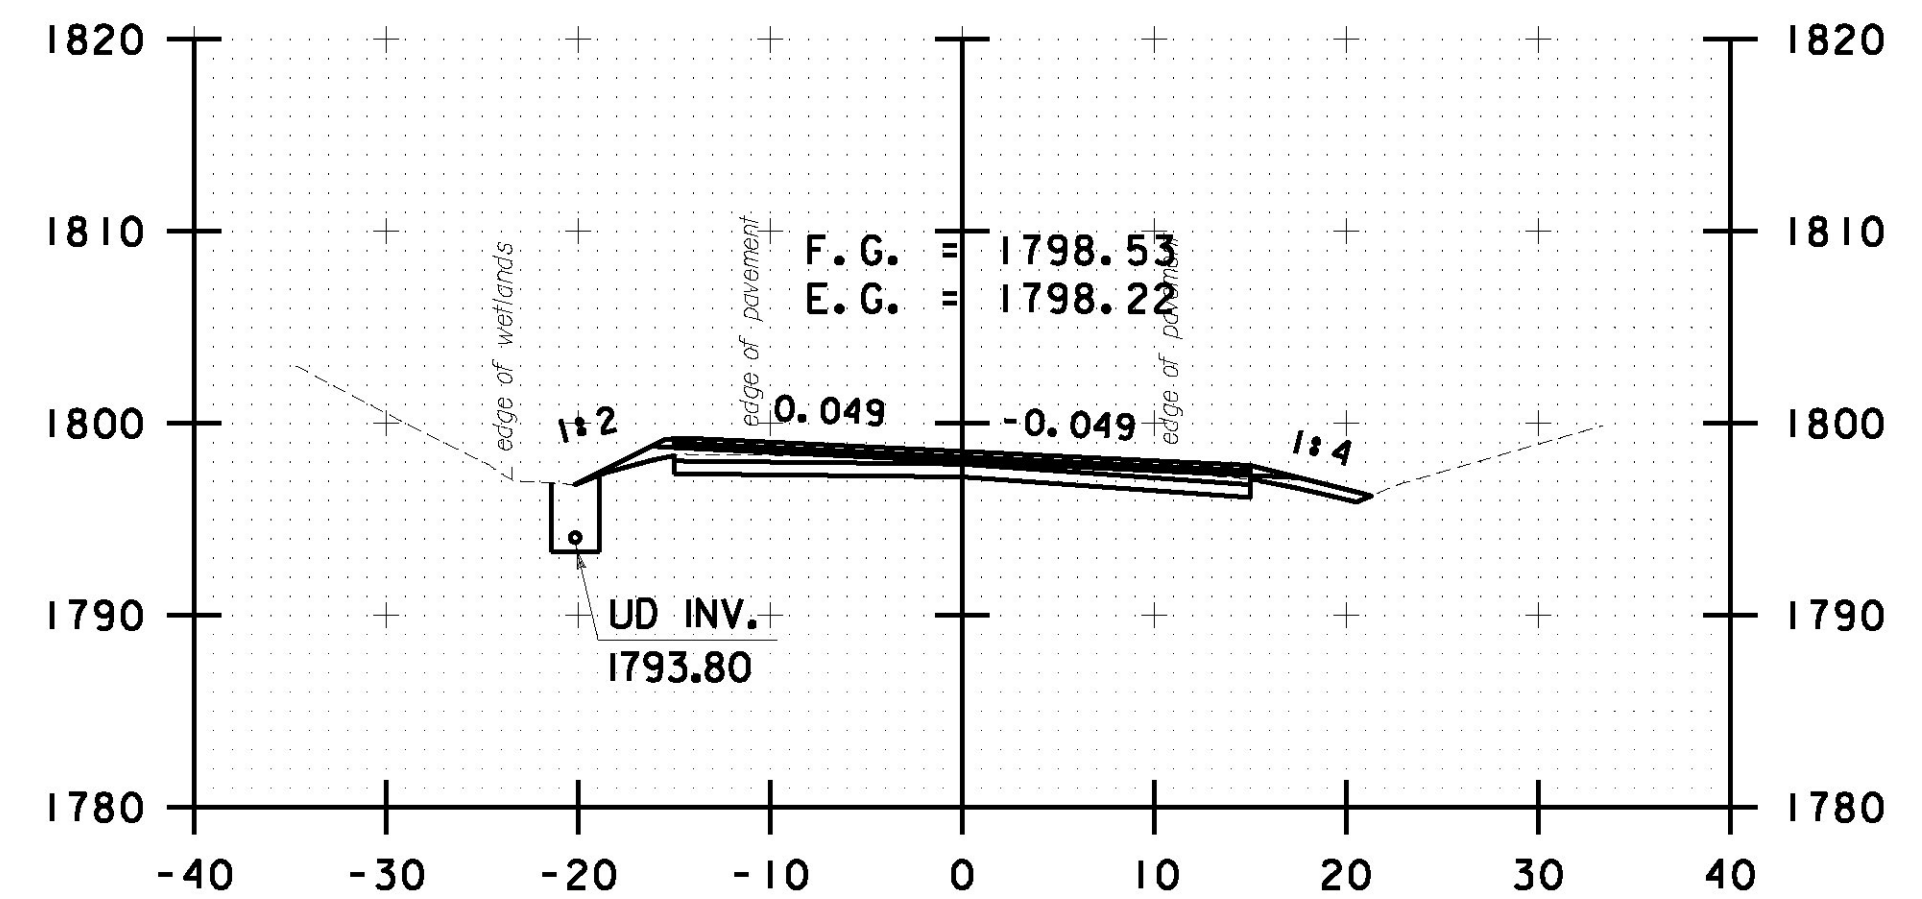

R 57+50.00

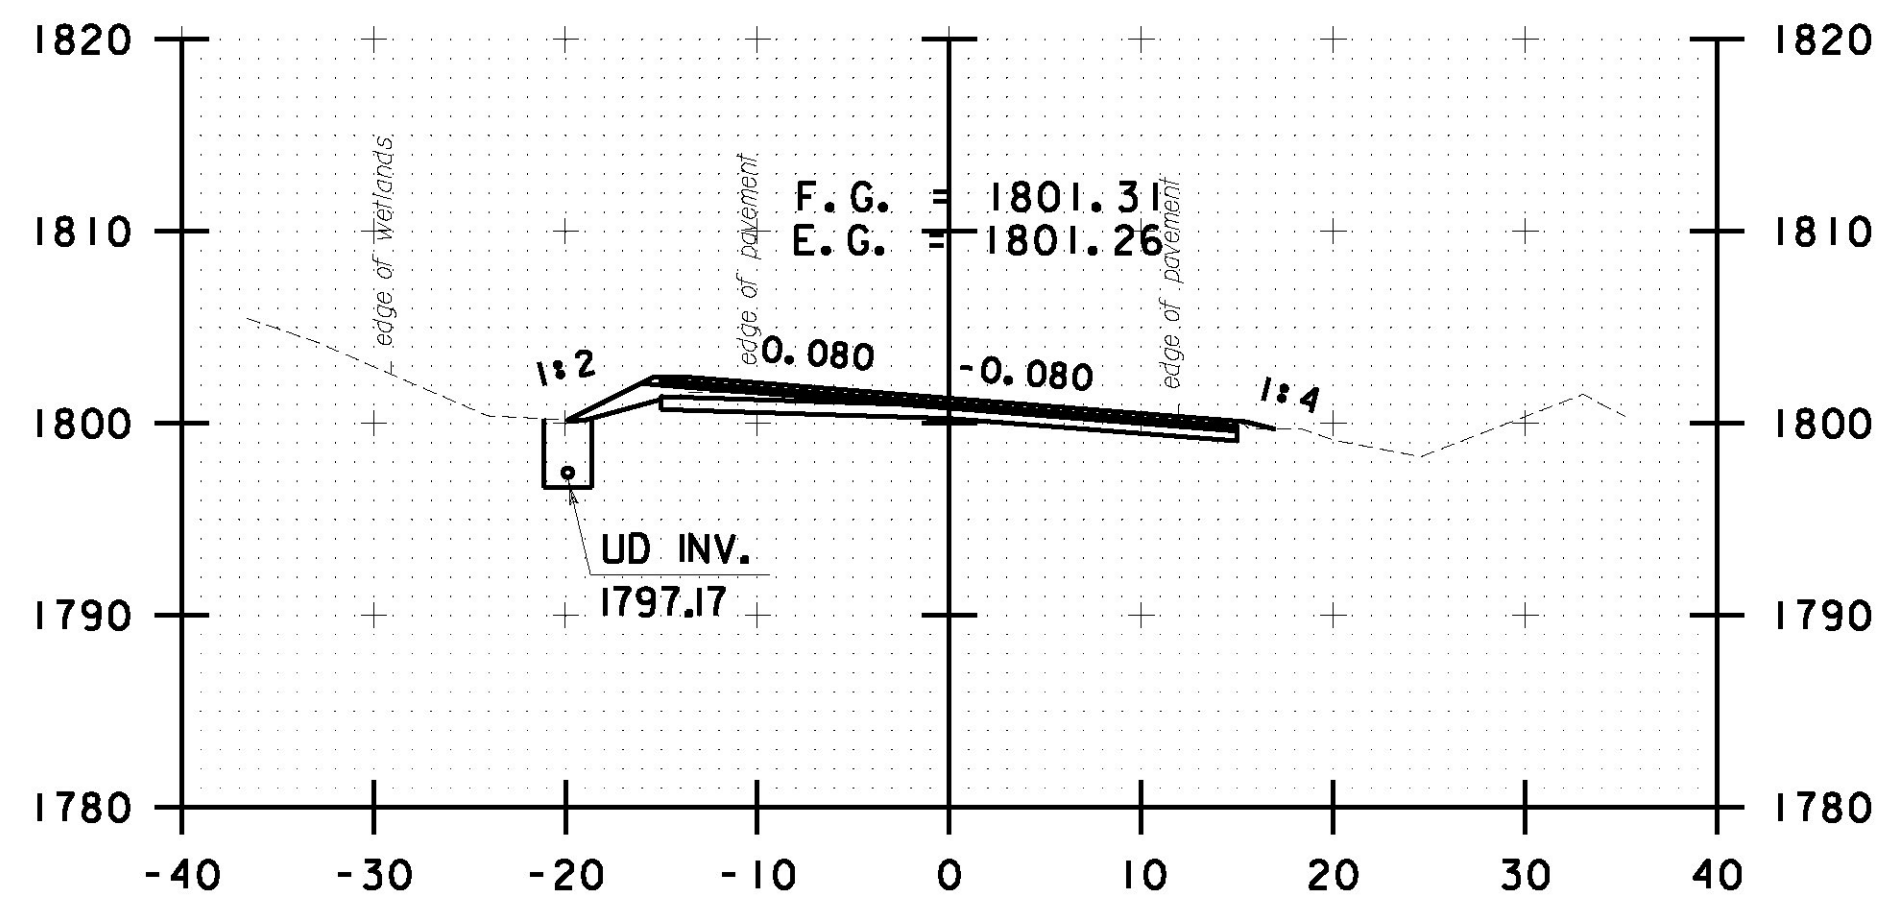

R 56+00.00

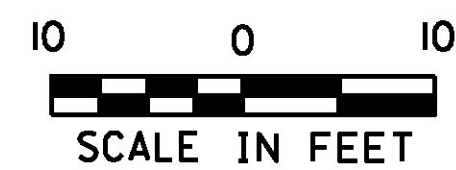

SCALE IN FEET



PROJECT NAME: ROCHESTER	
PROJECT NUMBER: ER STP 0162(21)	
FILE NAME: z13cl76xc.dgn	PLOT DATE: 1/12/2017
PROJECT LEADER: D. GOZALKOWSKI	DRAWN BY: J. HEALD
DESIGNED BY: J. OLSEN	CHECKED BY: J. SHIELDS
ROCHESTER CROSS SECTION SHEET #20	SHEET 206 OF 360