




R 150+00.00

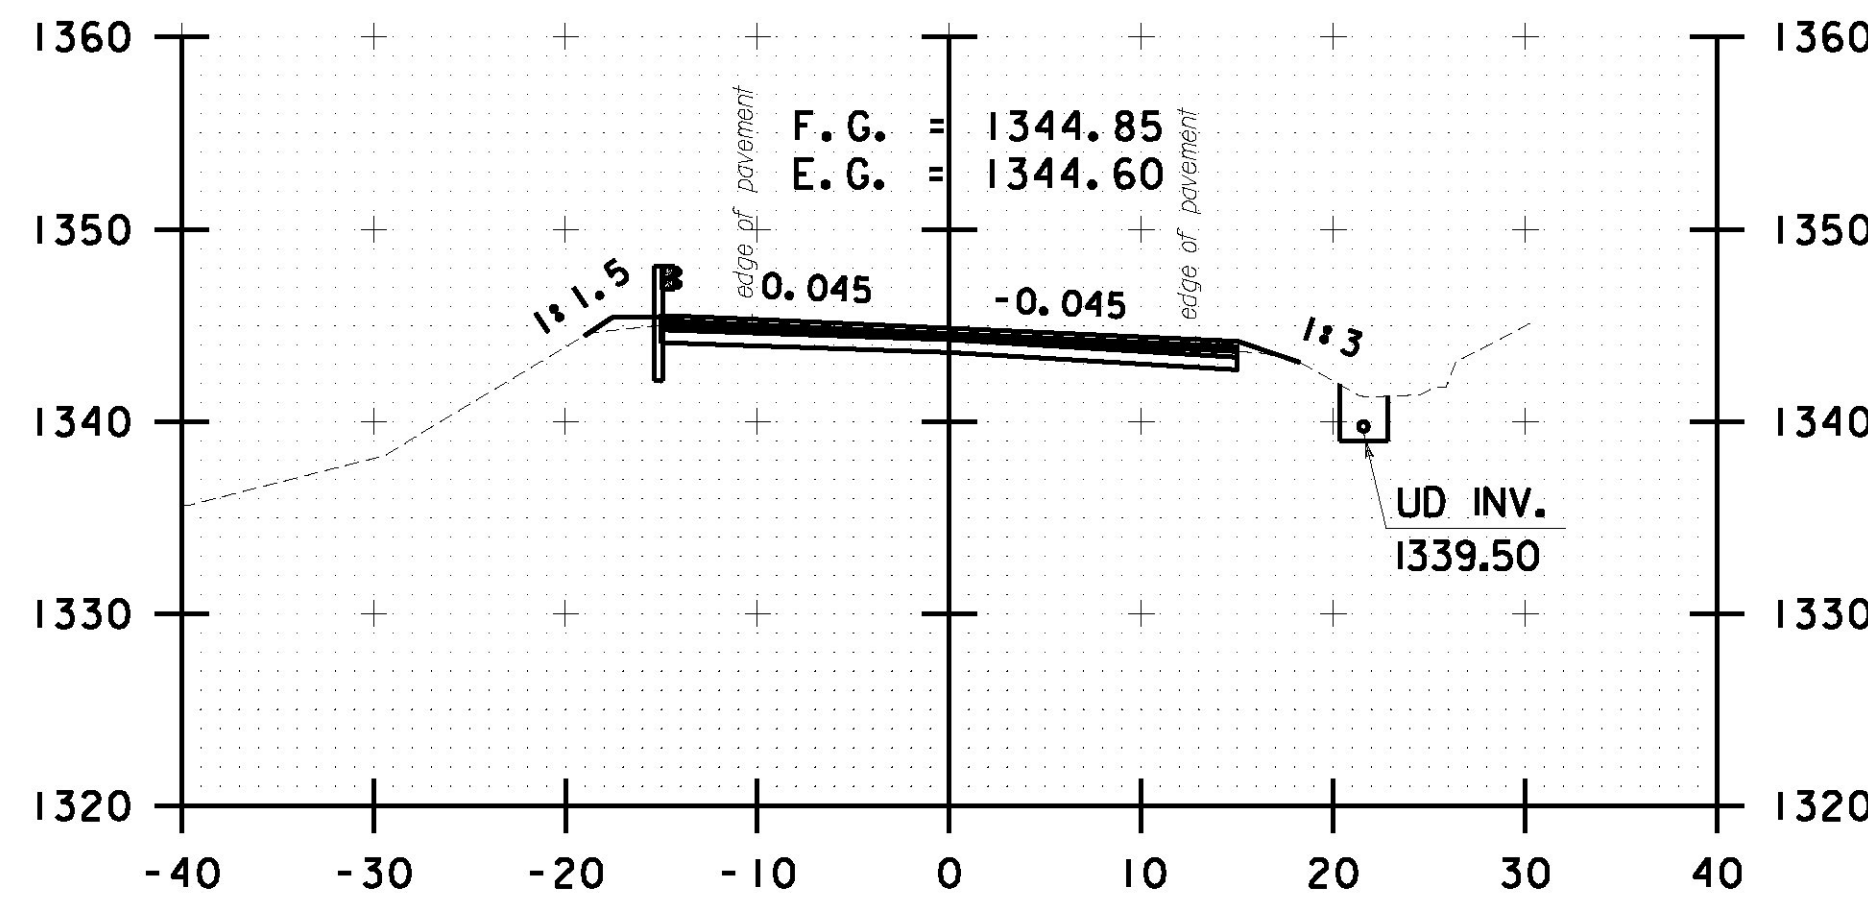


R 151+00.00

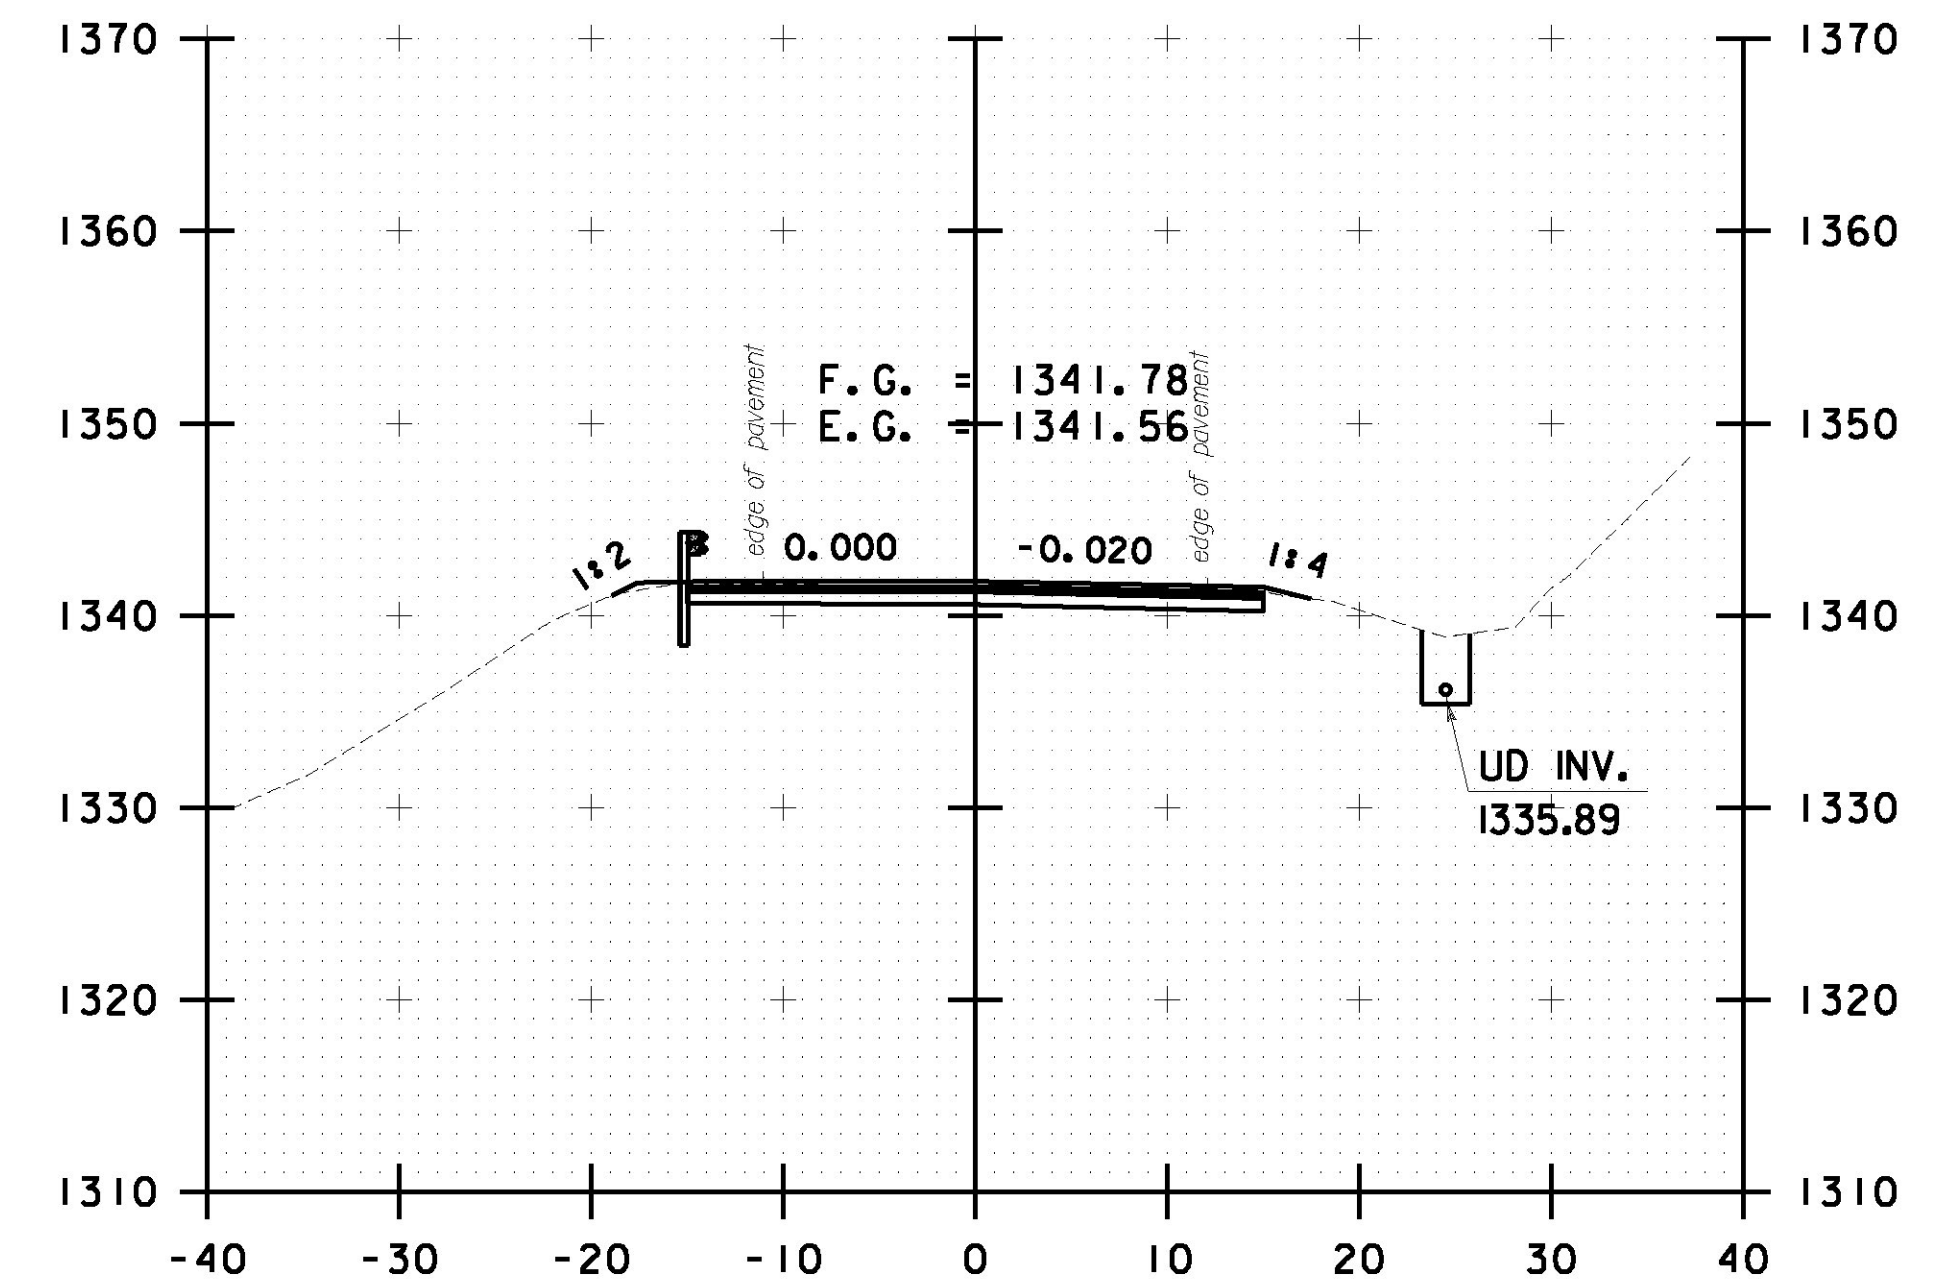


R 152+00.00

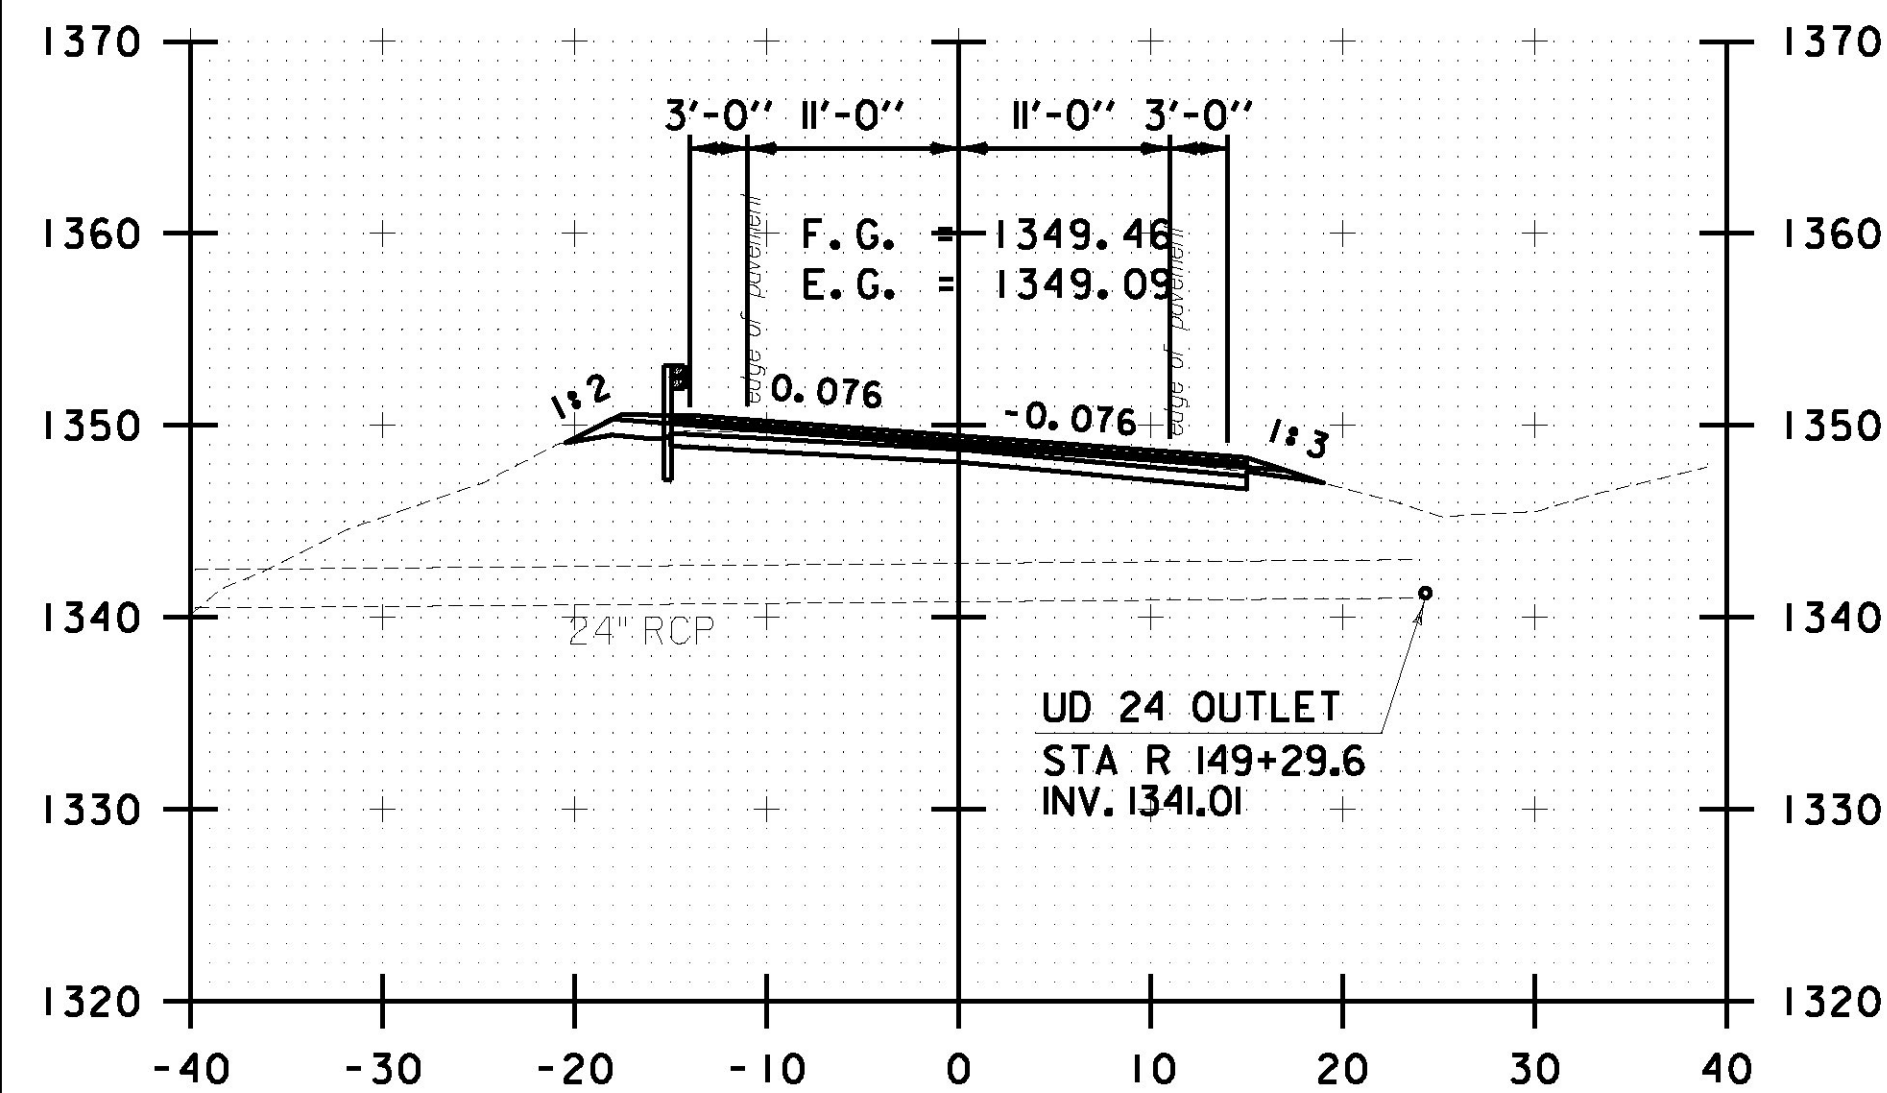


R 149+50.00

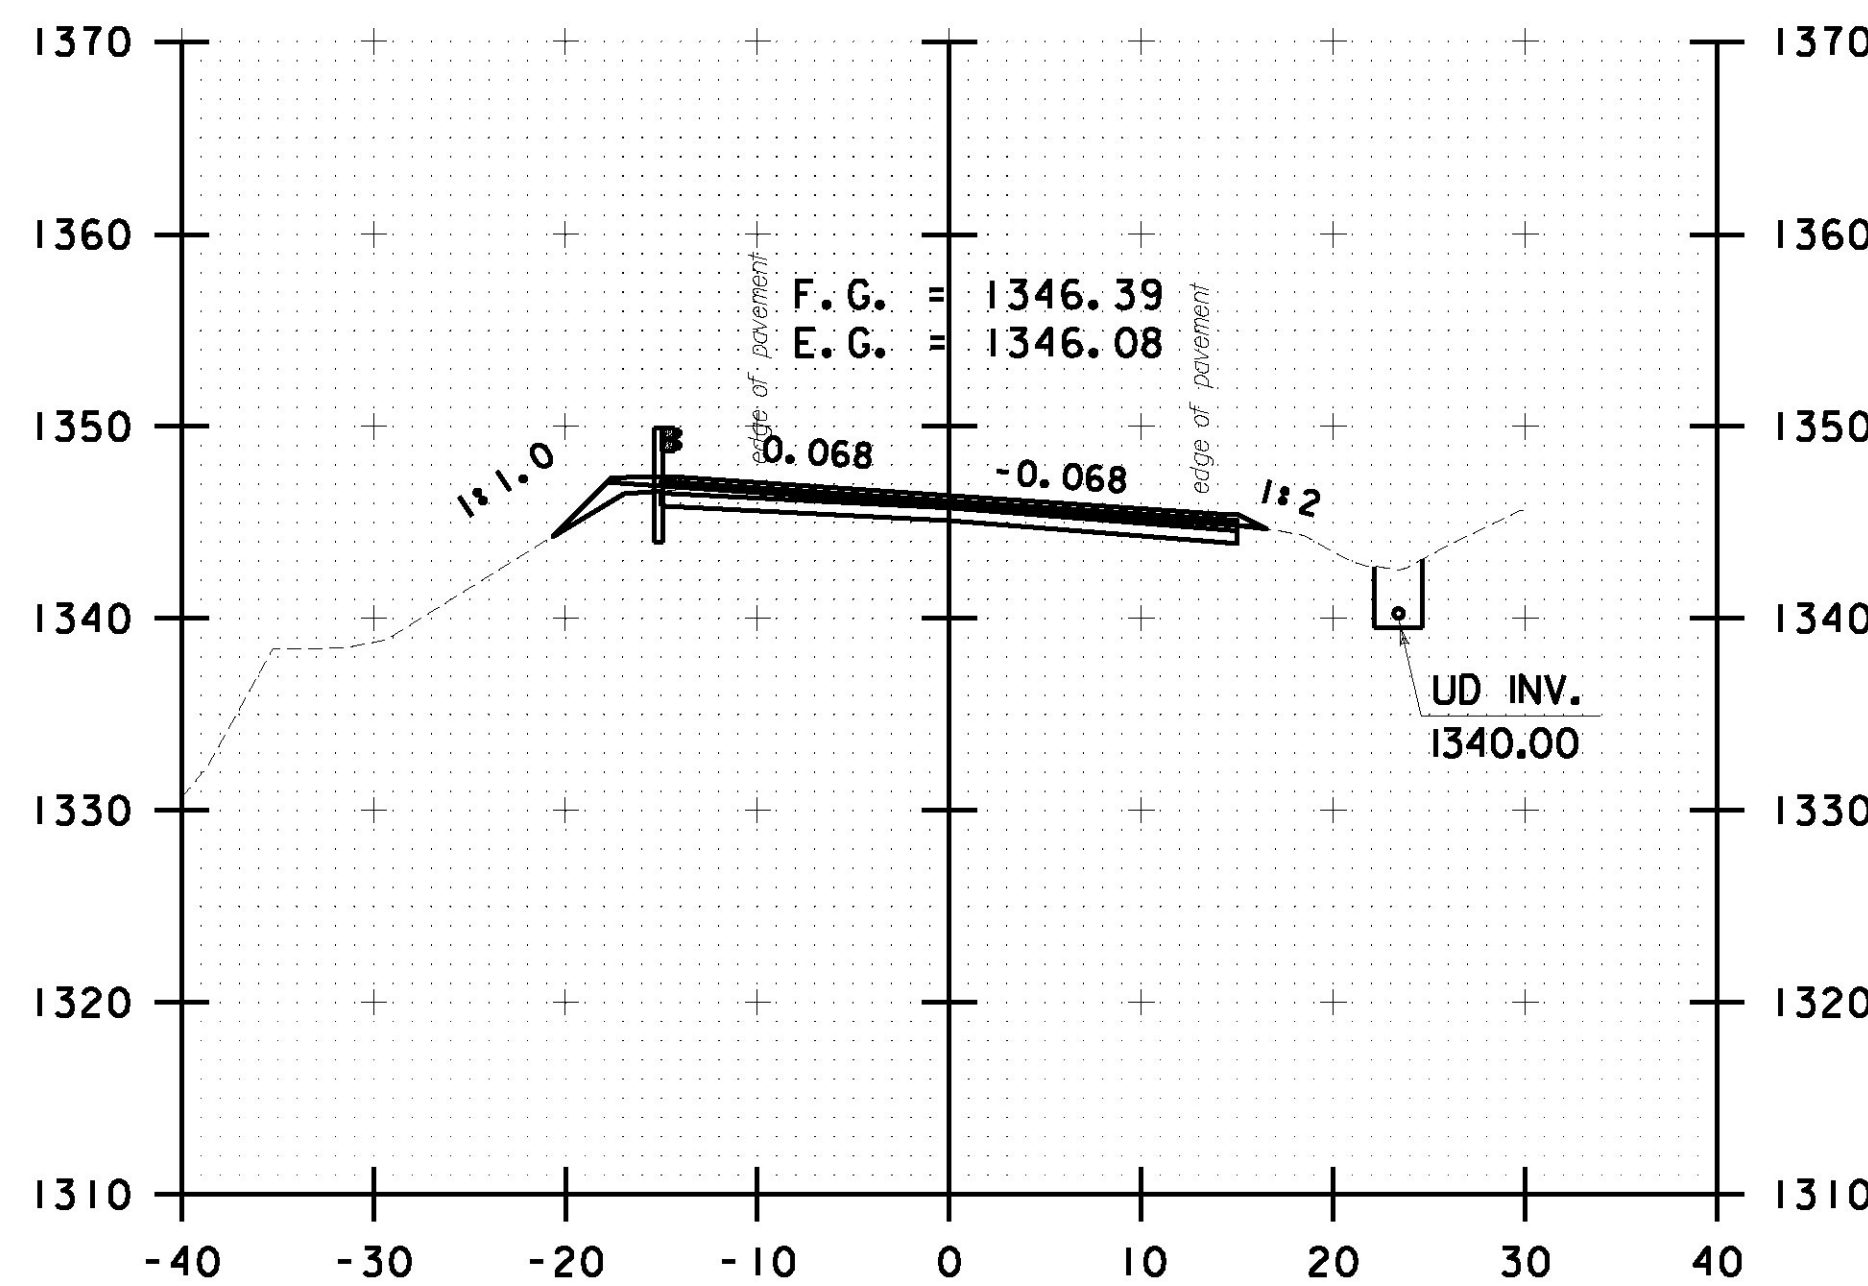

R 150+50.00

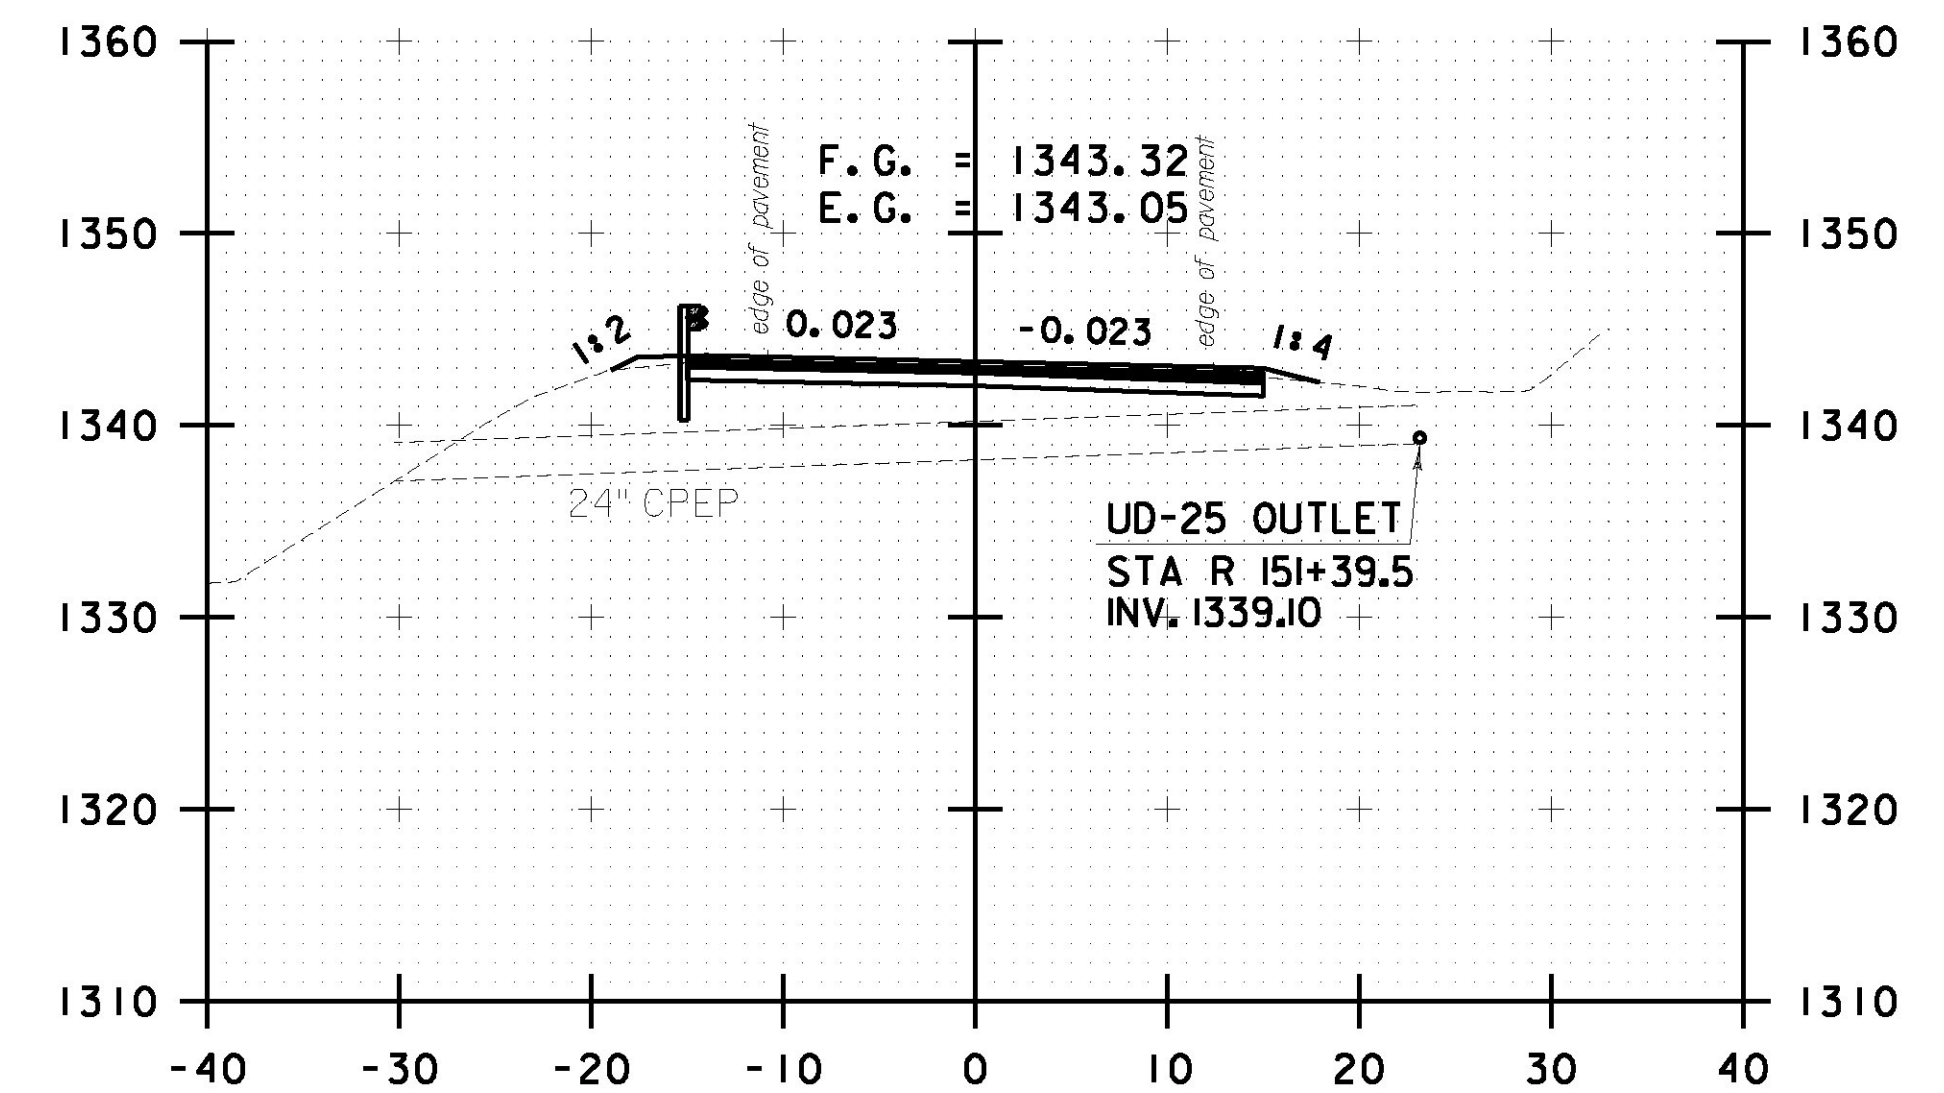

R 151+50.00

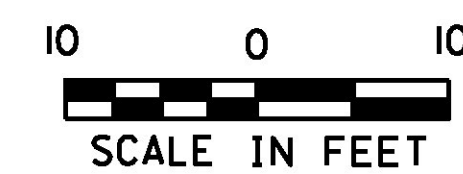

| | |
|-----------------------------------|------------------------|
| PROJECT NAME: ROCHESTER | |
| PROJECT NUMBER: ER STP 0162(21) | |
| FILE NAME: z13cl76xc.dgn | PLOT DATE: 1/12/2017 |
| PROJECT LEADER: D. GOZALKOWSKI | DRAWN BY: J. HEALD |
| DESIGNED BY: J. OLSEN | CHECKED BY: J. SHIELDS |
| ROCHESTER CROSS SECTION SHEET #53 | SHEET 239 OF 360 |