




R 159+00.00

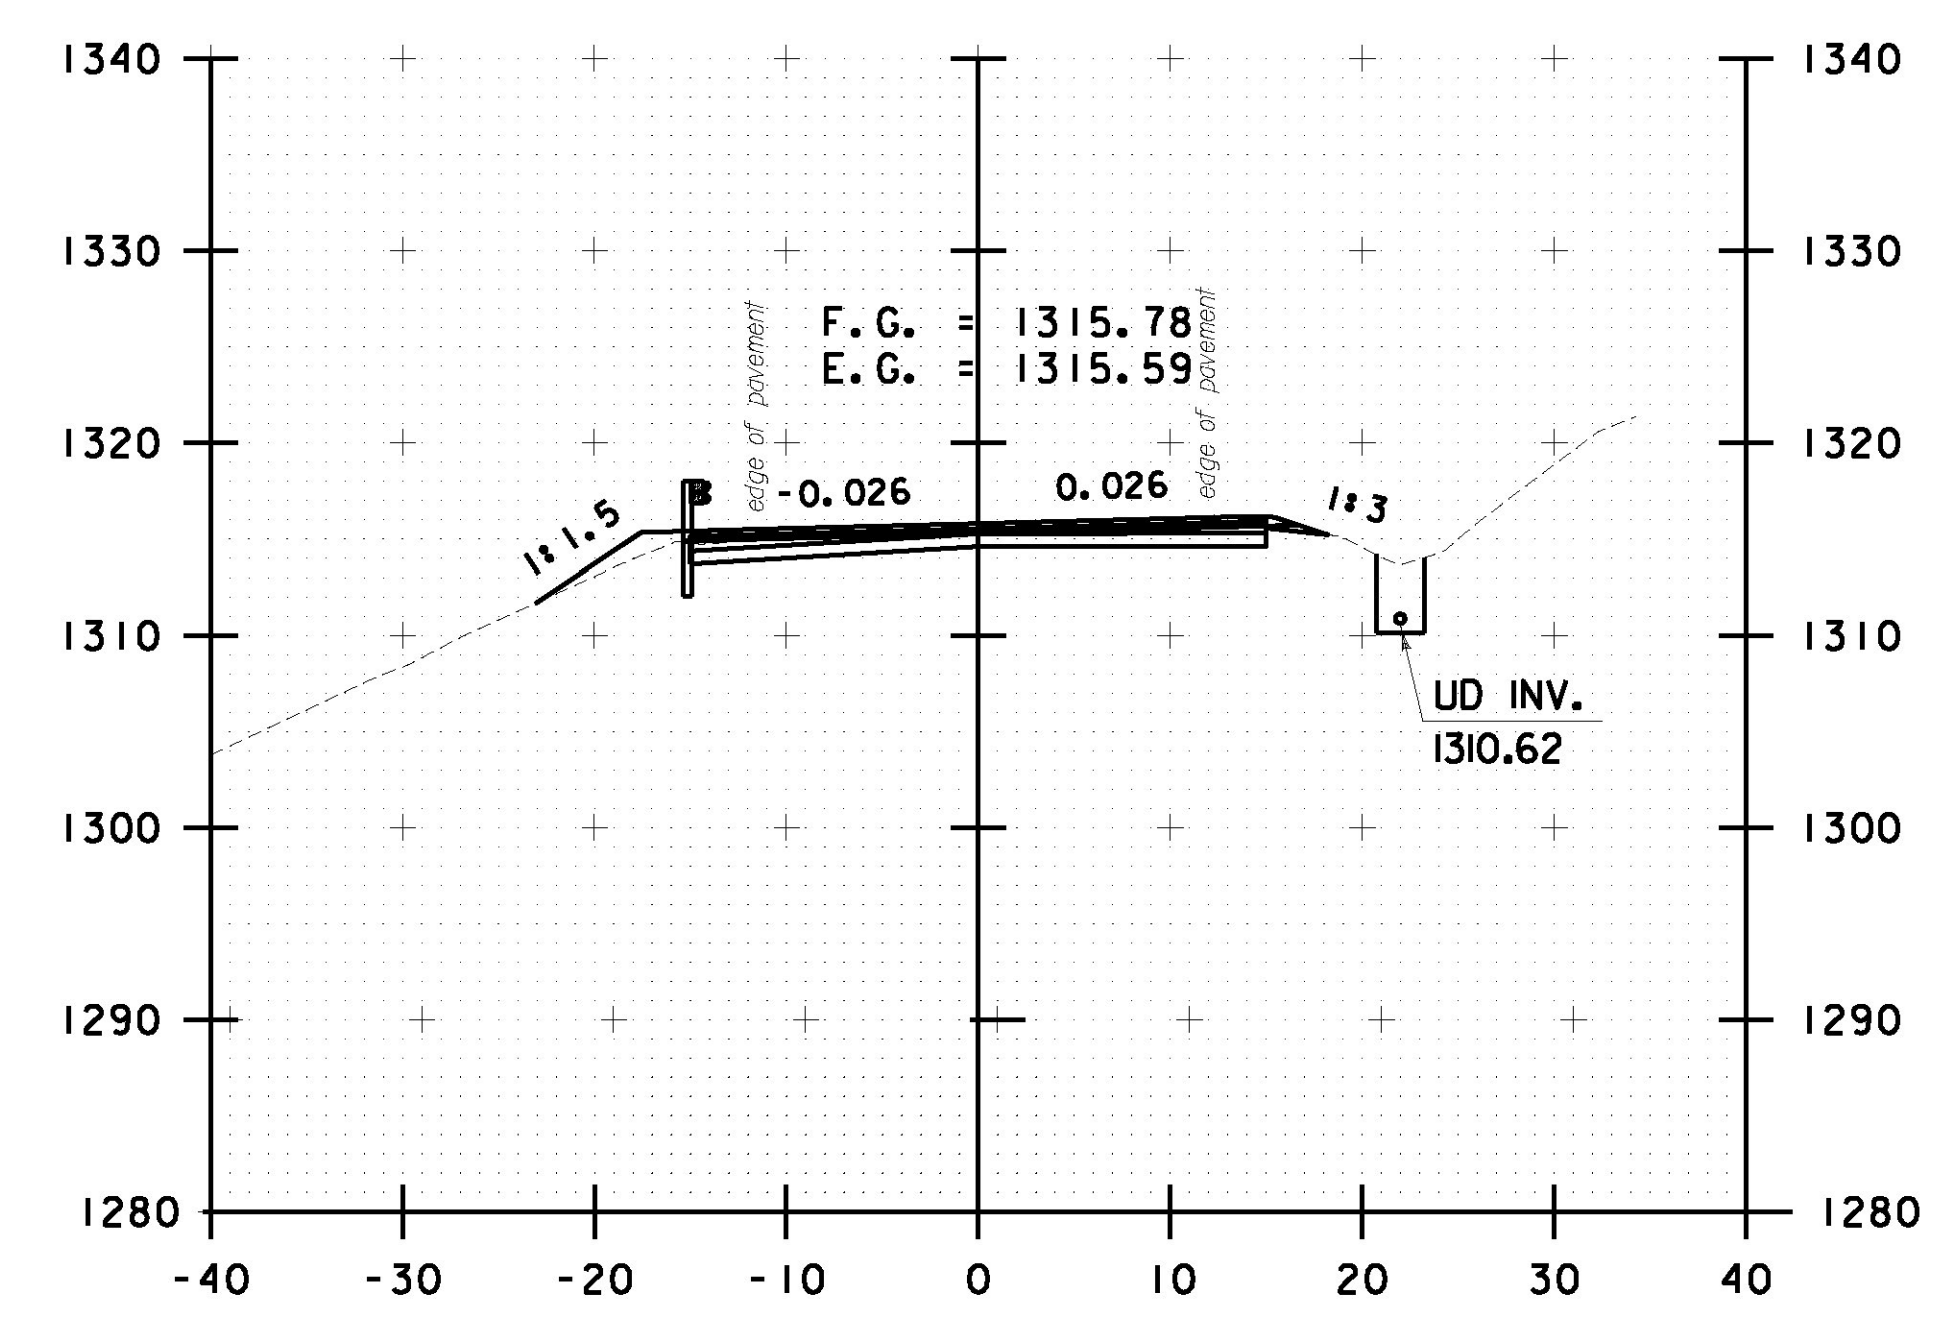


R 160+00.00

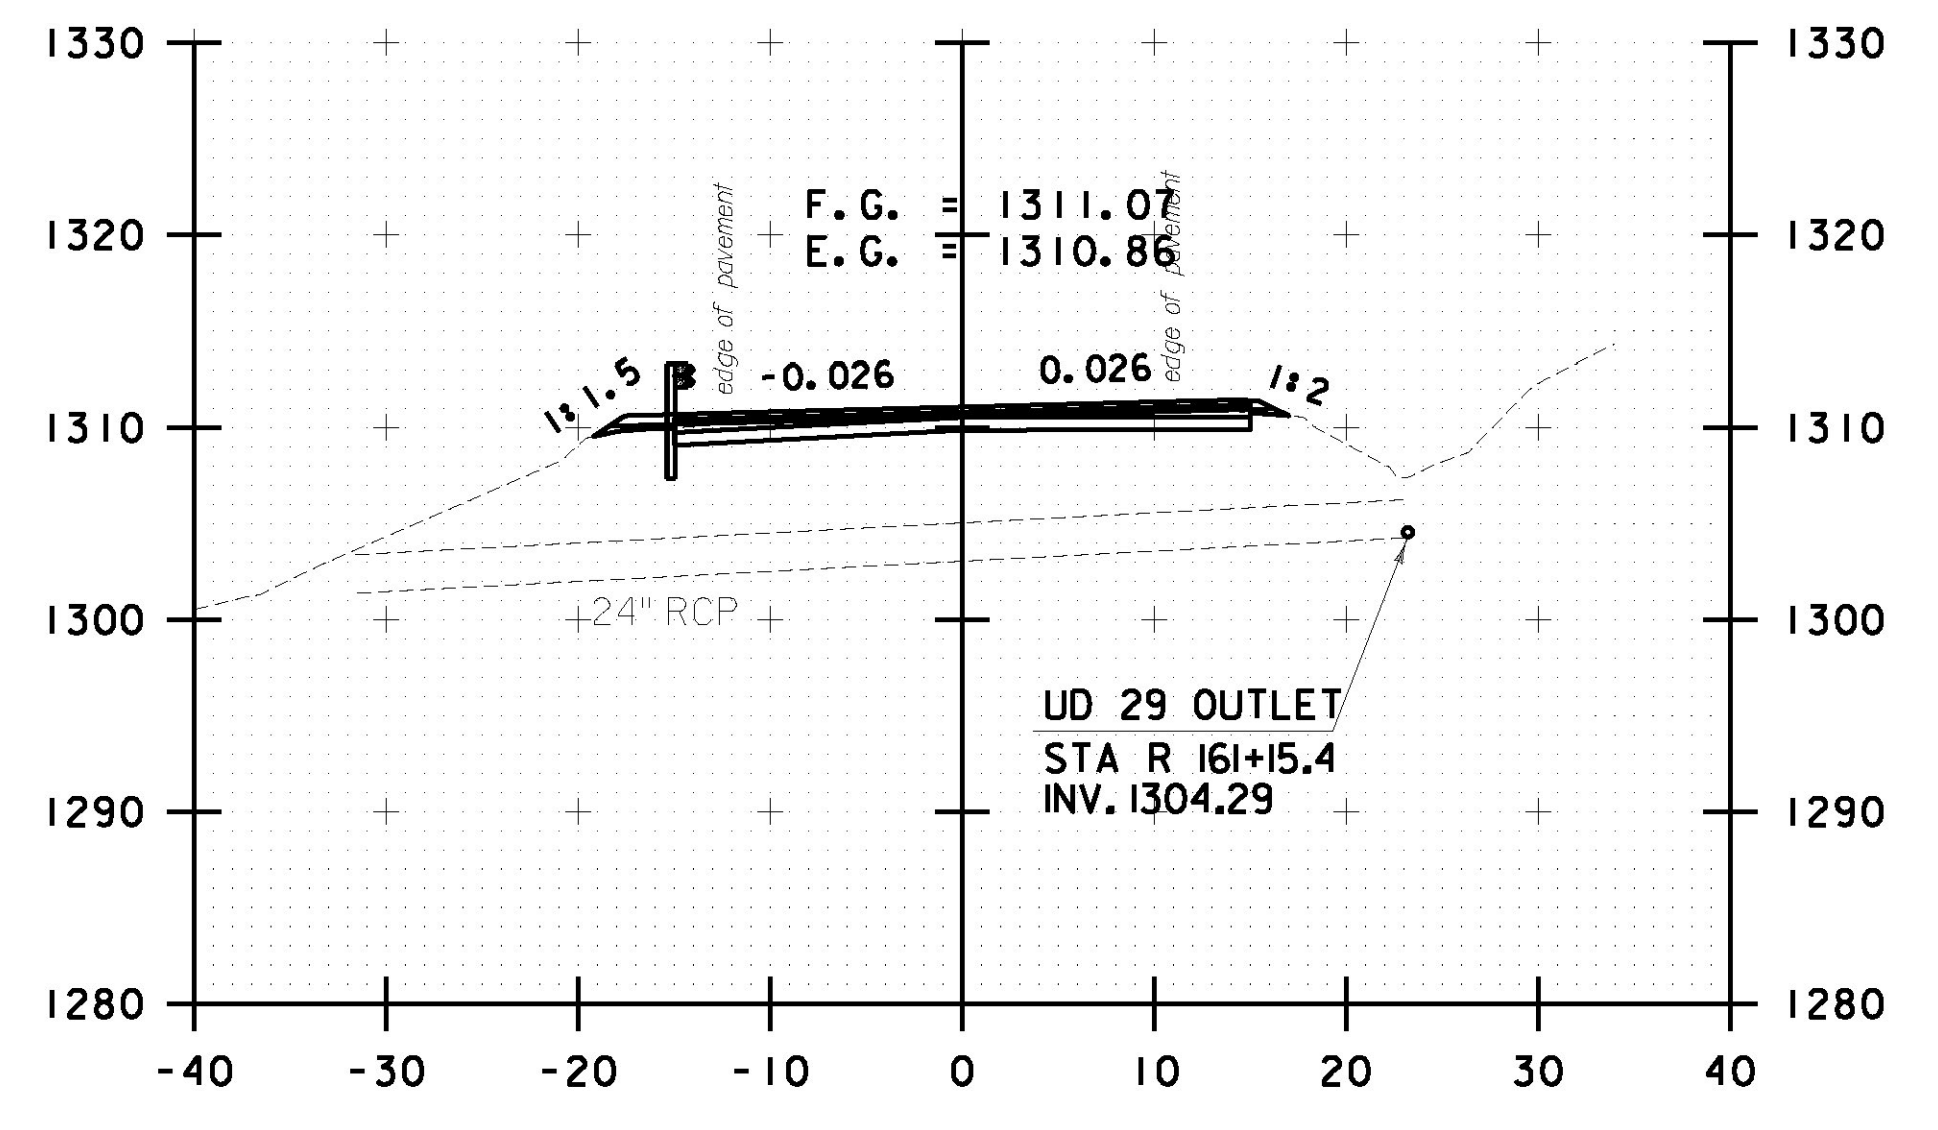


R 161+00.00

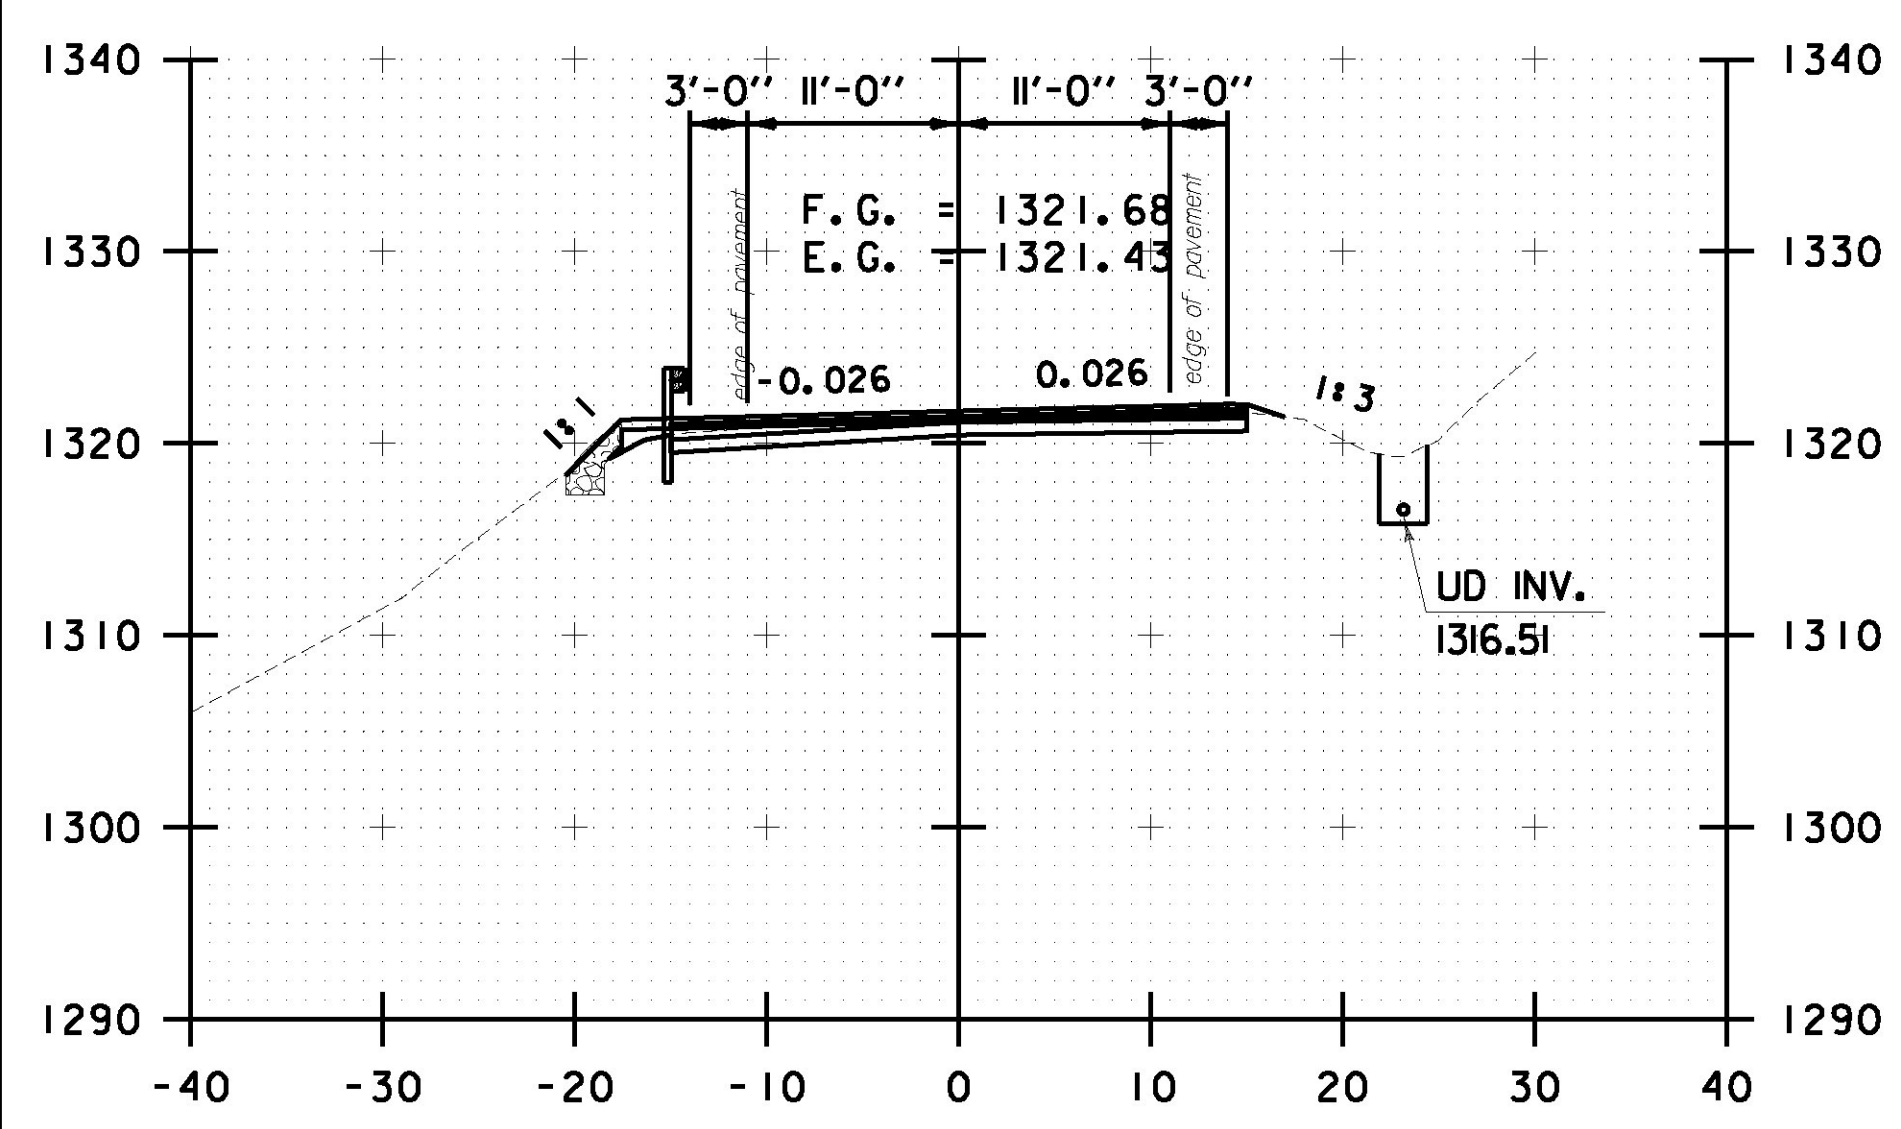


R 158+50.00

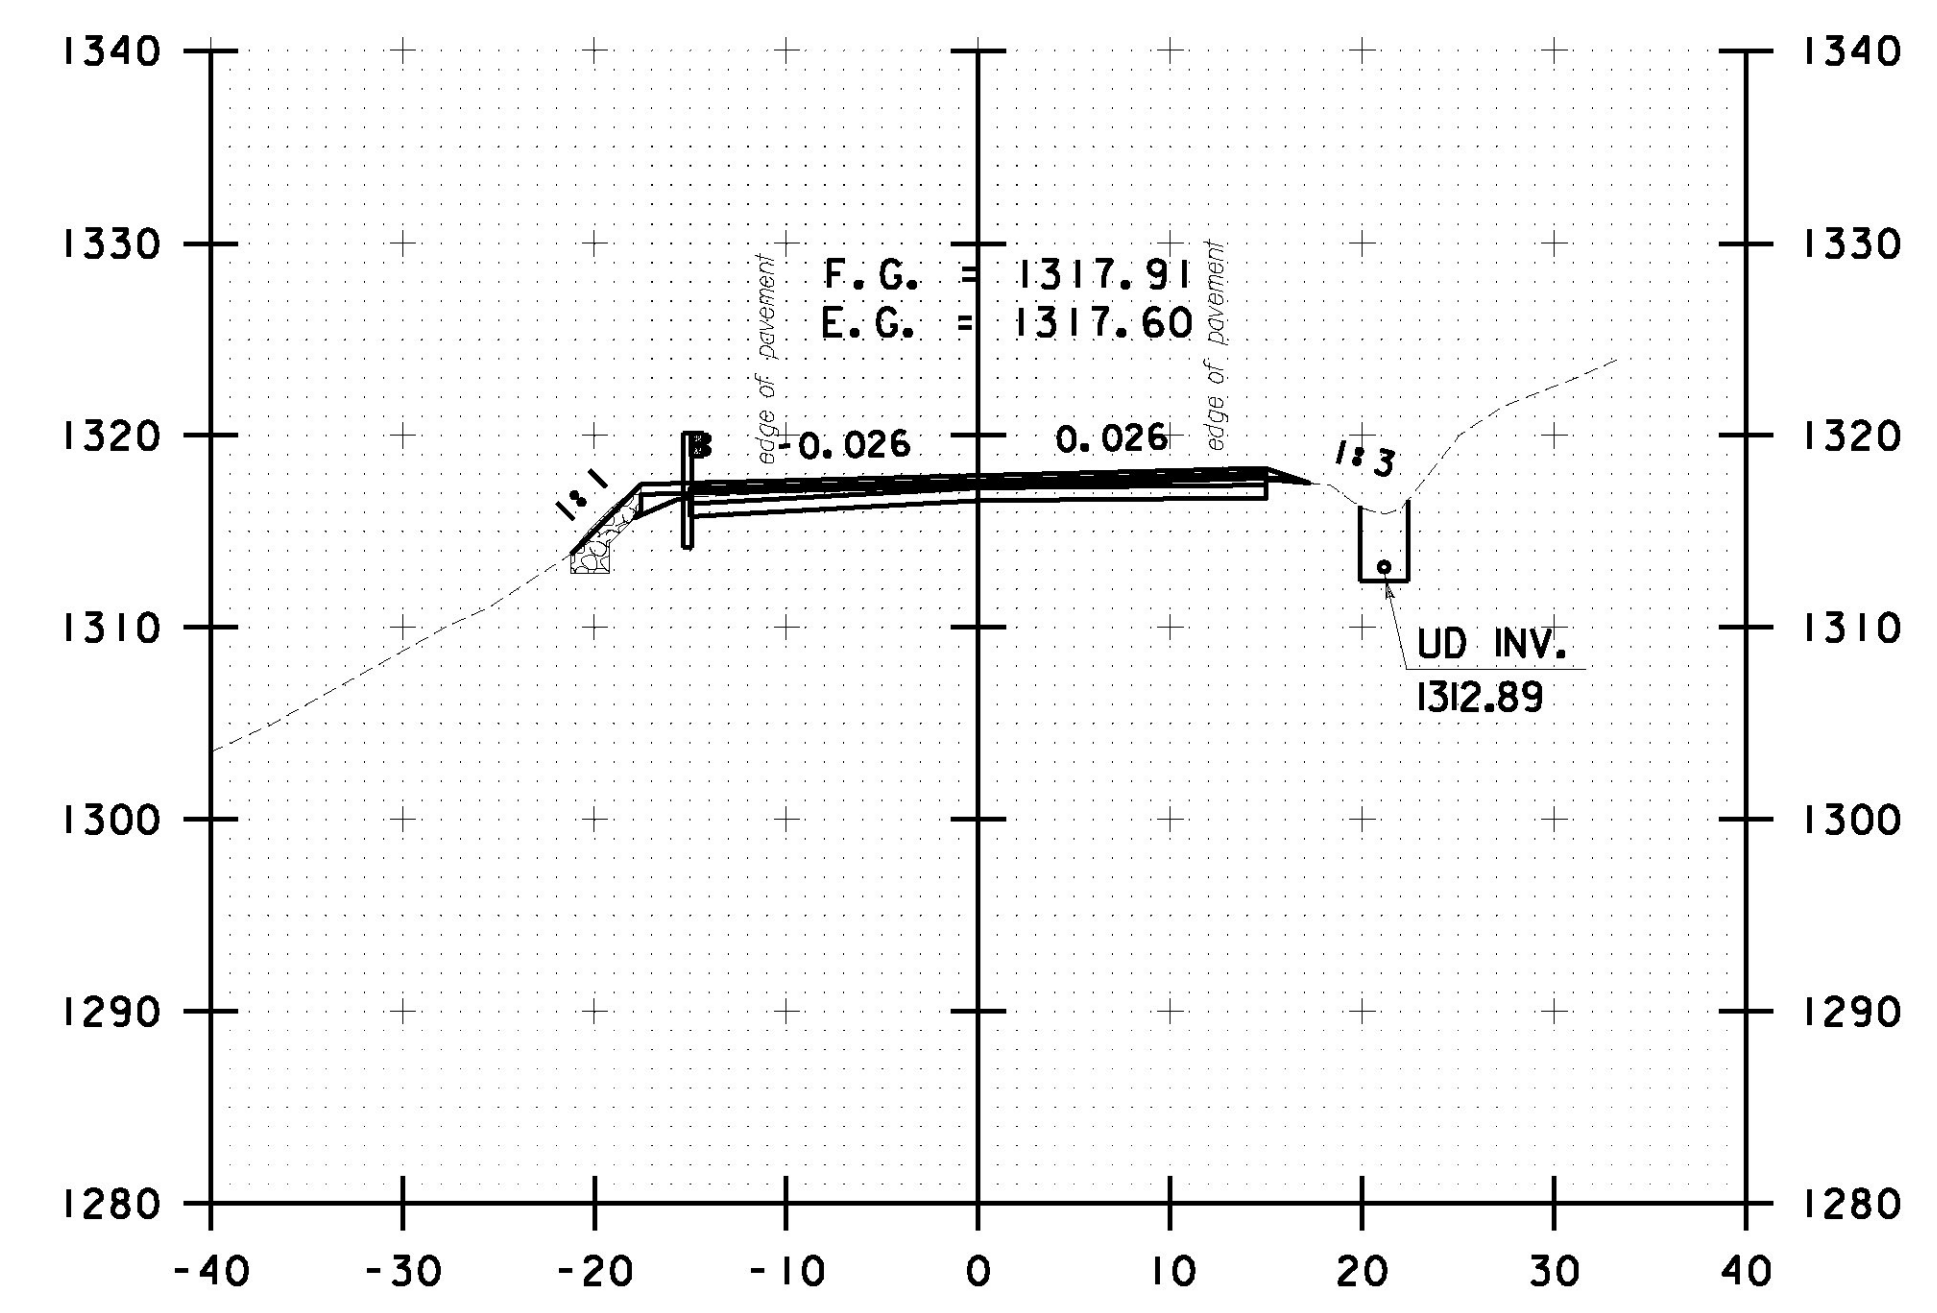

R 159+50.00

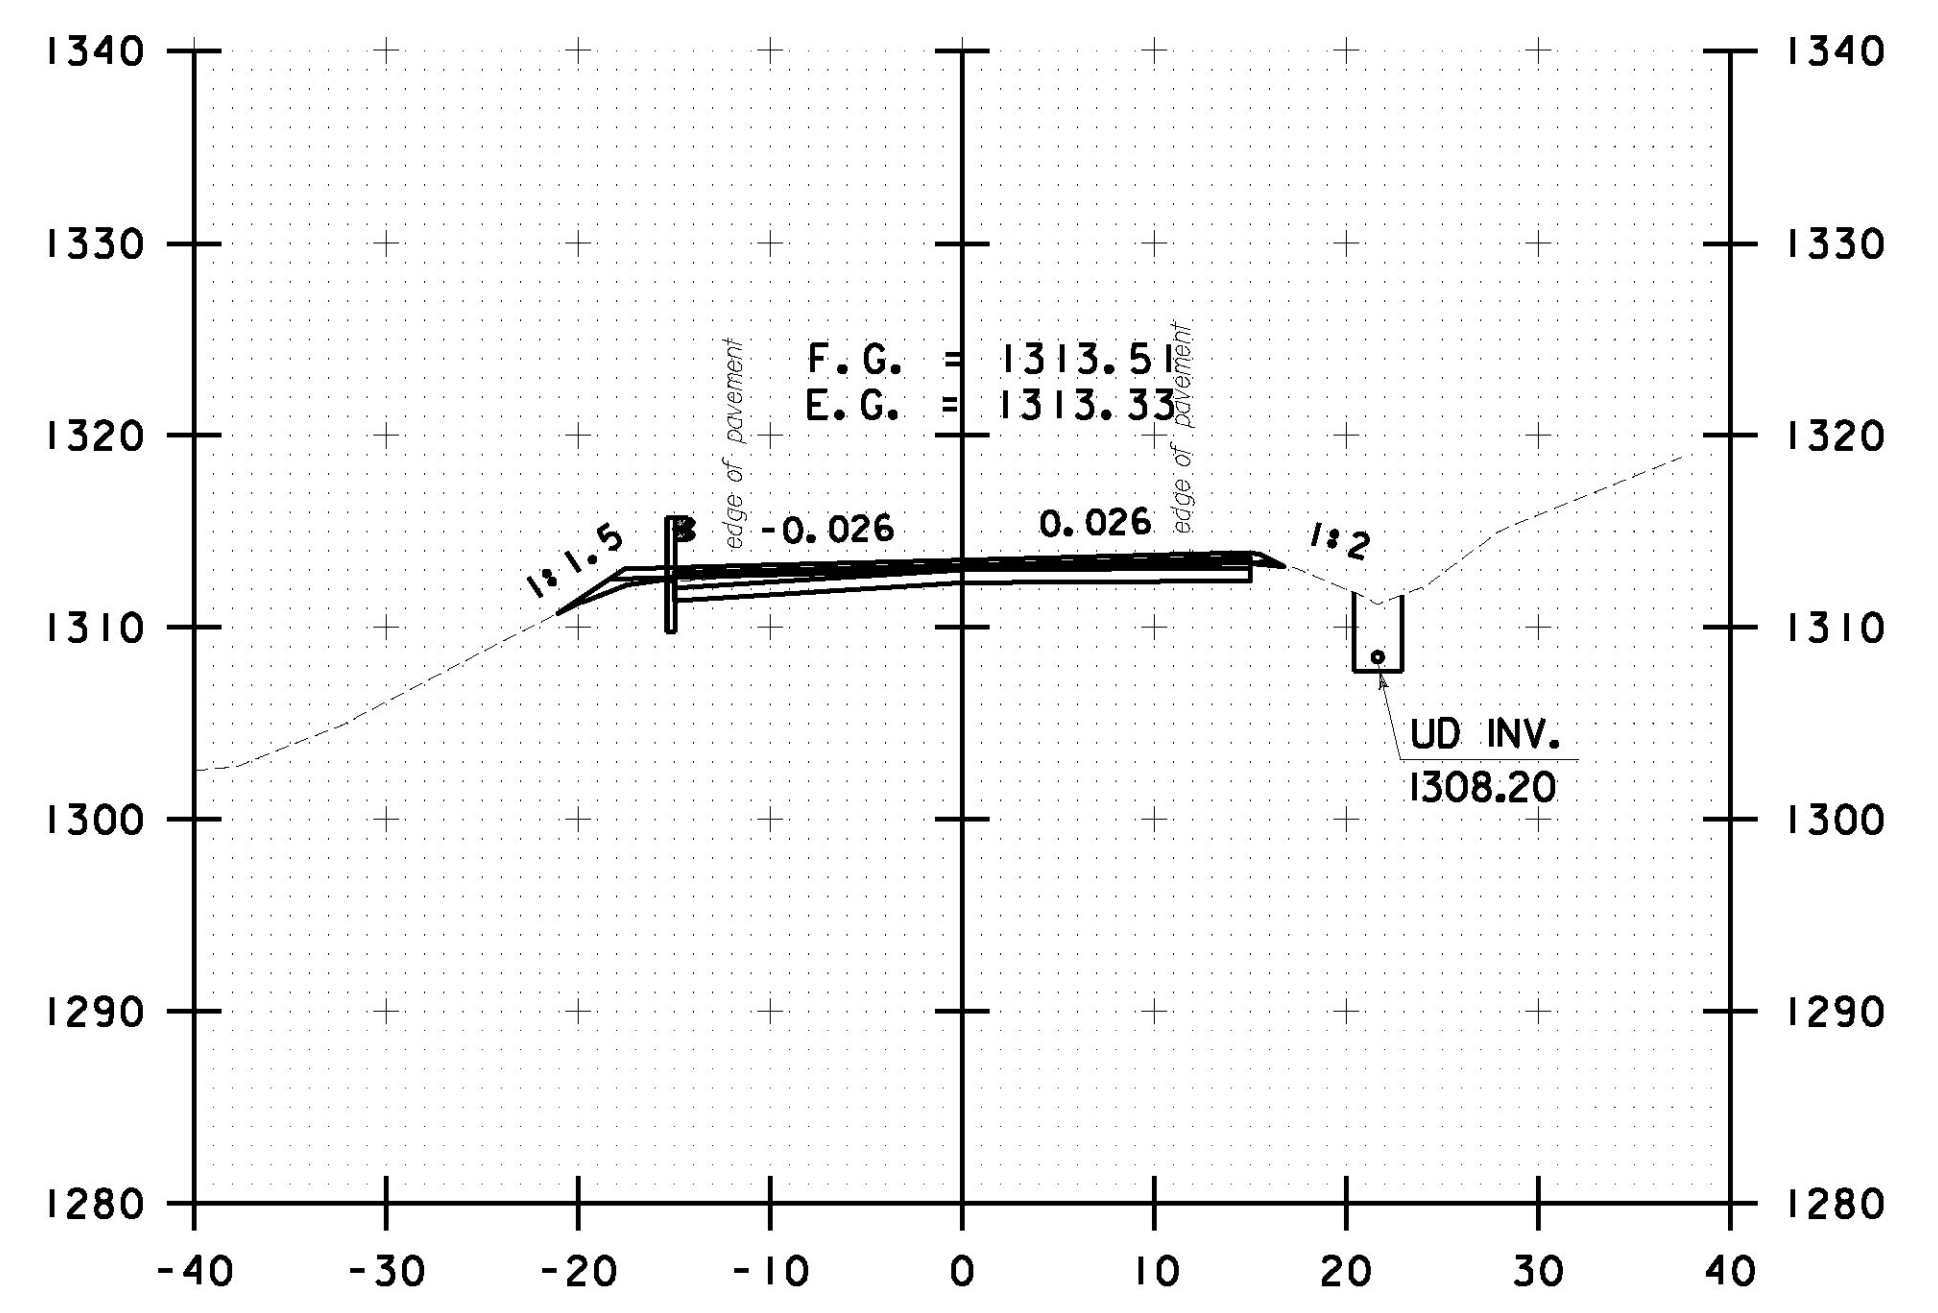

R 160+50.00

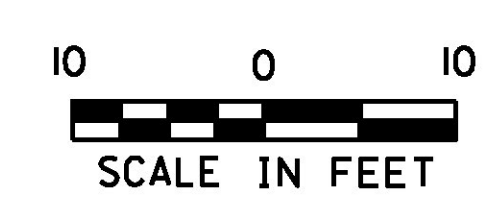

|                                   |                        |
|-----------------------------------|------------------------|
| PROJECT NAME: ROCHESTER           |                        |
| PROJECT NUMBER: ER STP 0162(21)   |                        |
| FILE NAME: z13cl76xc.dgn          | PLOT DATE: 1/12/2017   |
| PROJECT LEADER: D. GOZALKOWSKI    | DRAWN BY: J. HEALD     |
| DESIGNED BY: J. OLSEN             | CHECKED BY: J. SHIELDS |
| ROCHESTER CROSS SECTION SHEET #56 | SHEET 242 OF 360       |