




R 172+50.00

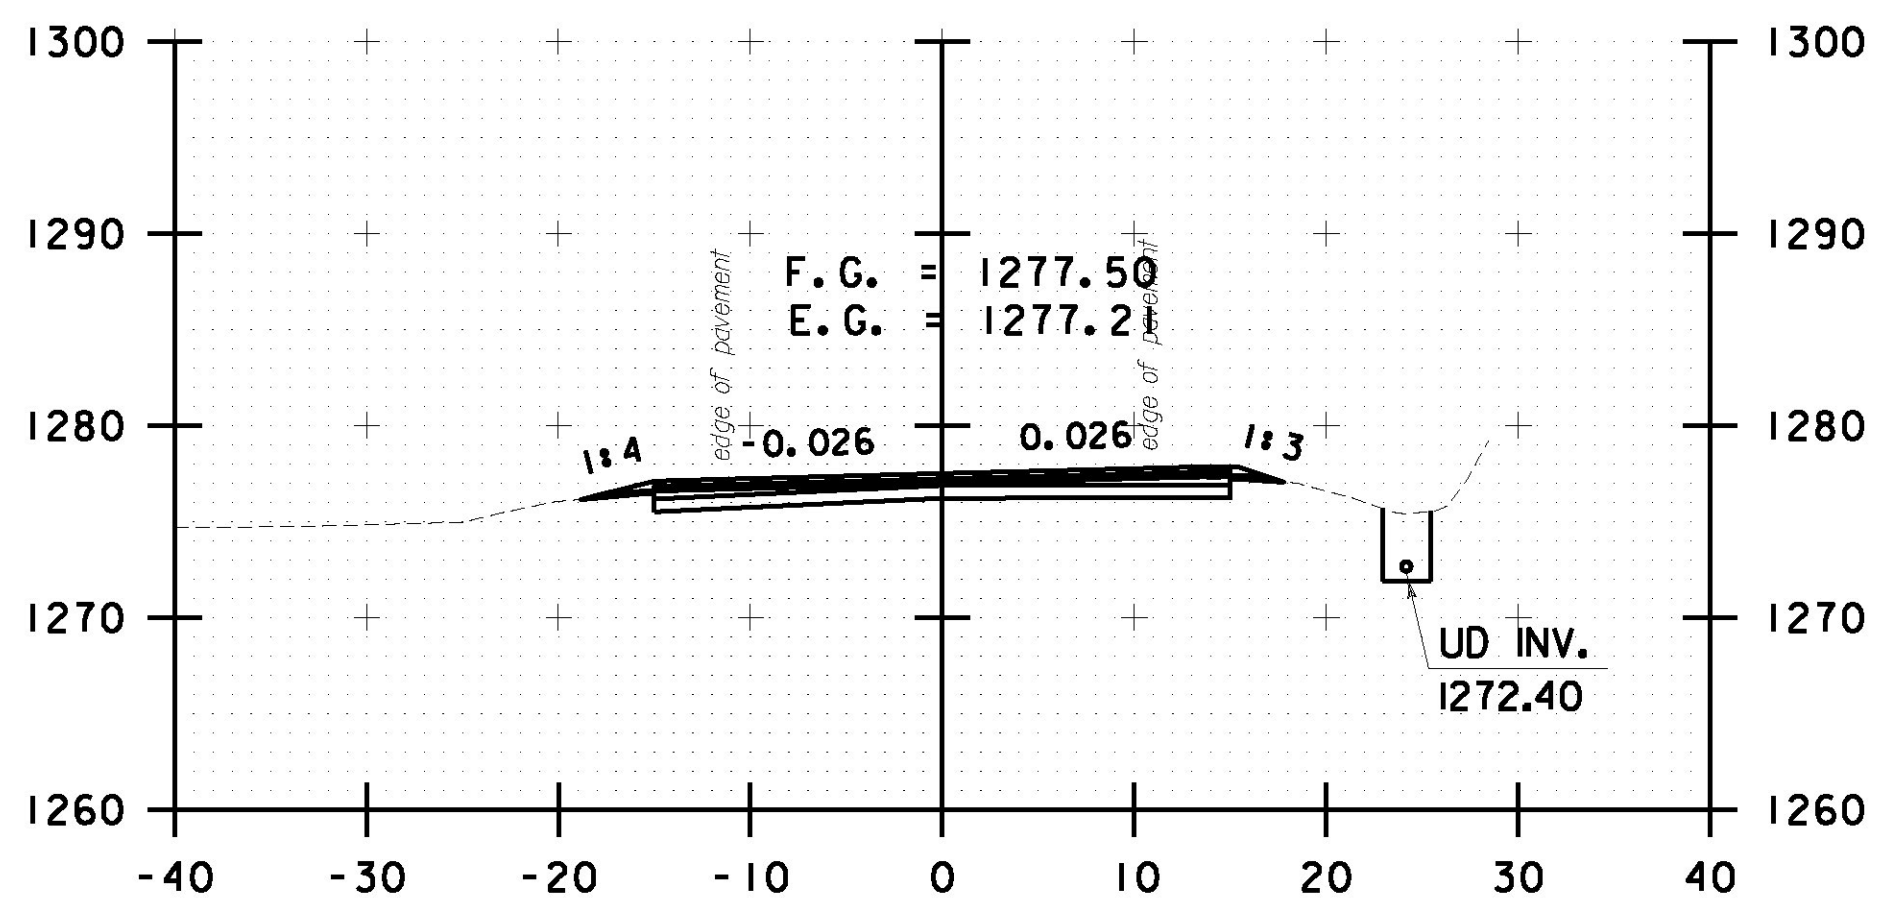


R 174+00.00

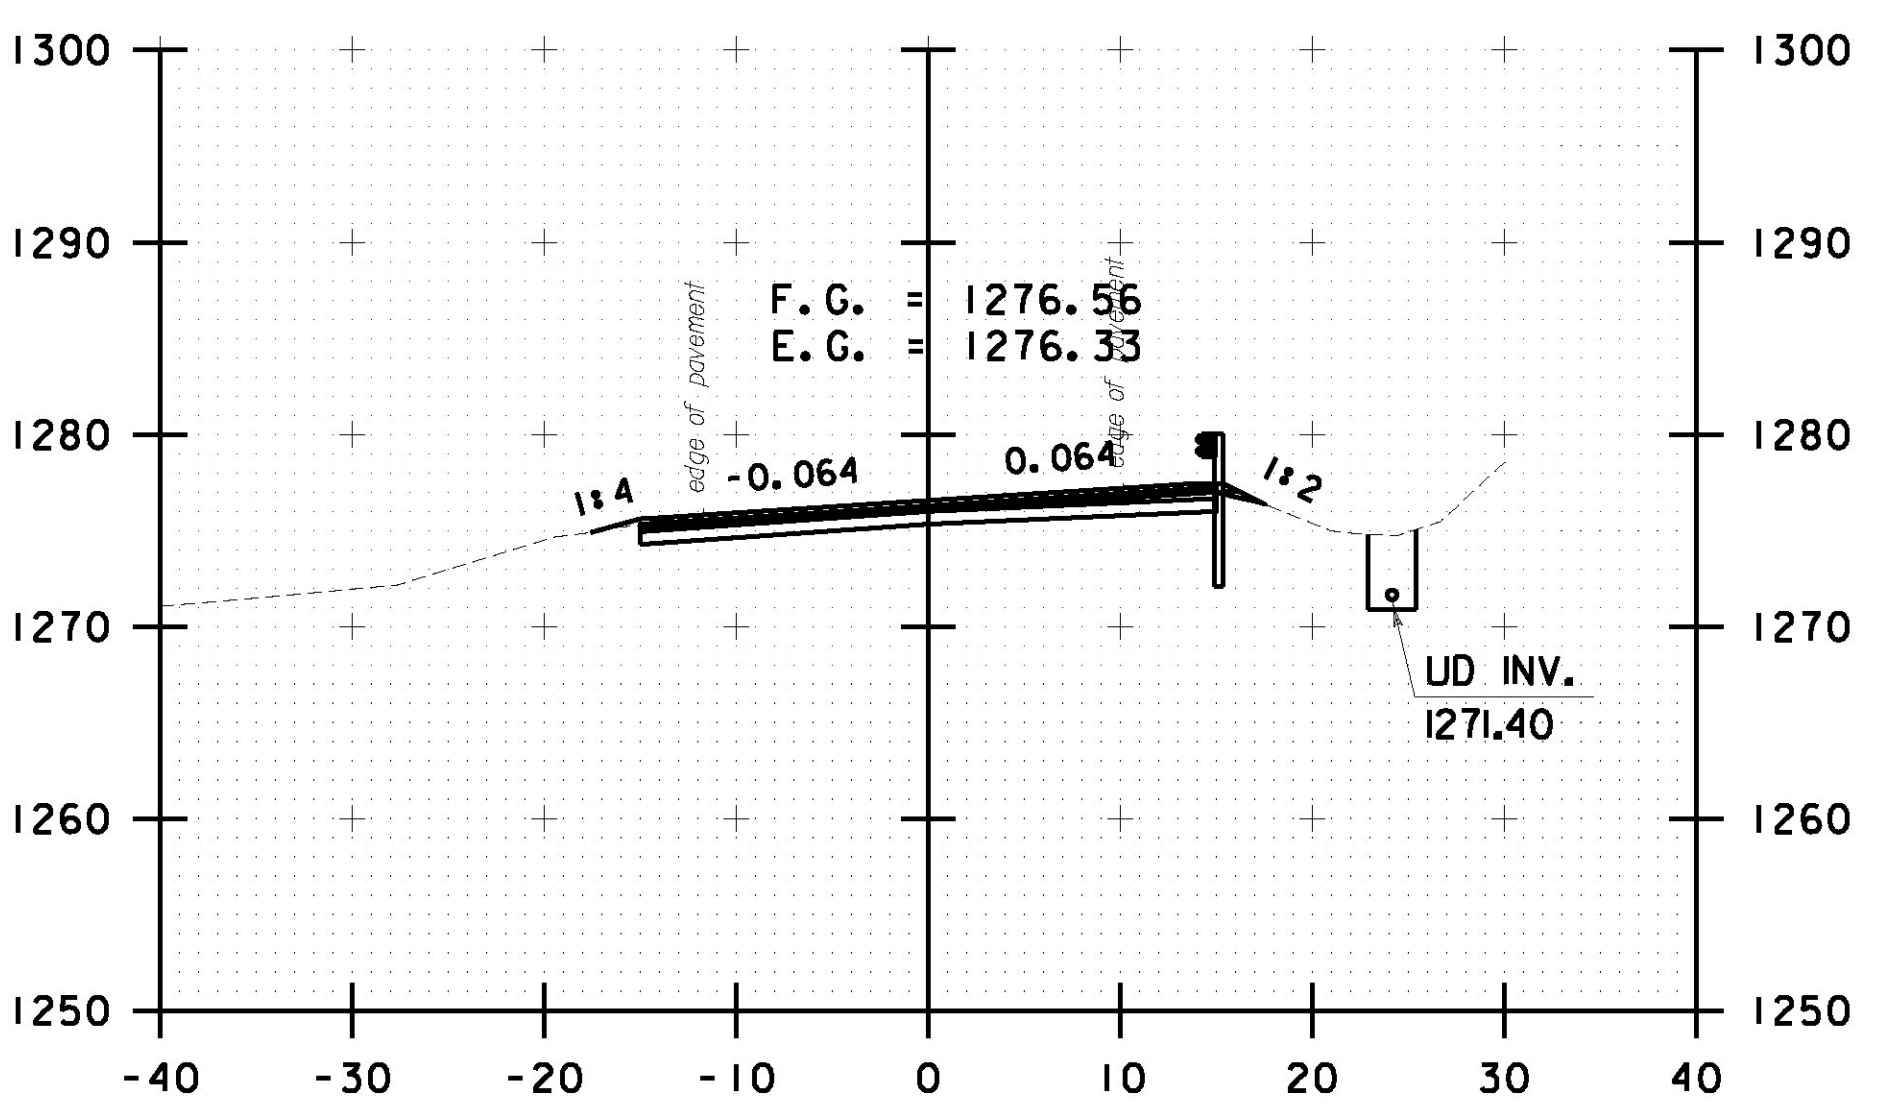


R 175+00.00

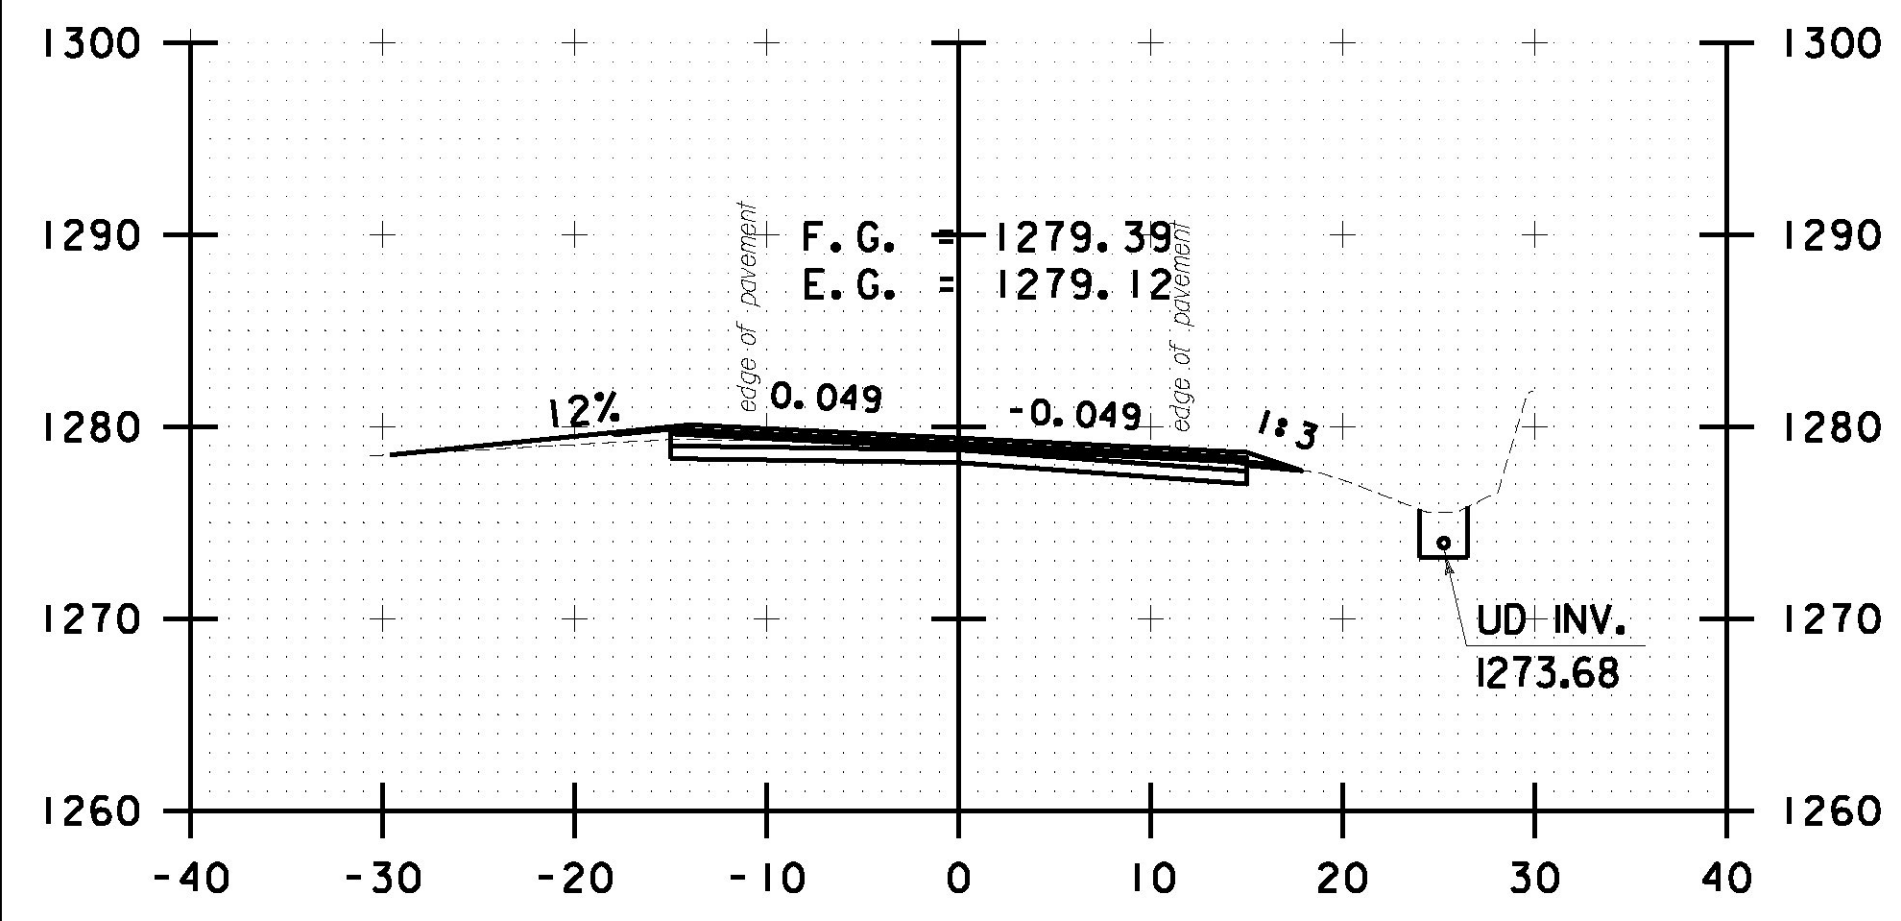


R 172+00.00

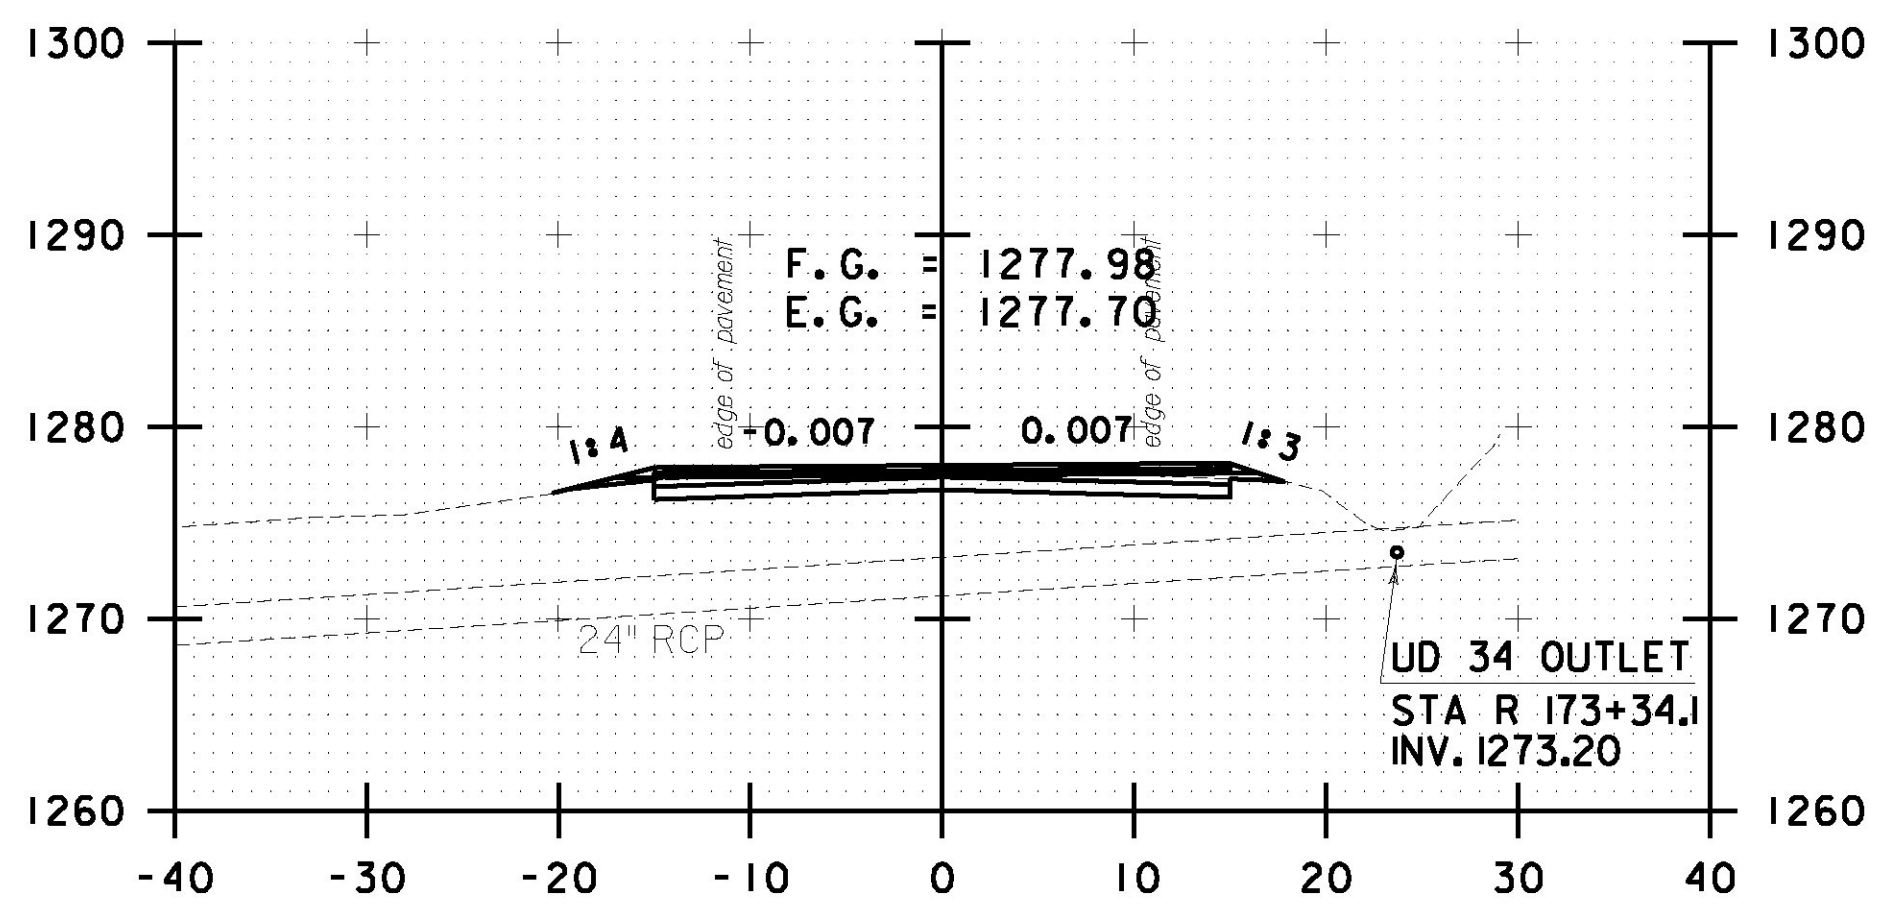


R 173+50.00

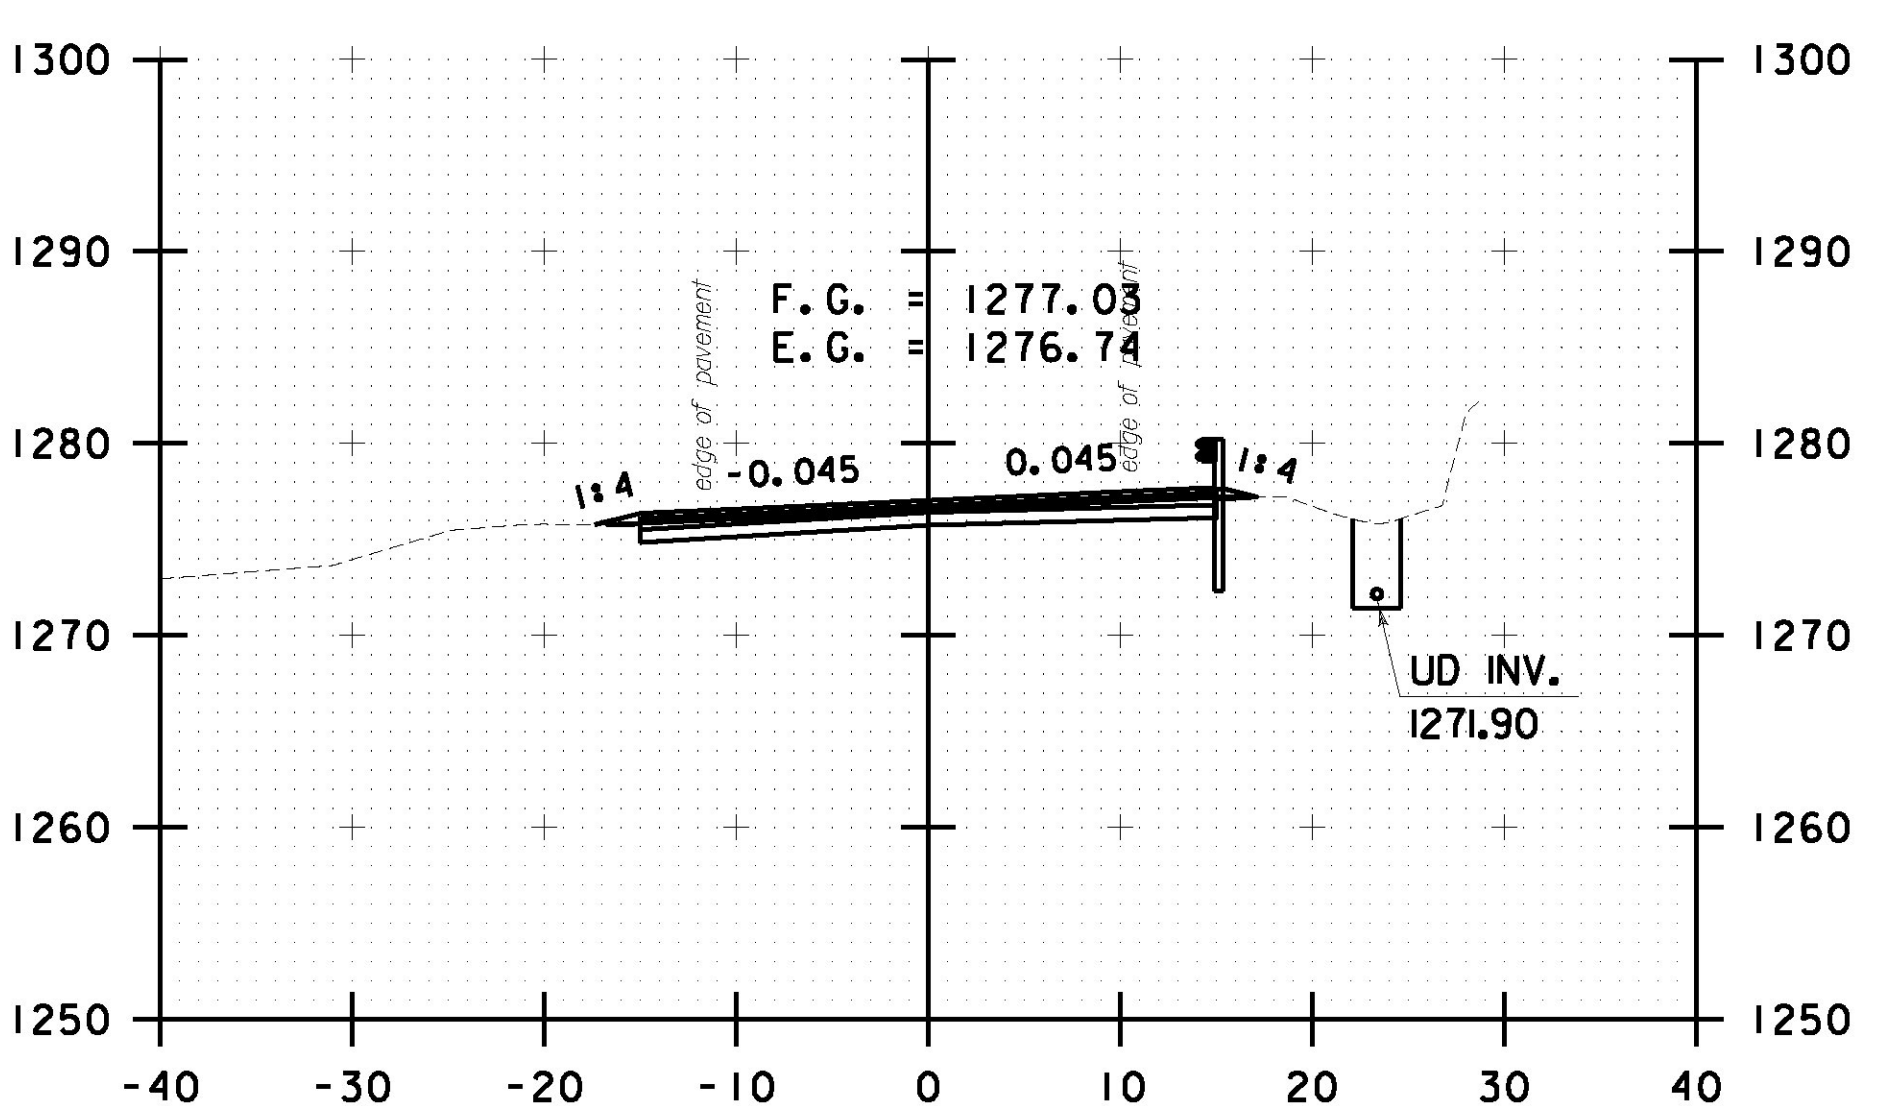


R 174+50.00

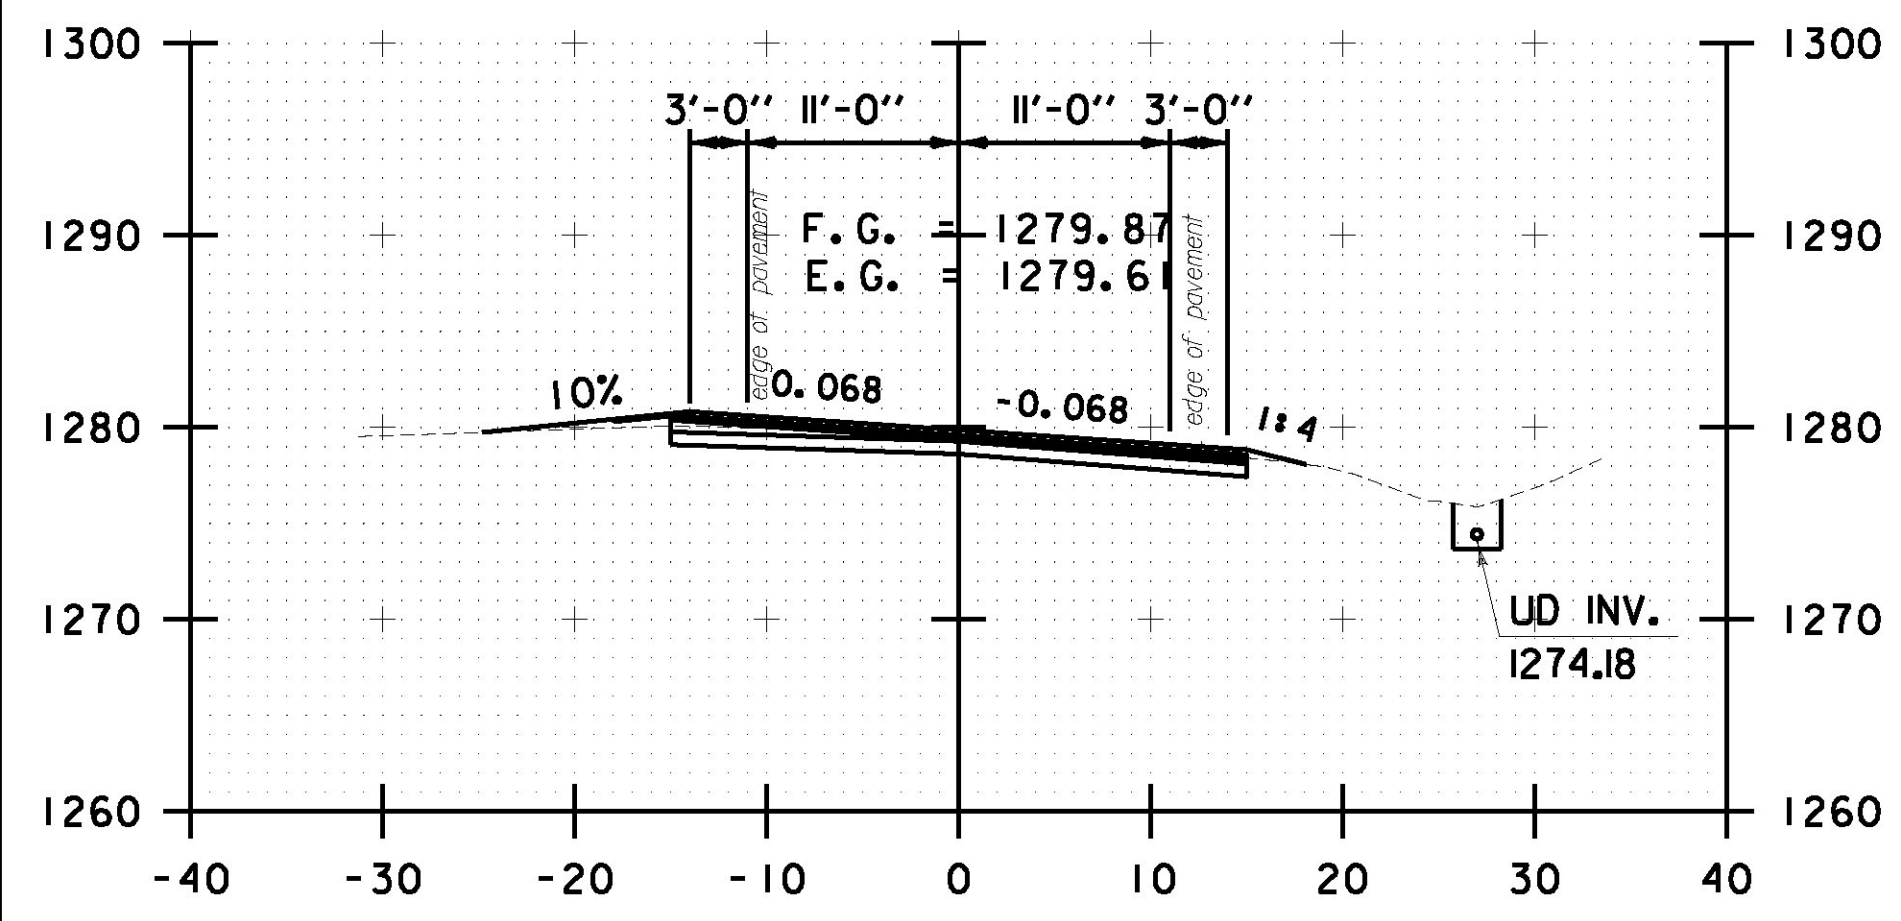

R 171+50.00

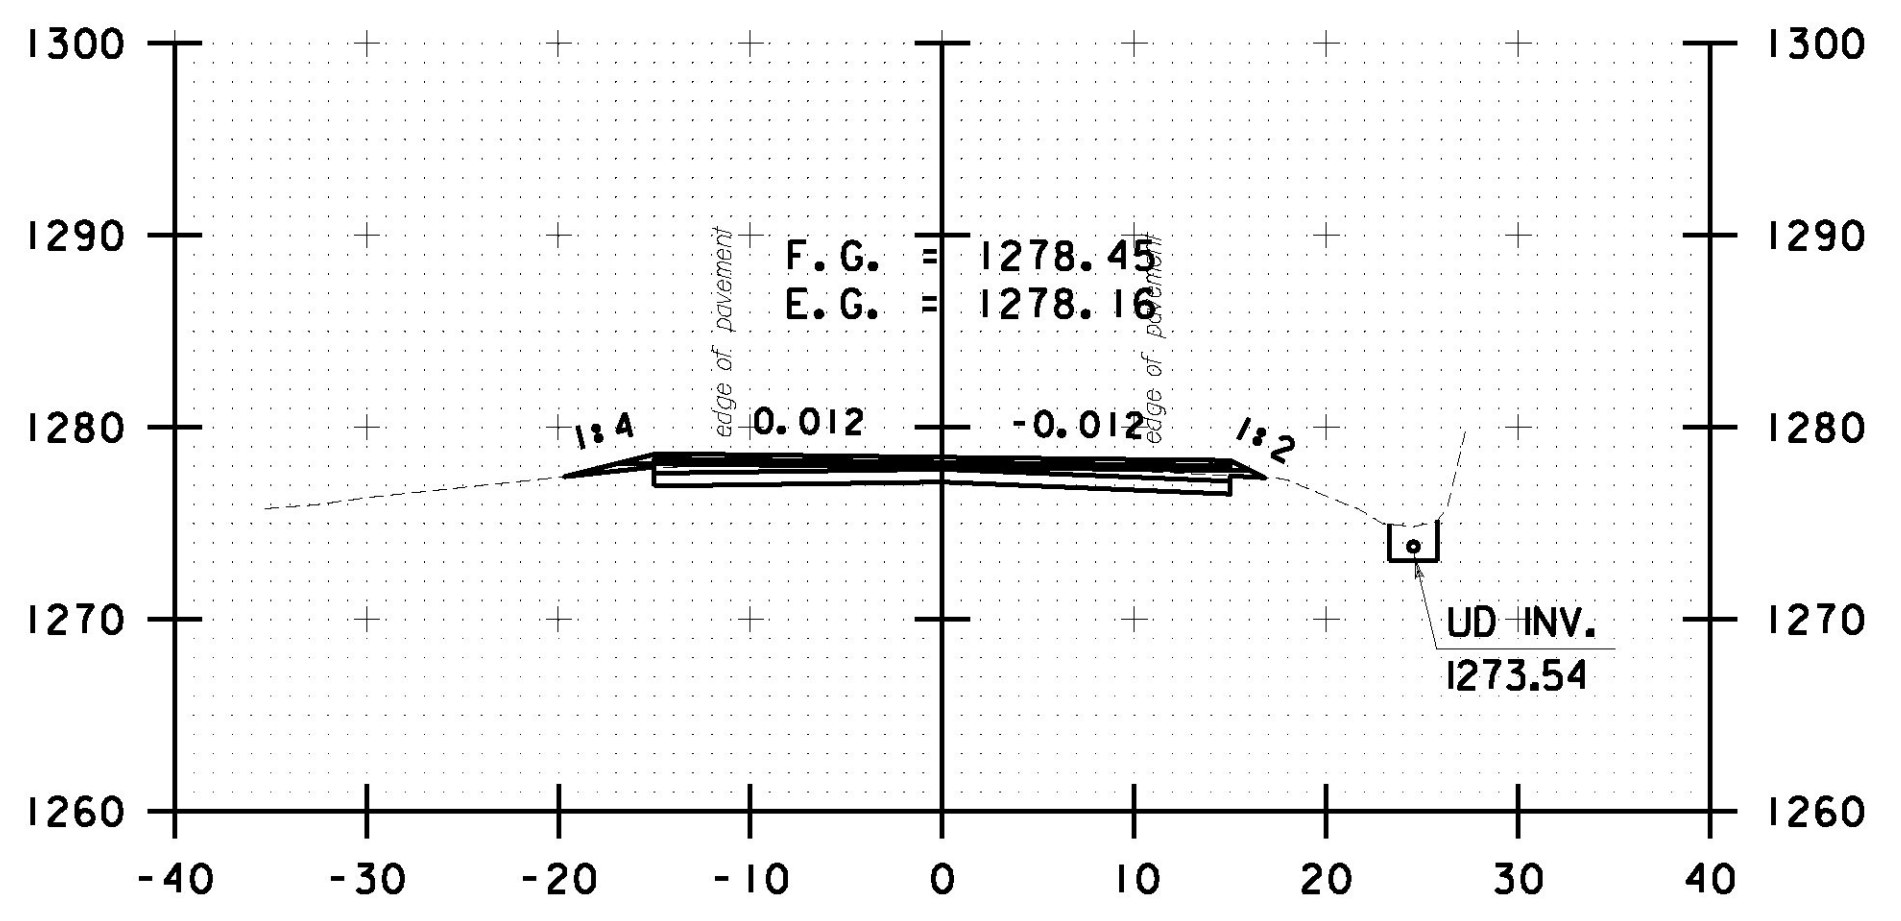

R 173+00.00

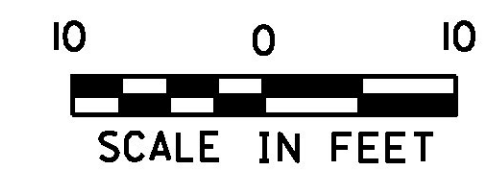

PROJECT NAME: ROCHESTER	
PROJECT NUMBER: ER STP 0162(21)	
FILE NAME: z13cl76xc.dgn	PLOT DATE: 1/12/2017
PROJECT LEADER: D. GOZALKOWSKI	DRAWN BY: J. HEALD
DESIGNED BY: J. OLSEN	CHECKED BY: J. SHIELDS
ROCHESTER CROSS SECTION SHEET #60	SHEET 246 OF 360