




R 220+50.00

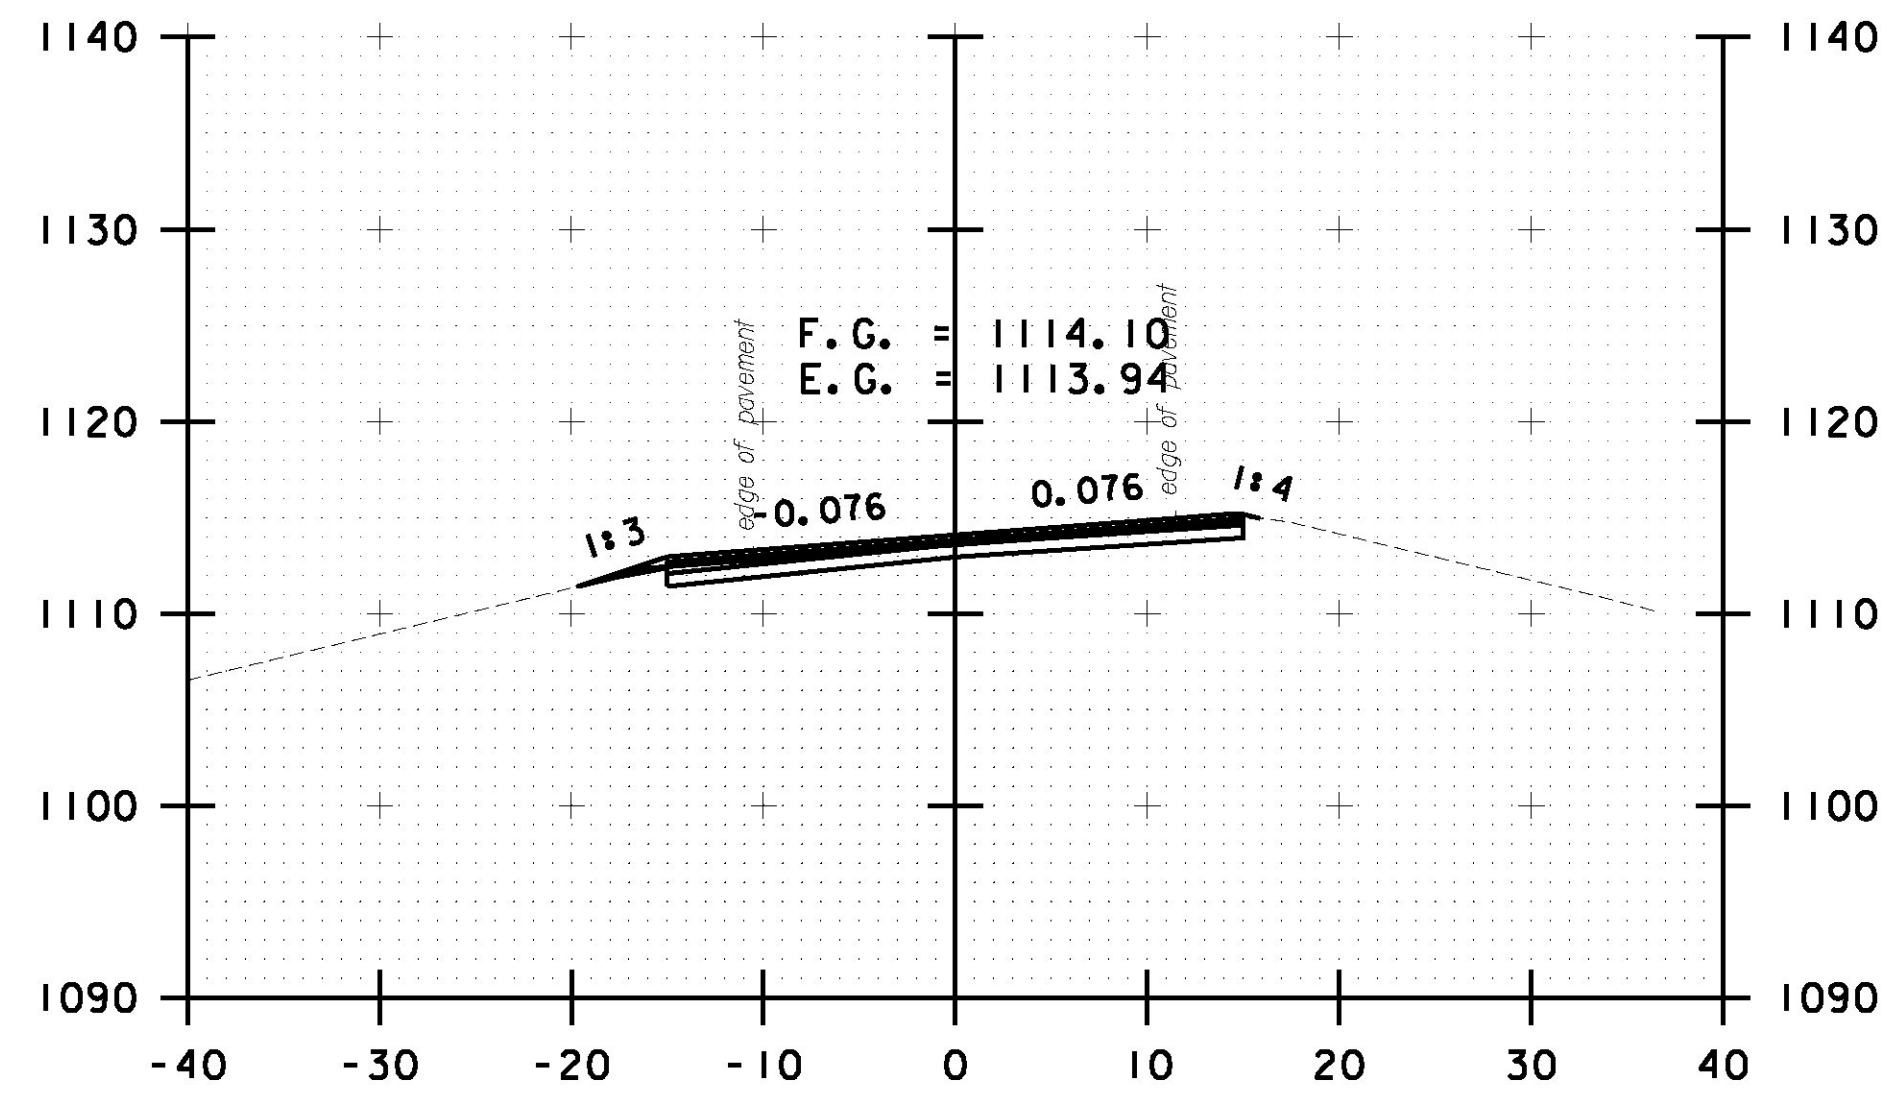


R 221+50.00

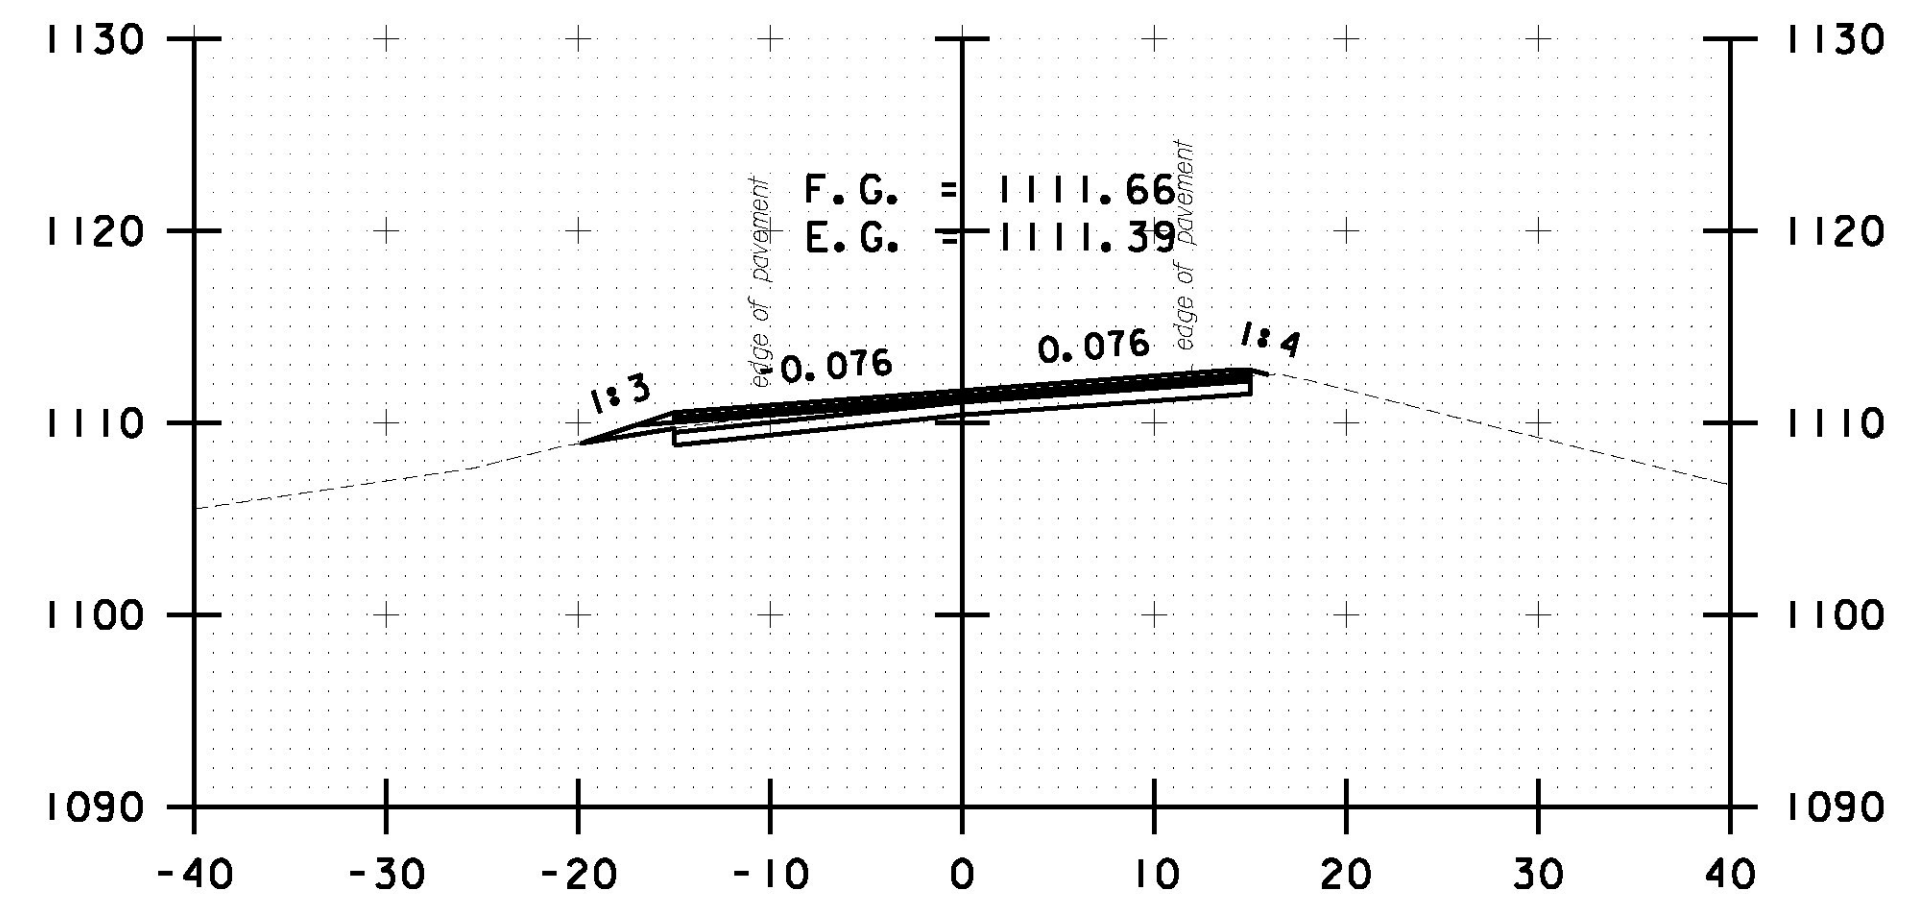


R 222+50.00

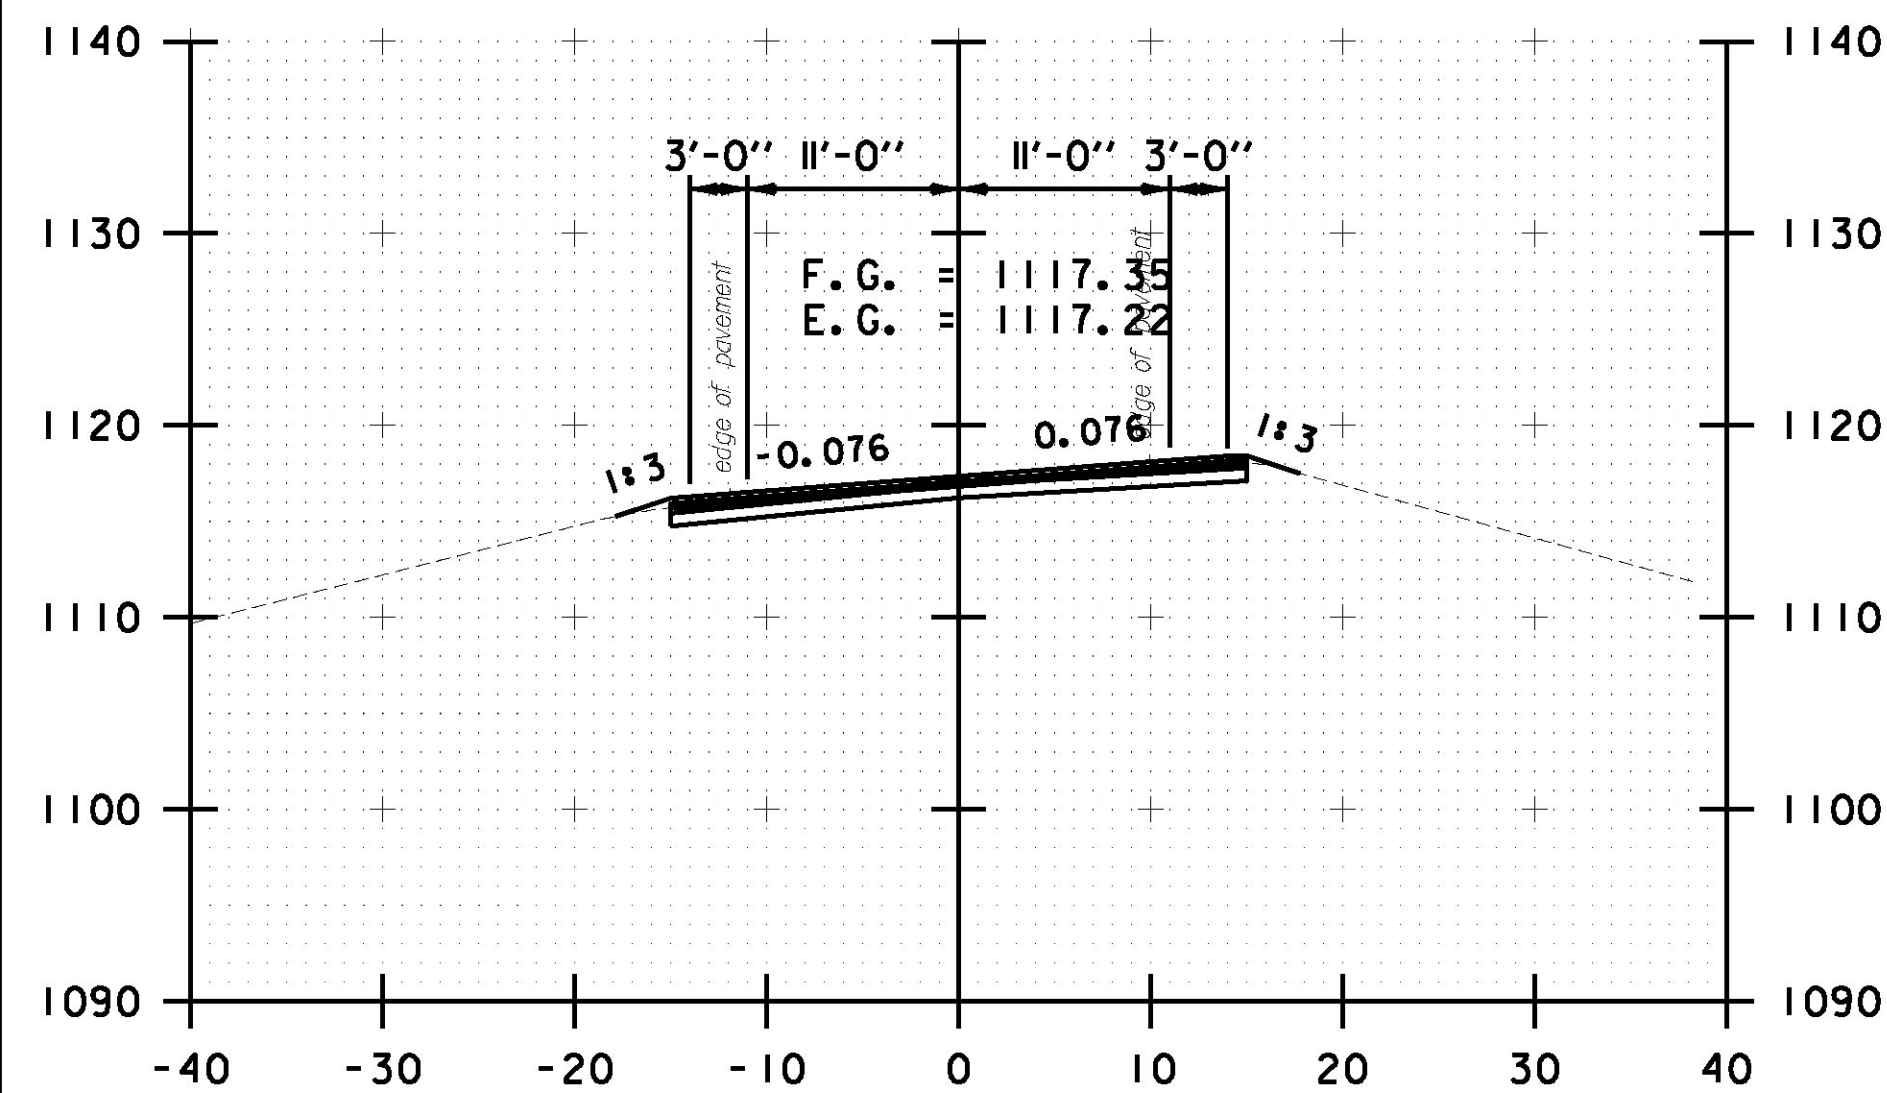


R 220+00.00

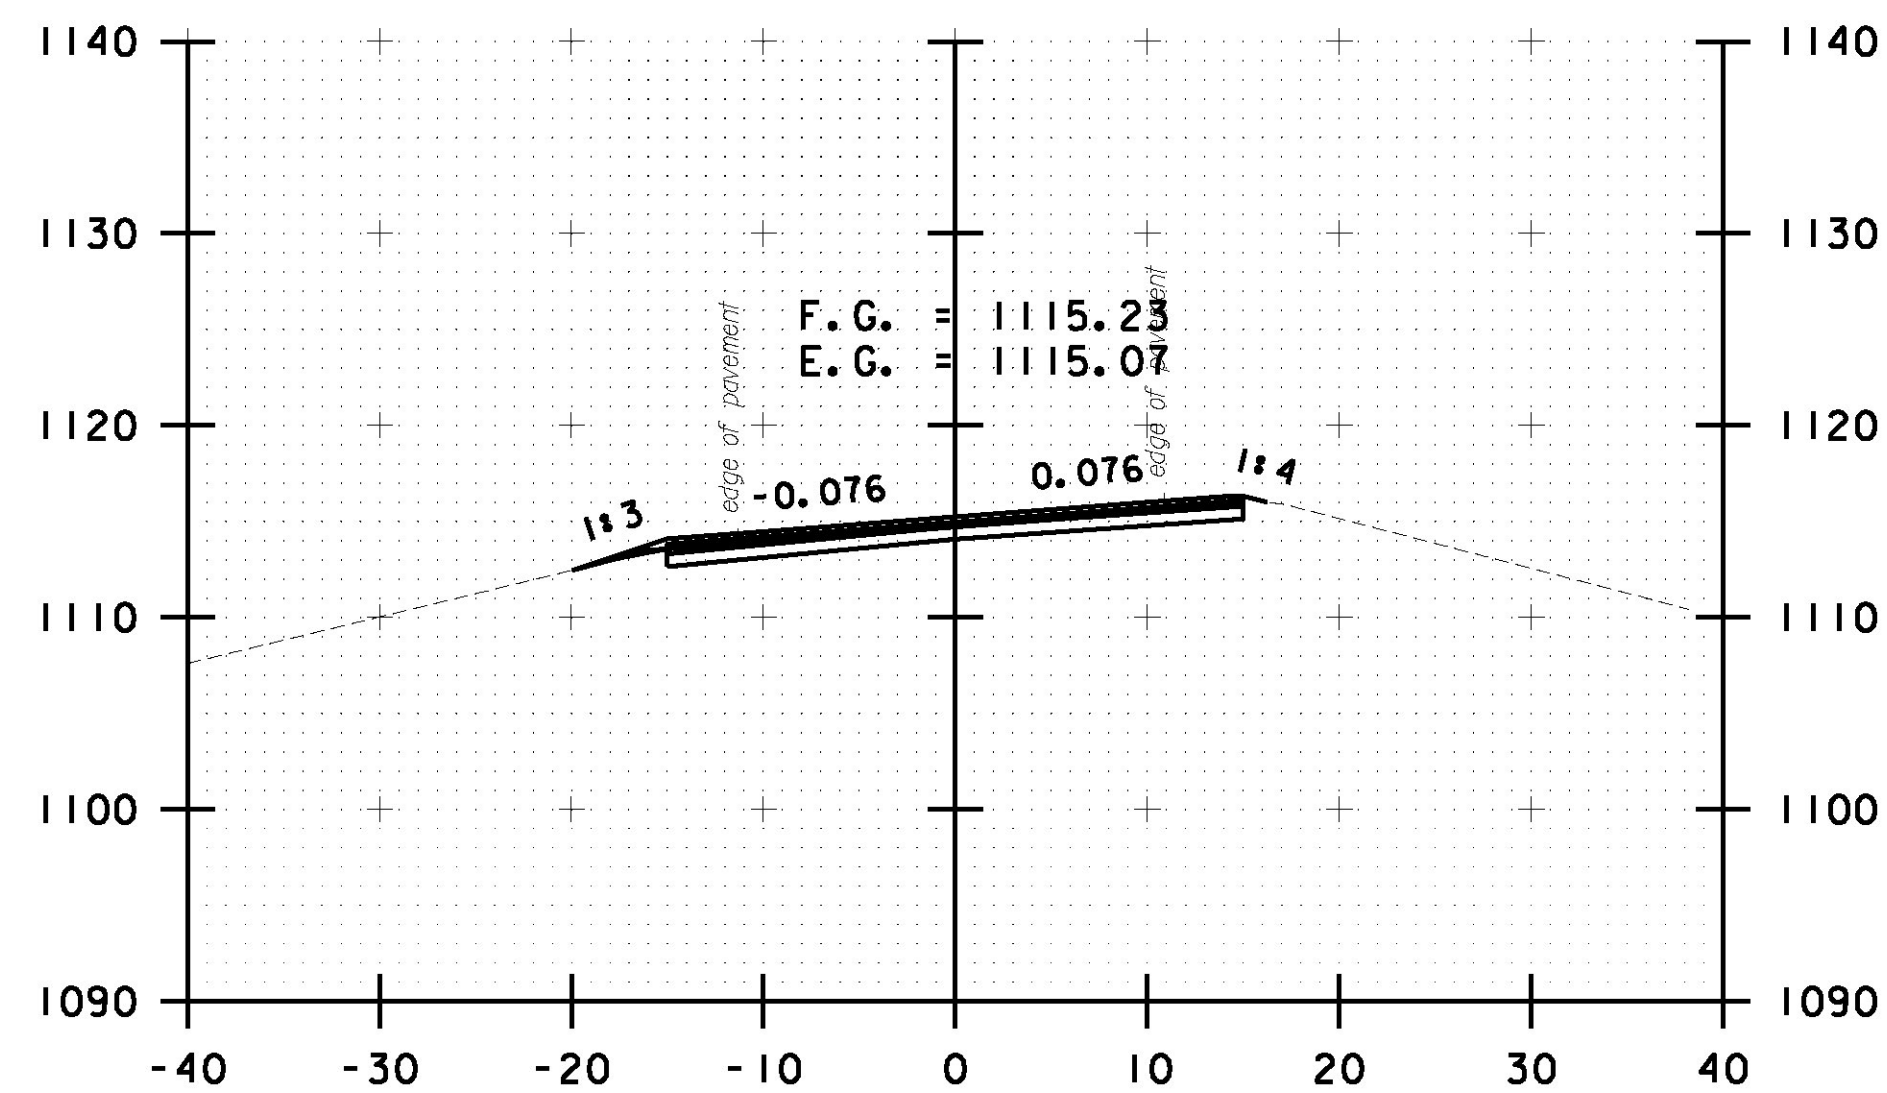

R 221+00.00

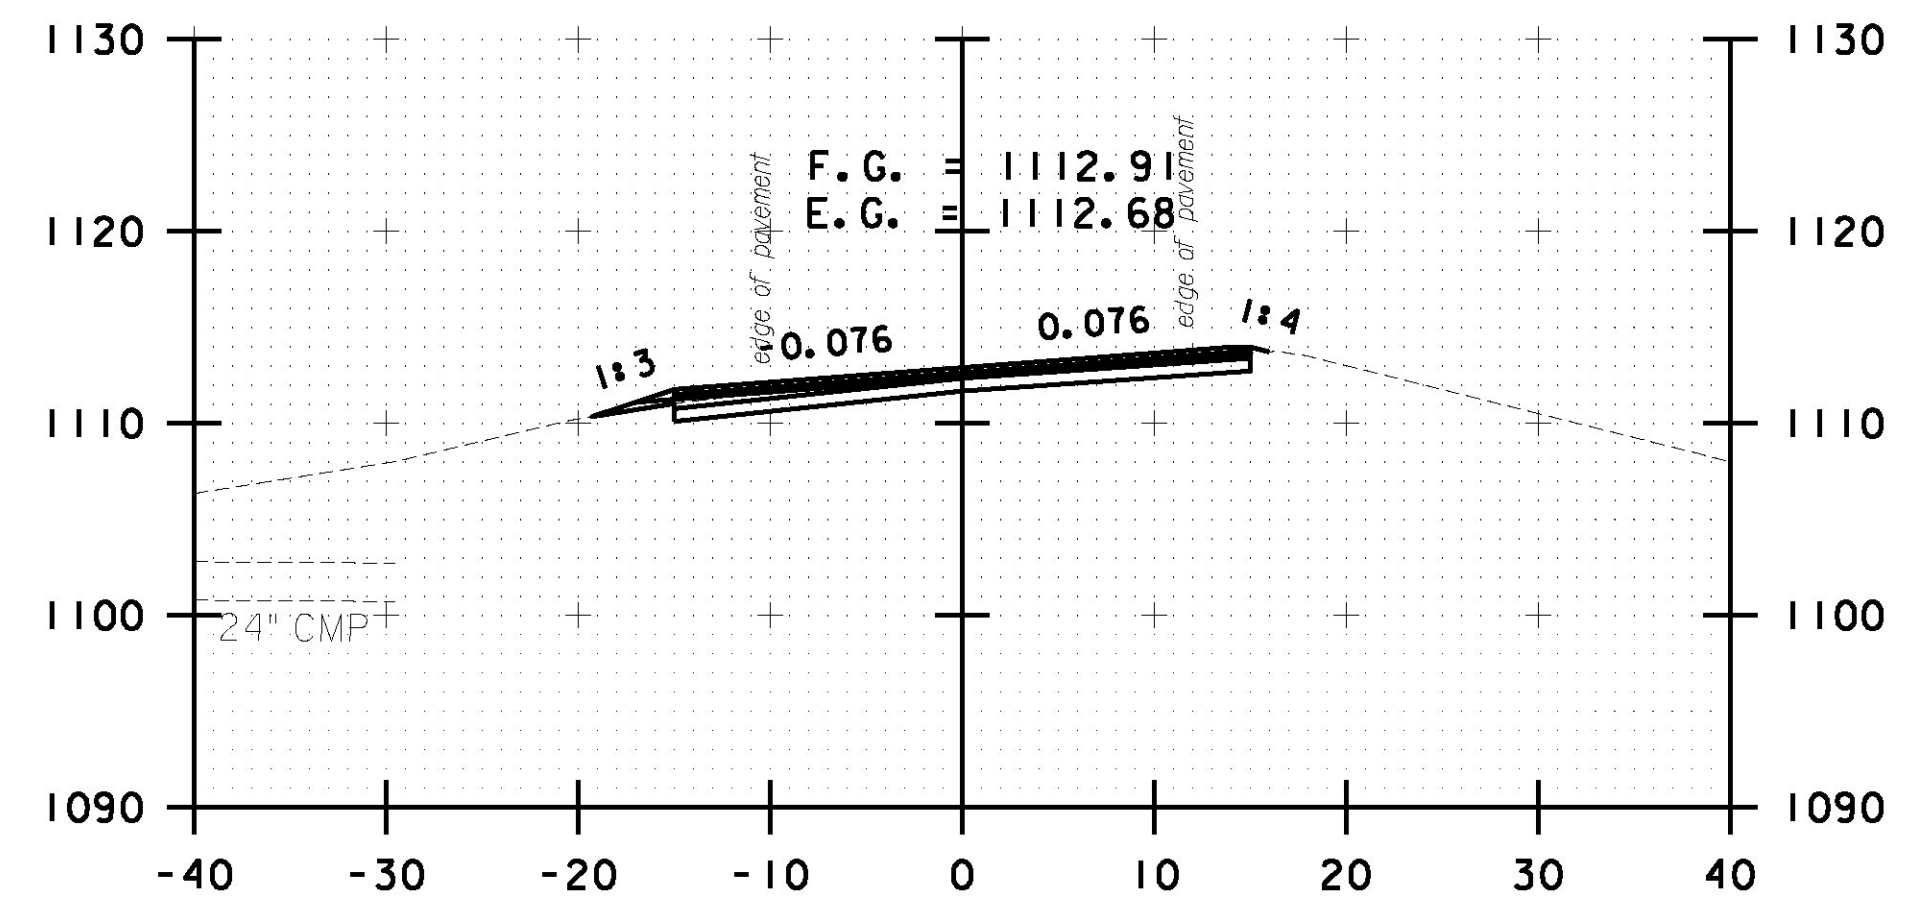

R 222+00.00

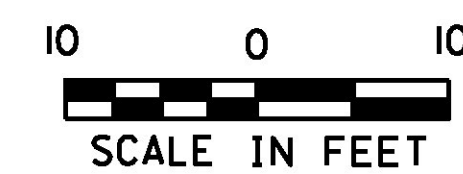

SCALE IN FEET



PROJECT NAME: ROCHESTER	
PROJECT NUMBER: ER STP 0162(21)	
FILE NAME: z13cl76xc.dgn	PLOT DATE: 1/12/2017
PROJECT LEADER: D. GOZALKOWSKI	DRAWN BY: J. HEALD
DESIGNED BY: J. OLSEN	CHECKED BY: J. SHIELDS
ROCHESTER CROSS SECTION SHEET #77	SHEET 263 OF 360