




C 3+50.00

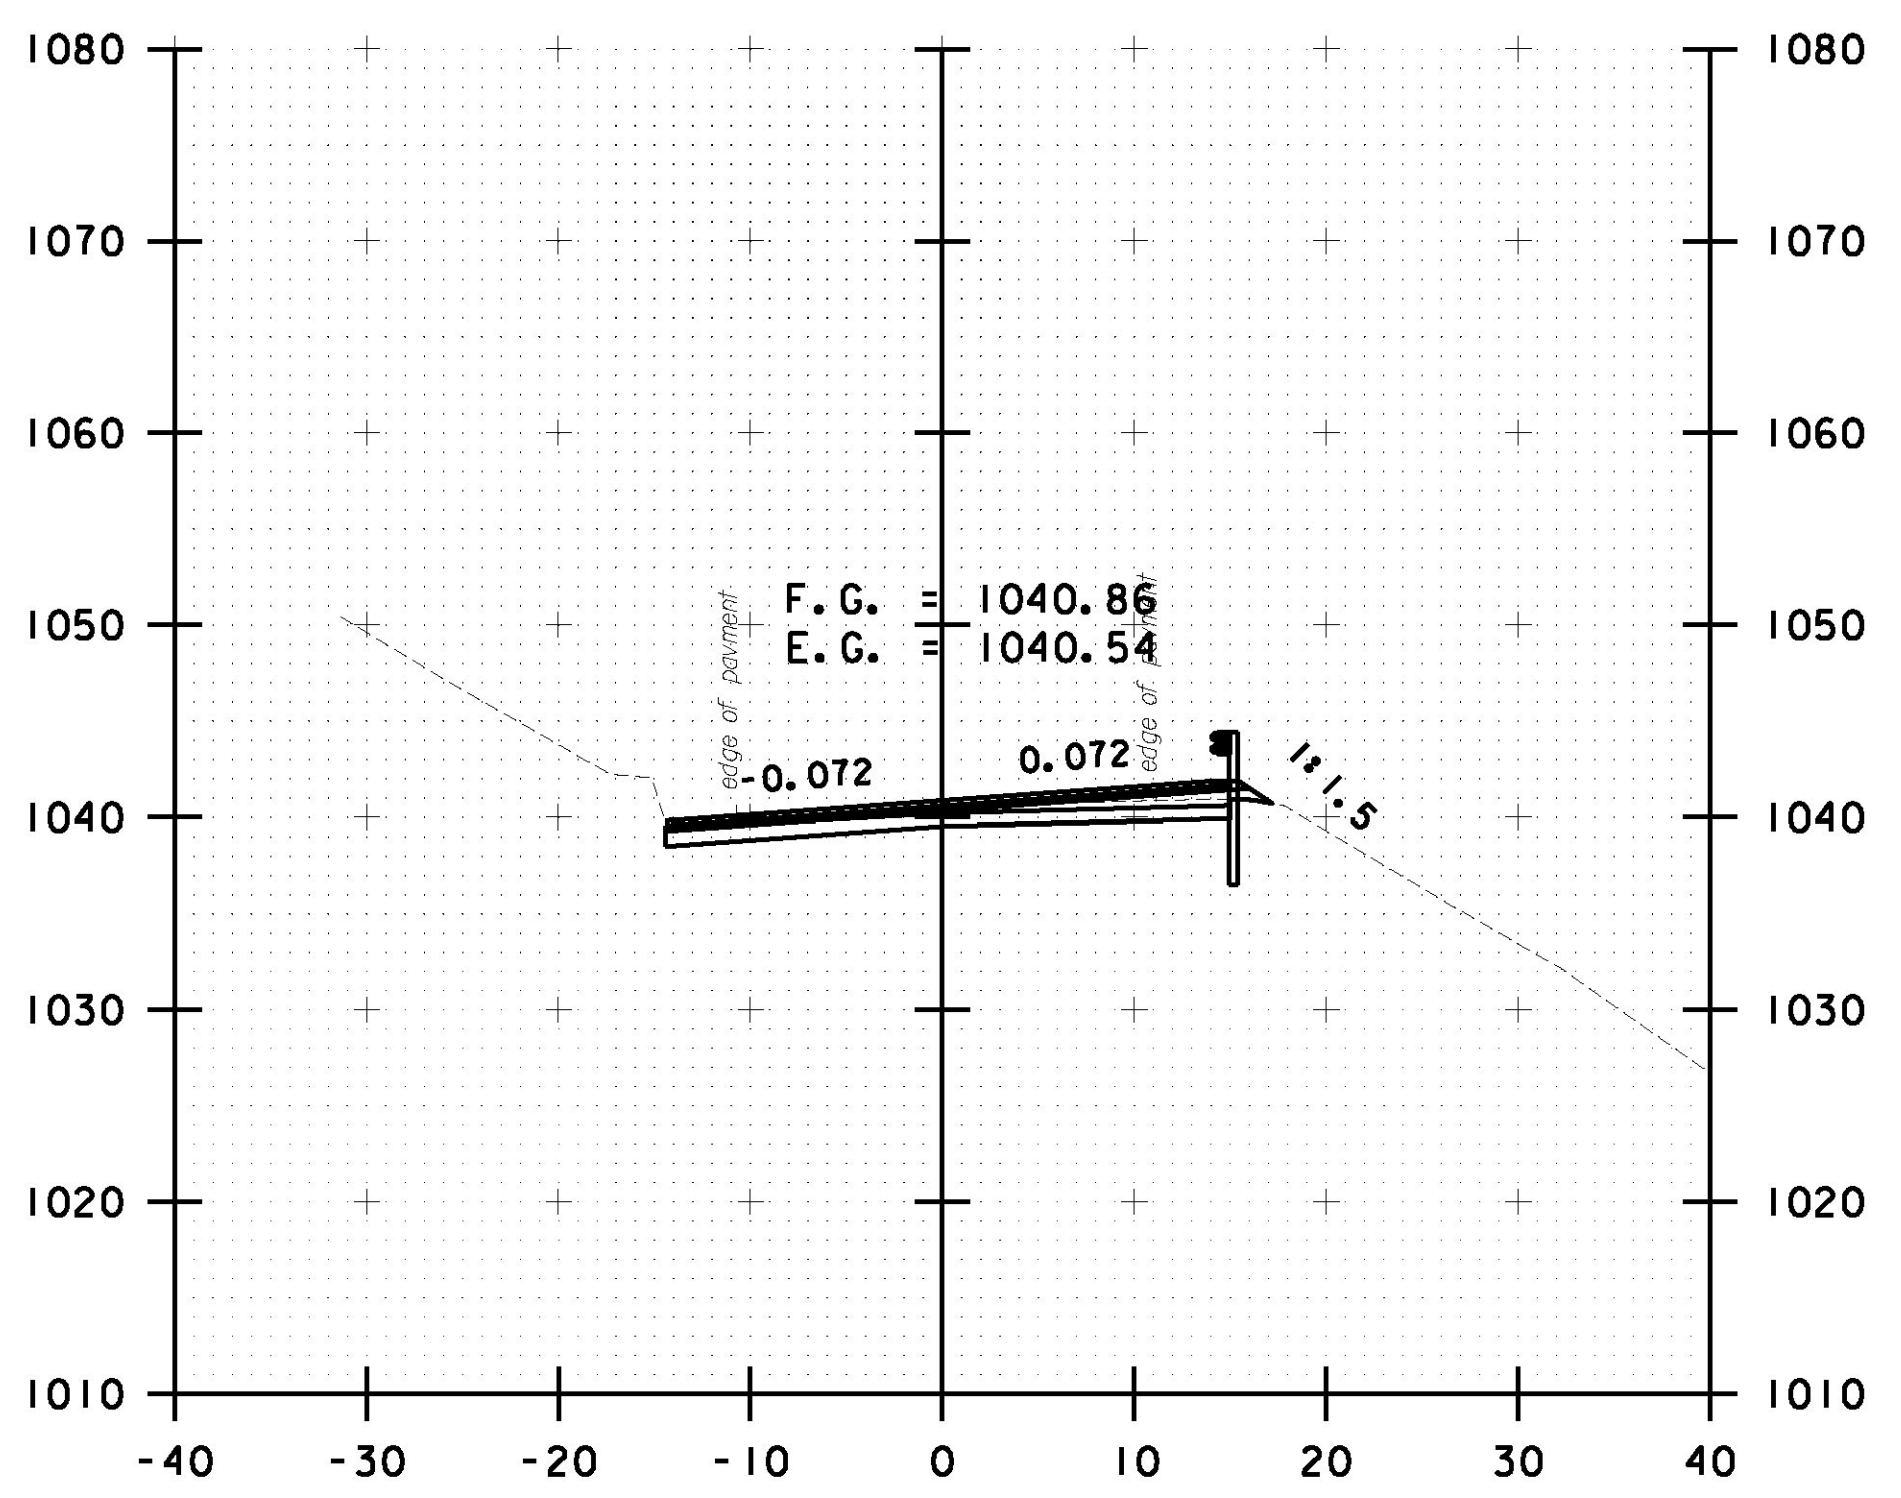


C 4+50.00

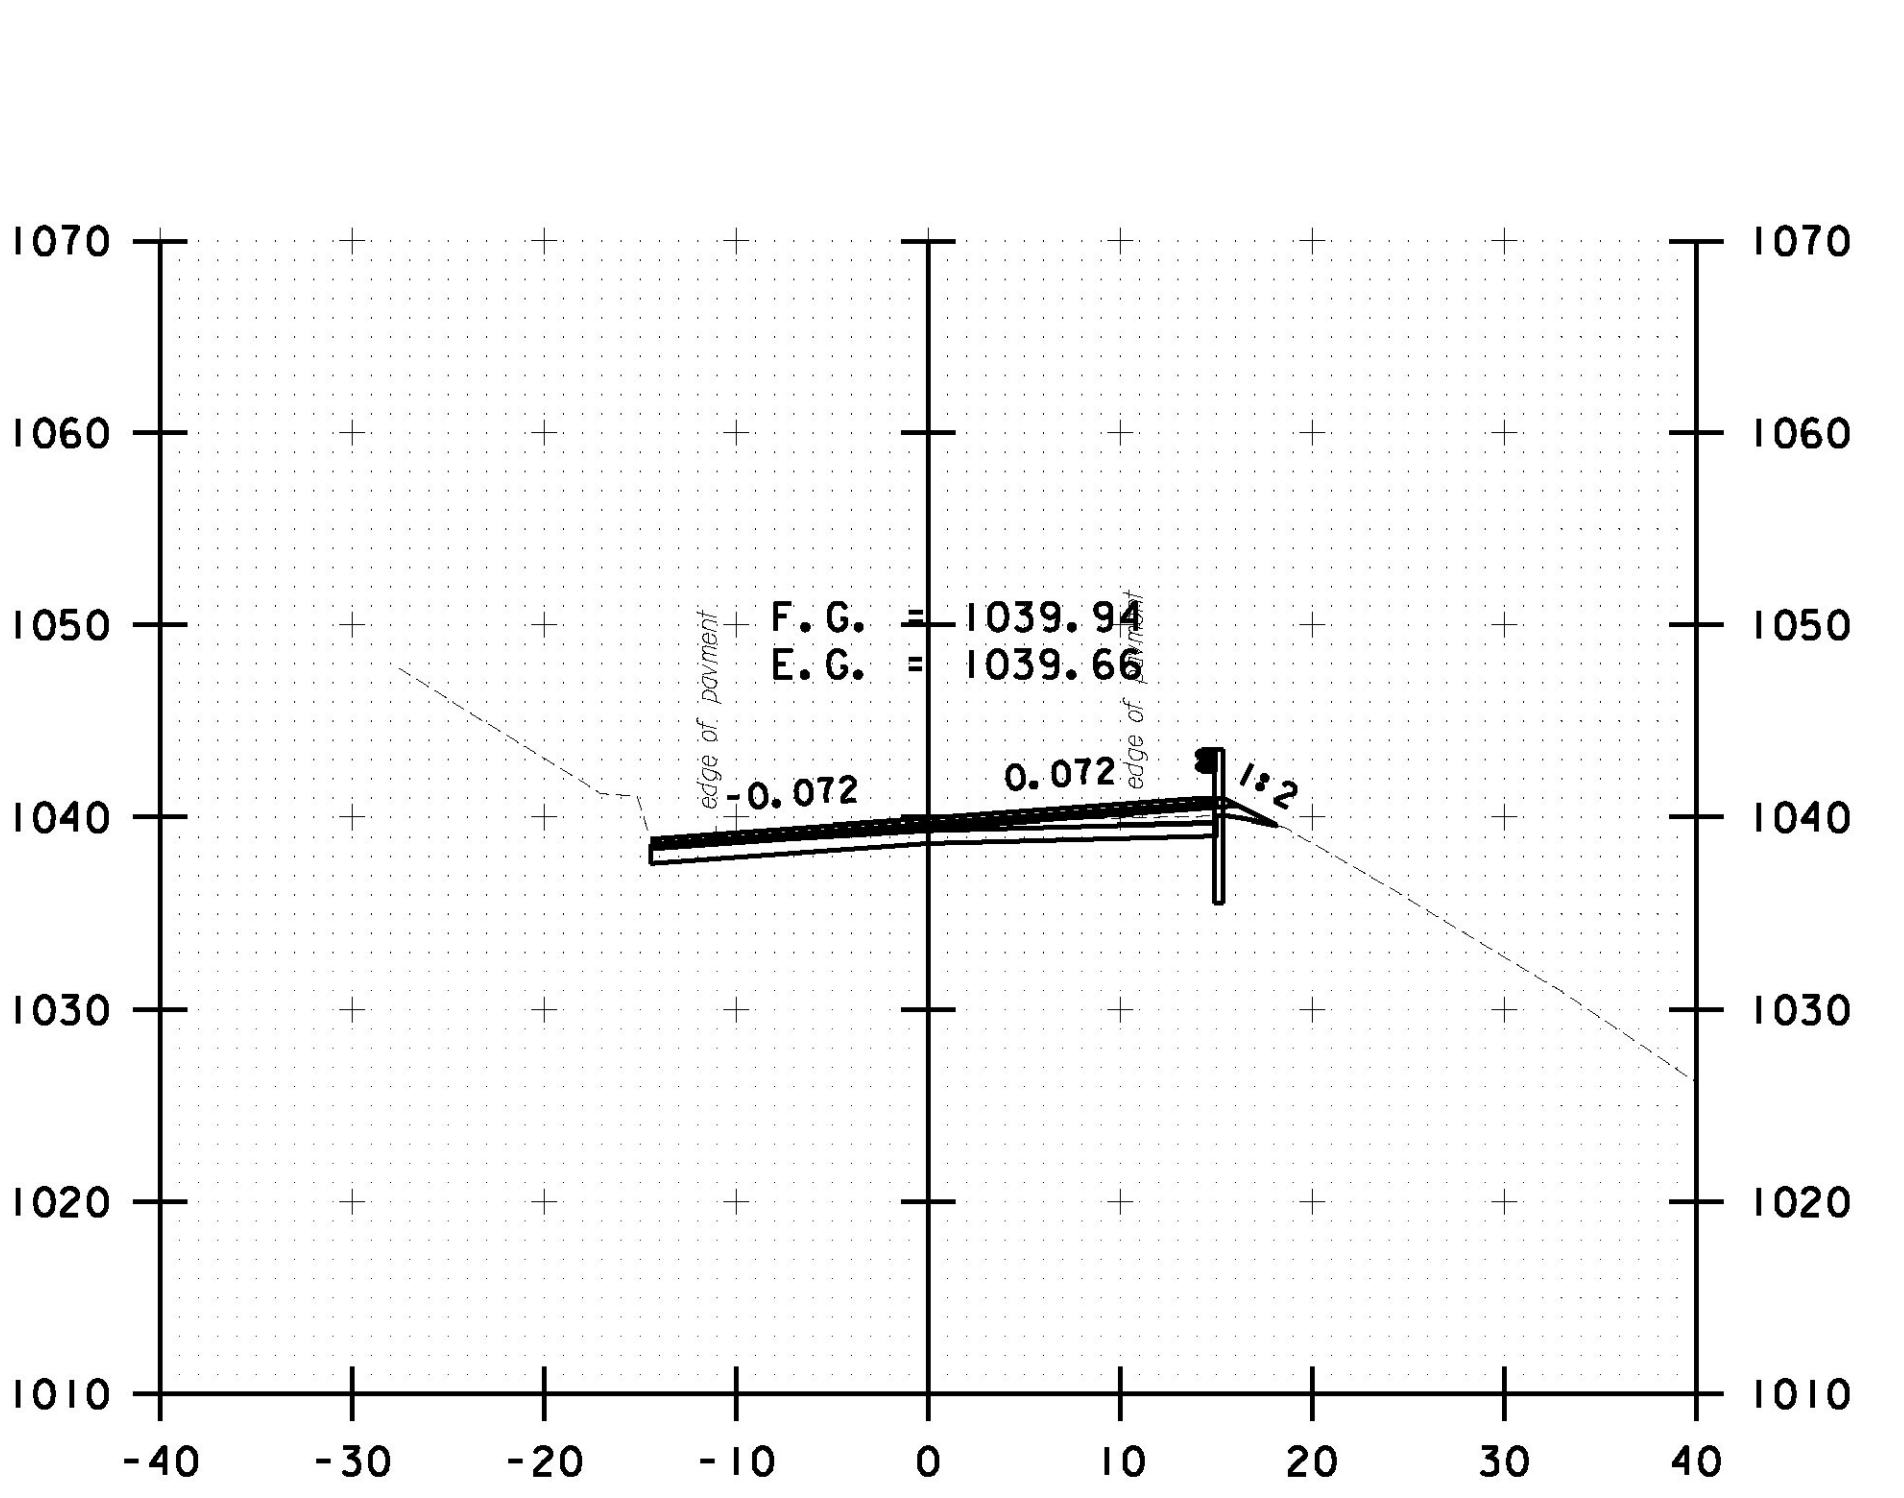


C 5+50.00

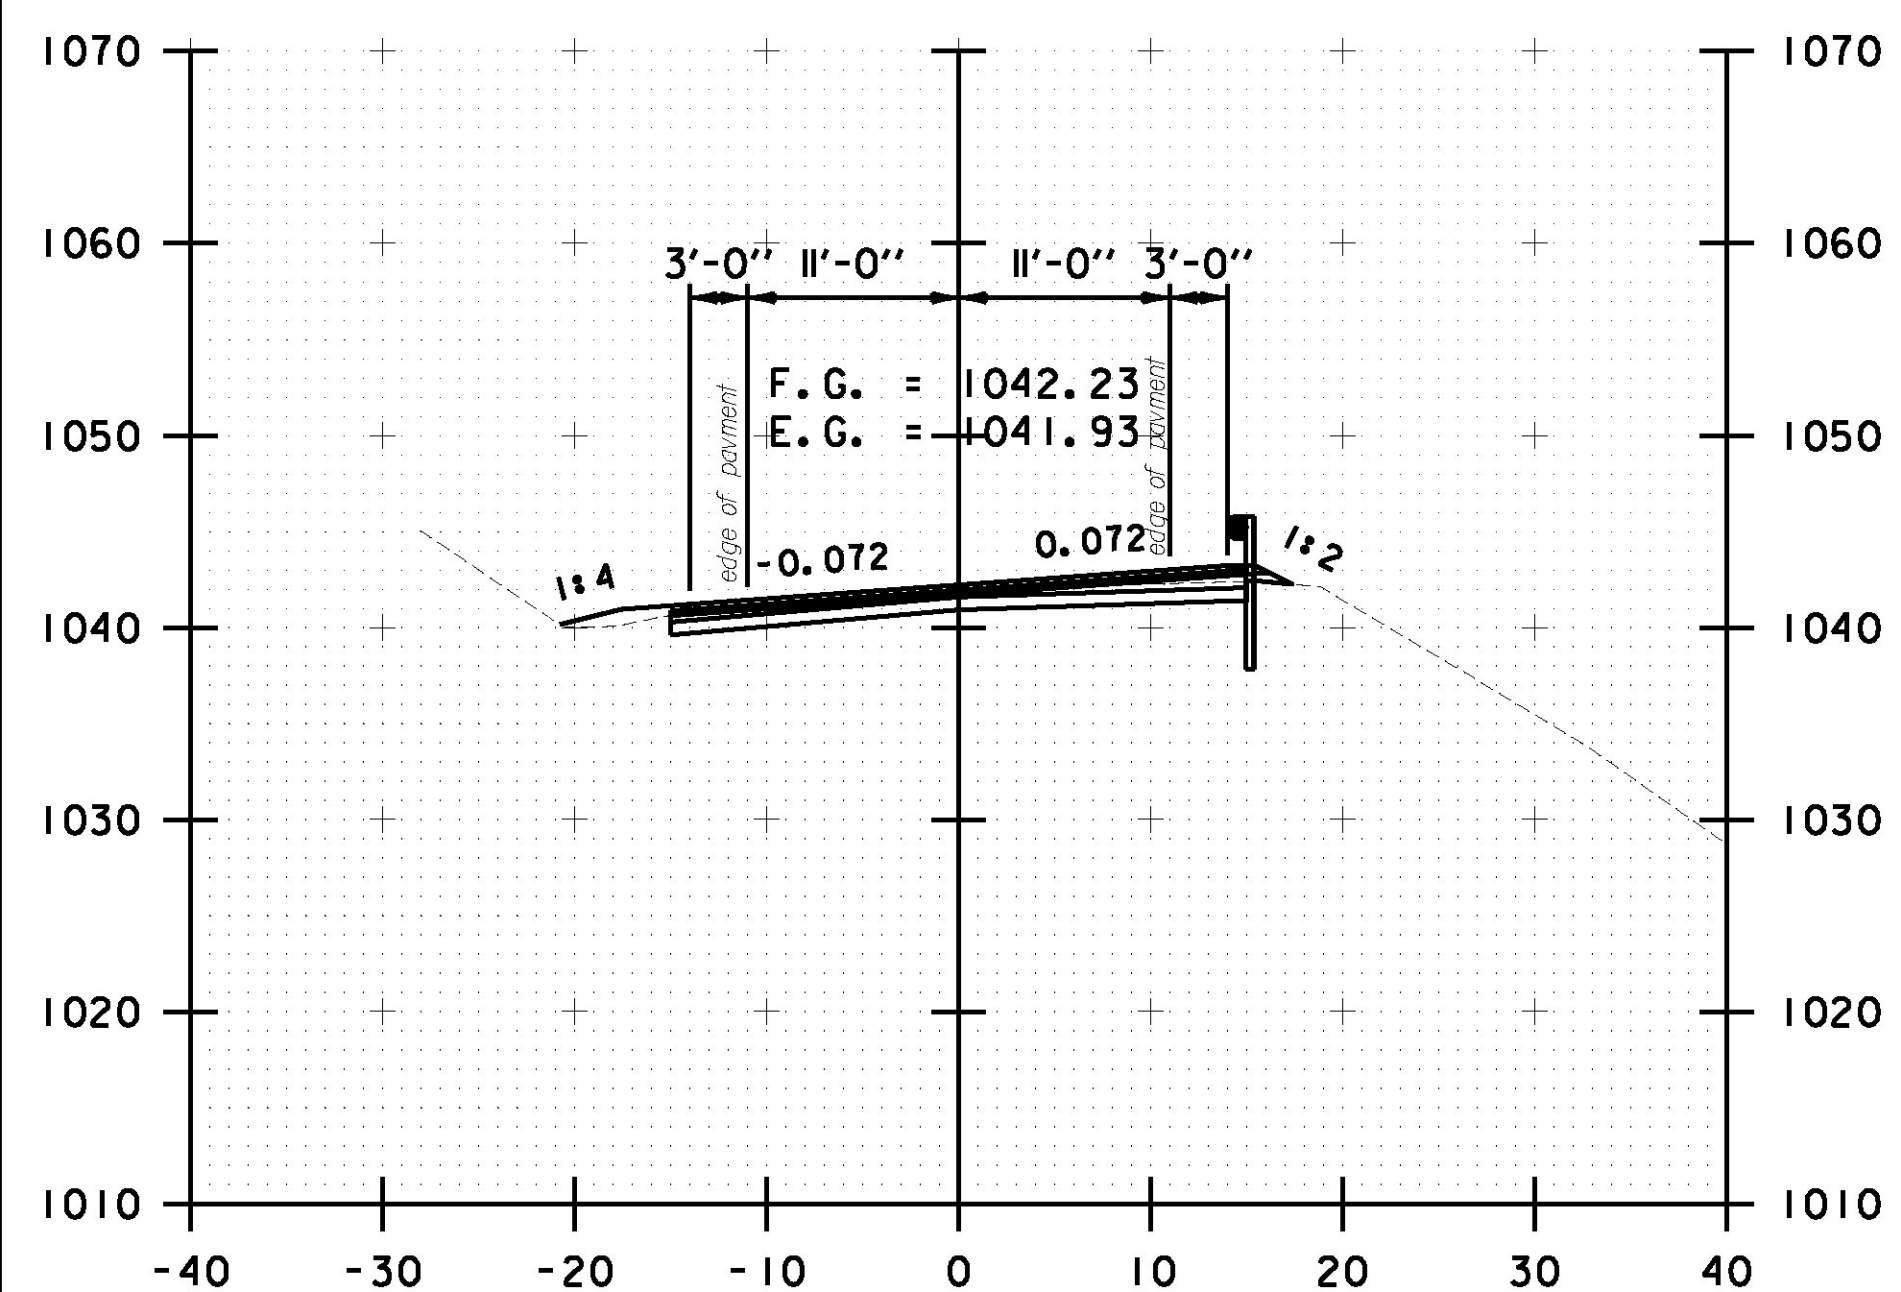


C 3+00.00

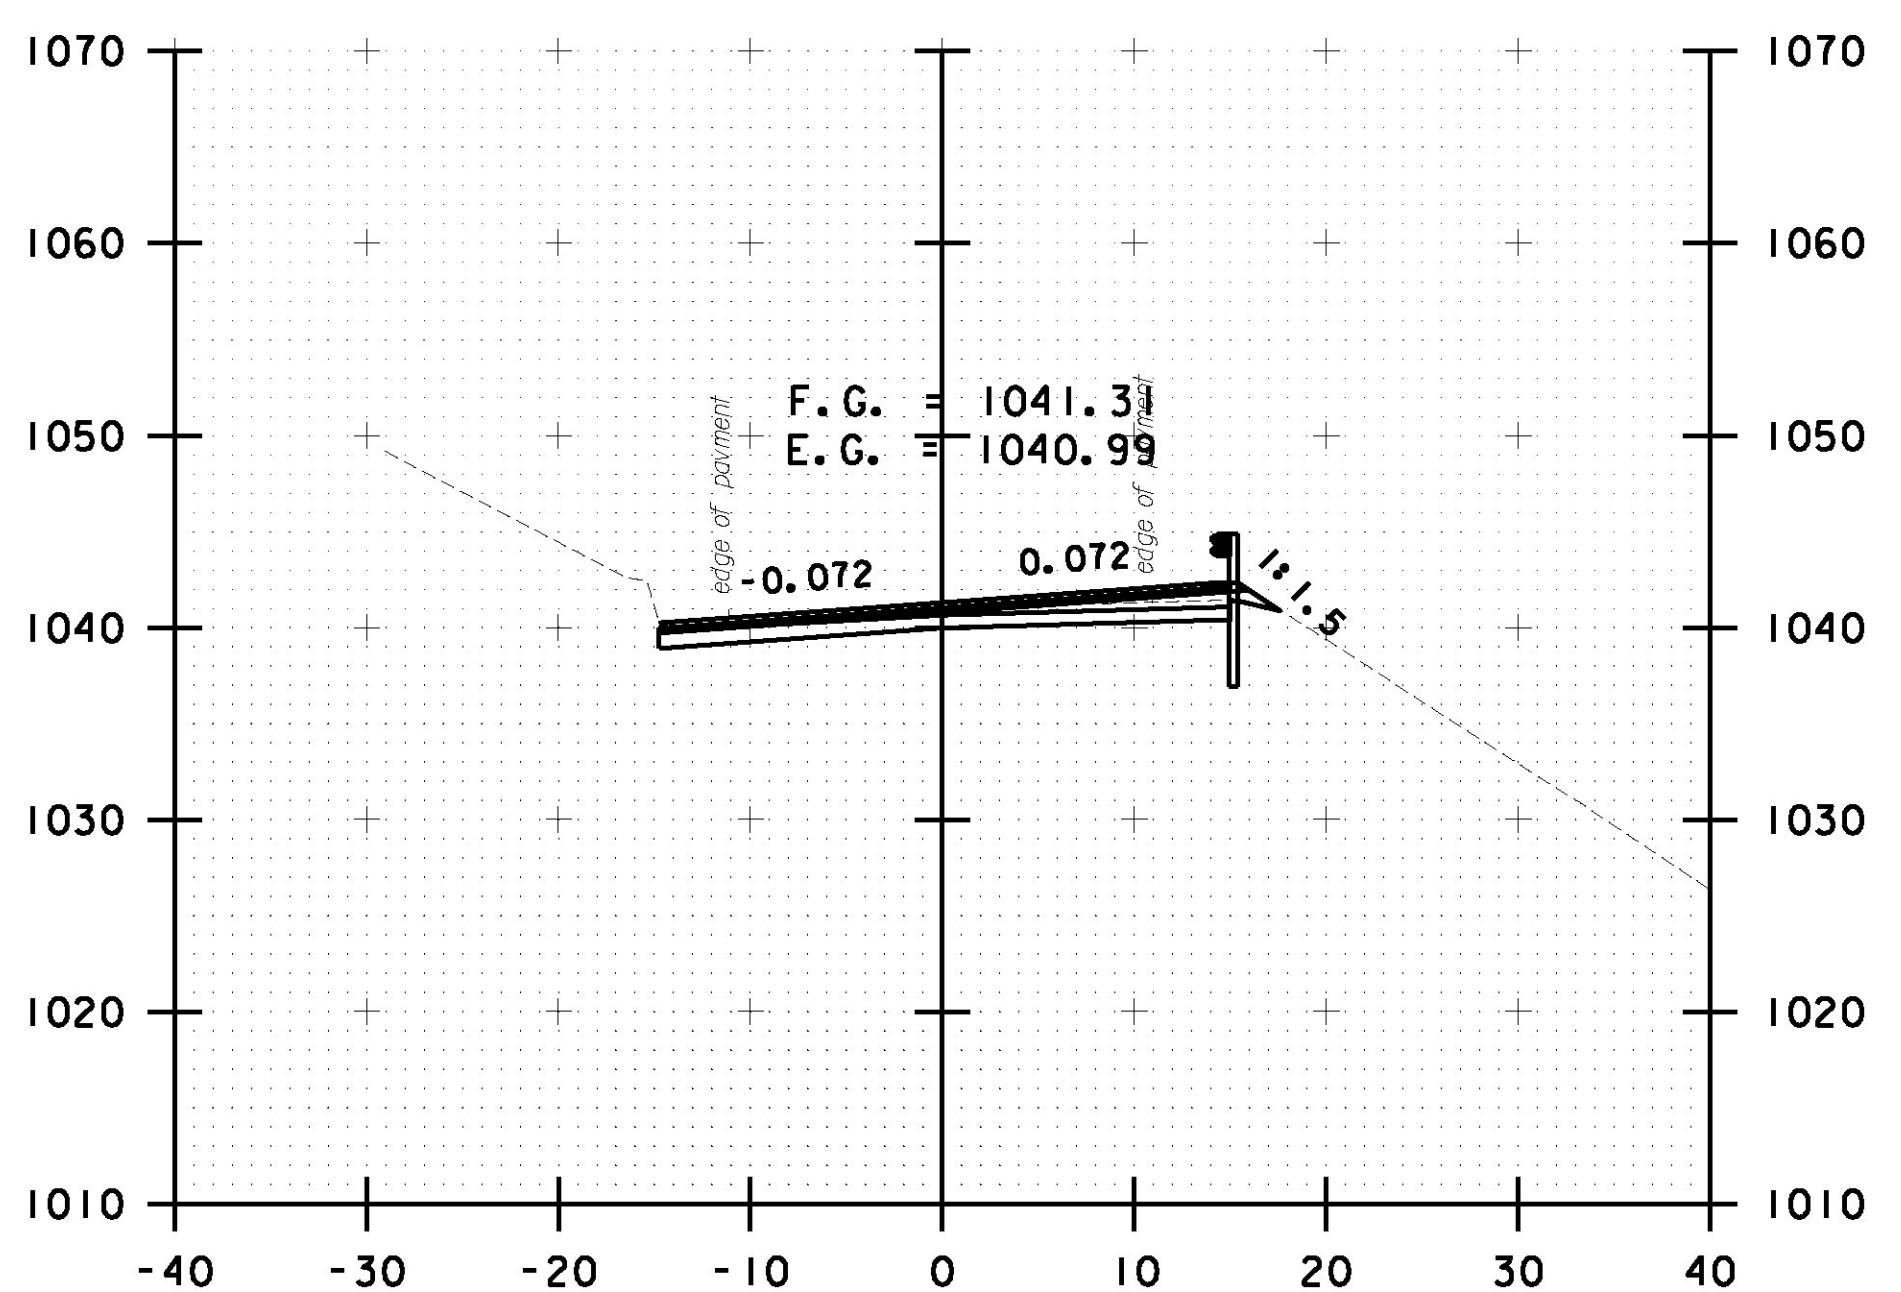

C 4+00.00

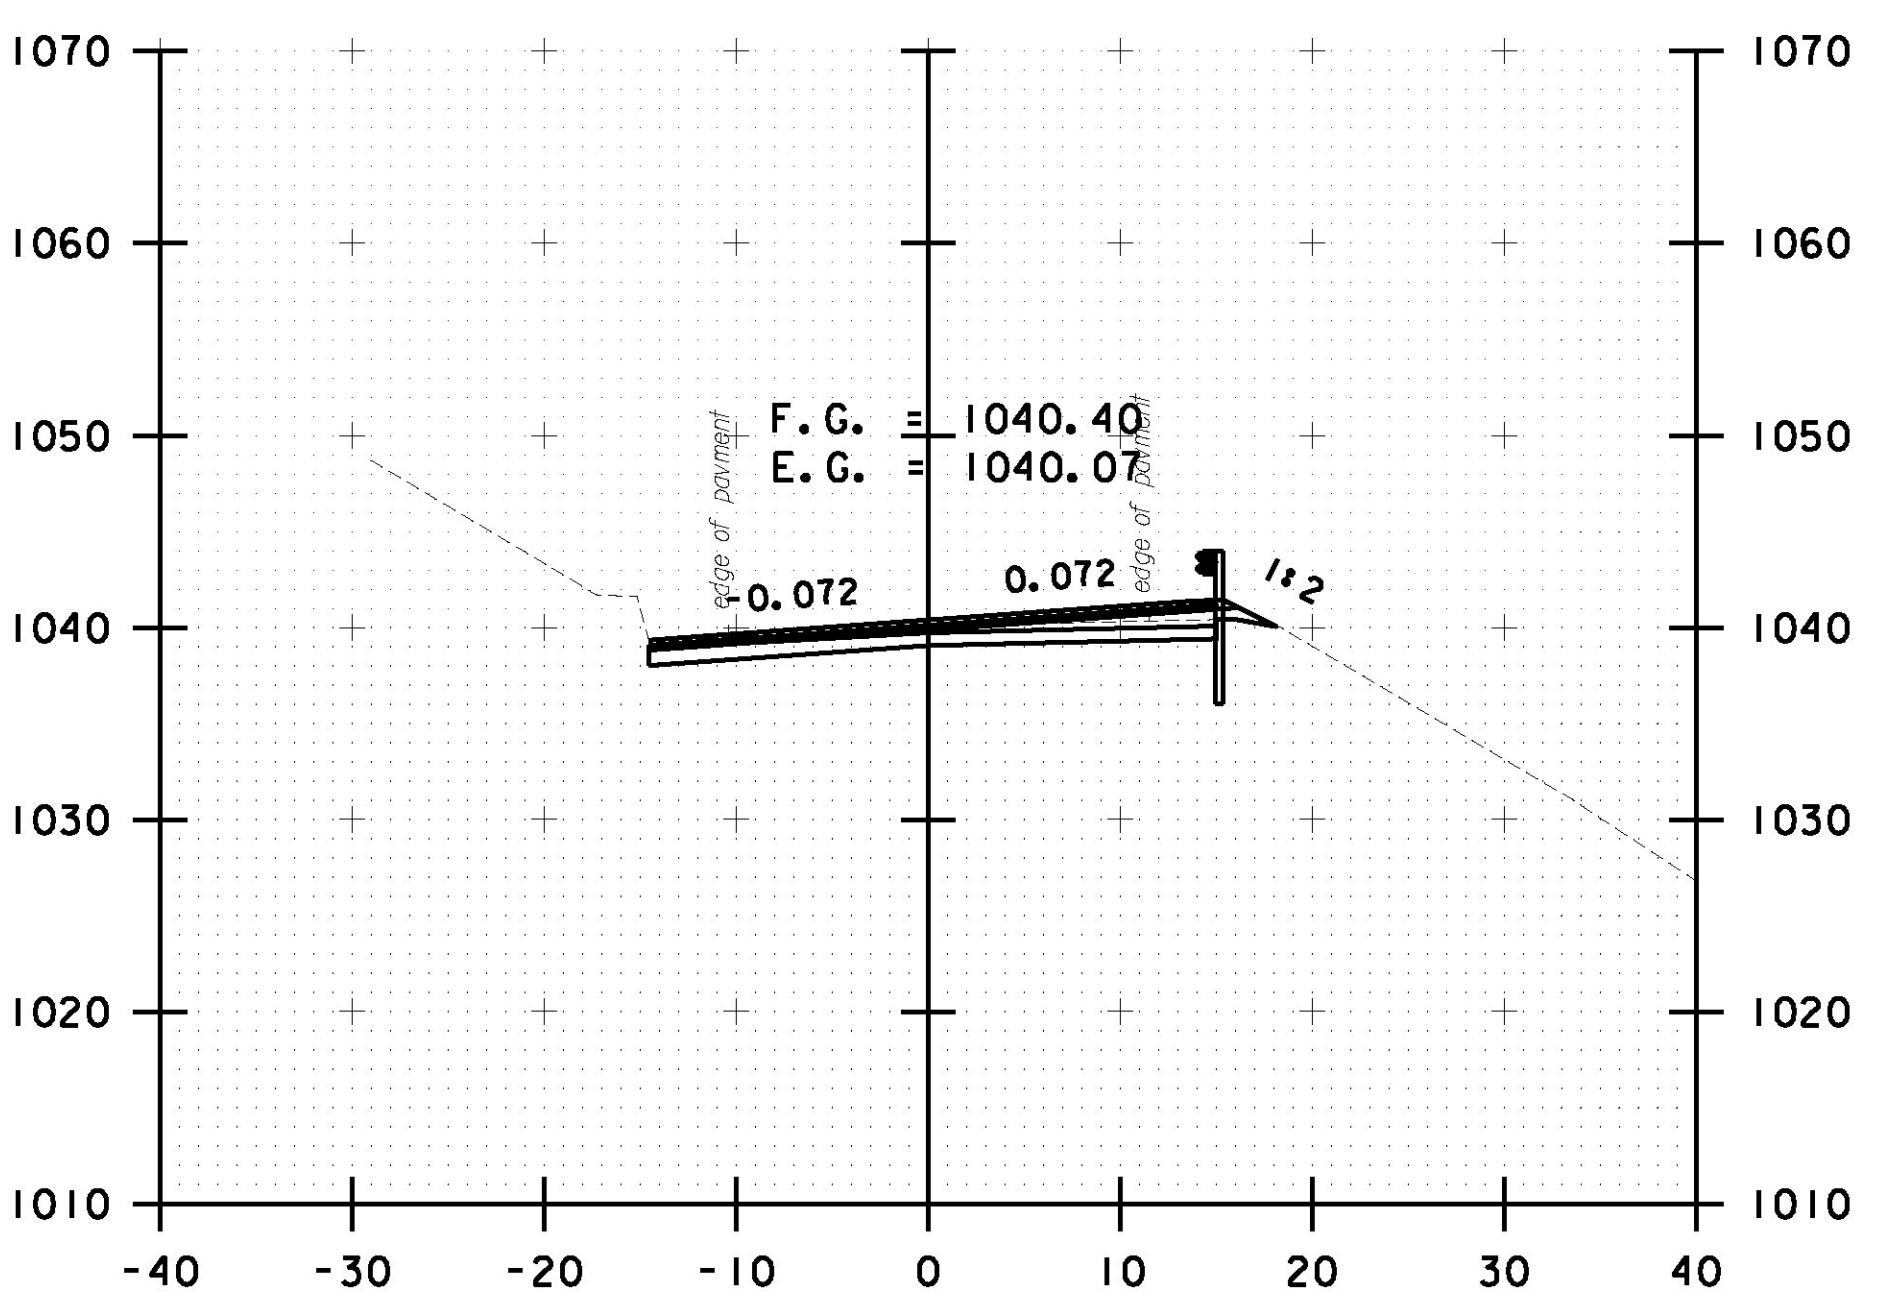

C 5+00.00

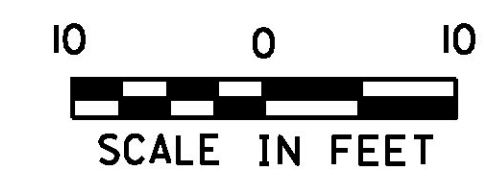

PROJECT NAME: ROCHESTER	
PROJECT NUMBER: ER STP 0162(21)	
FILE NAME: z13cl76xc.dgn	PLOT DATE: 1/12/2017
PROJECT LEADER: D. GOZALKOWSKI	DRAWN BY: J. HEALD
DESIGNED BY: J. OLSEN	CHECKED BY: J. SHIELDS
CHITTENDEN CROSS SECTION SHEET #2	SHEET 275 OF 360