




C 6+50.00

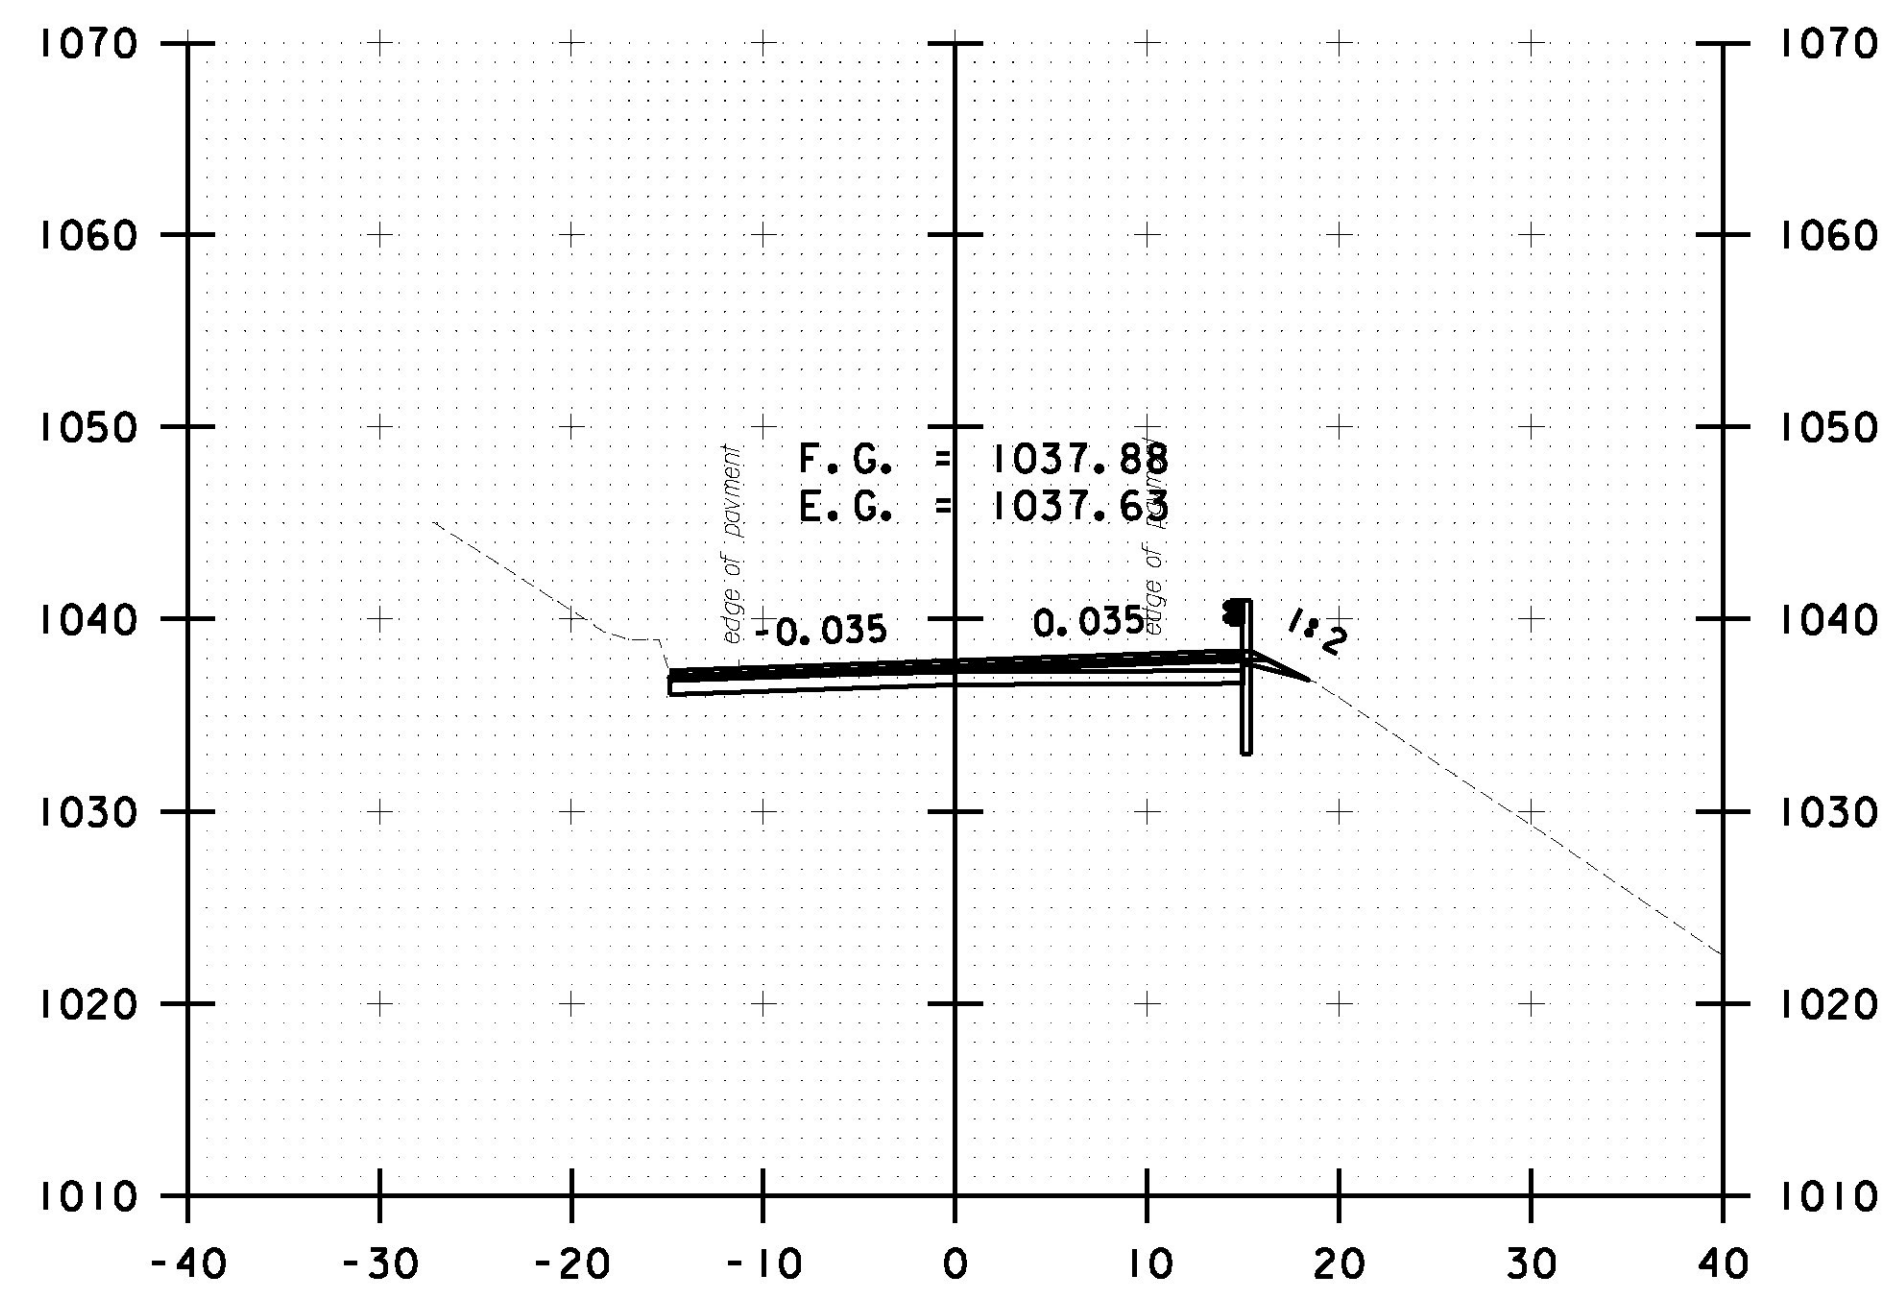


C 7+04.54

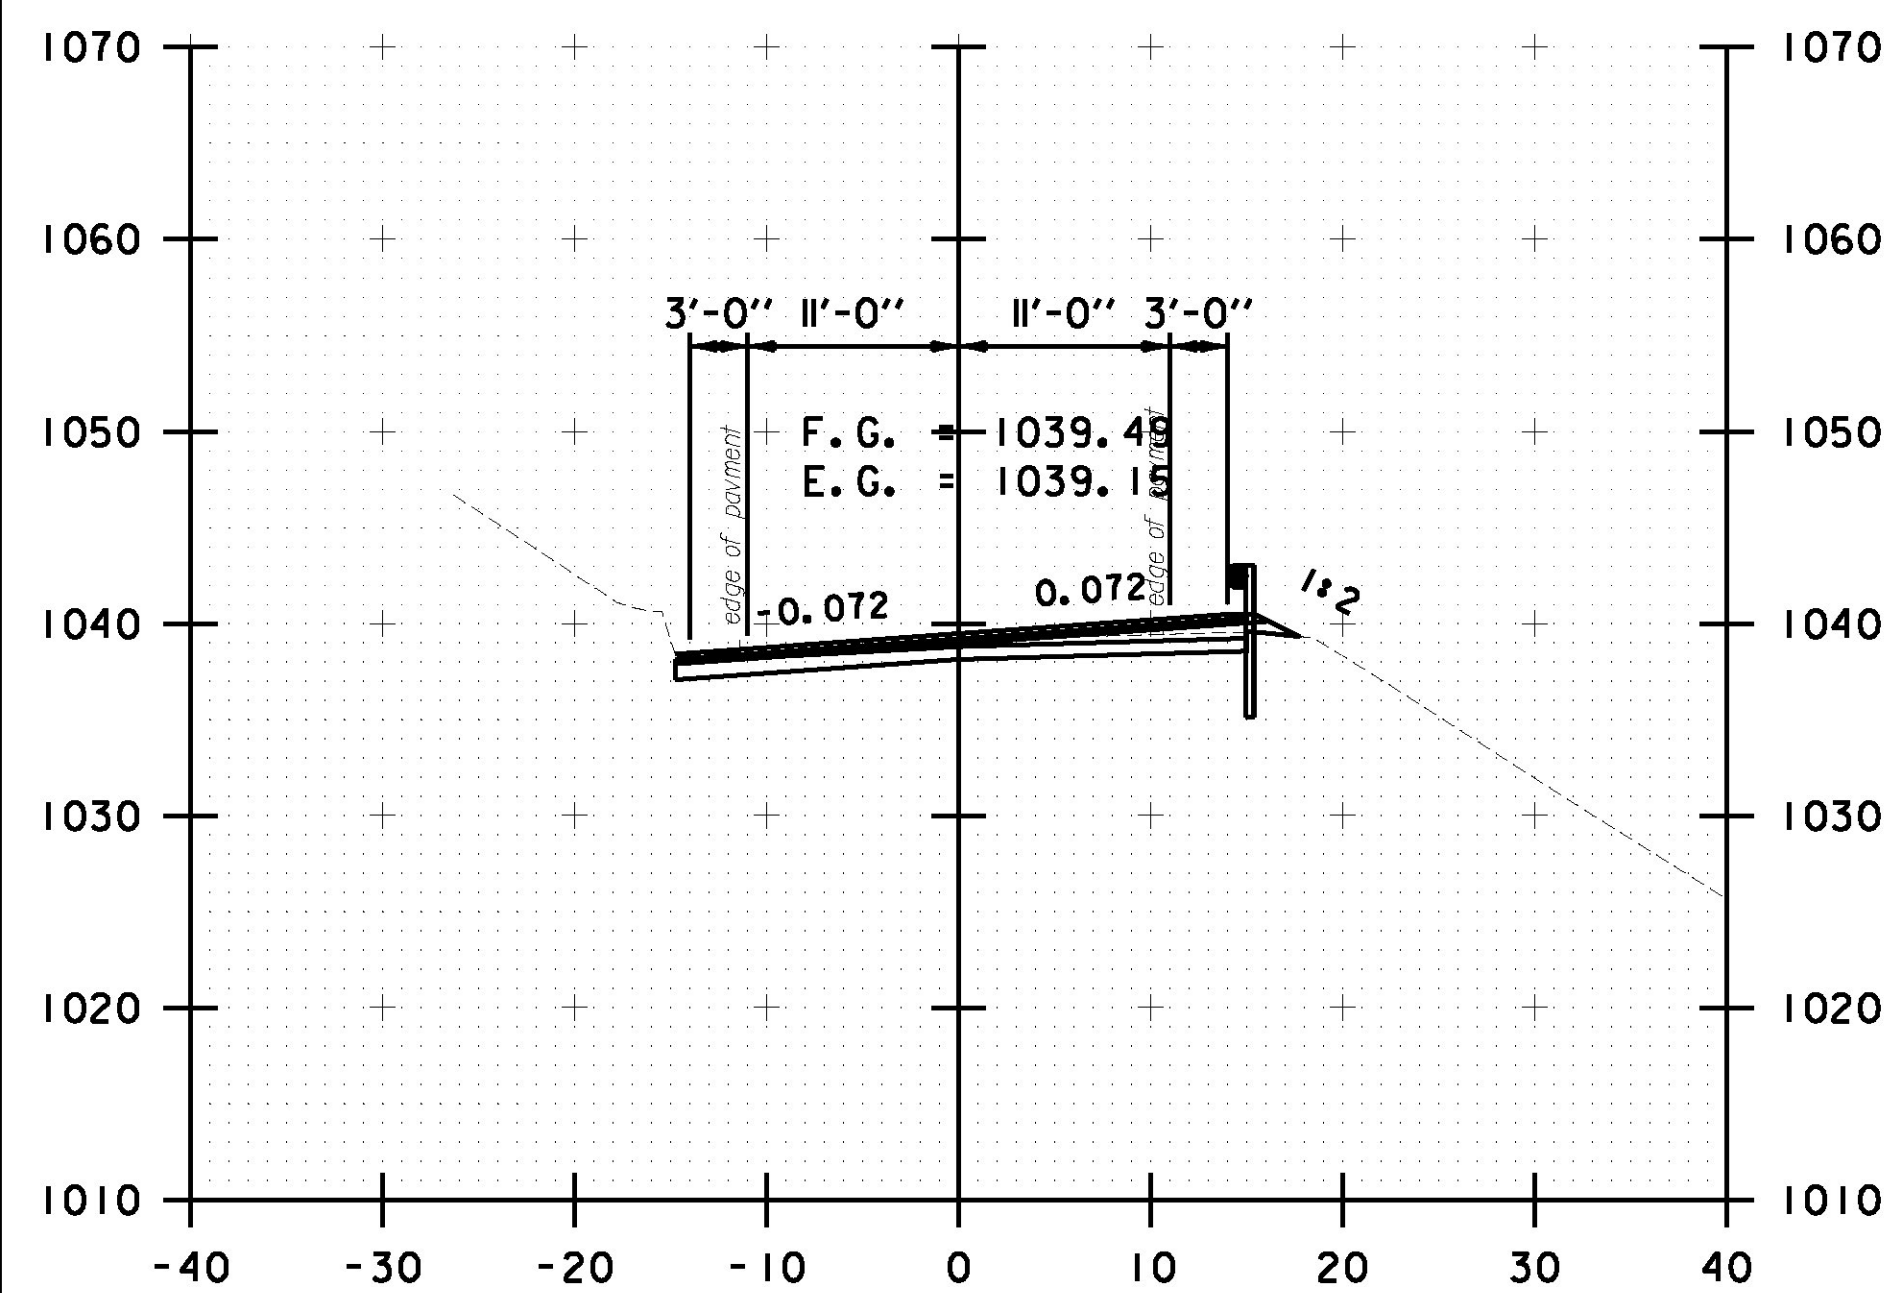

C 6+00.00

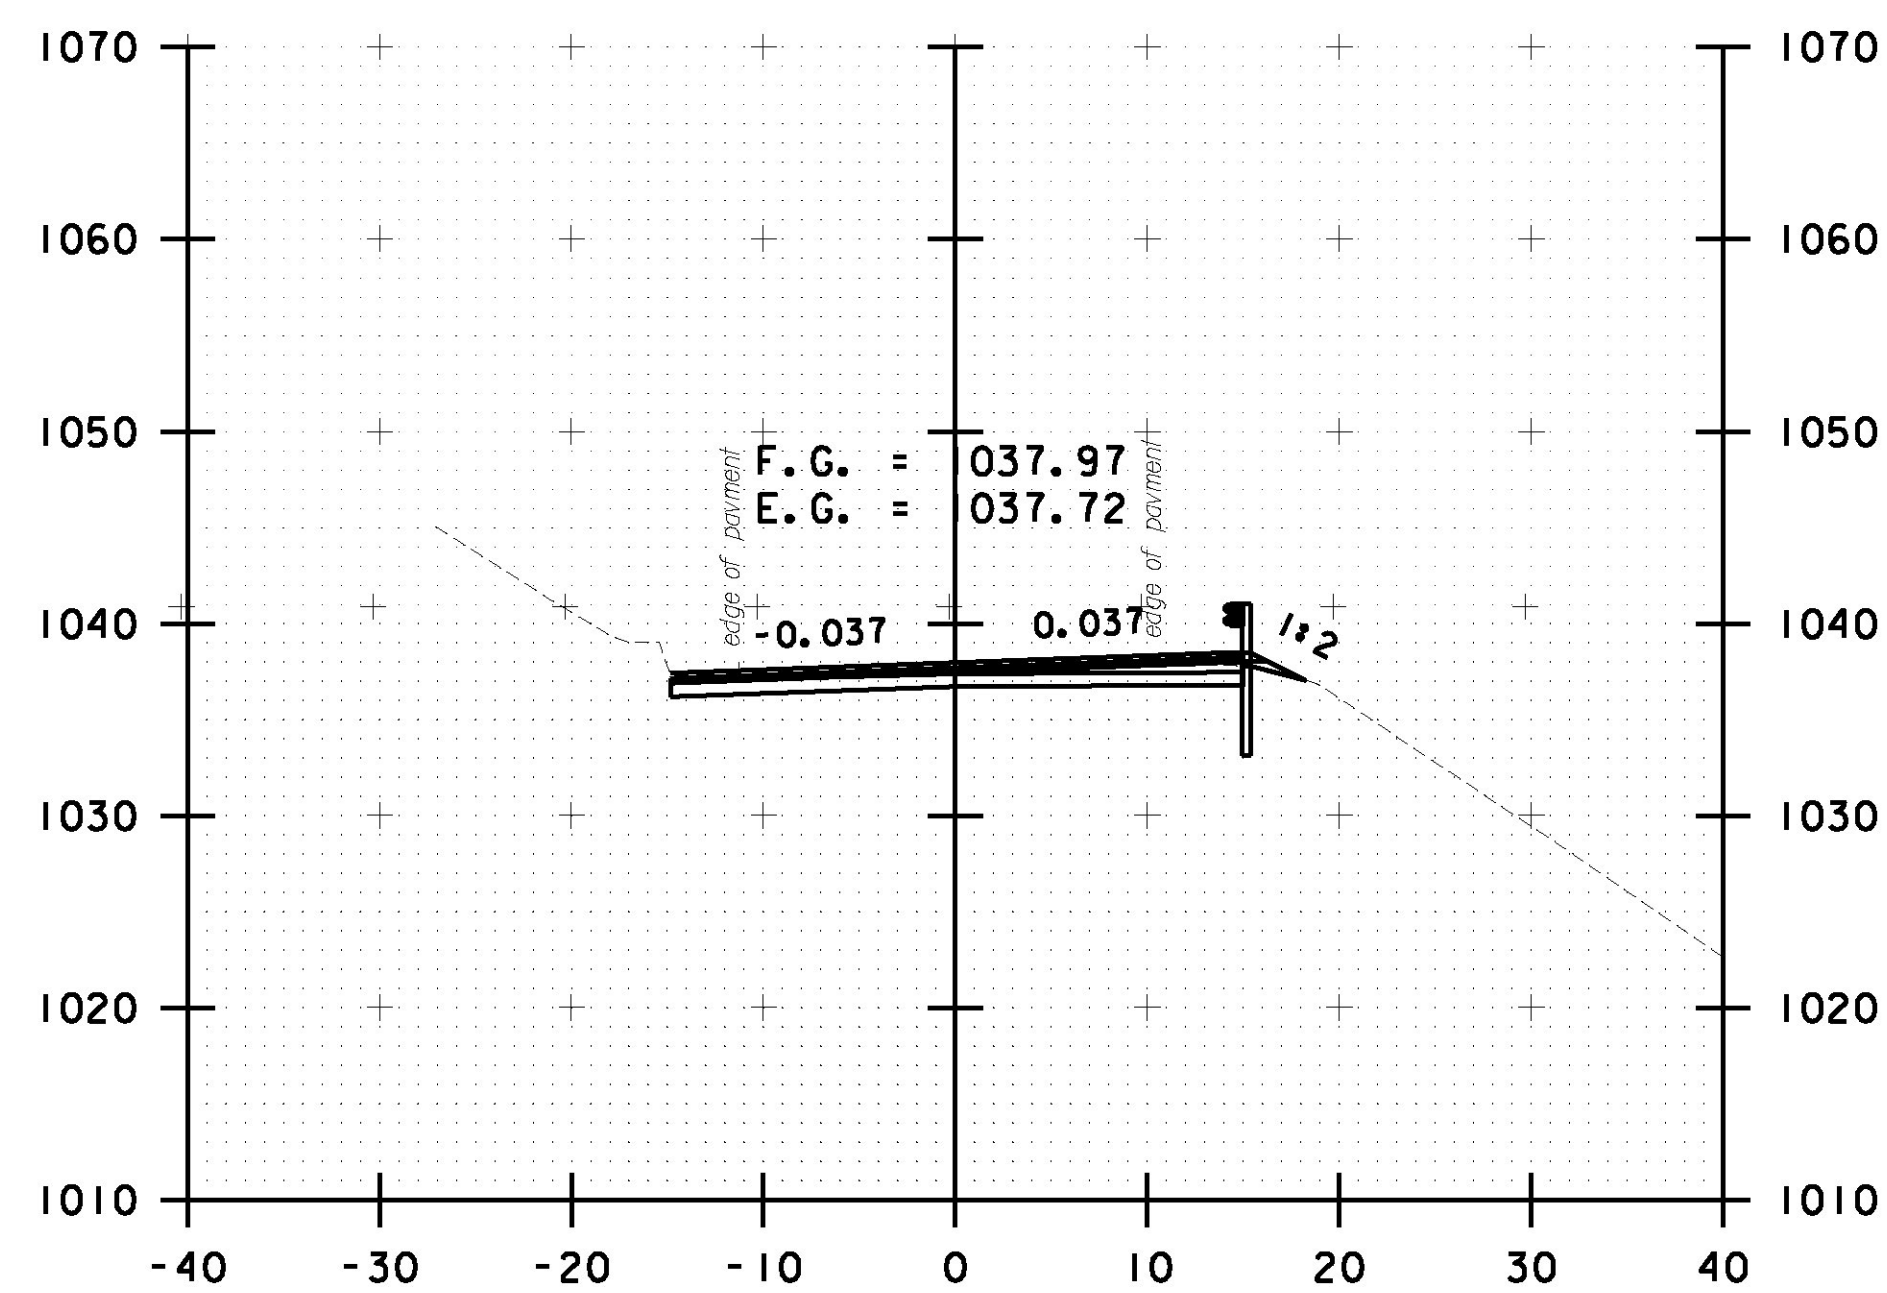

C 7+00.00

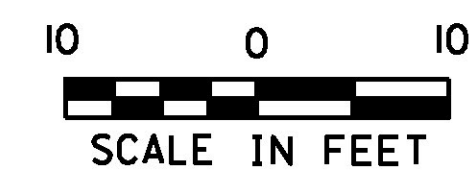

SCALE IN FEET



PROJECT NAME: ROCHESTER	
PROJECT NUMBER: ER STP 0162(21)	
FILE NAME: z13cl76xc.dgn	PLOT DATE: 1/12/2017
PROJECT LEADER: D. GOZALKOWSKI	DRAWN BY: J. HEALD
DESIGNED BY: J. OLSEN	CHECKED BY: J. SHIELDS
CHITTENDEN CROSS SECTION SHEET *3	SHEET 276 OF 360