




R 258+50.00

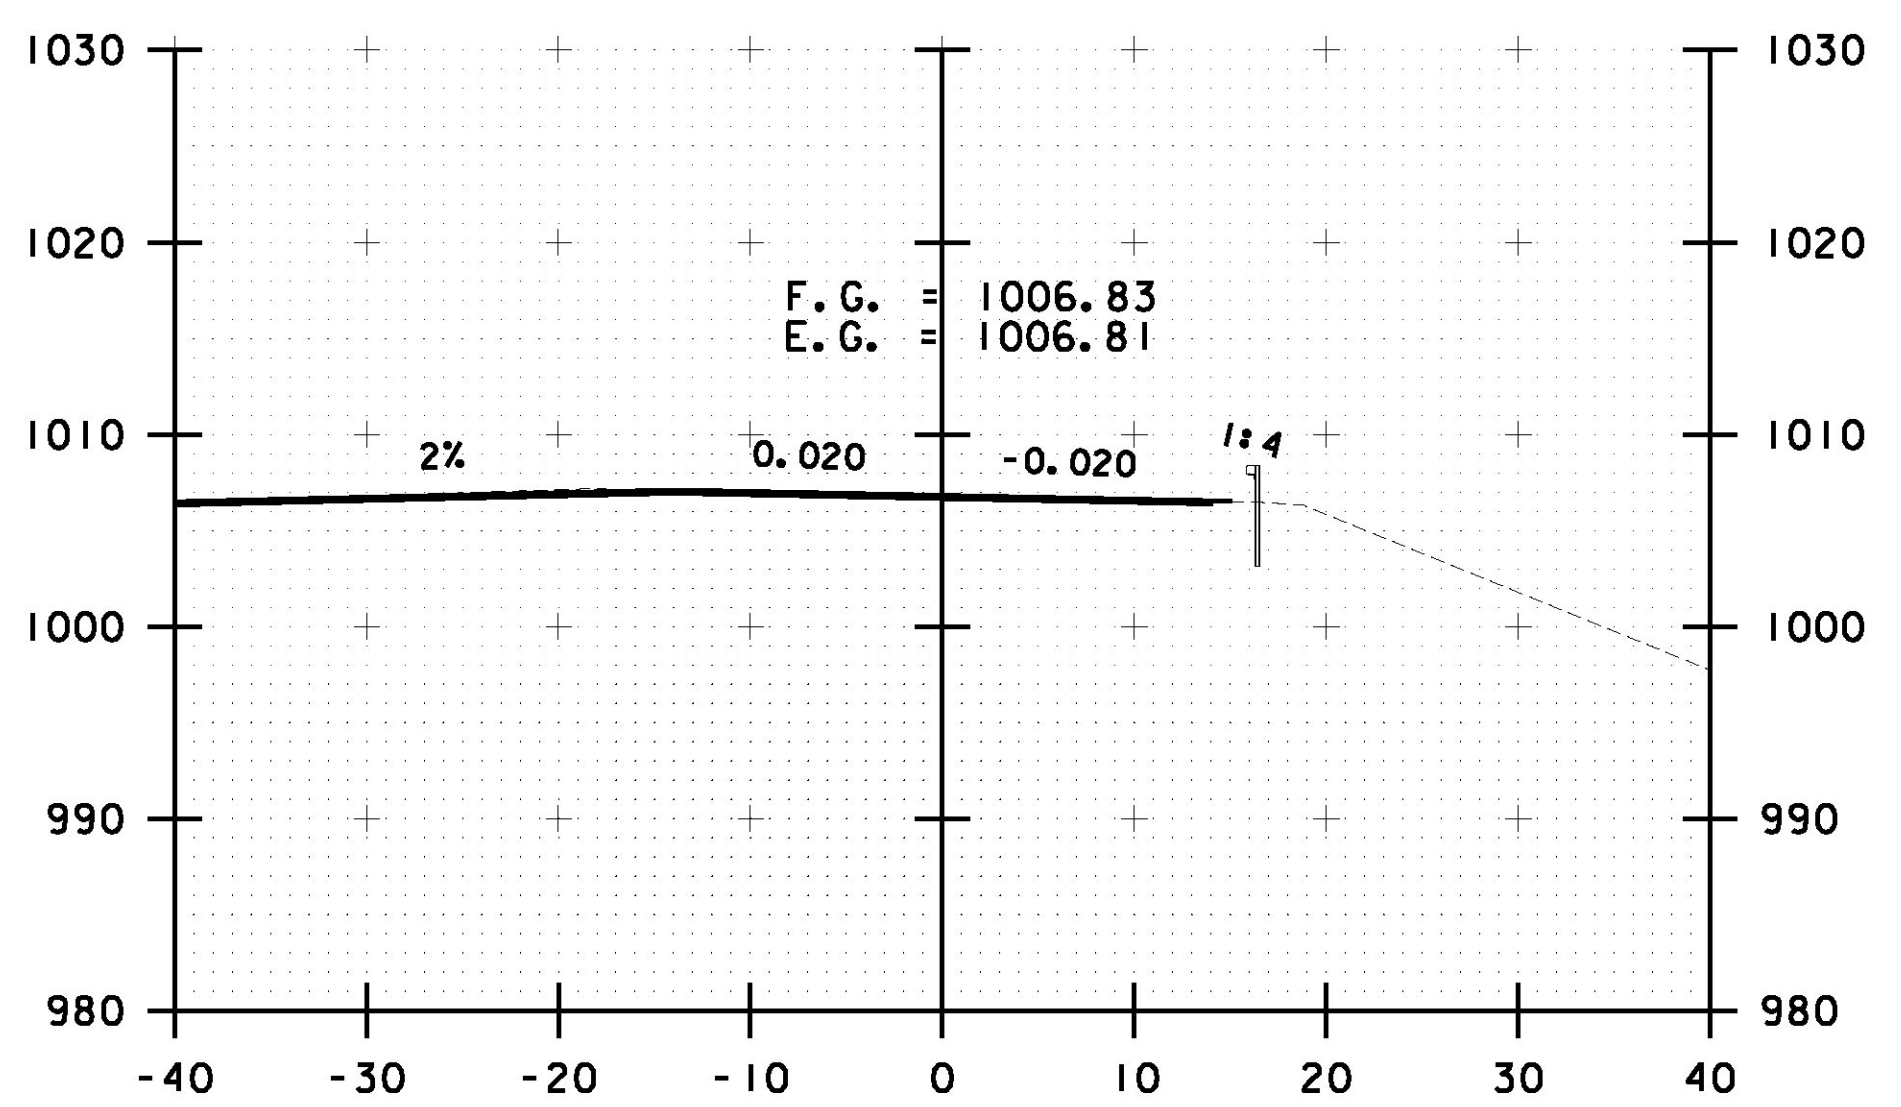


R 259+50.00

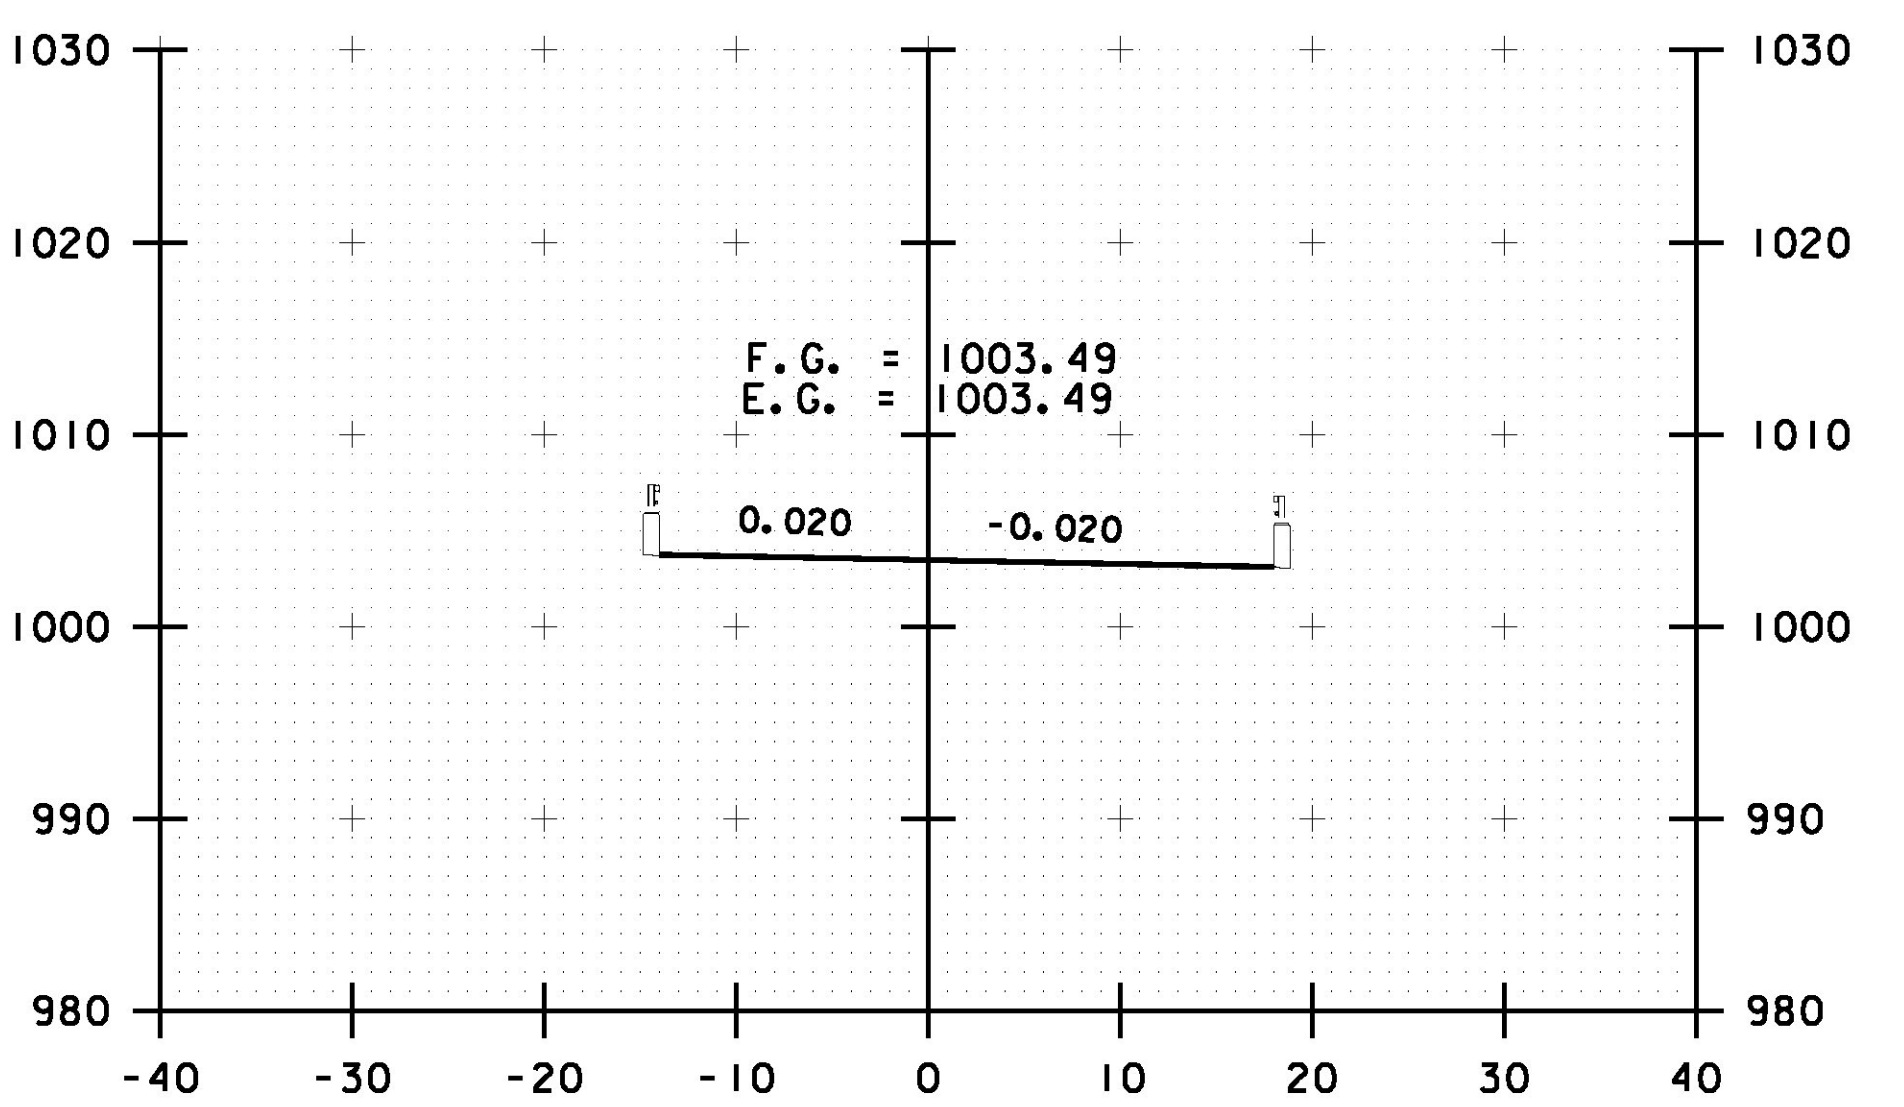


R 260+50.00

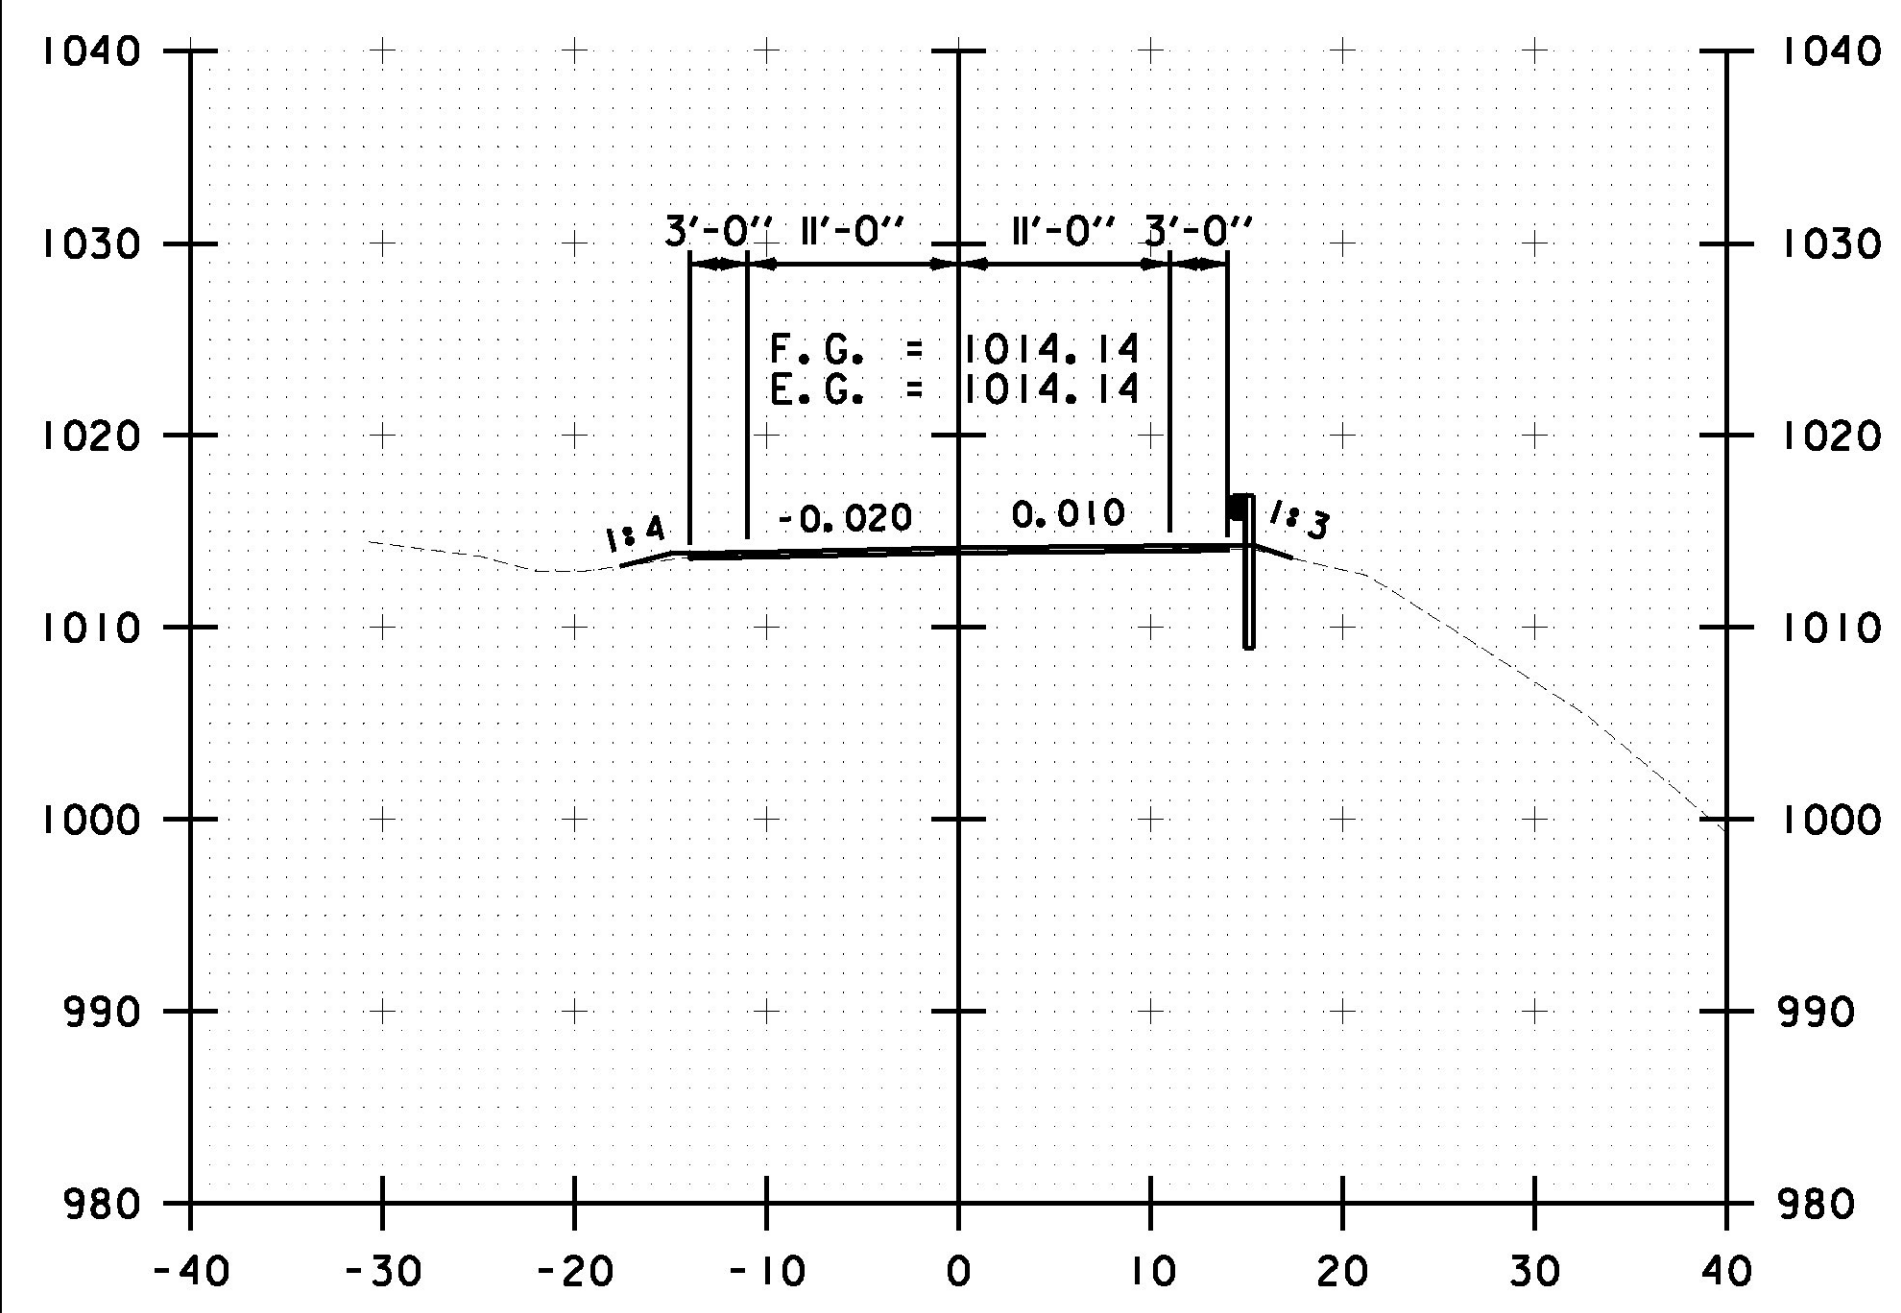


R 258+00.00

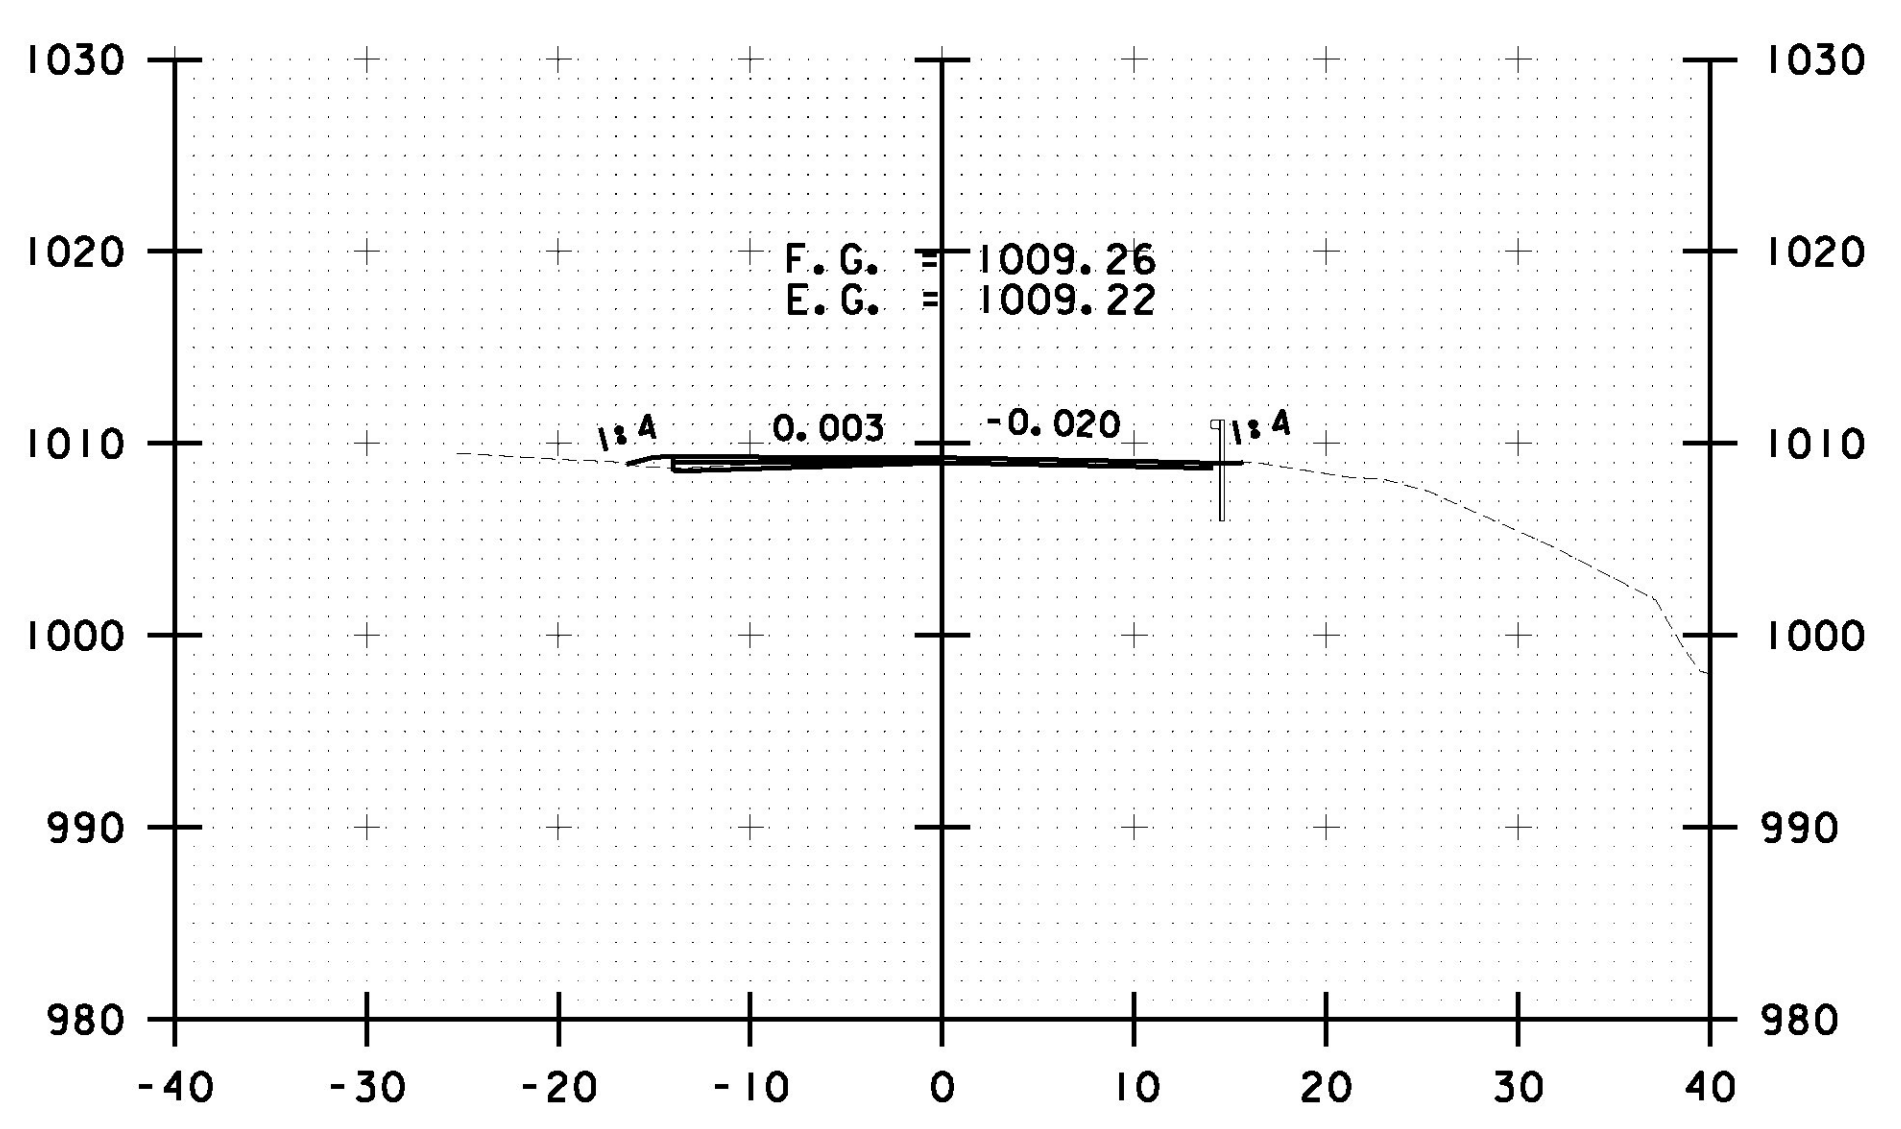

R 259+00.00

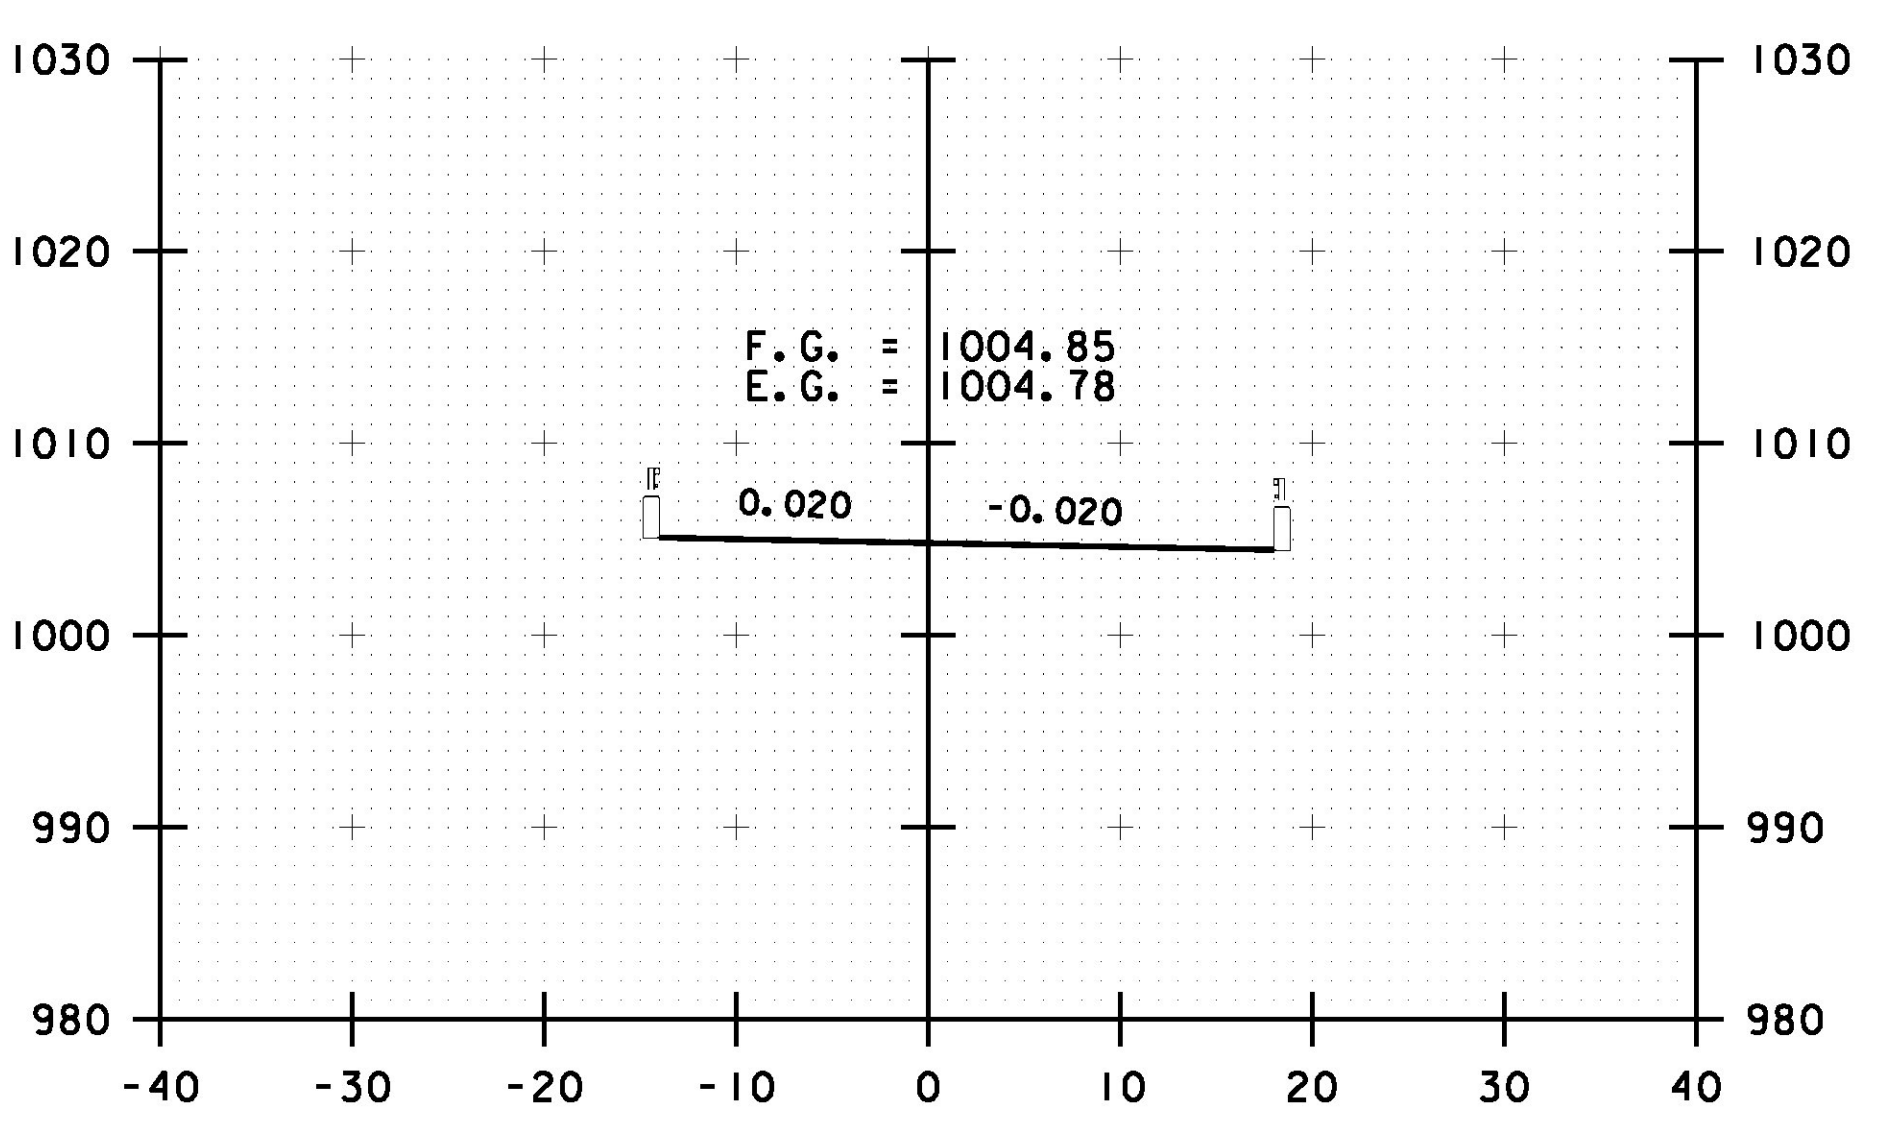

R 260+00.00
BR 15

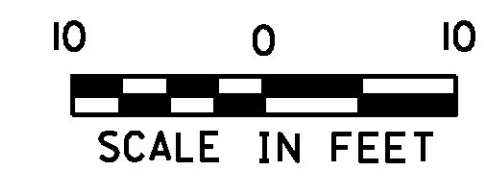

PROJECT NAME: ROCHESTER	
PROJECT NUMBER: ER STP 0162(21)	
FILE NAME: z13cl76xc.dgn	PLOT DATE: 1/12/2017
PROJECT LEADER: D. GOZALKOWSKI	DRAWN BY: J. HEALD
DESIGNED BY: J. OLSEN	CHECKED BY: J. SHIELDS
ROCHESTER CROSS SECTION SHEET *90	SHEET 279 OF 360