




R 277+00.00

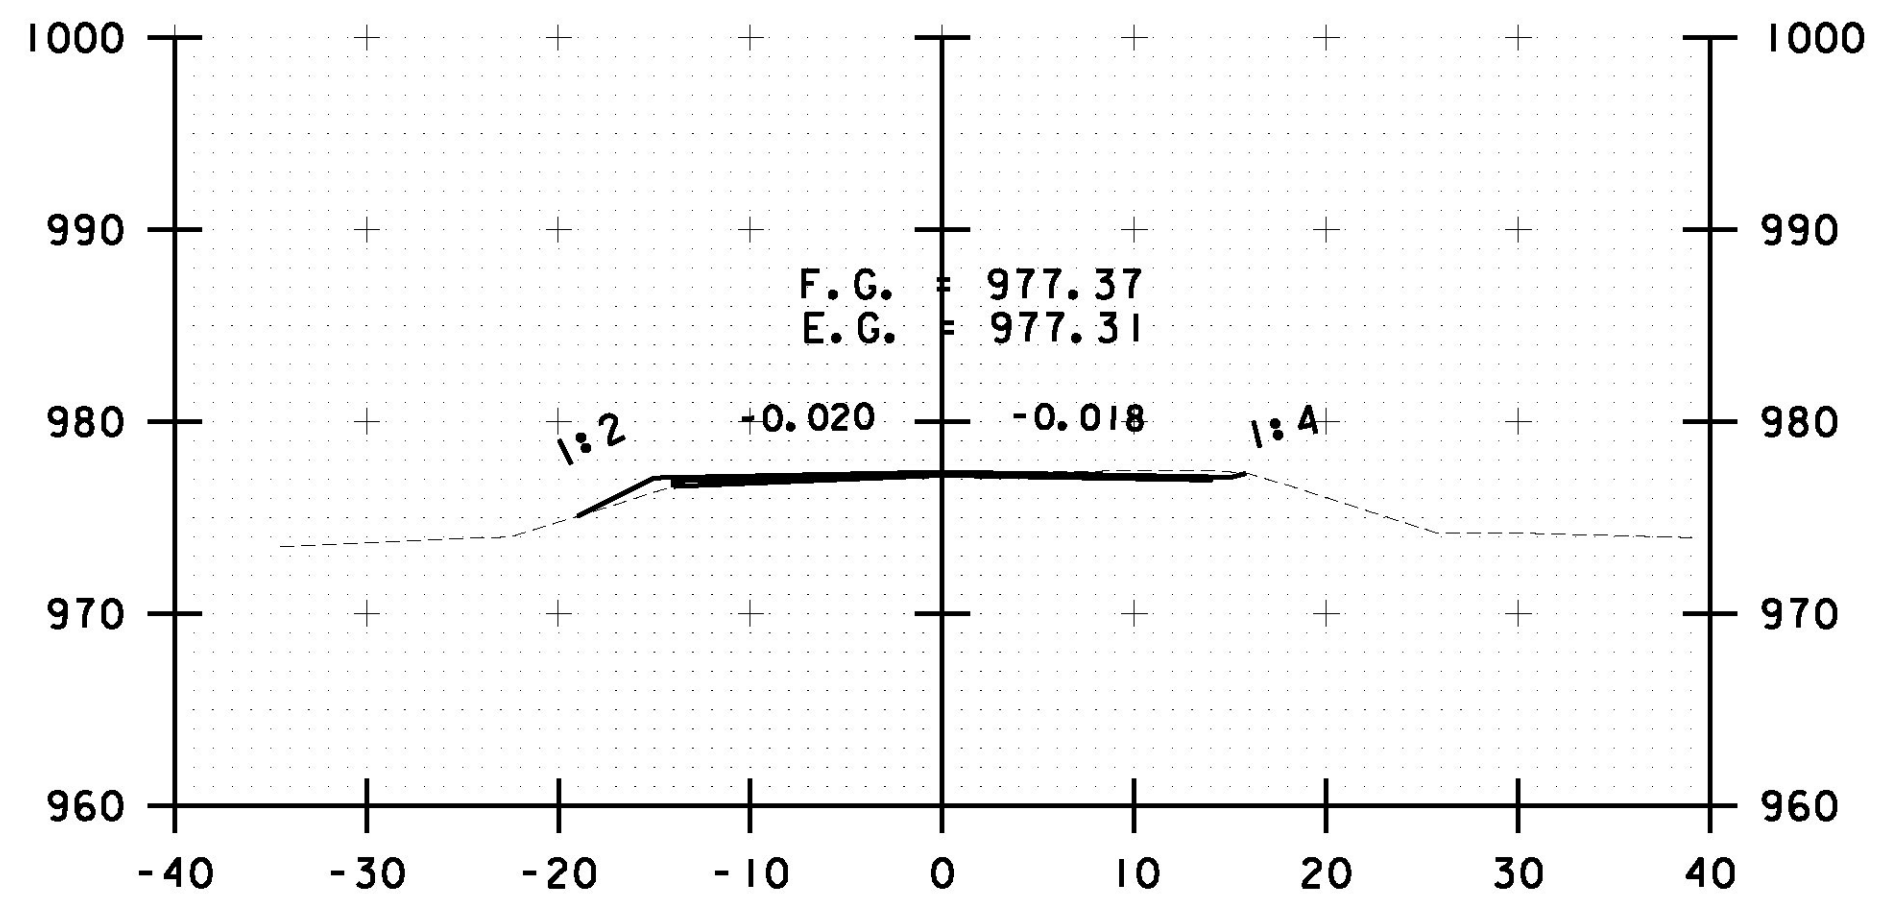


R 278+50.00

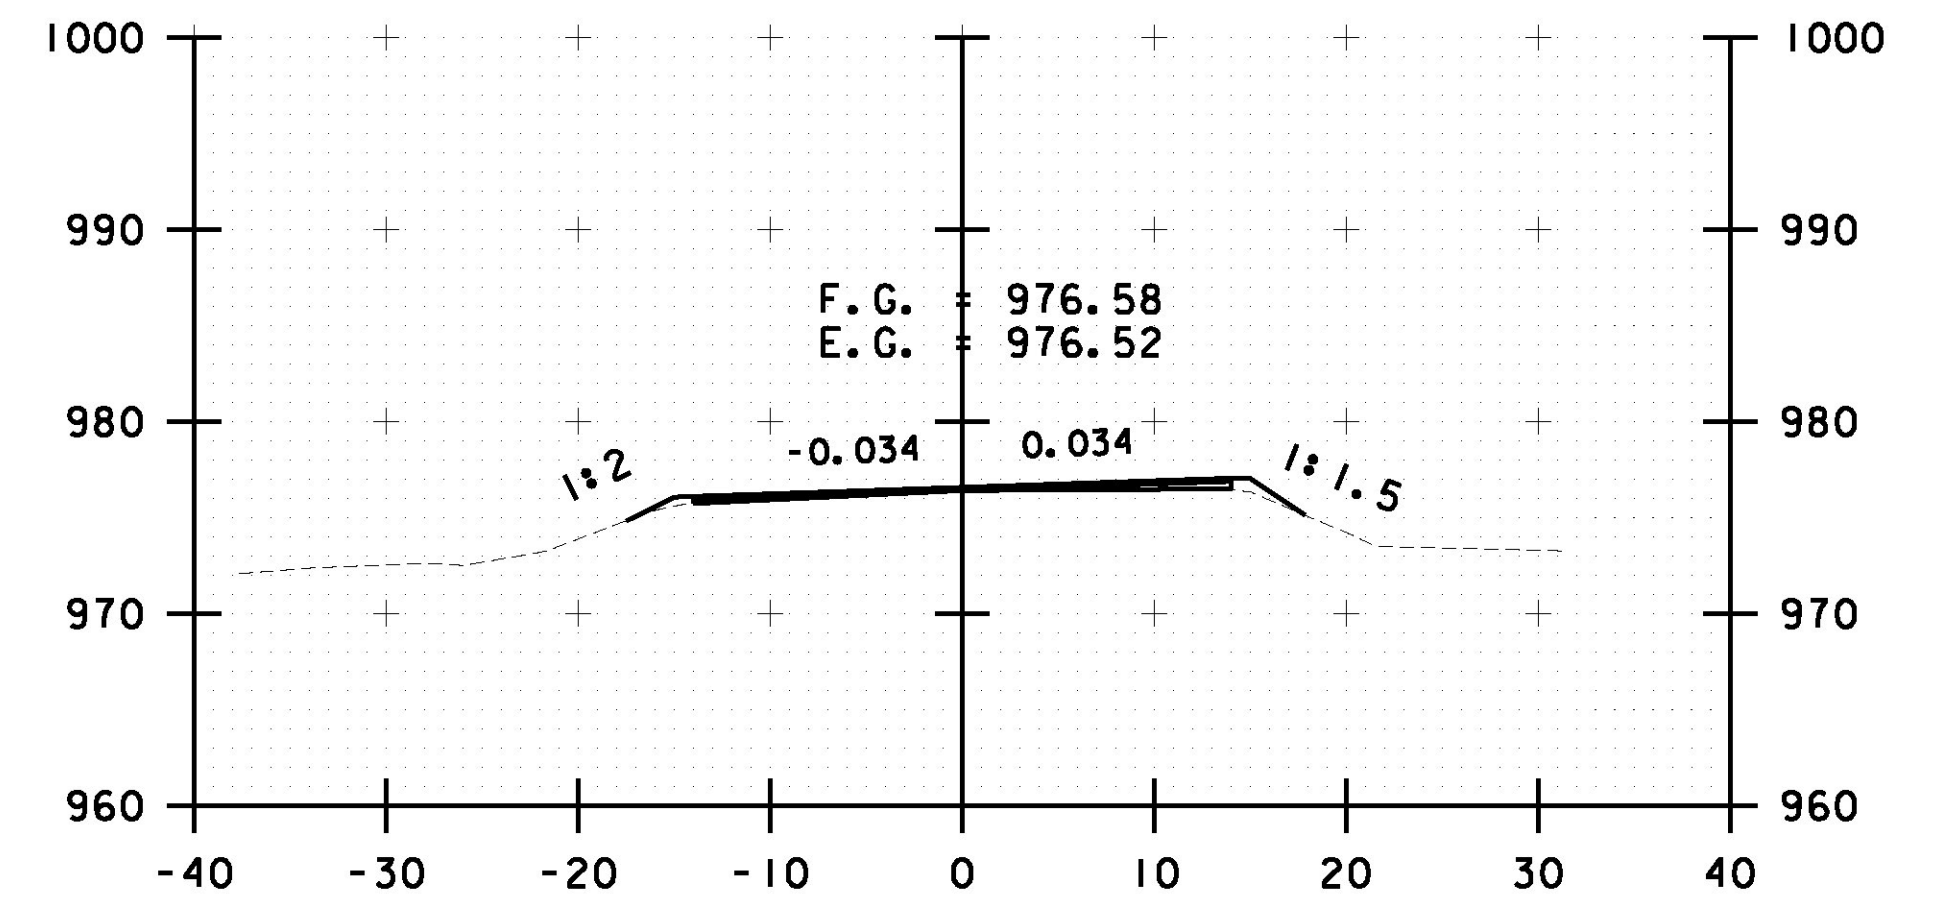


R 280+00.00

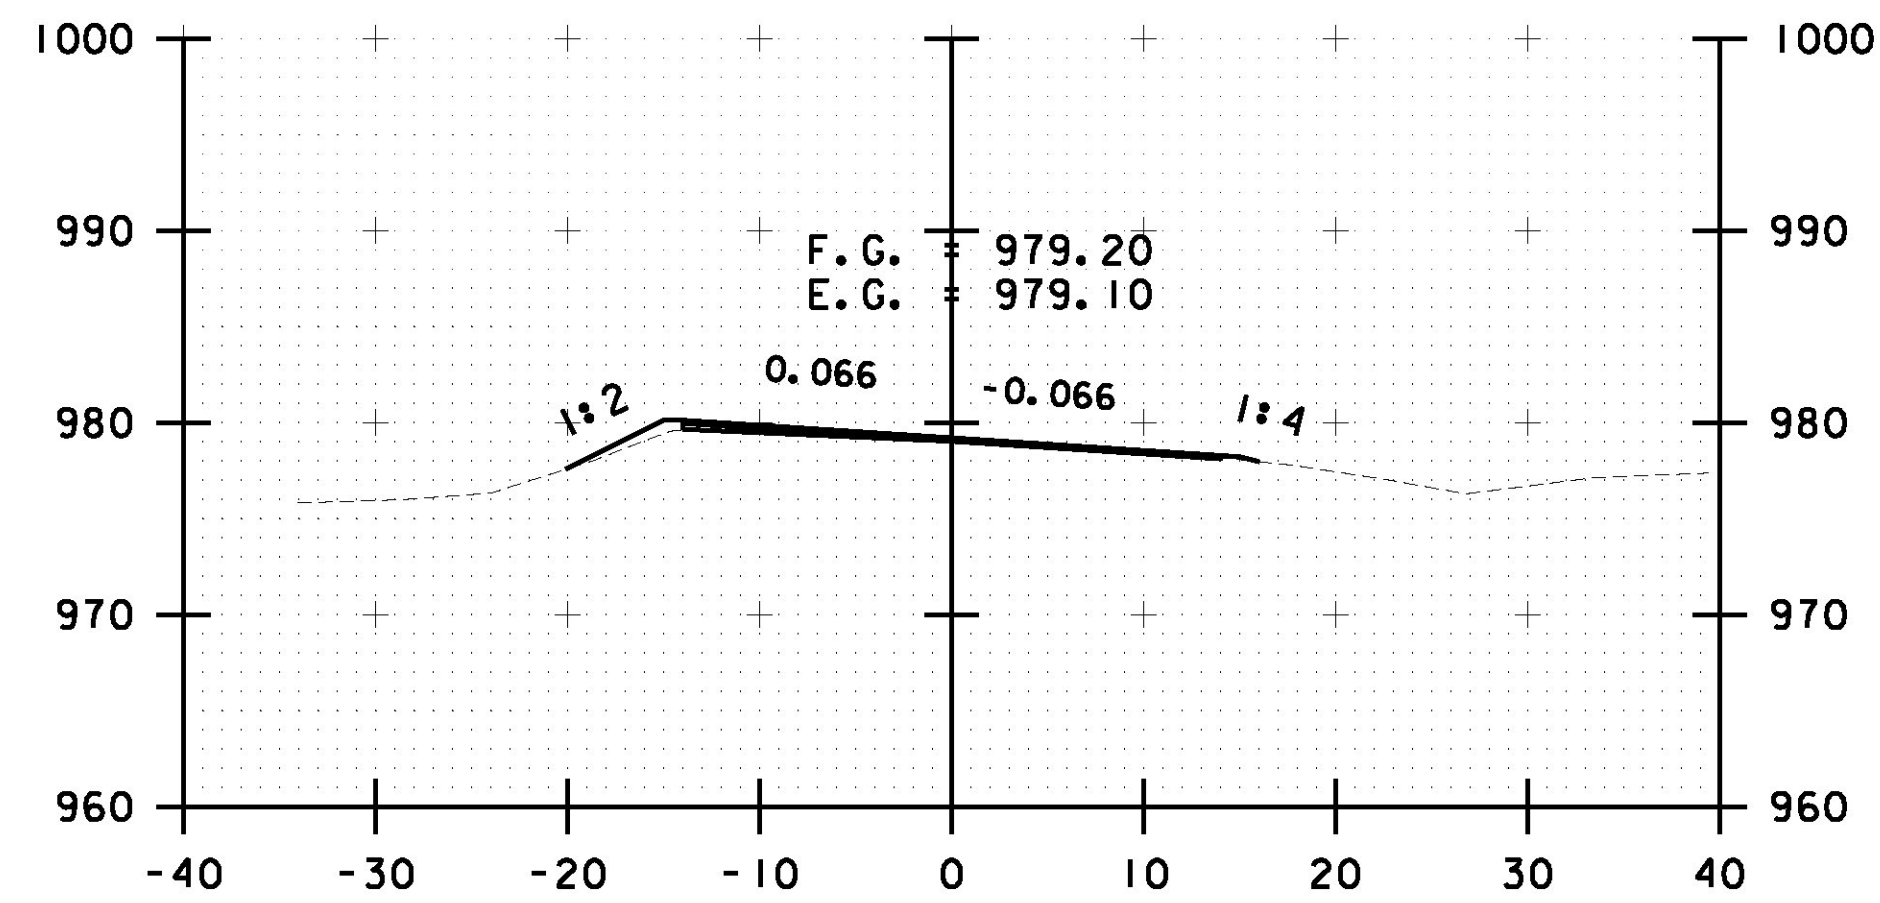


R 276+50.00

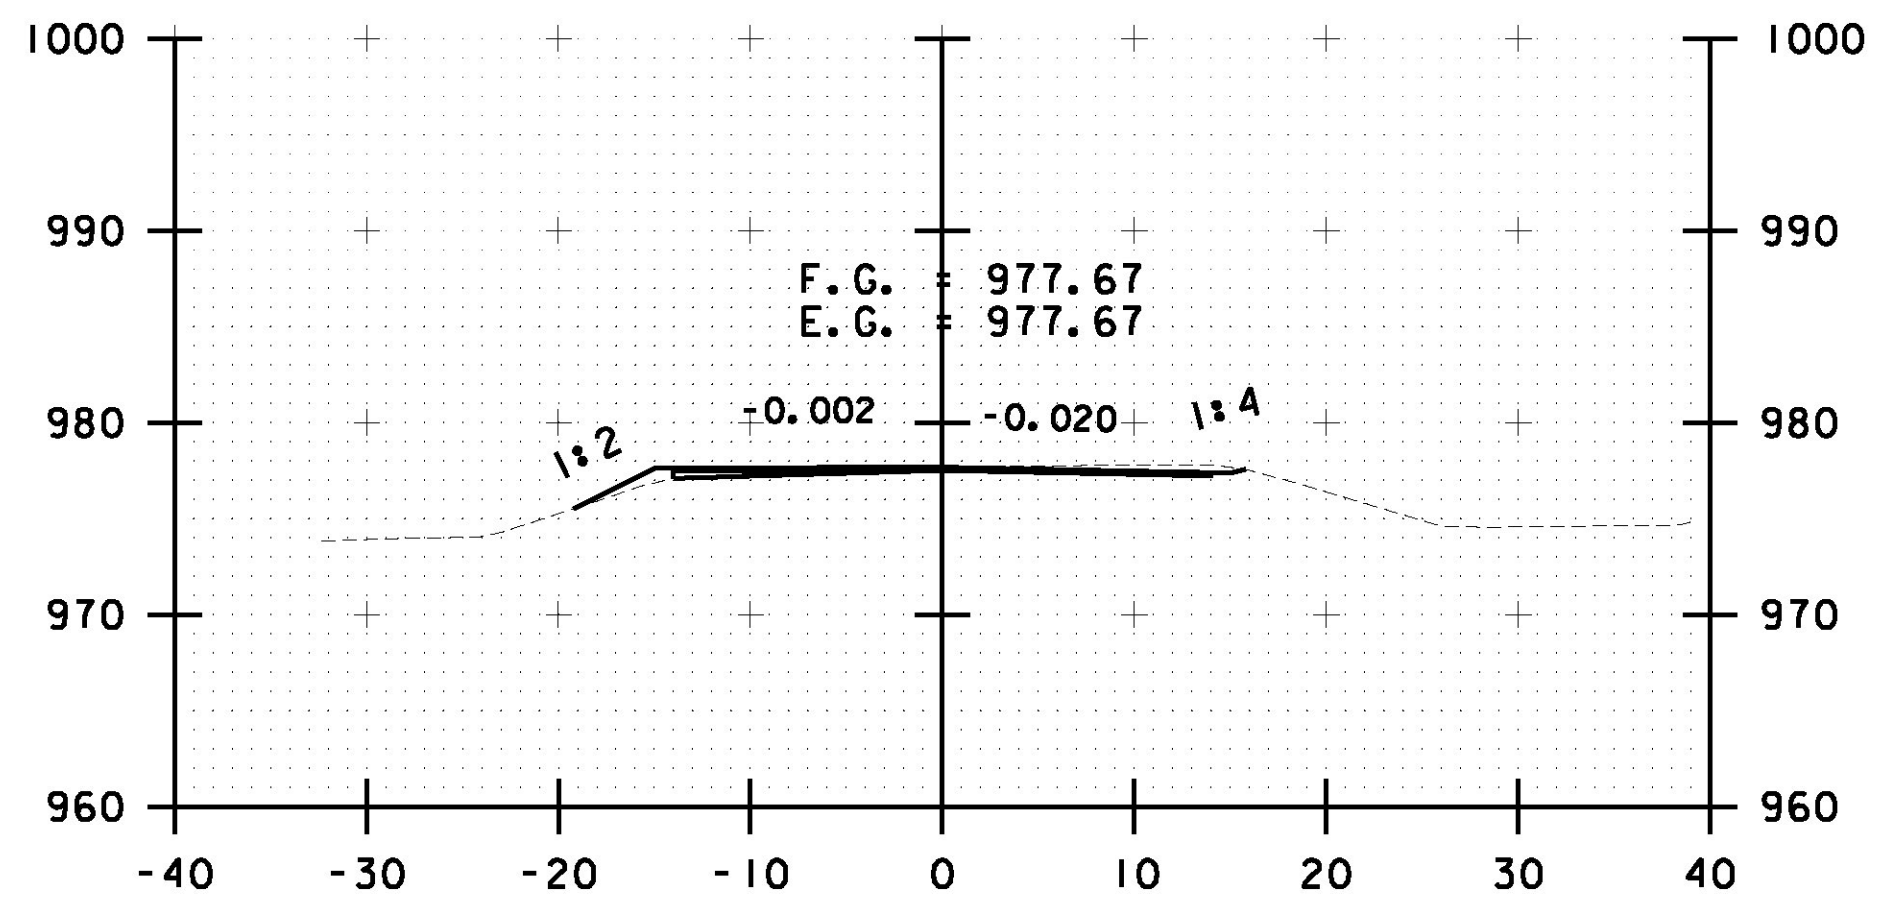


R 278+00.00

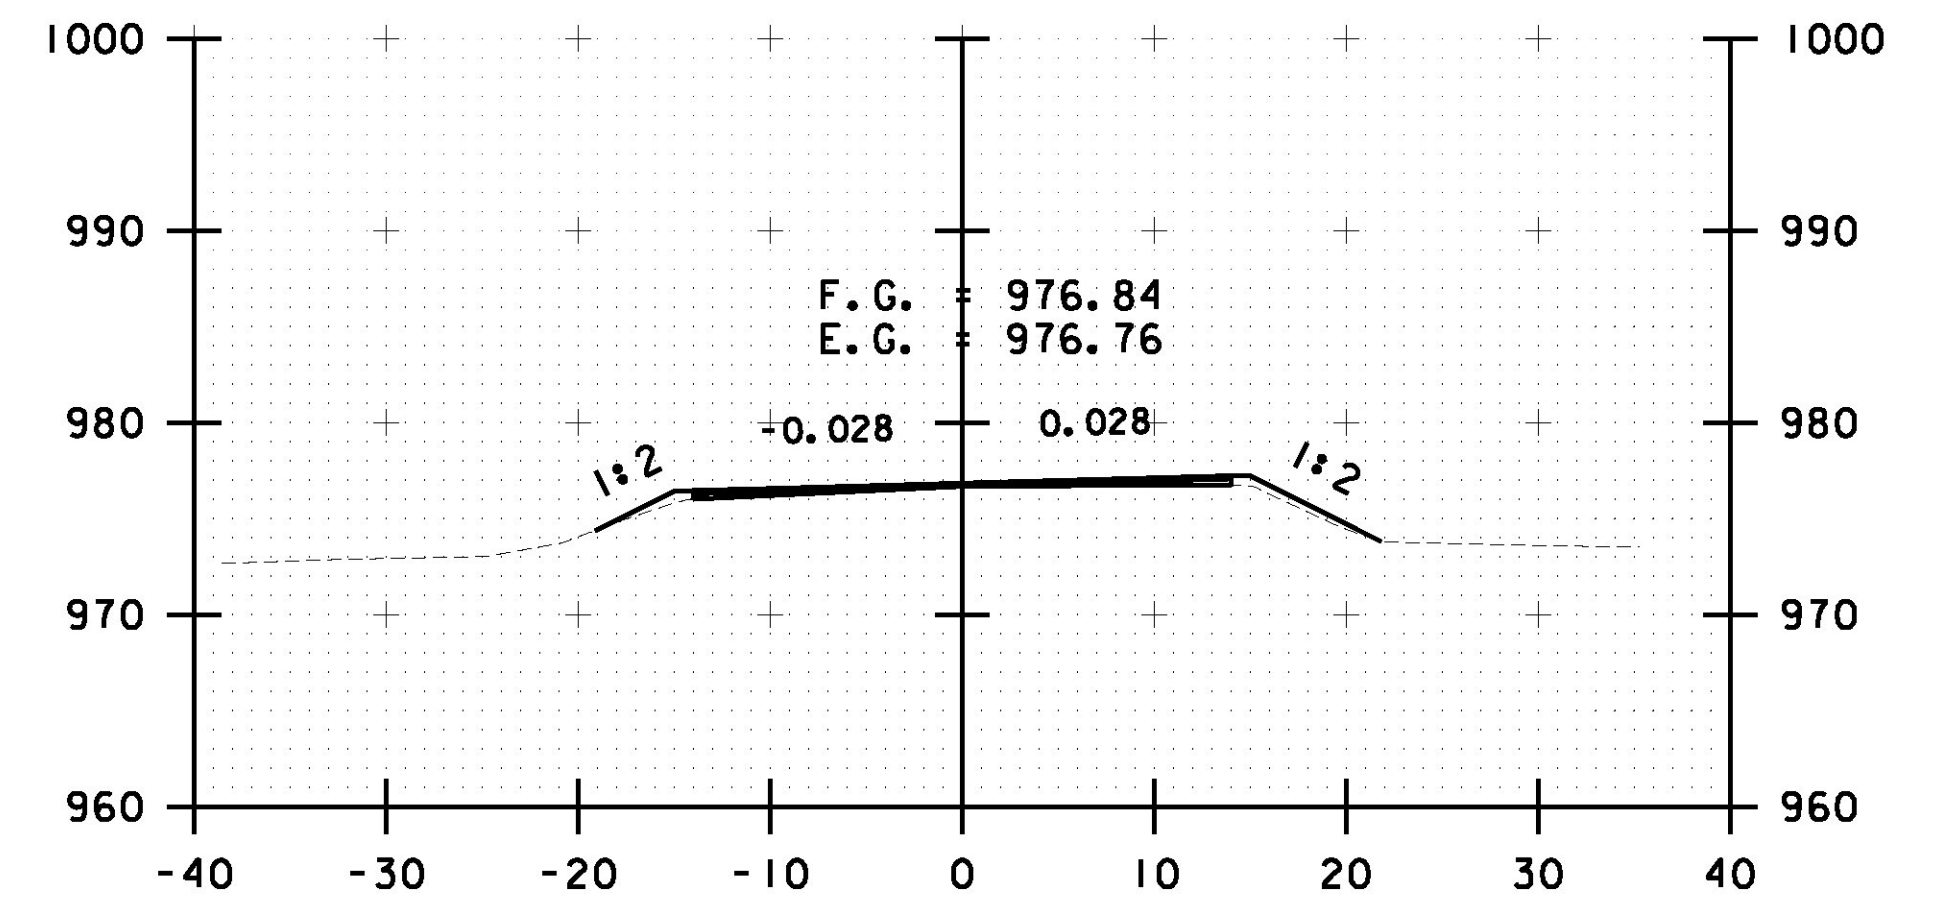


R 279+50.00

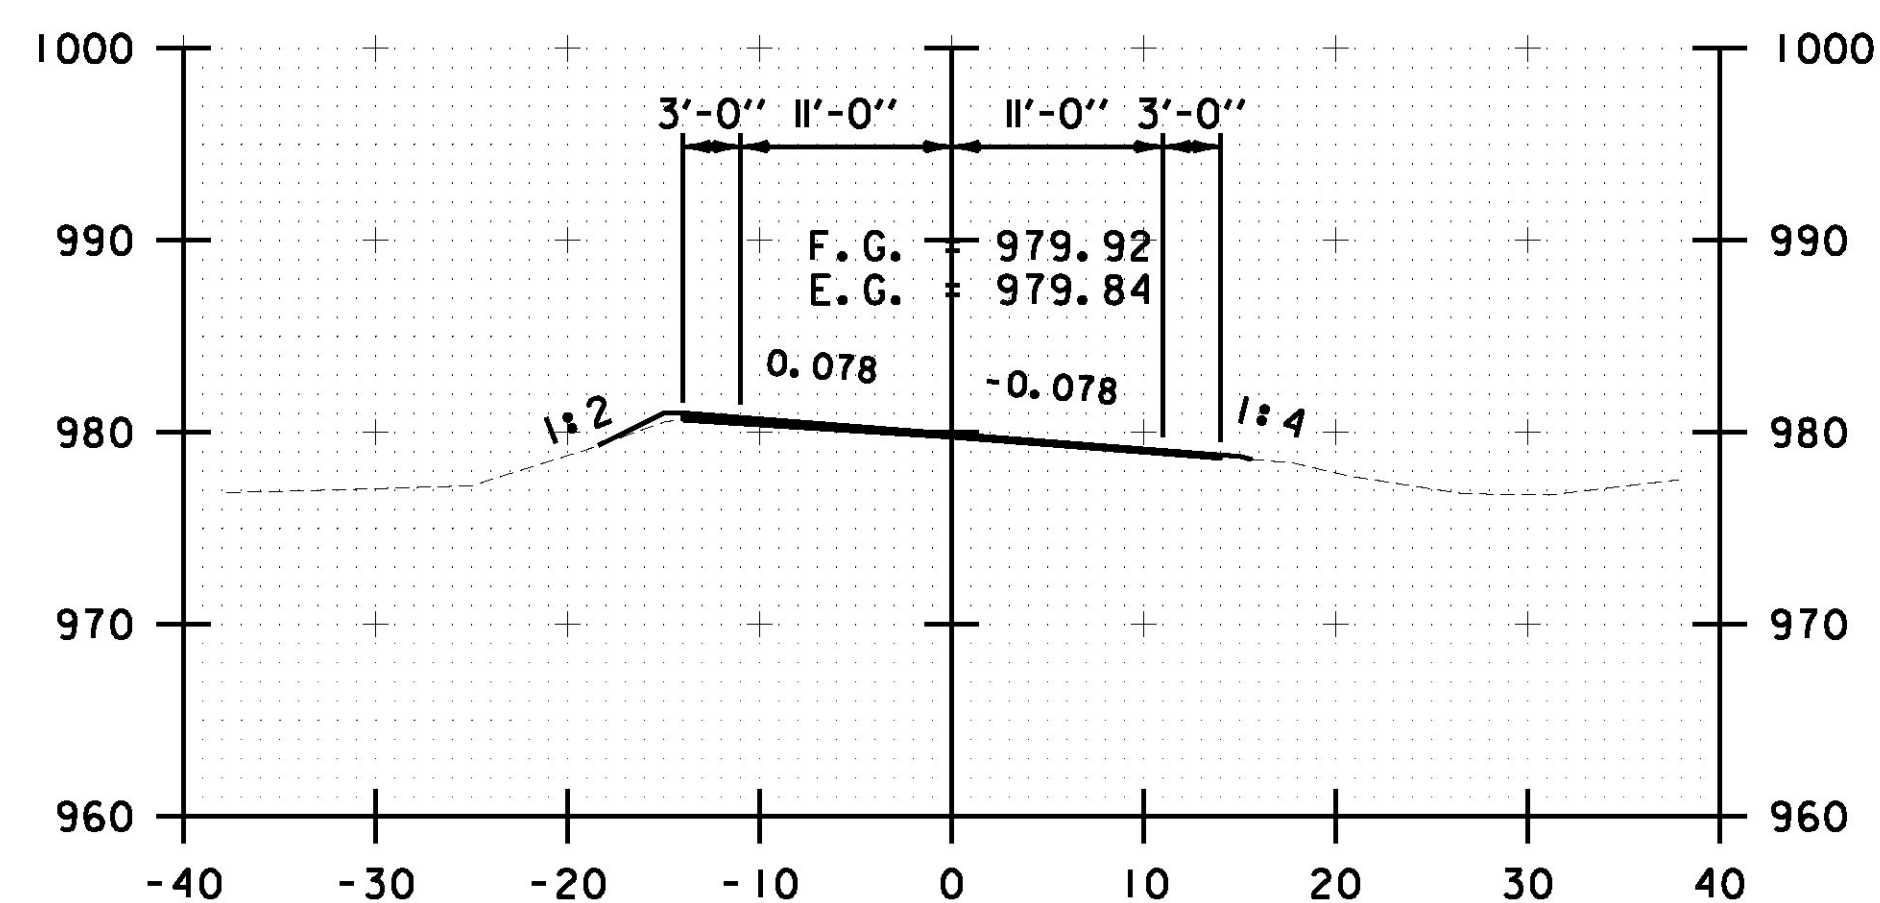


R 276+00.00

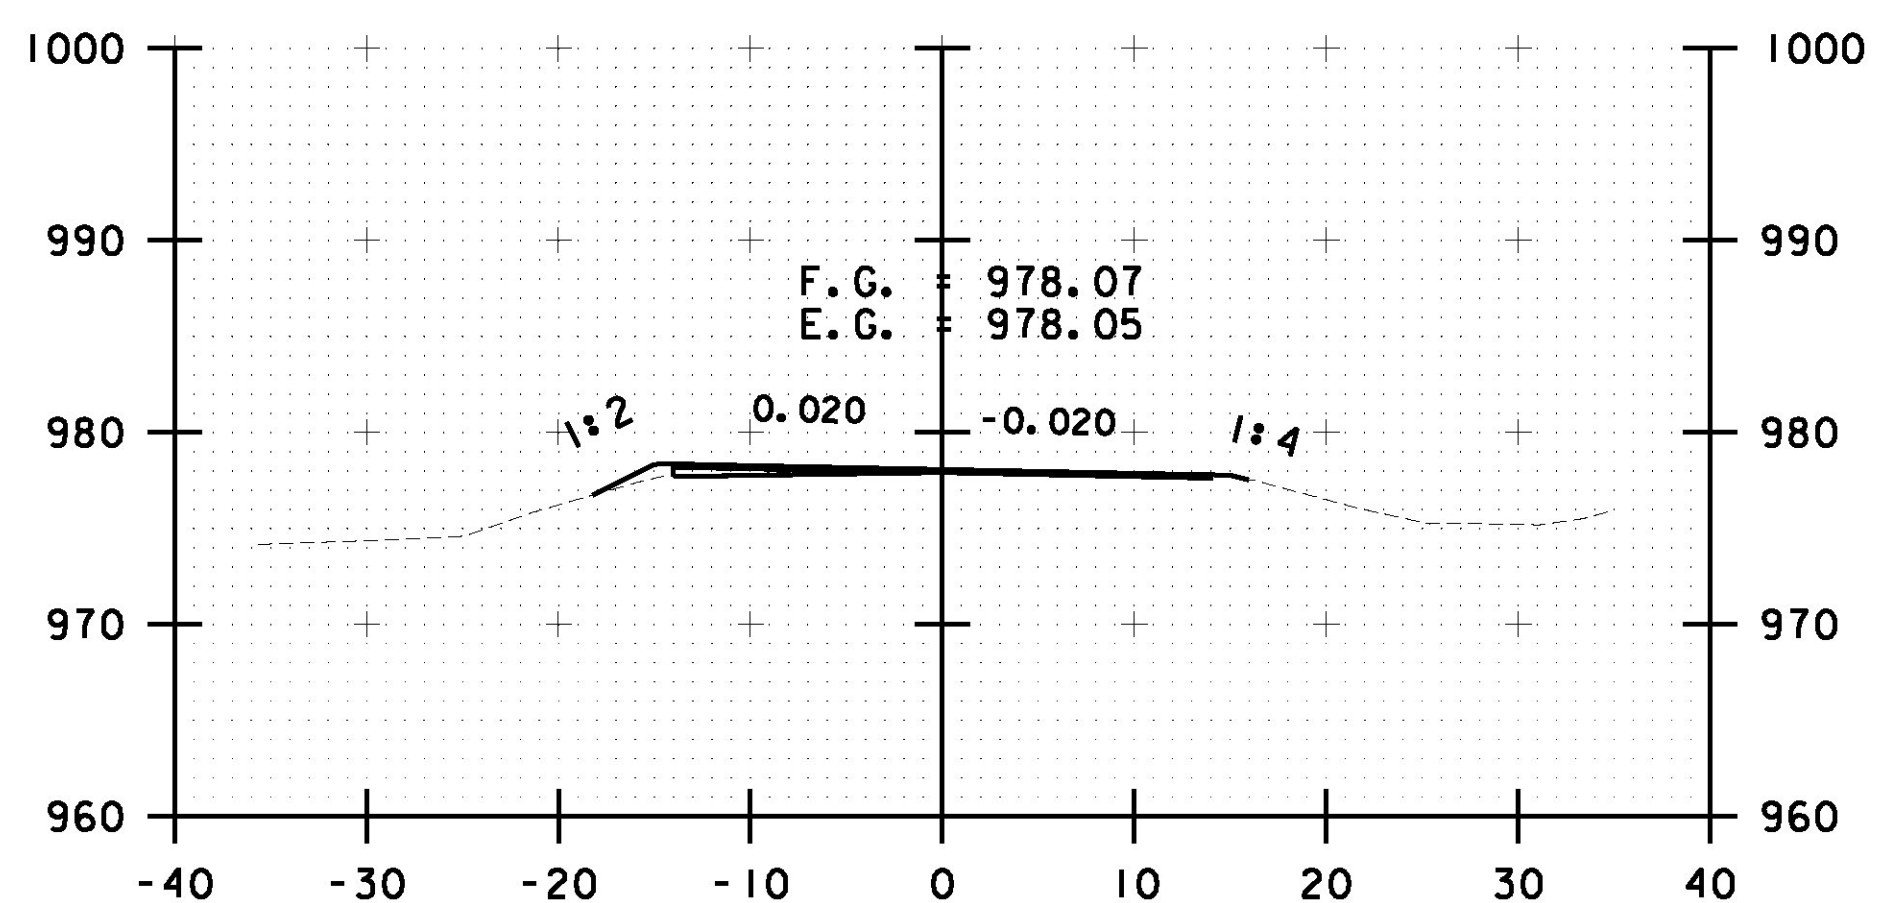

R 277+50.00

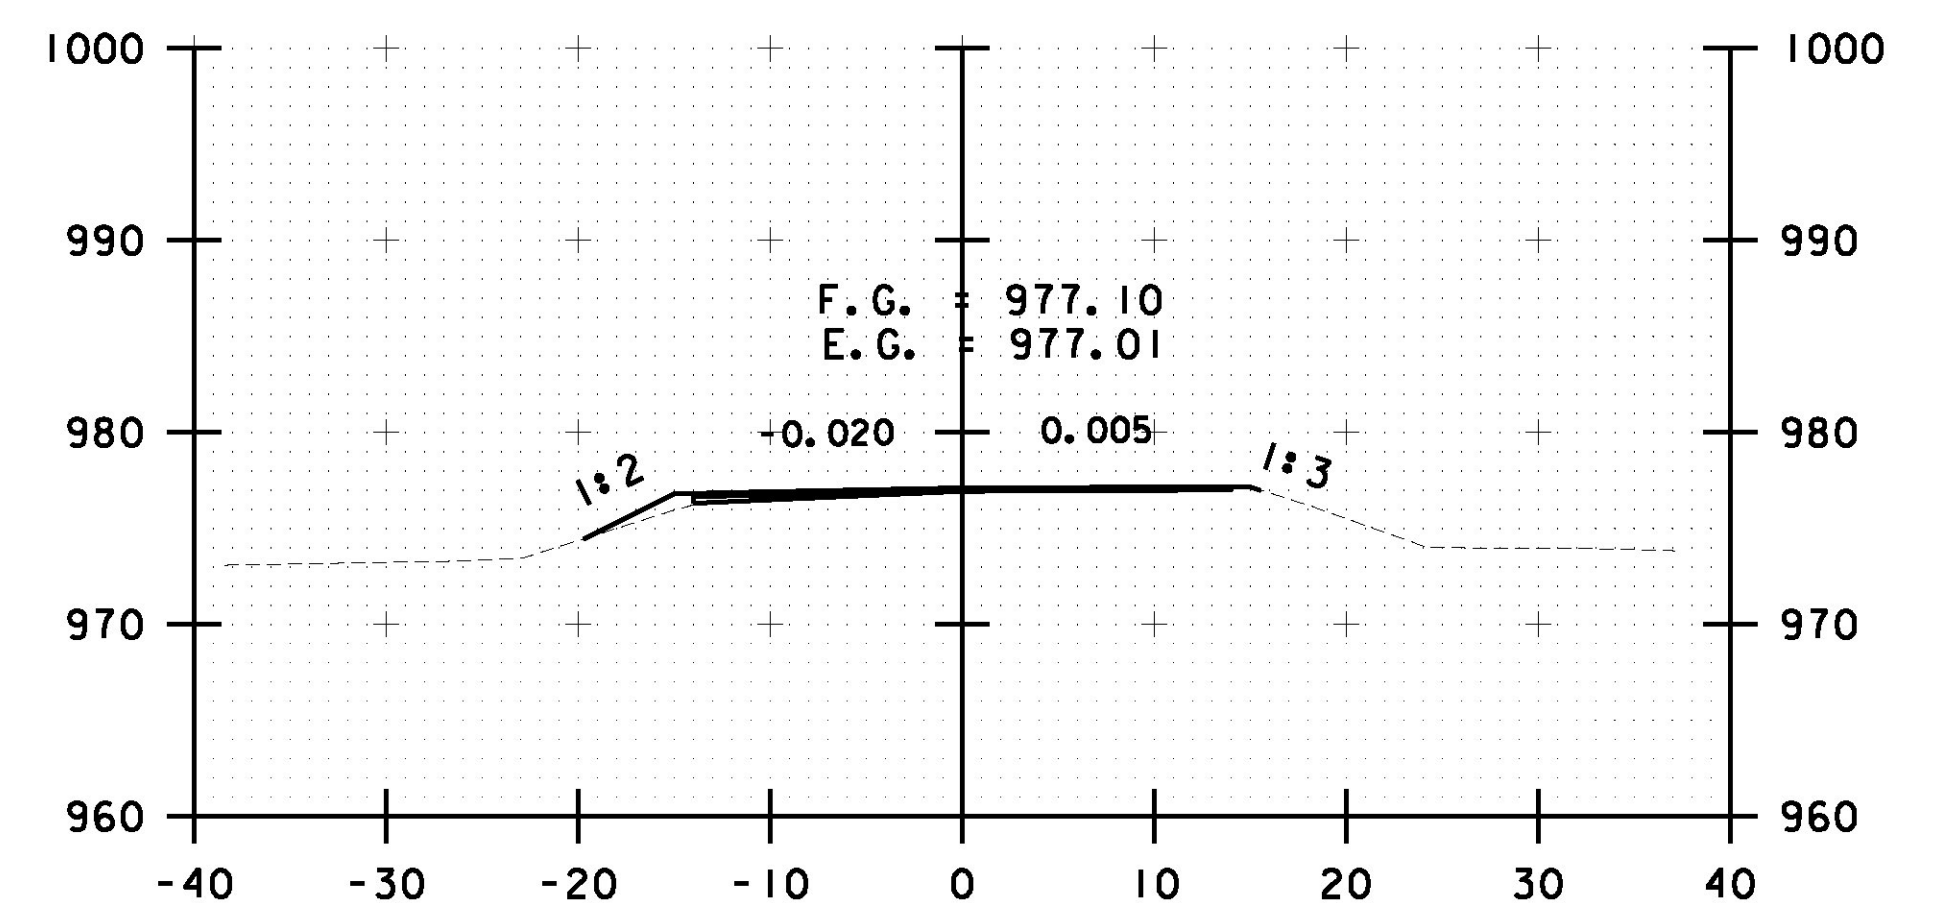

R 279+00.00

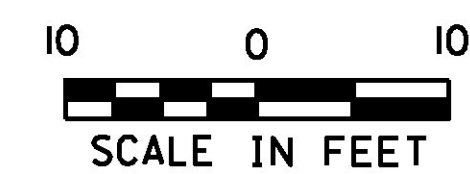

PROJECT NAME: ROCHESTER	
PROJECT NUMBER: ER STP 0162(21)	
FILE NAME: z13cl76xc.dgn	PLOT DATE: 1/12/2017
PROJECT LEADER: D. GOZALKOWSKI	DRAWN BY: J. HEALD
DESIGNED BY: J. OLSEN	CHECKED BY: J. SHIELDS
ROCHESTER CROSS SECTION SHEET *96	SHEET 285 OF 360