




R 289+00.00

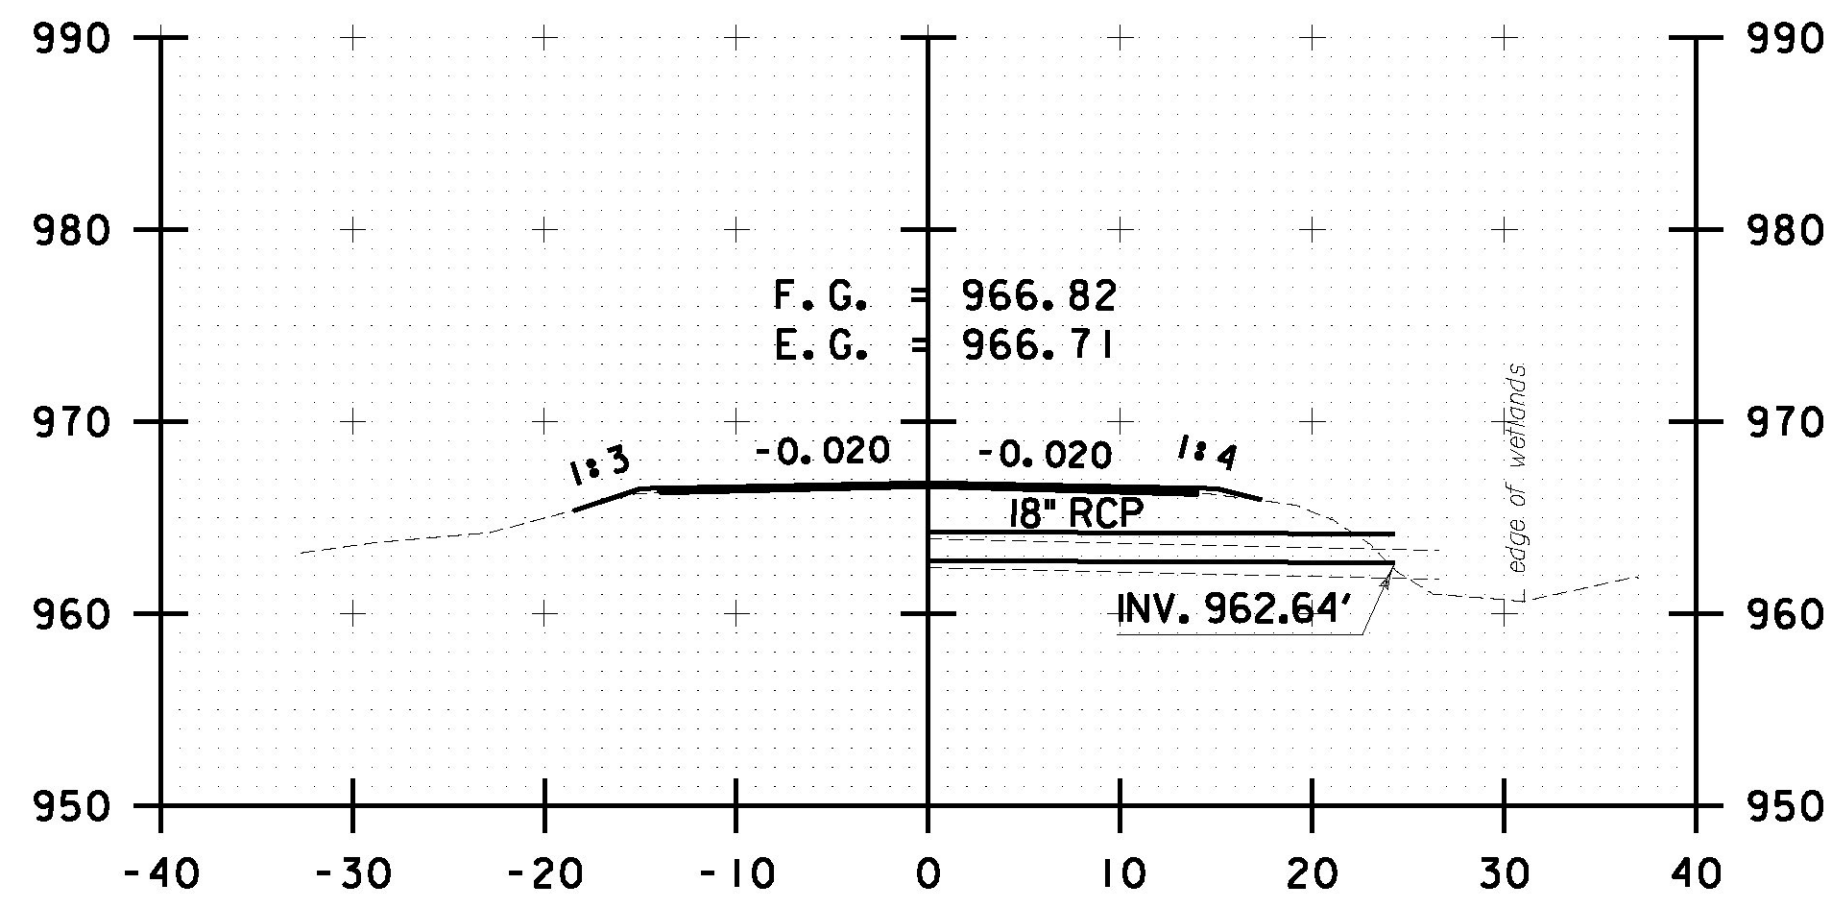


R 289+52.00

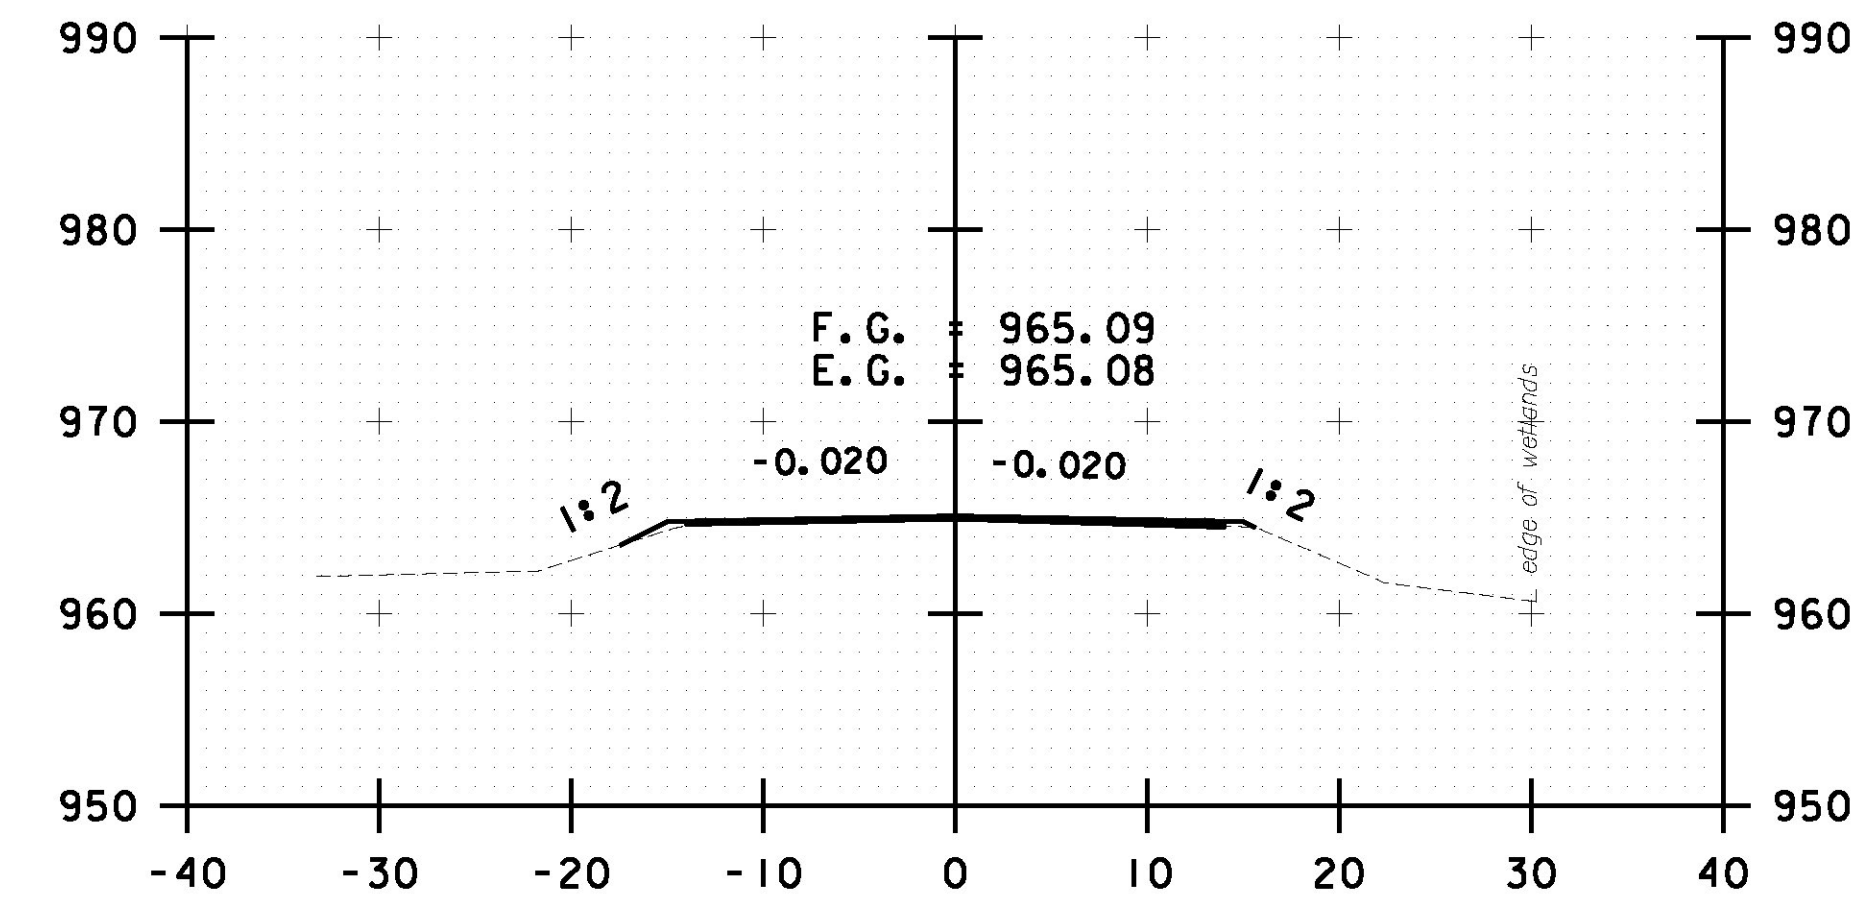


R 291+00.00

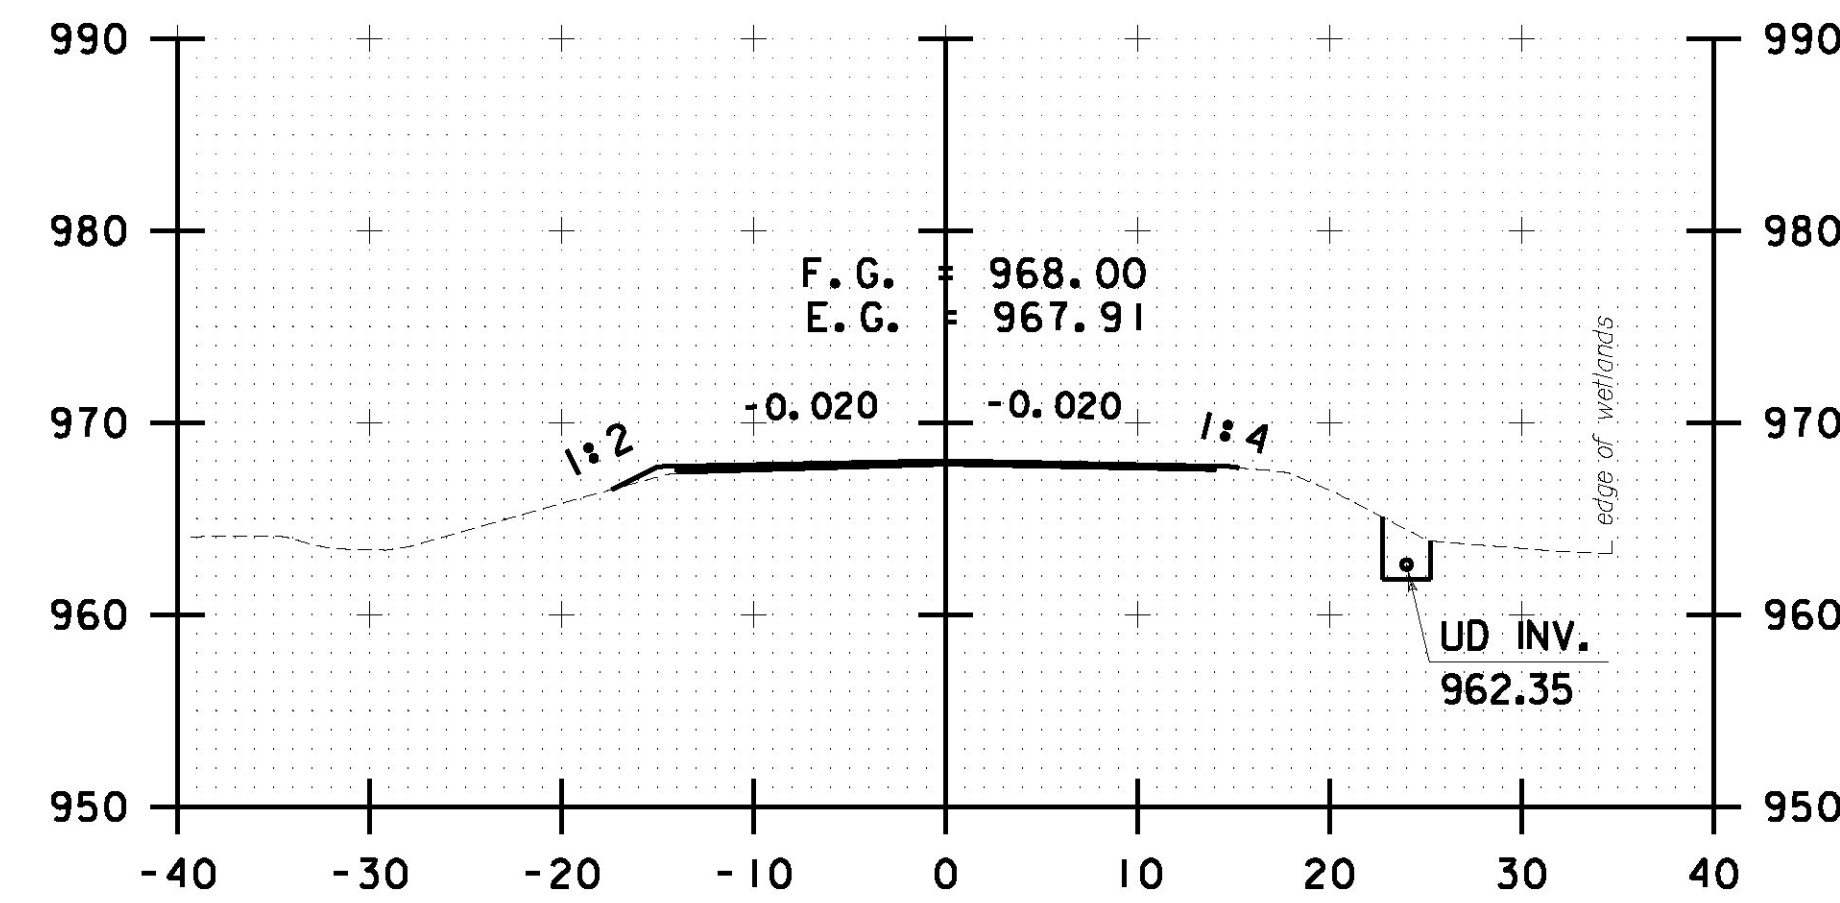


R 288+50.00

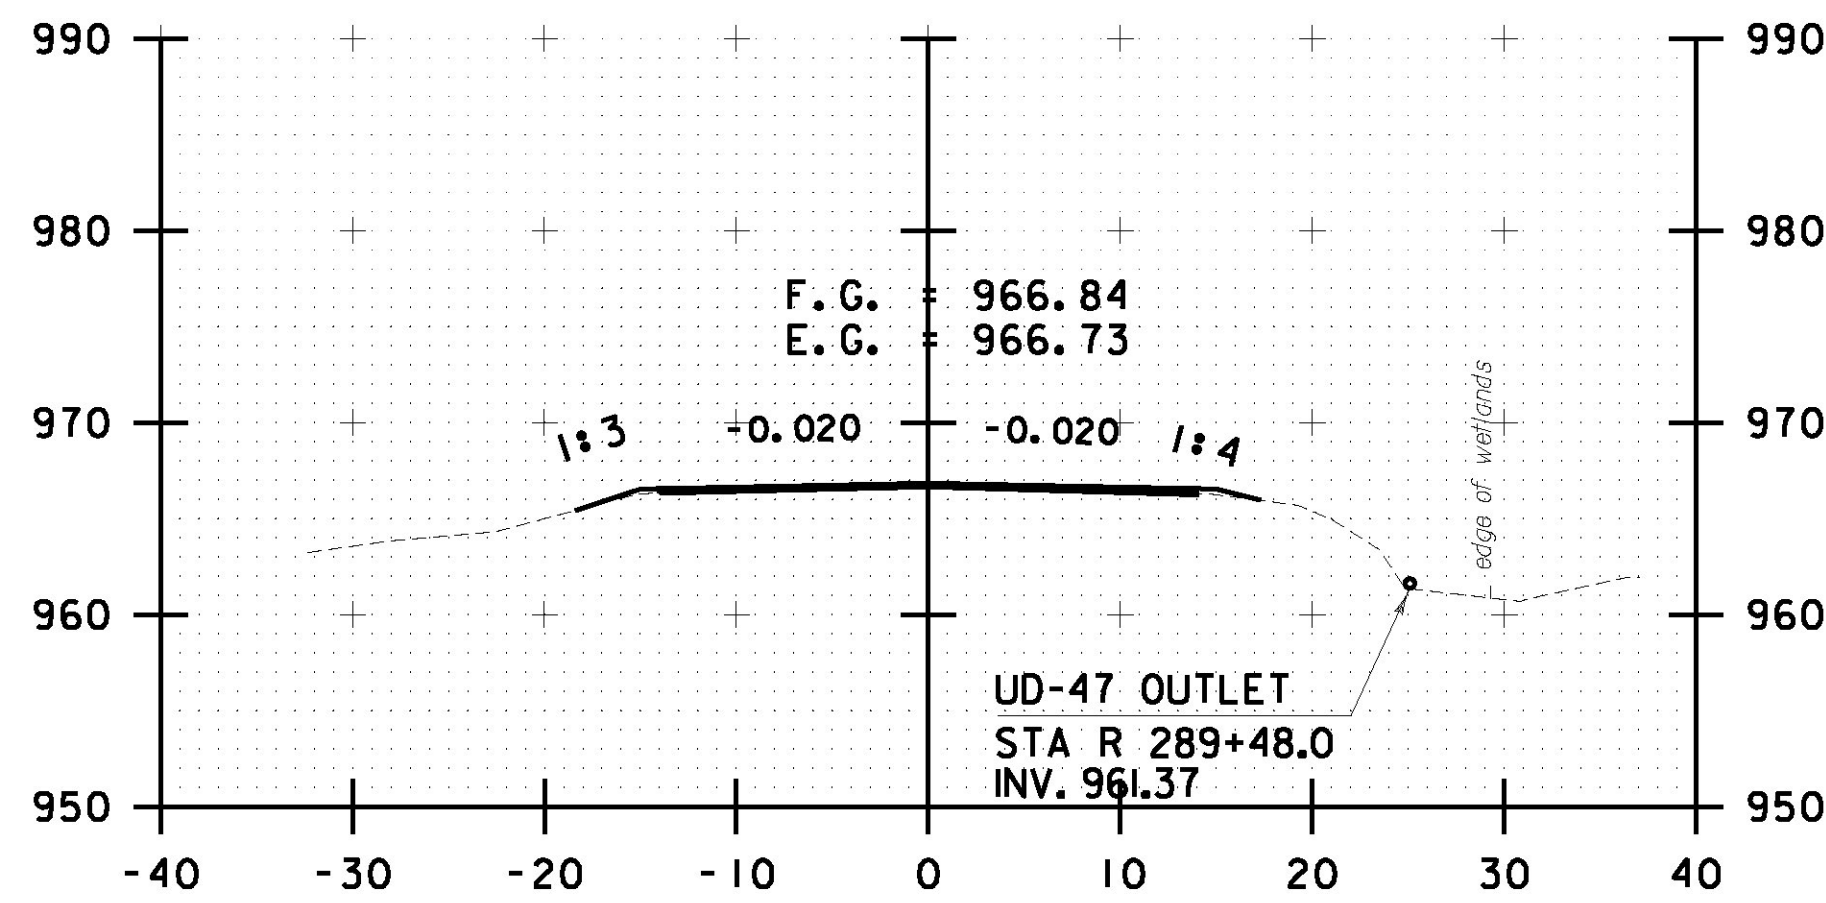


R 289+50.00

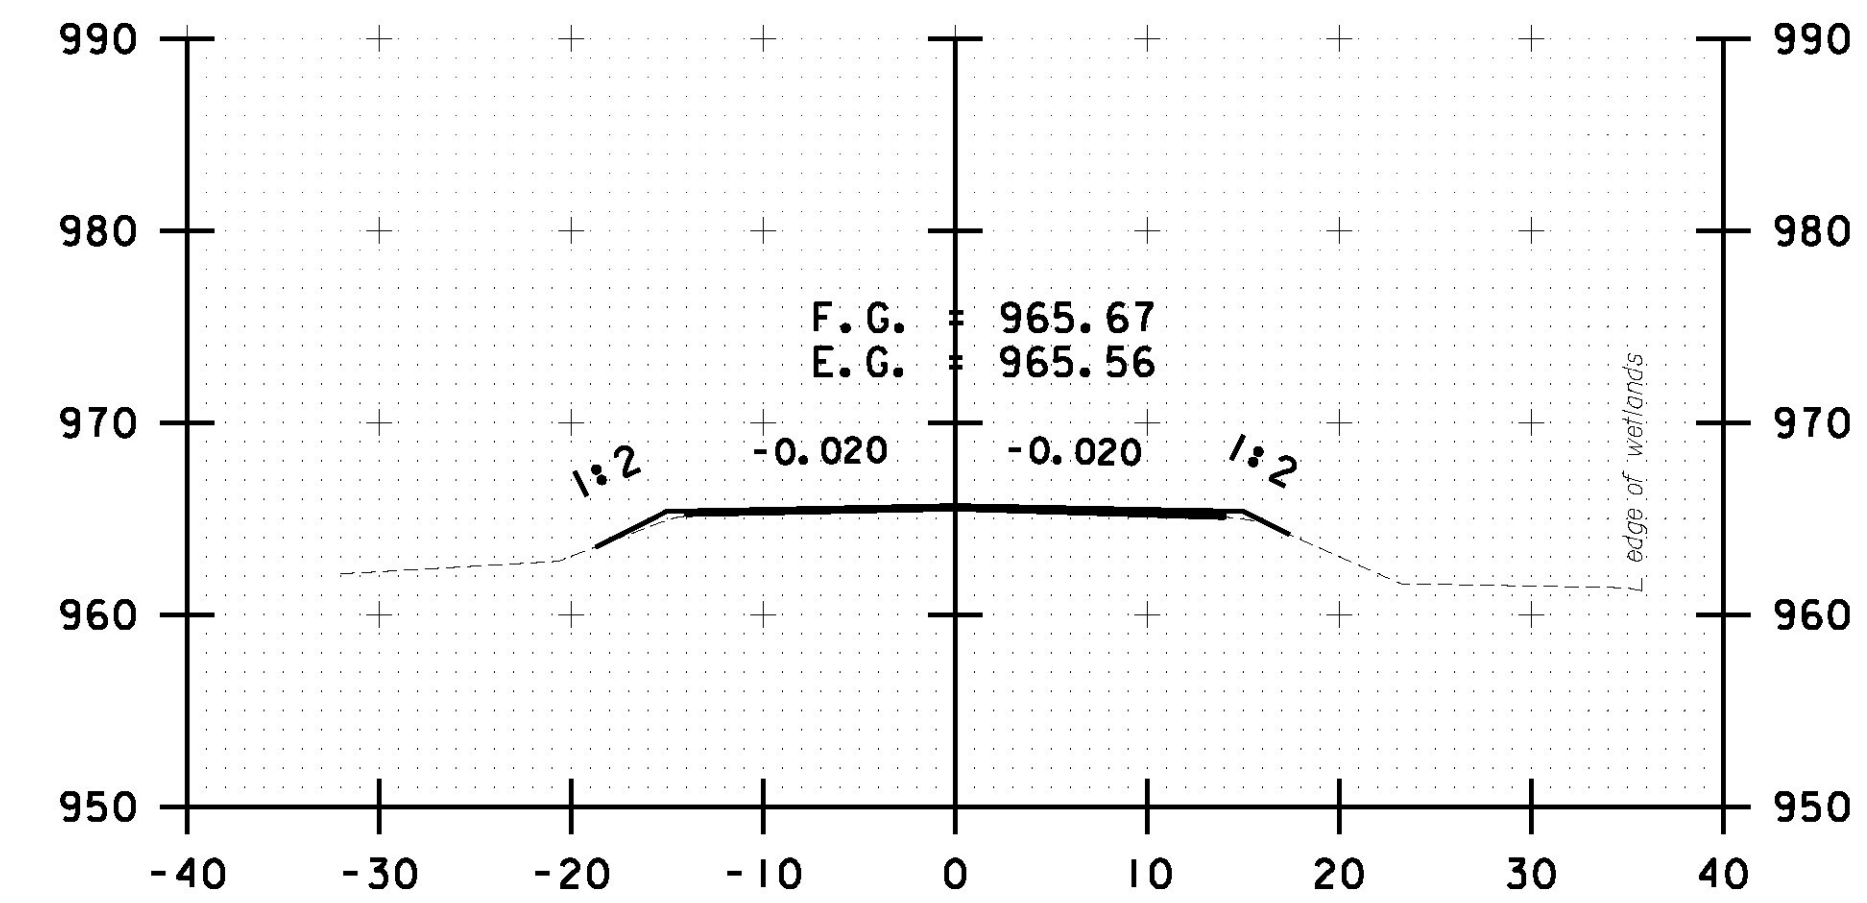


R 290+50.00

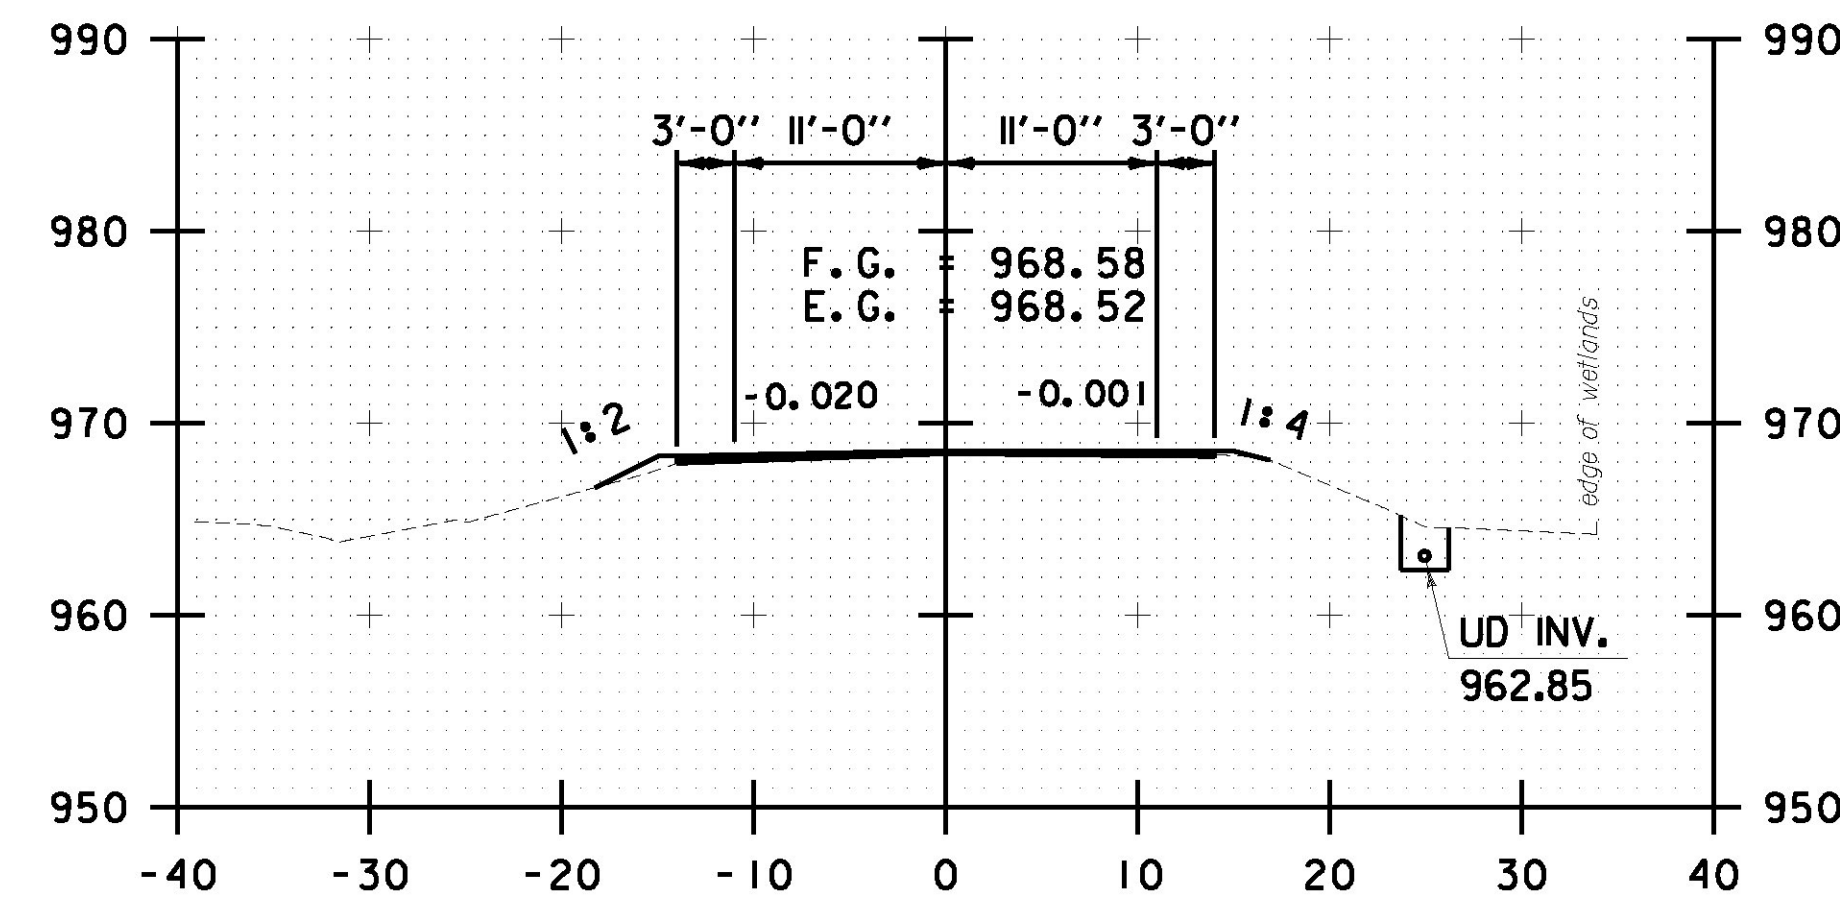


R 288+00.00

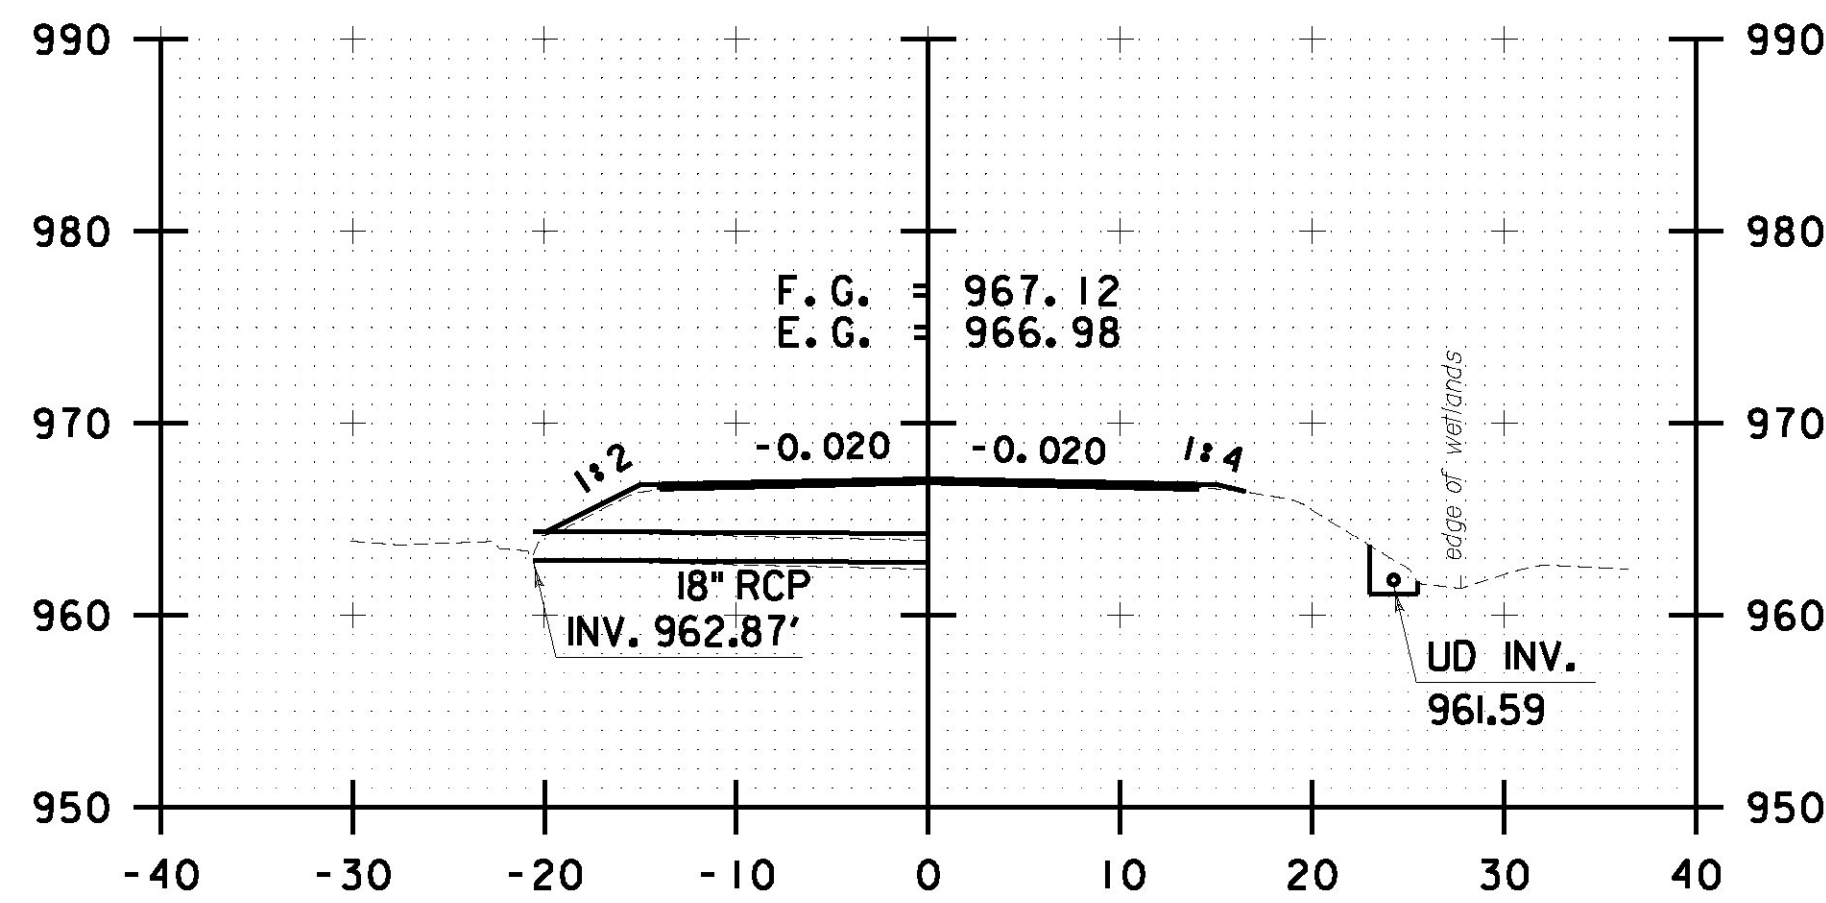

R 289+26.00

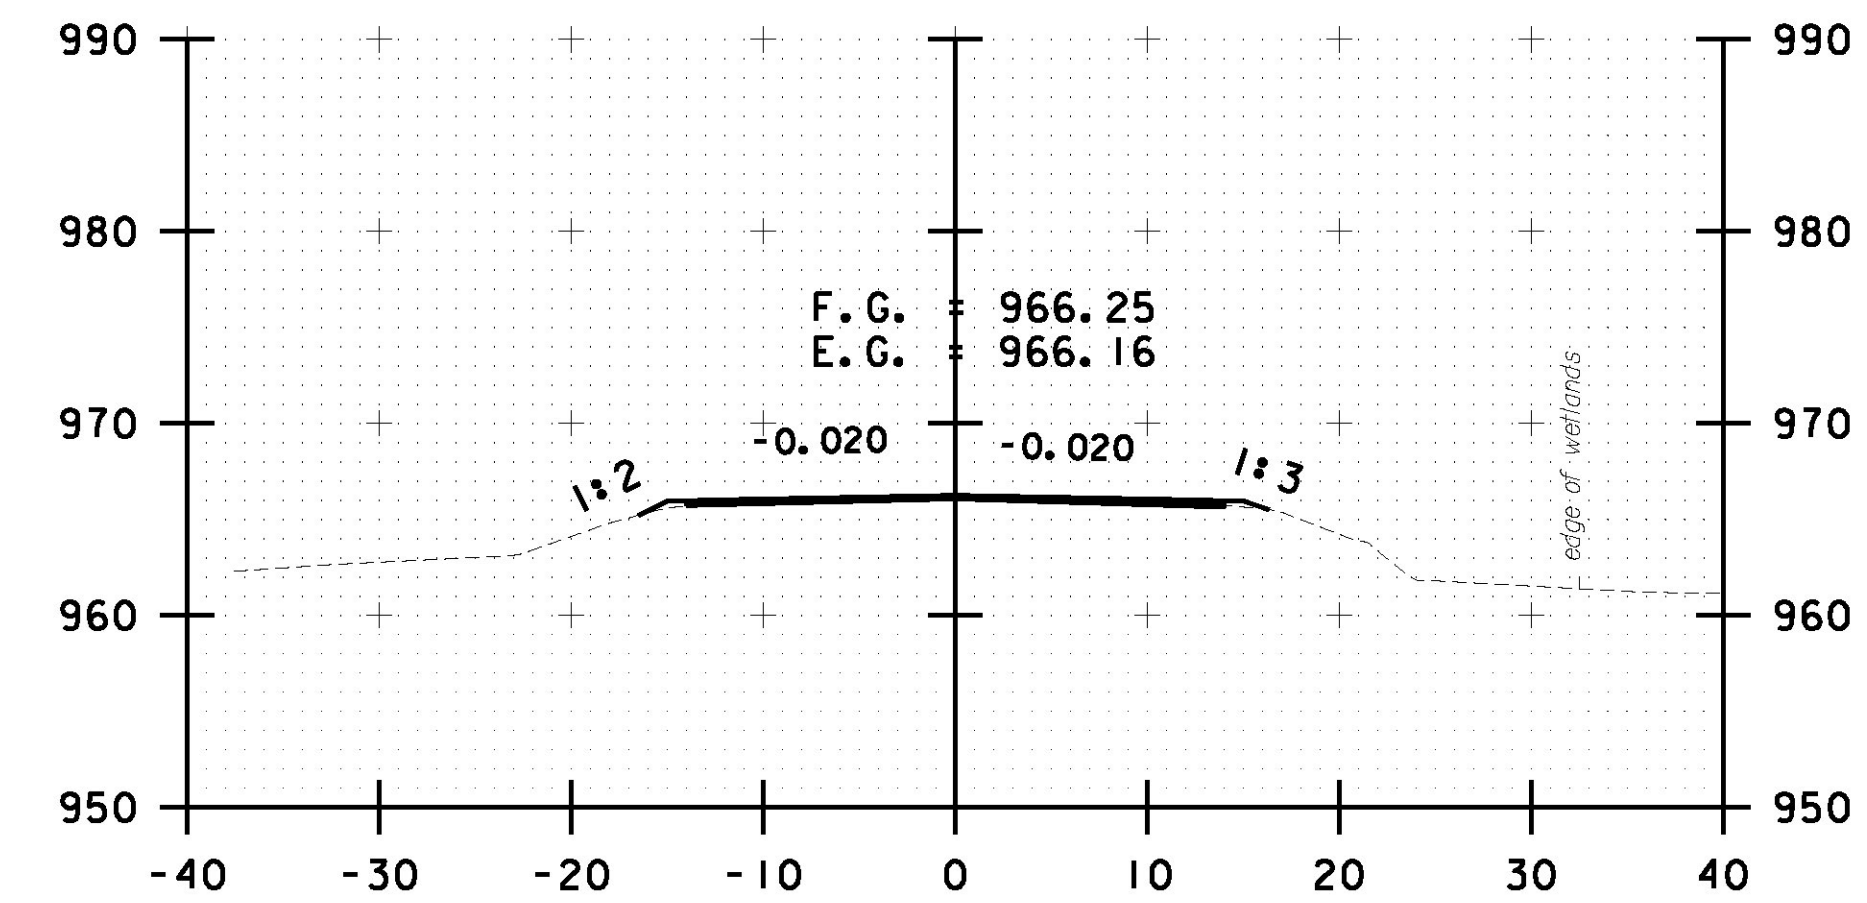

R 290+00.00

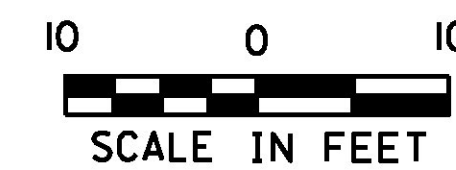

PROJECT NAME: ROCHESTER	
PROJECT NUMBER: ER STP 0162(21)	
FILE NAME: z13cl76xc.dgn	PLOT DATE: 1/12/2017
PROJECT LEADER: D. GOZALKOWSKI	DRAWN BY: J. HEALD
DESIGNED BY: J. OLSEN	CHECKED BY: J. SHIELDS
ROCHESTER CROSS SECTION SHEET #100	SHEET 289 OF 360