
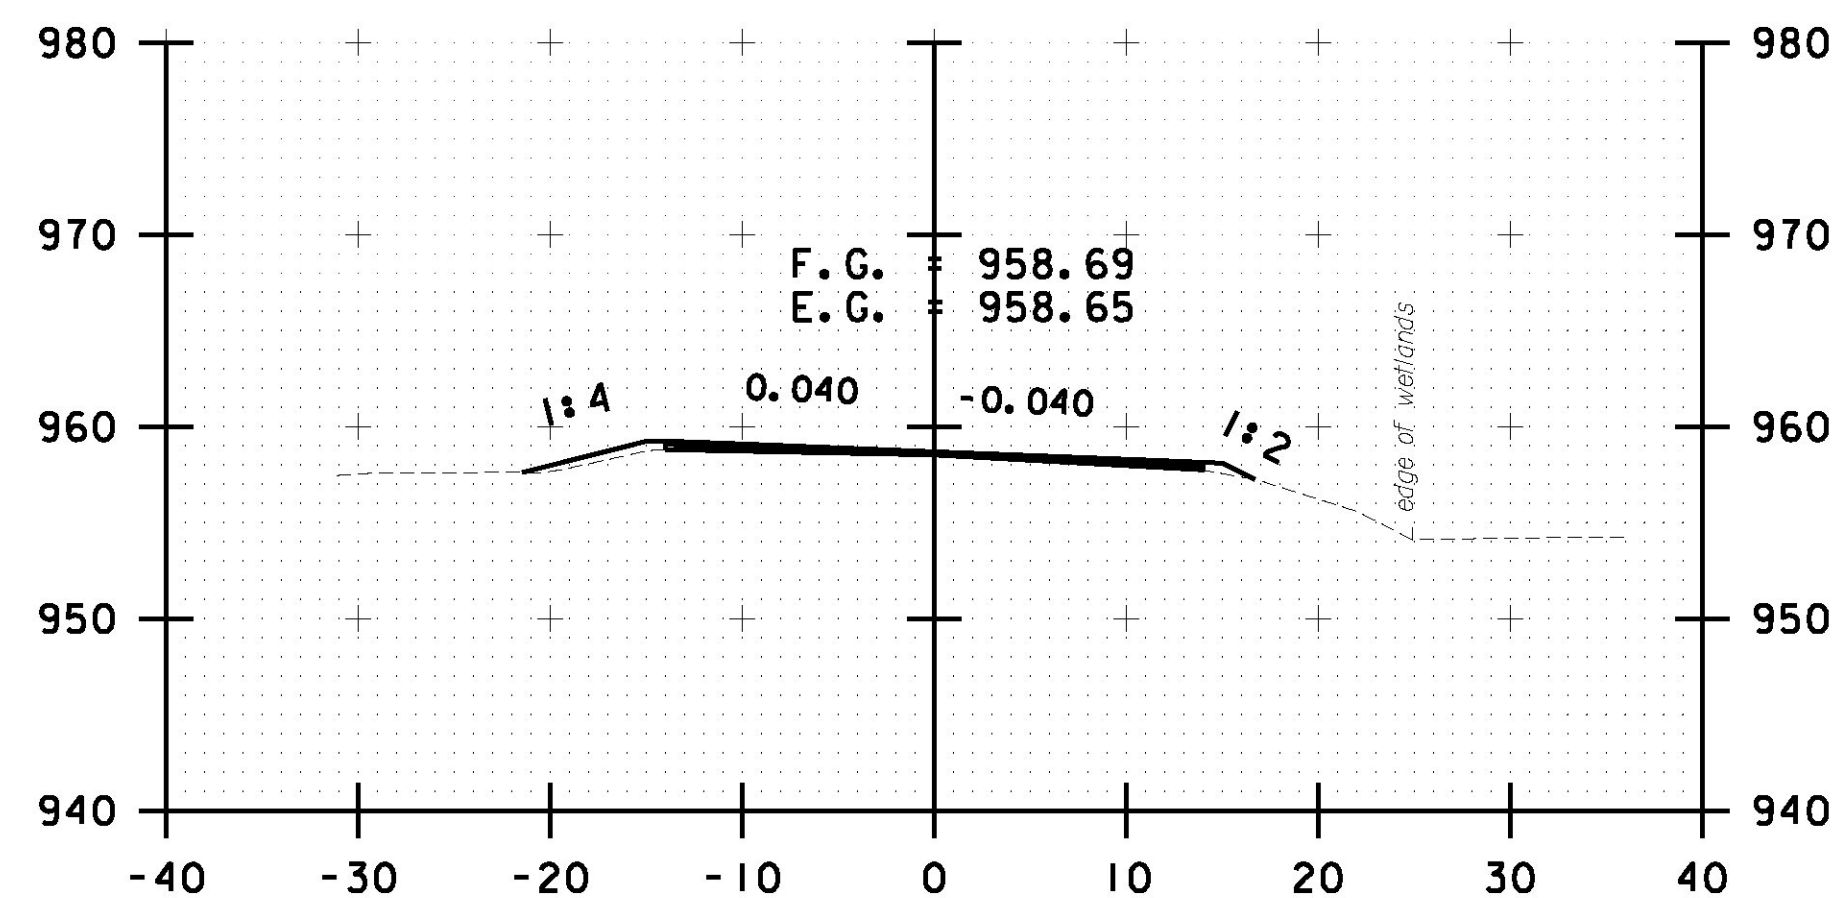
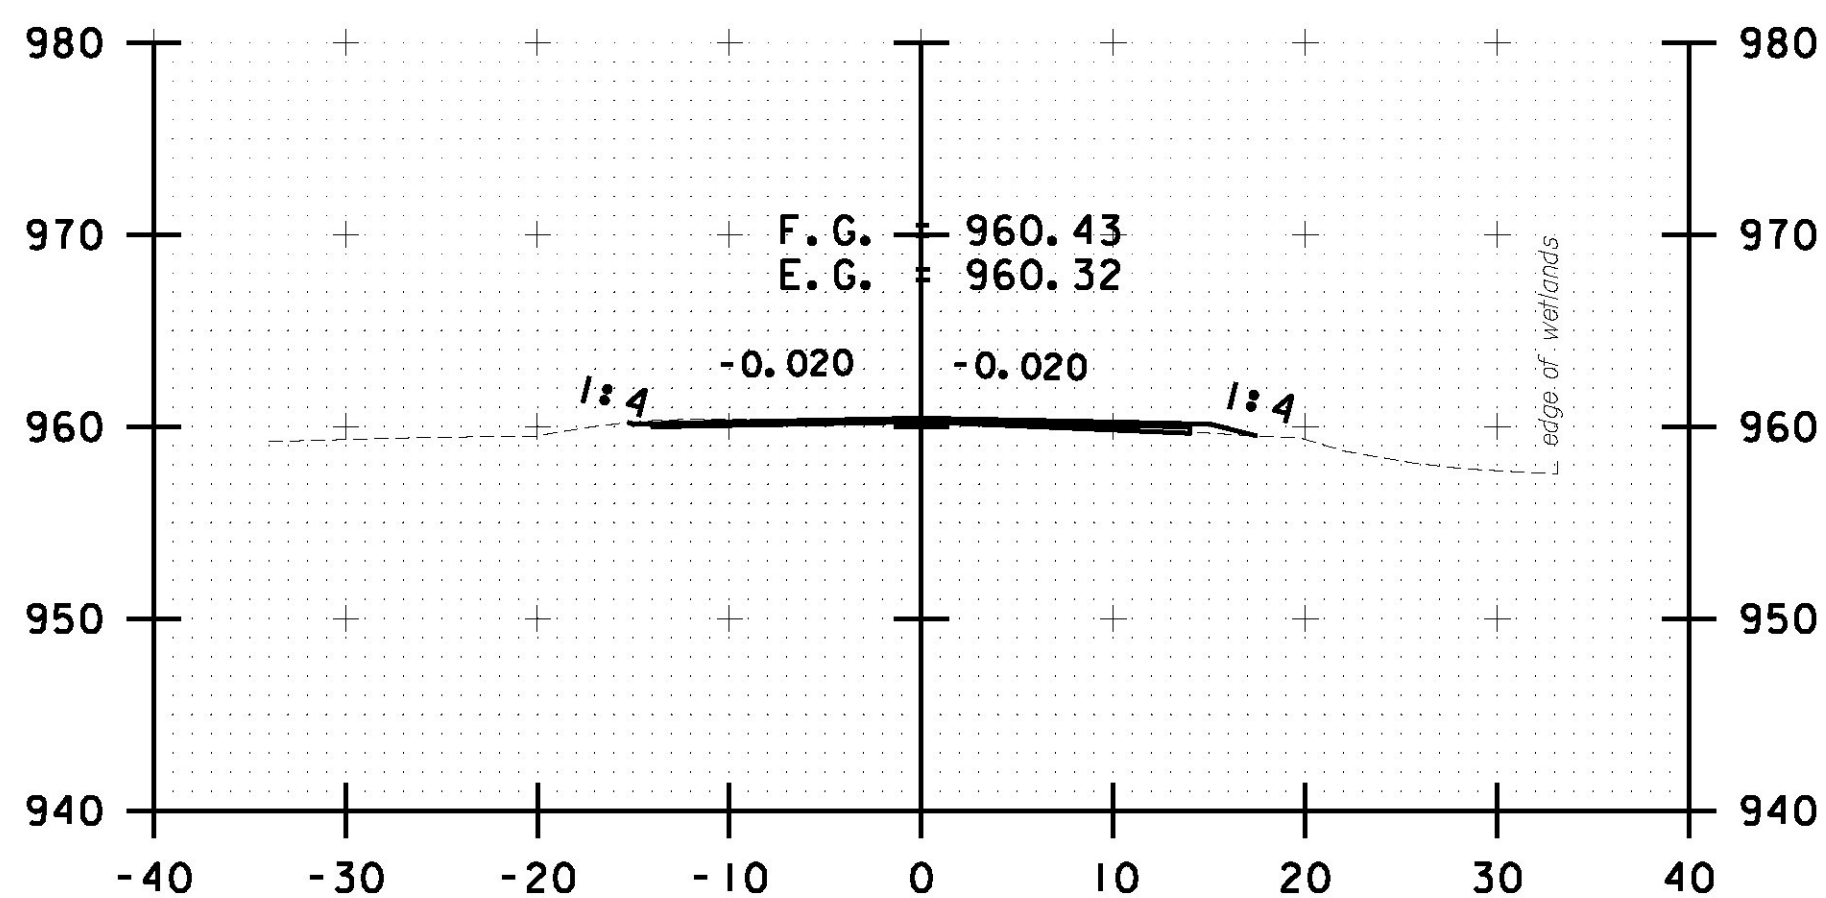


R 295+50.00




R 297+00.00

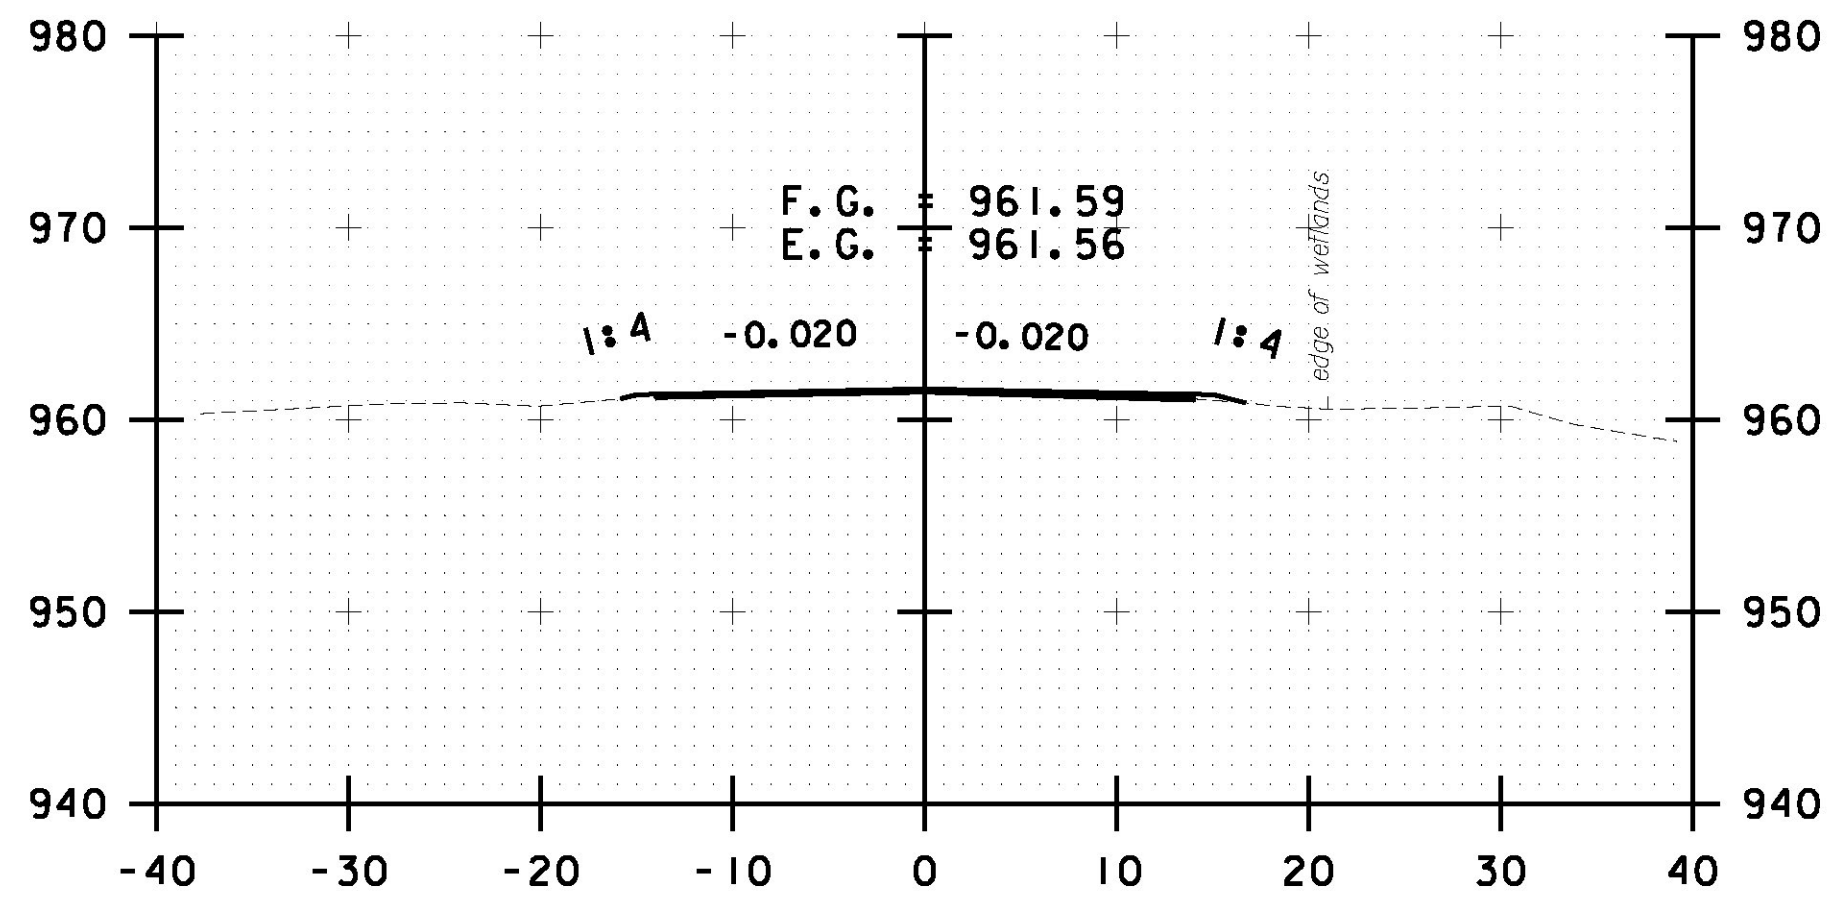

R 294+00.00

R 295+00.00


R 296+50.00

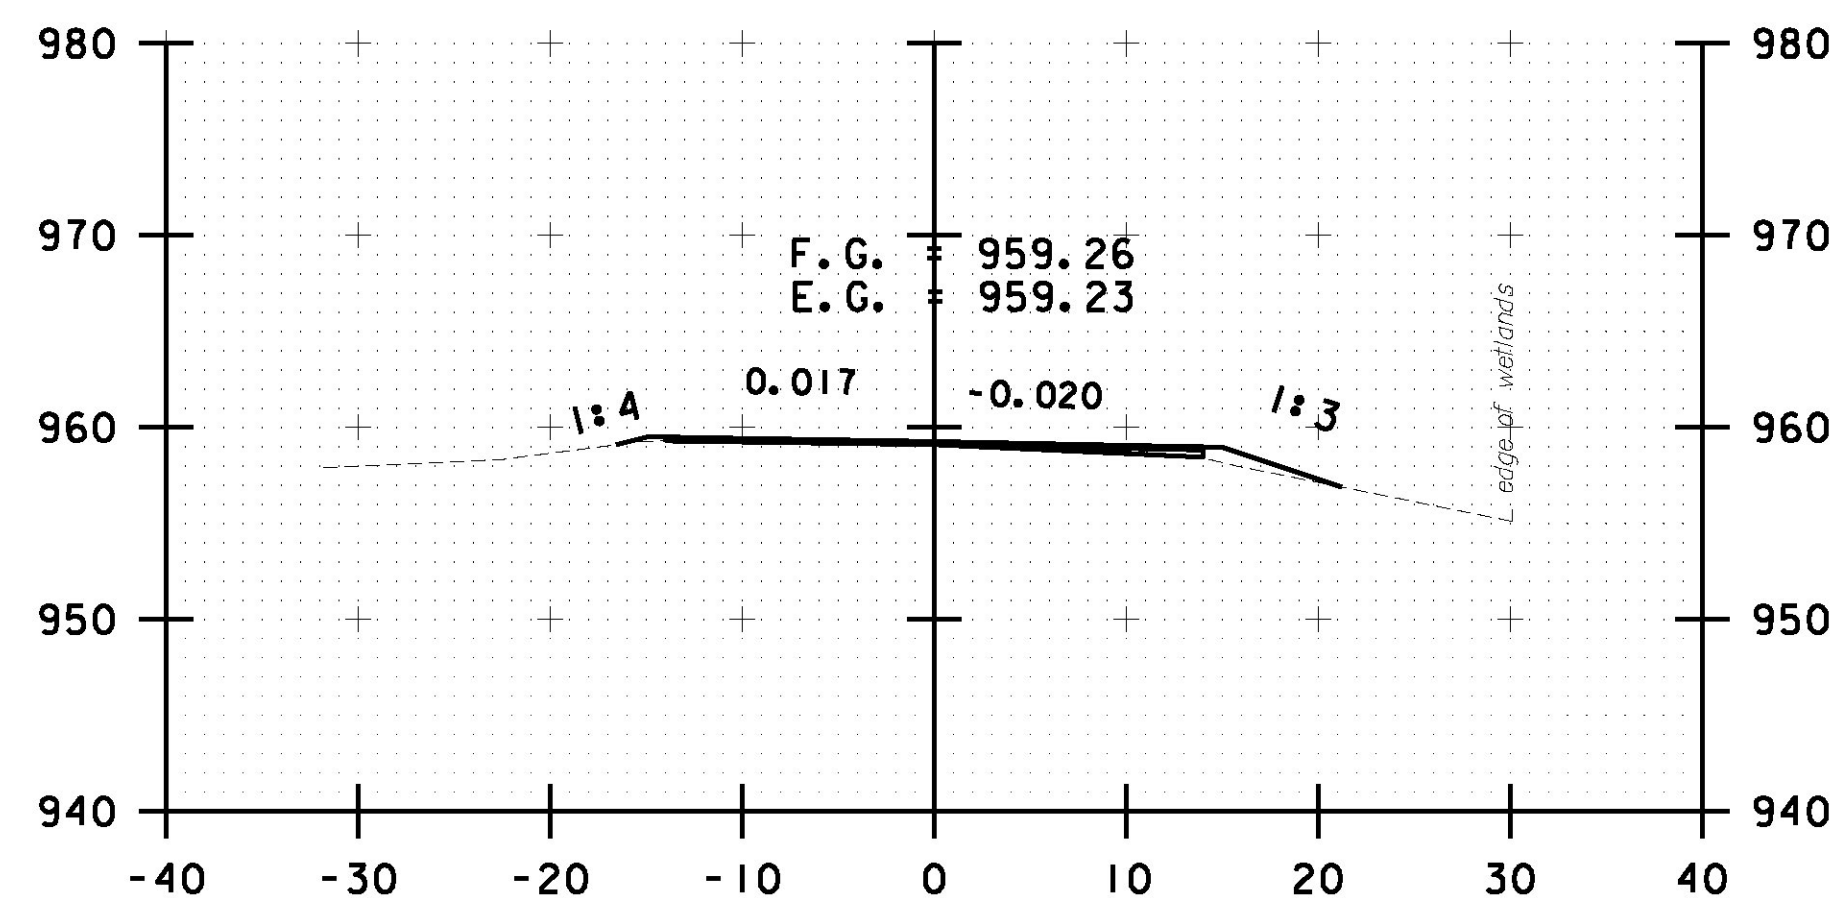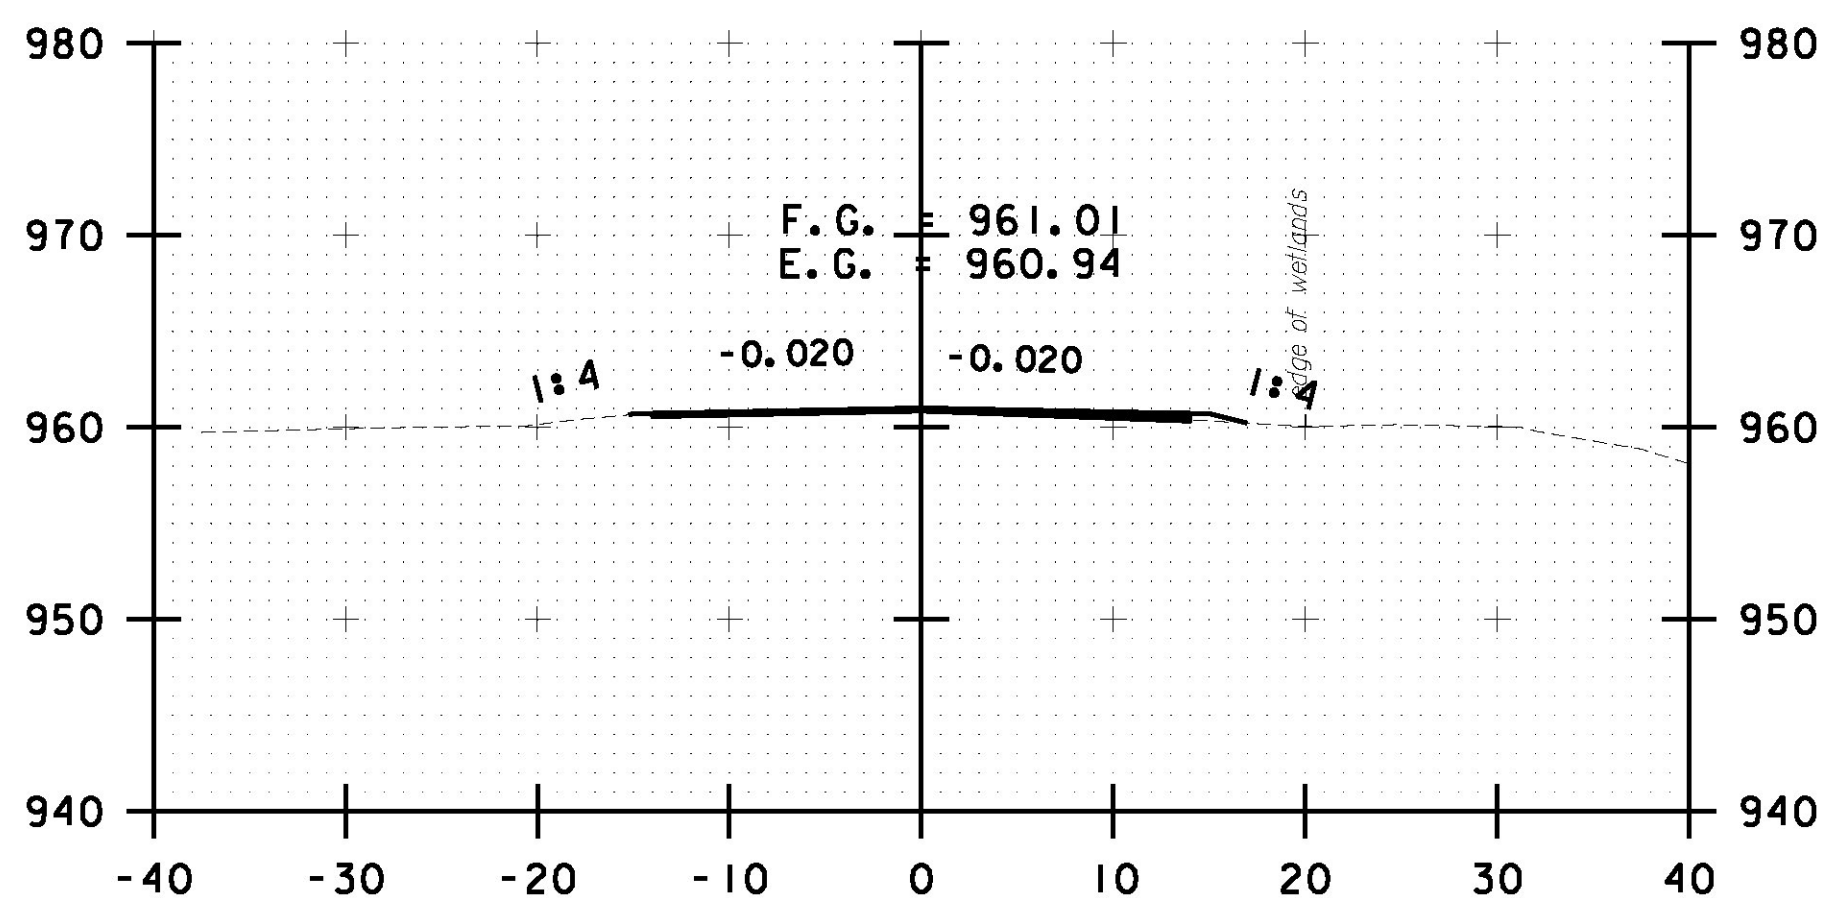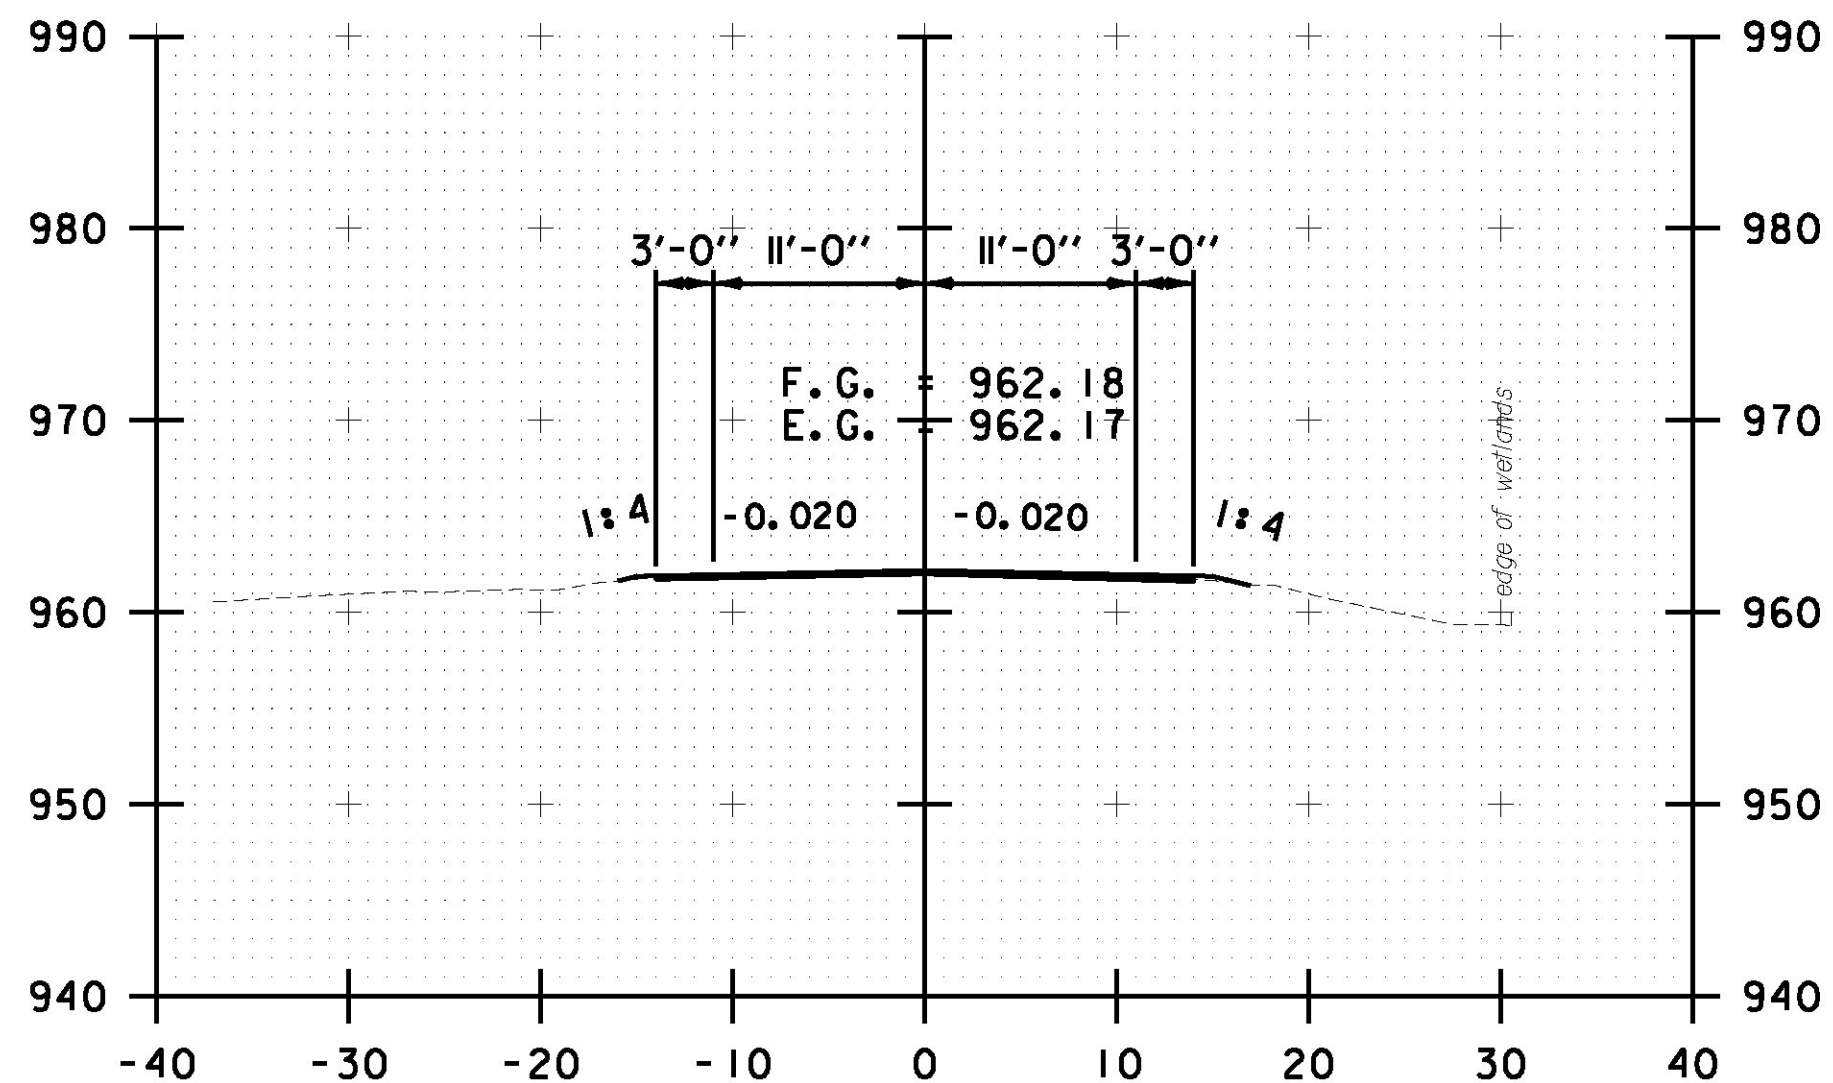

R 293+50.00

R 294+50.00

R 296+00.00

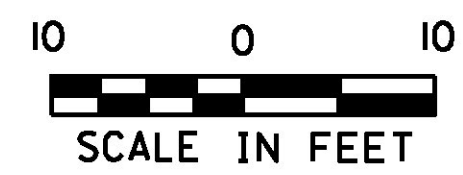

PROJECT NAME: ROCHESTER	
PROJECT NUMBER: ER STP 0162(21)	
FILE NAME: z13cl76xc.dgn	PLOT DATE: 1/12/2017
PROJECT LEADER: D. GOZALKOWSKI	DRAWN BY: J. HEALD
DESIGNED BY: J. OLSEN	CHECKED BY: J. SHIELDS
ROCHESTER CROSS SECTION SHEET #102	SHEET 291 OF 360