




R 350+07.00

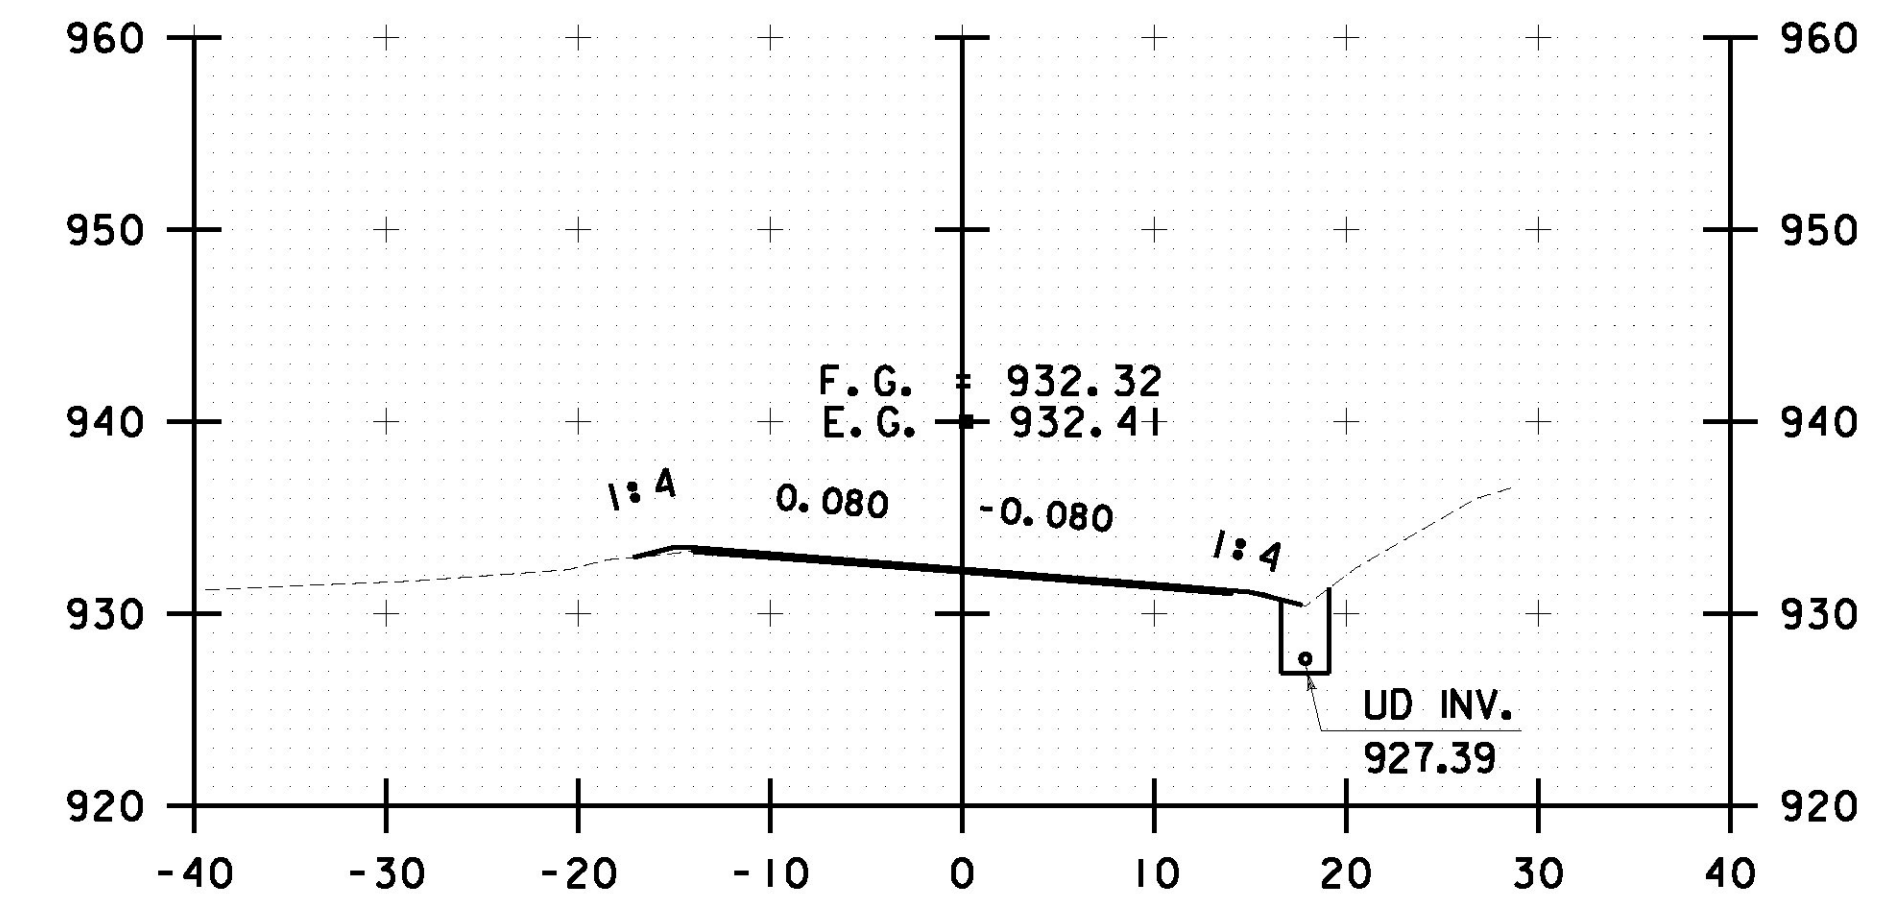


R 351+50.00

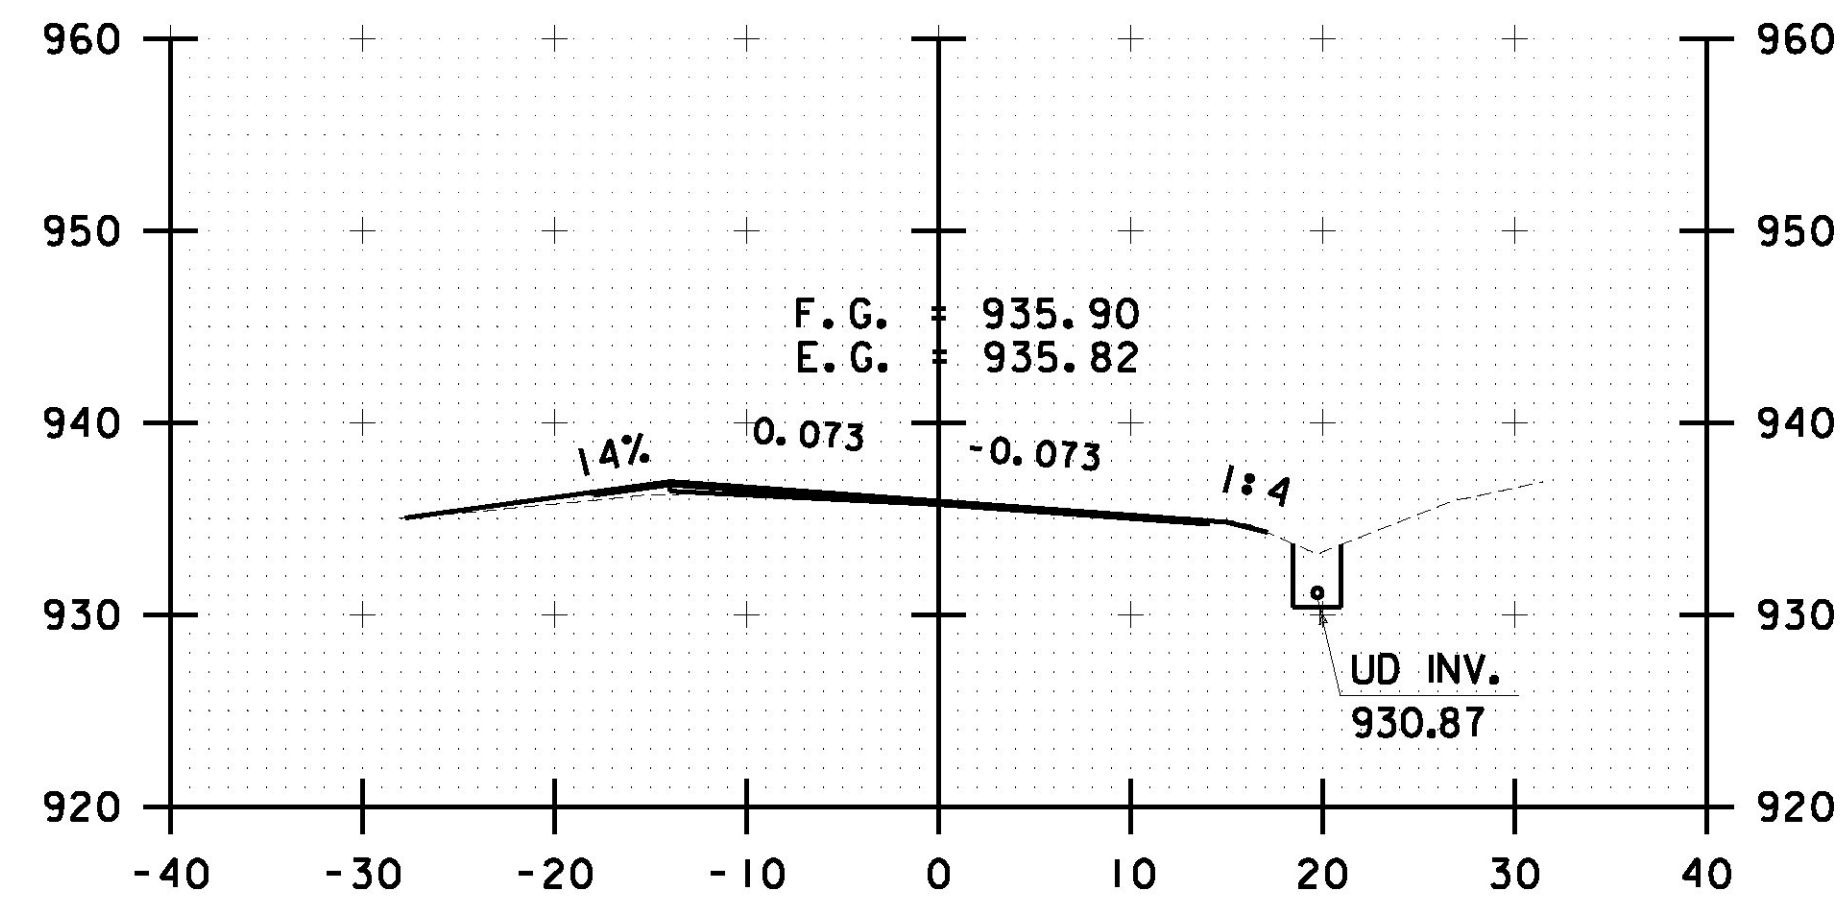


R 349+50.00

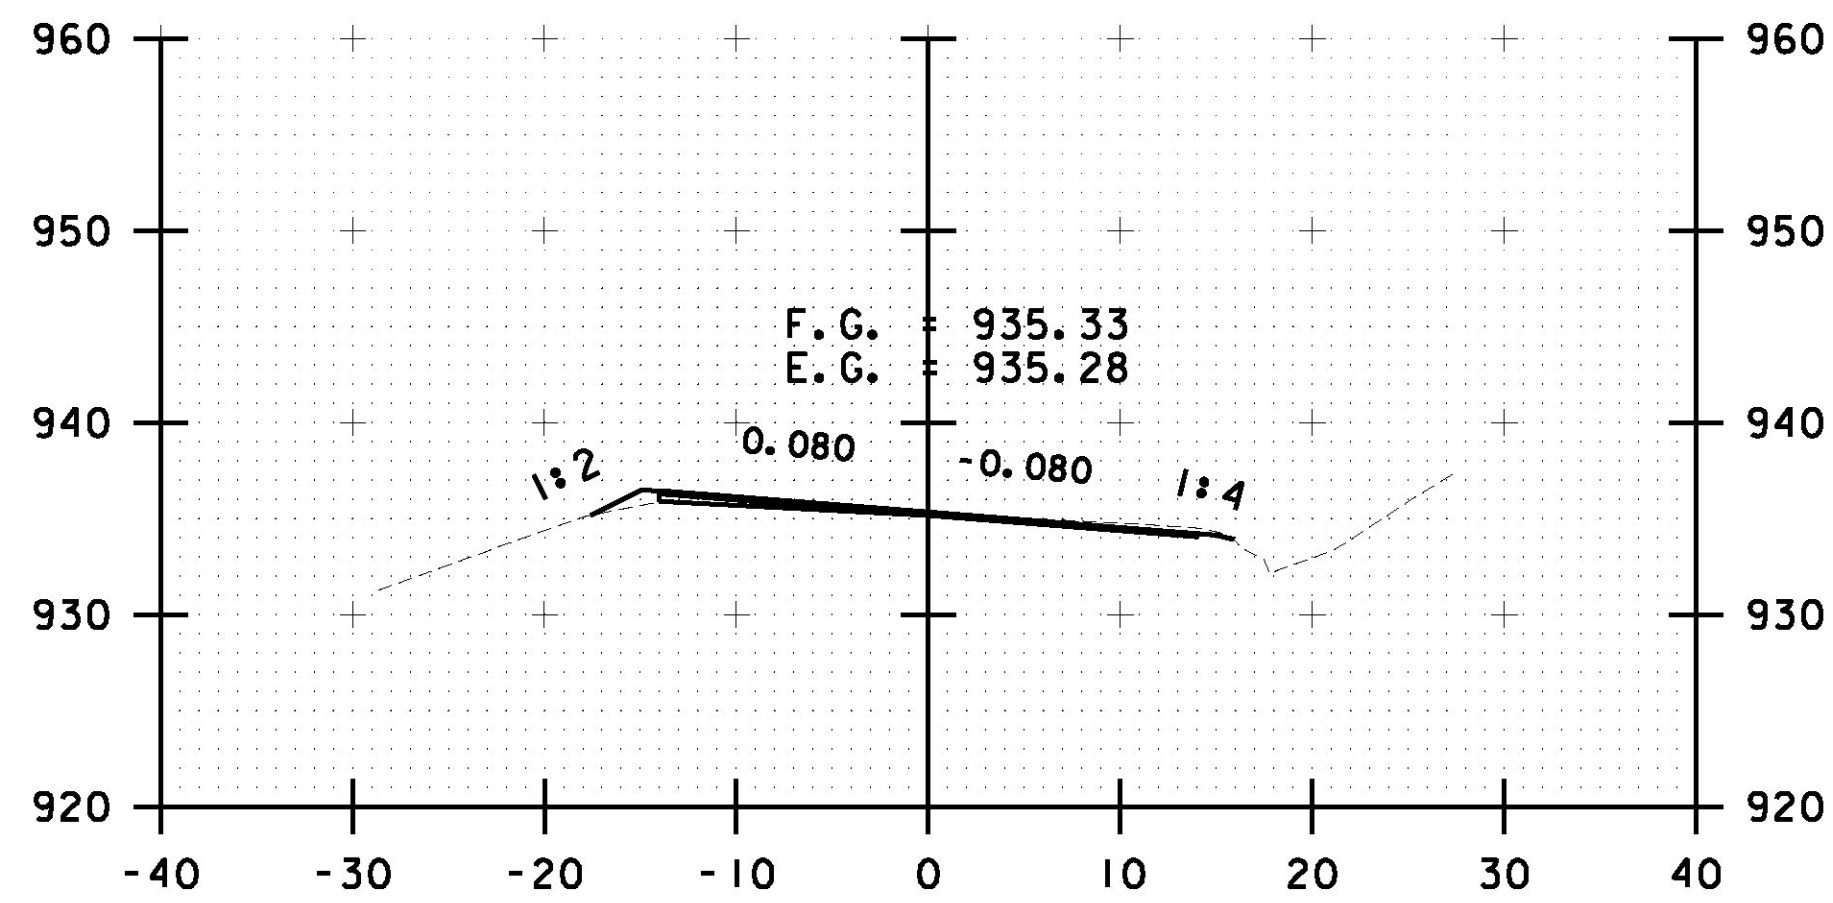


R 350+00.00

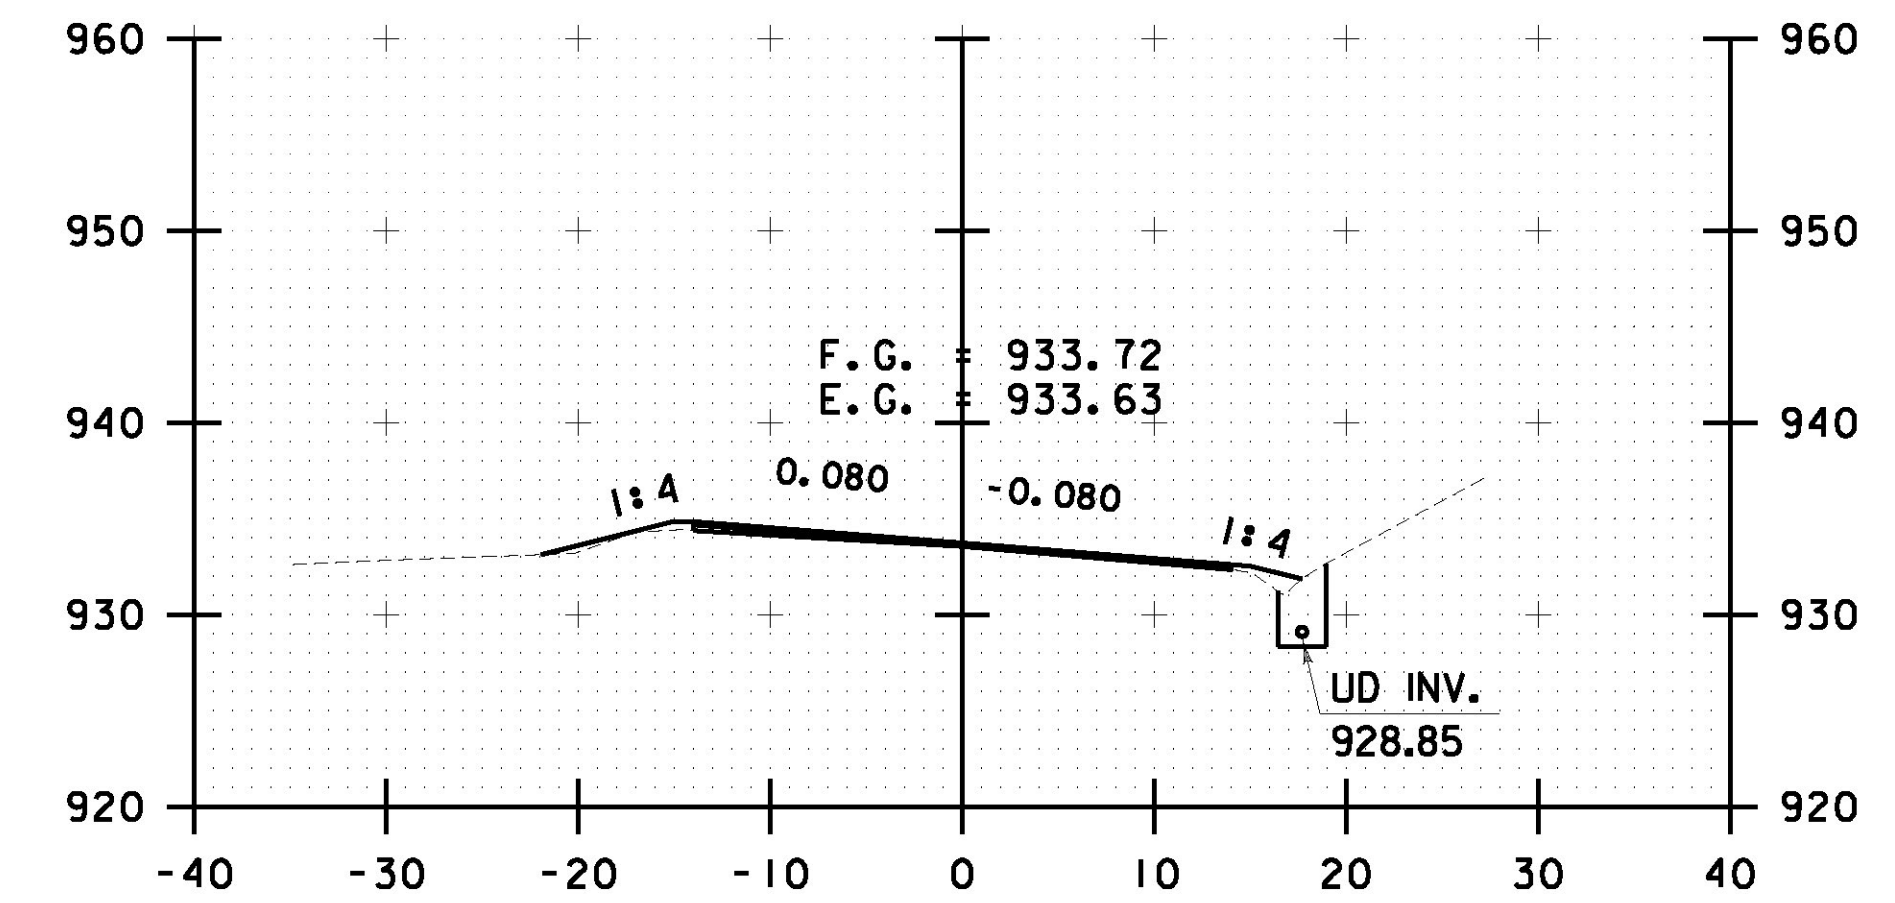


R 351+00.00

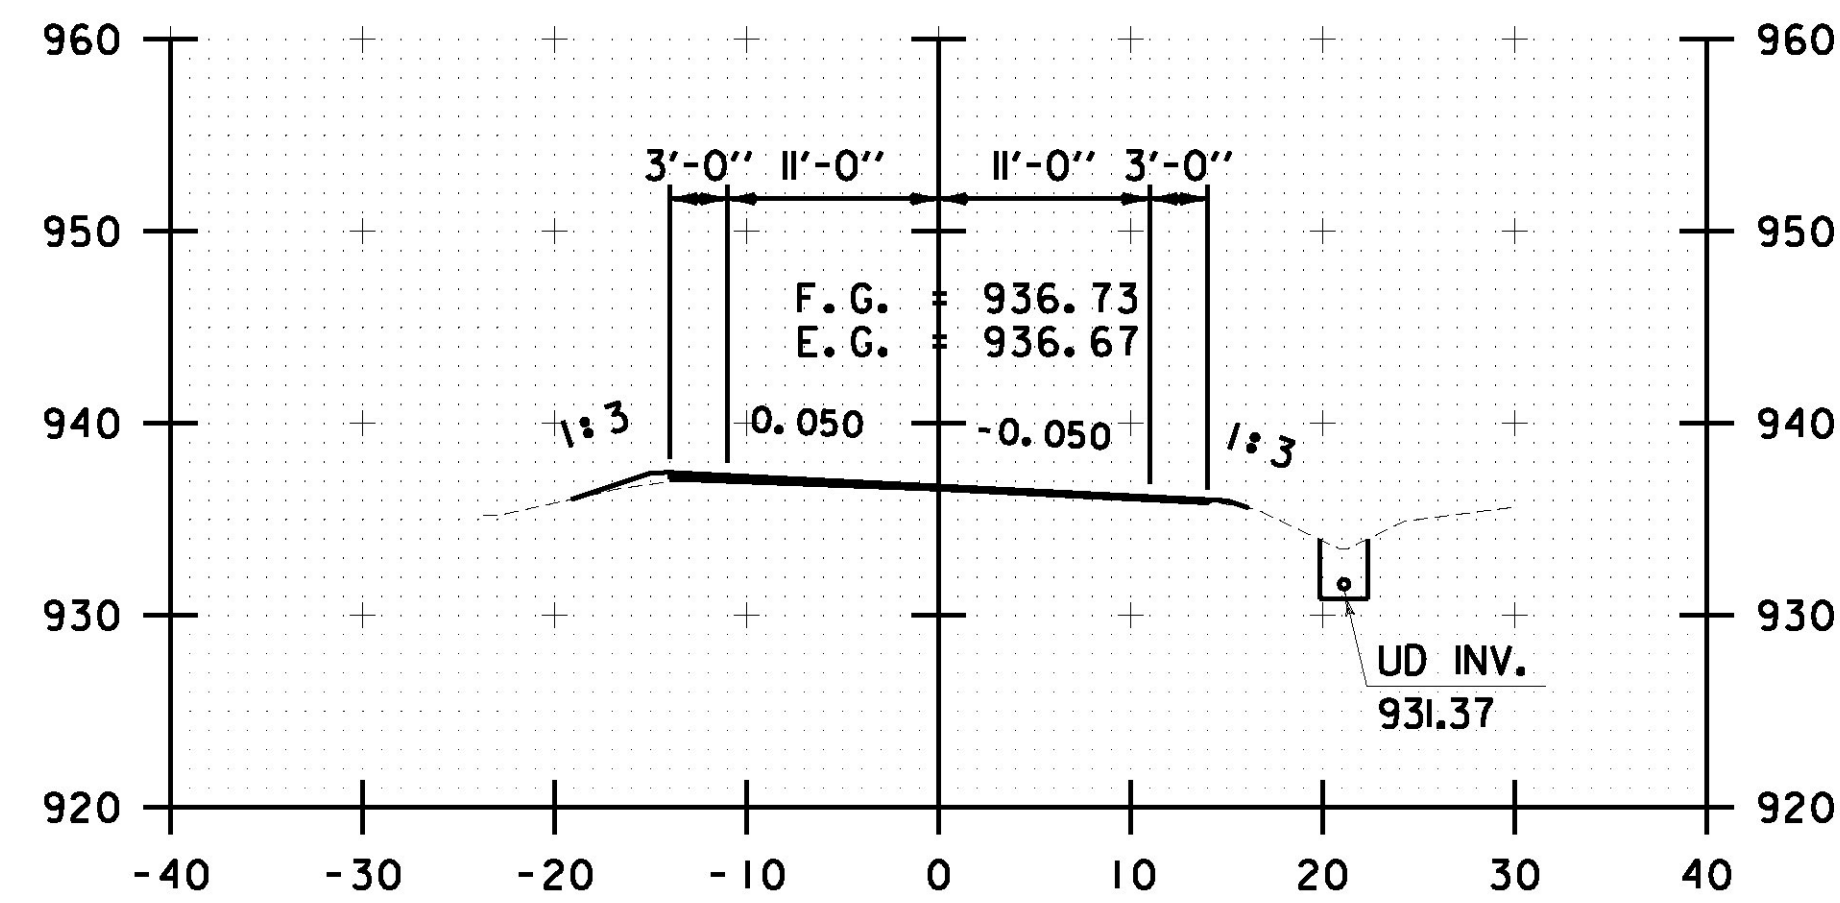


R 349+00.00

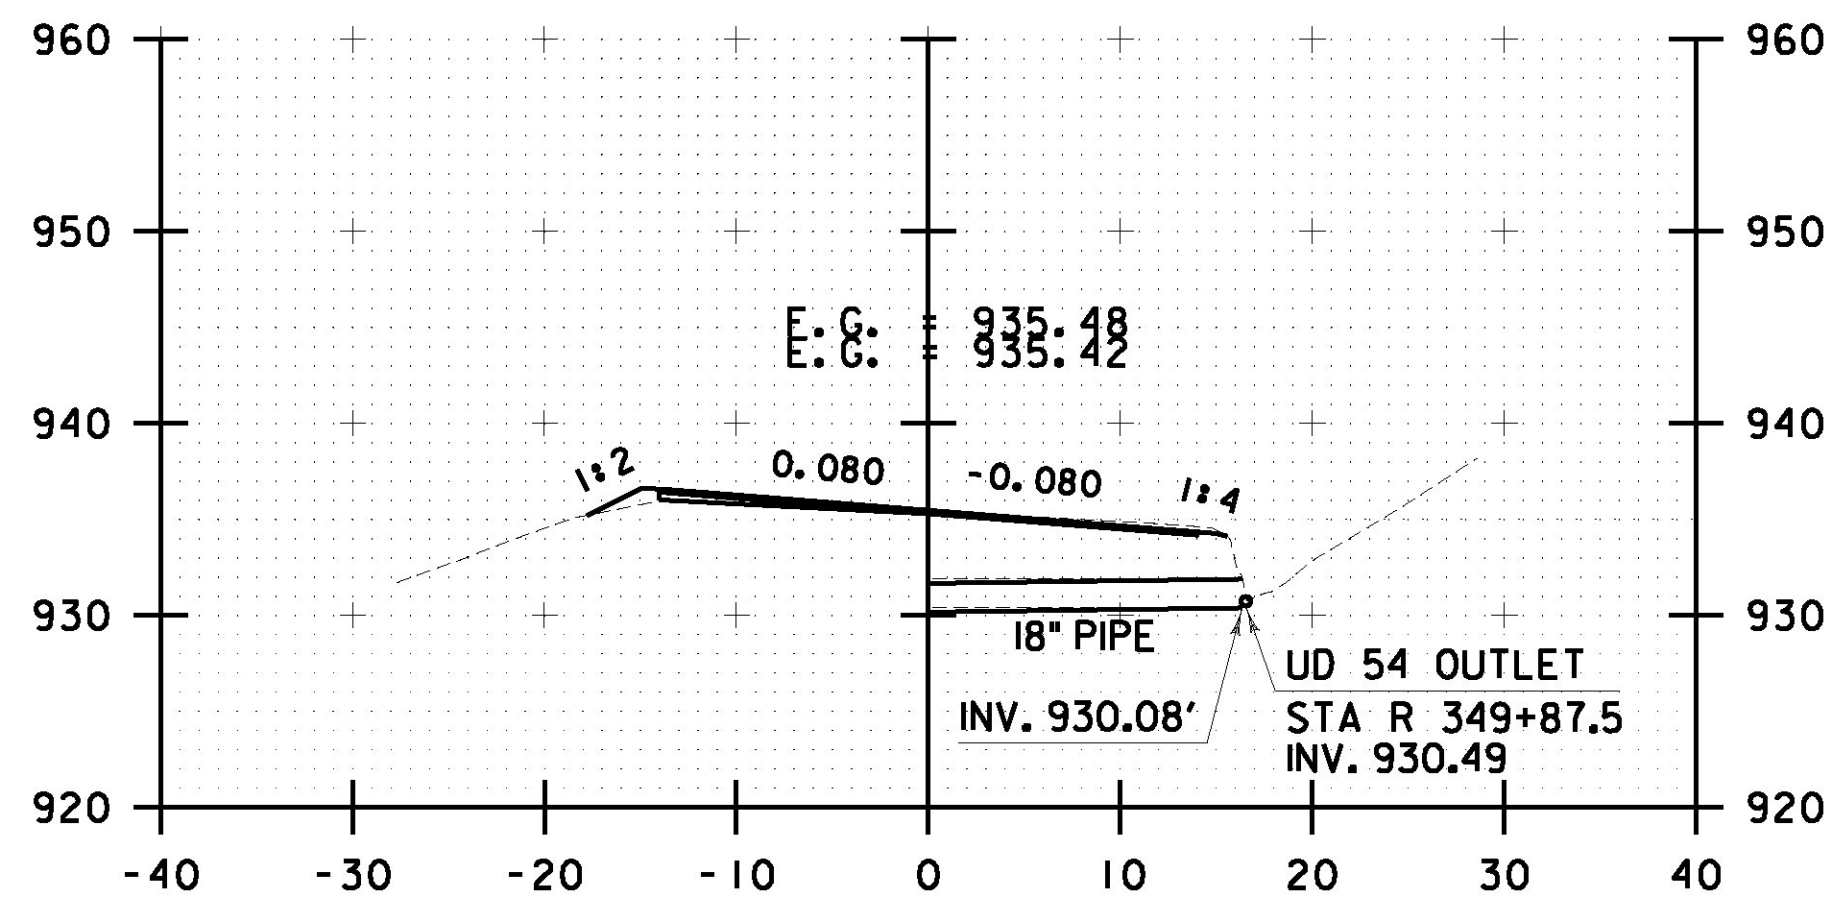

R 349+88.00

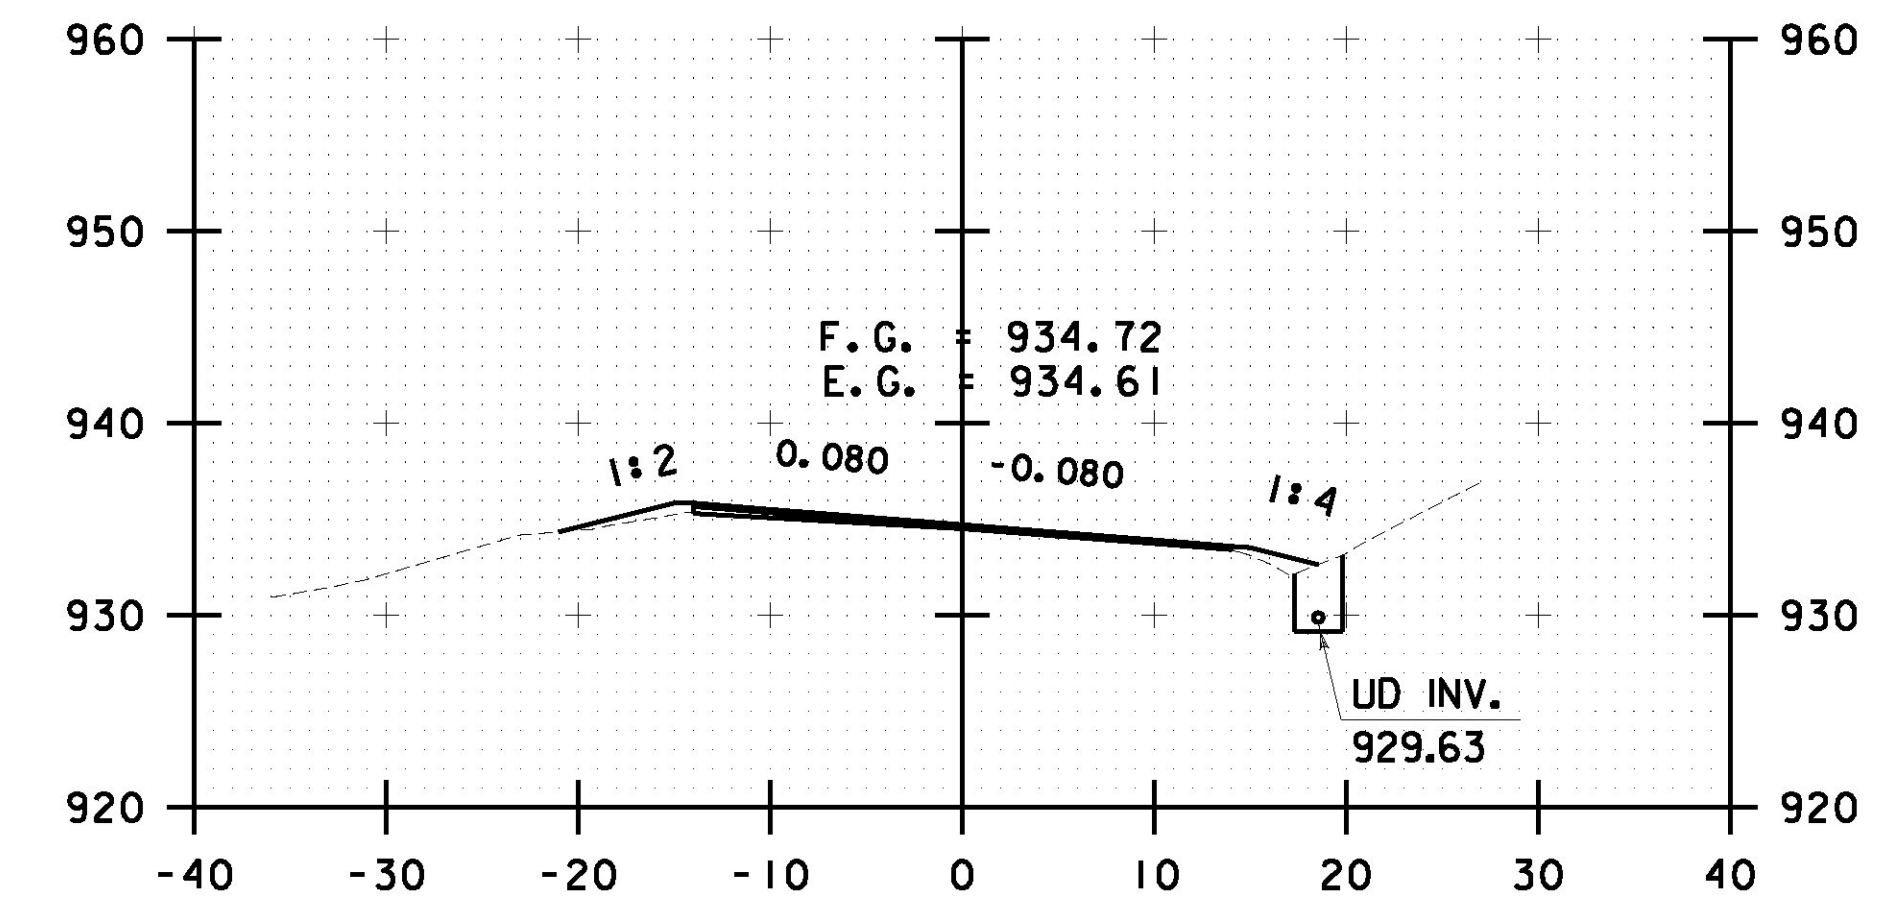

R 350+50.00

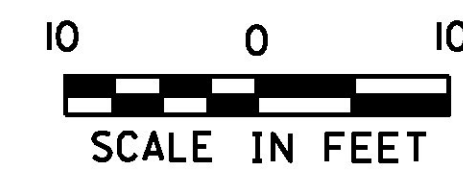

PROJECT NAME: ROCHESTER	
PROJECT NUMBER: ER STP 0162(21)	
FILE NAME: z13cl76xc.dgn	PLOT DATE: 1/12/2017
PROJECT LEADER: D. GOZALKOWSKI	DRAWN BY: J. HEALD
DESIGNED BY: J. OLSEN	CHECKED BY: J. SHIELDS
ROCHESTER CROSS SECTION SHEET #121	SHEET 310 OF 360