




R 383+00.00

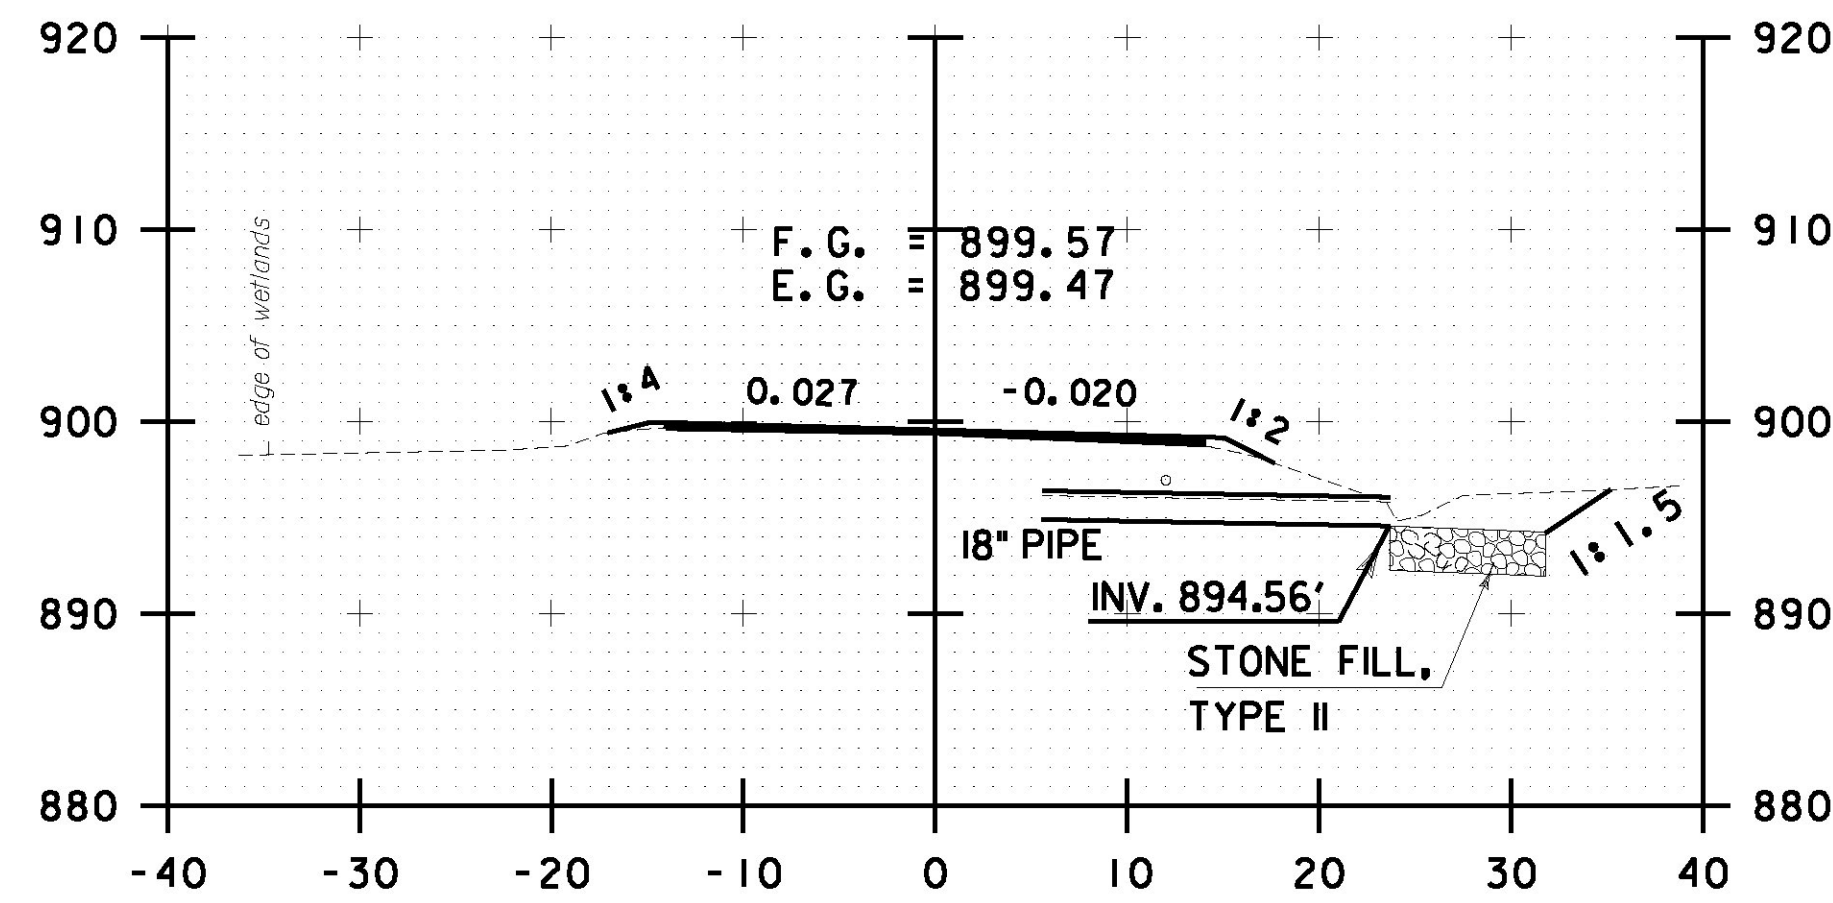


R 383+67.00

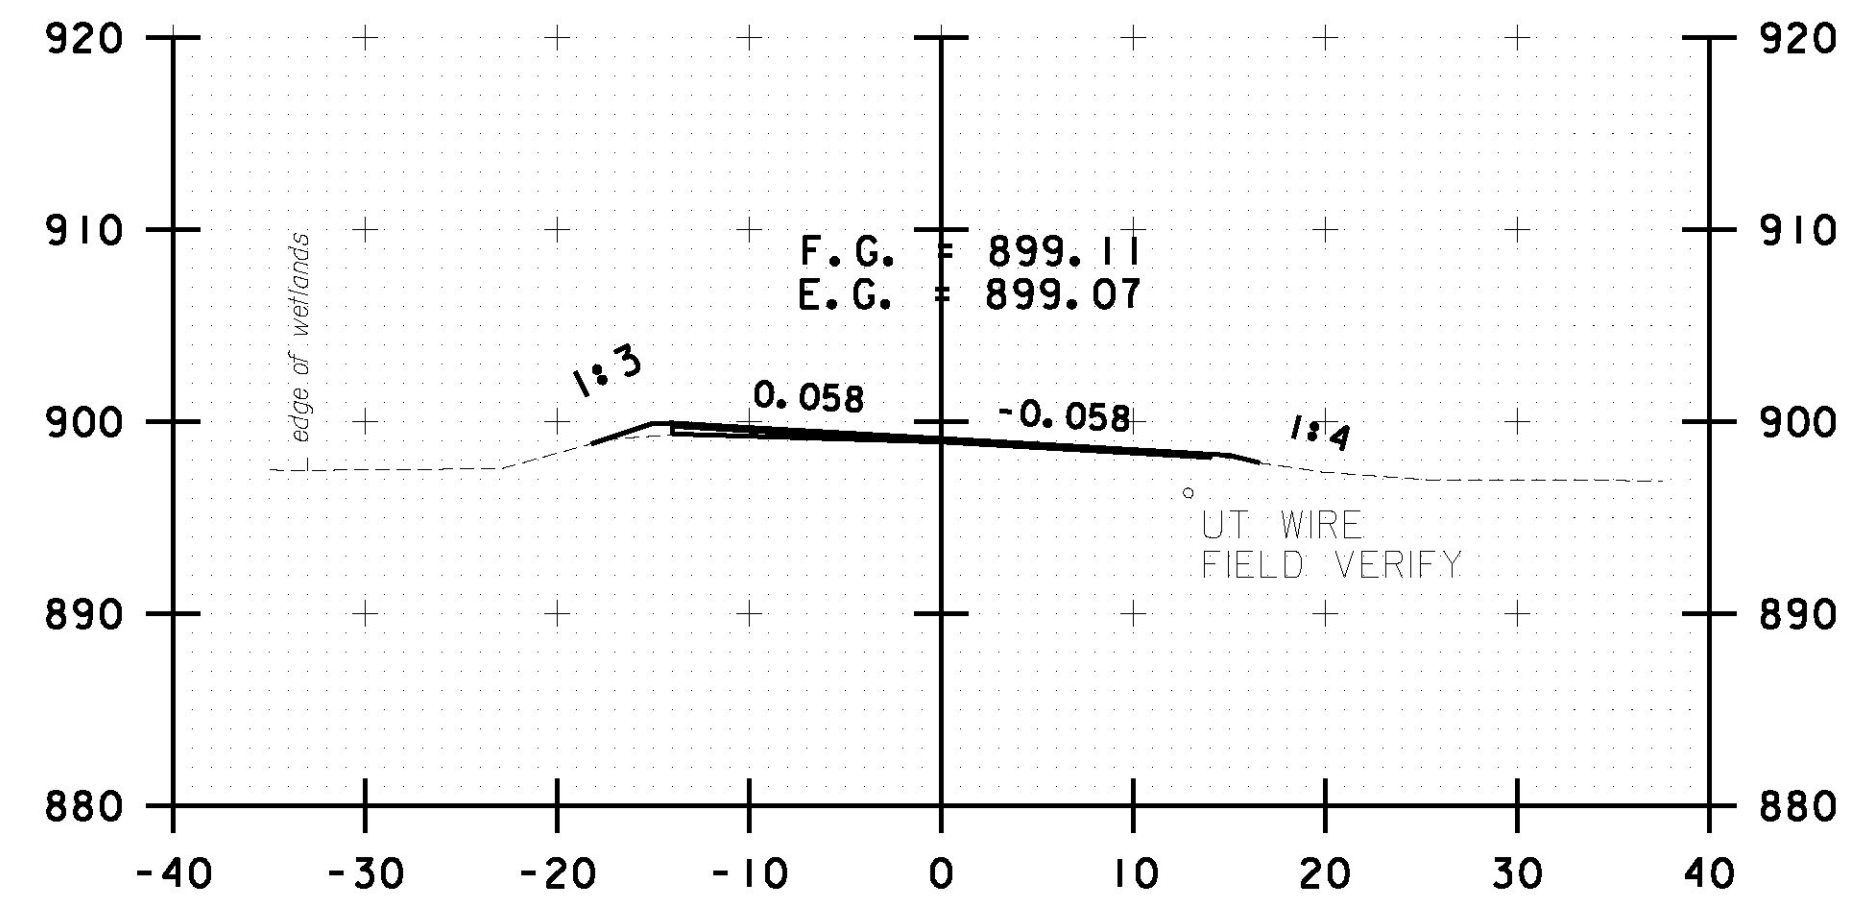


R 385+00.00

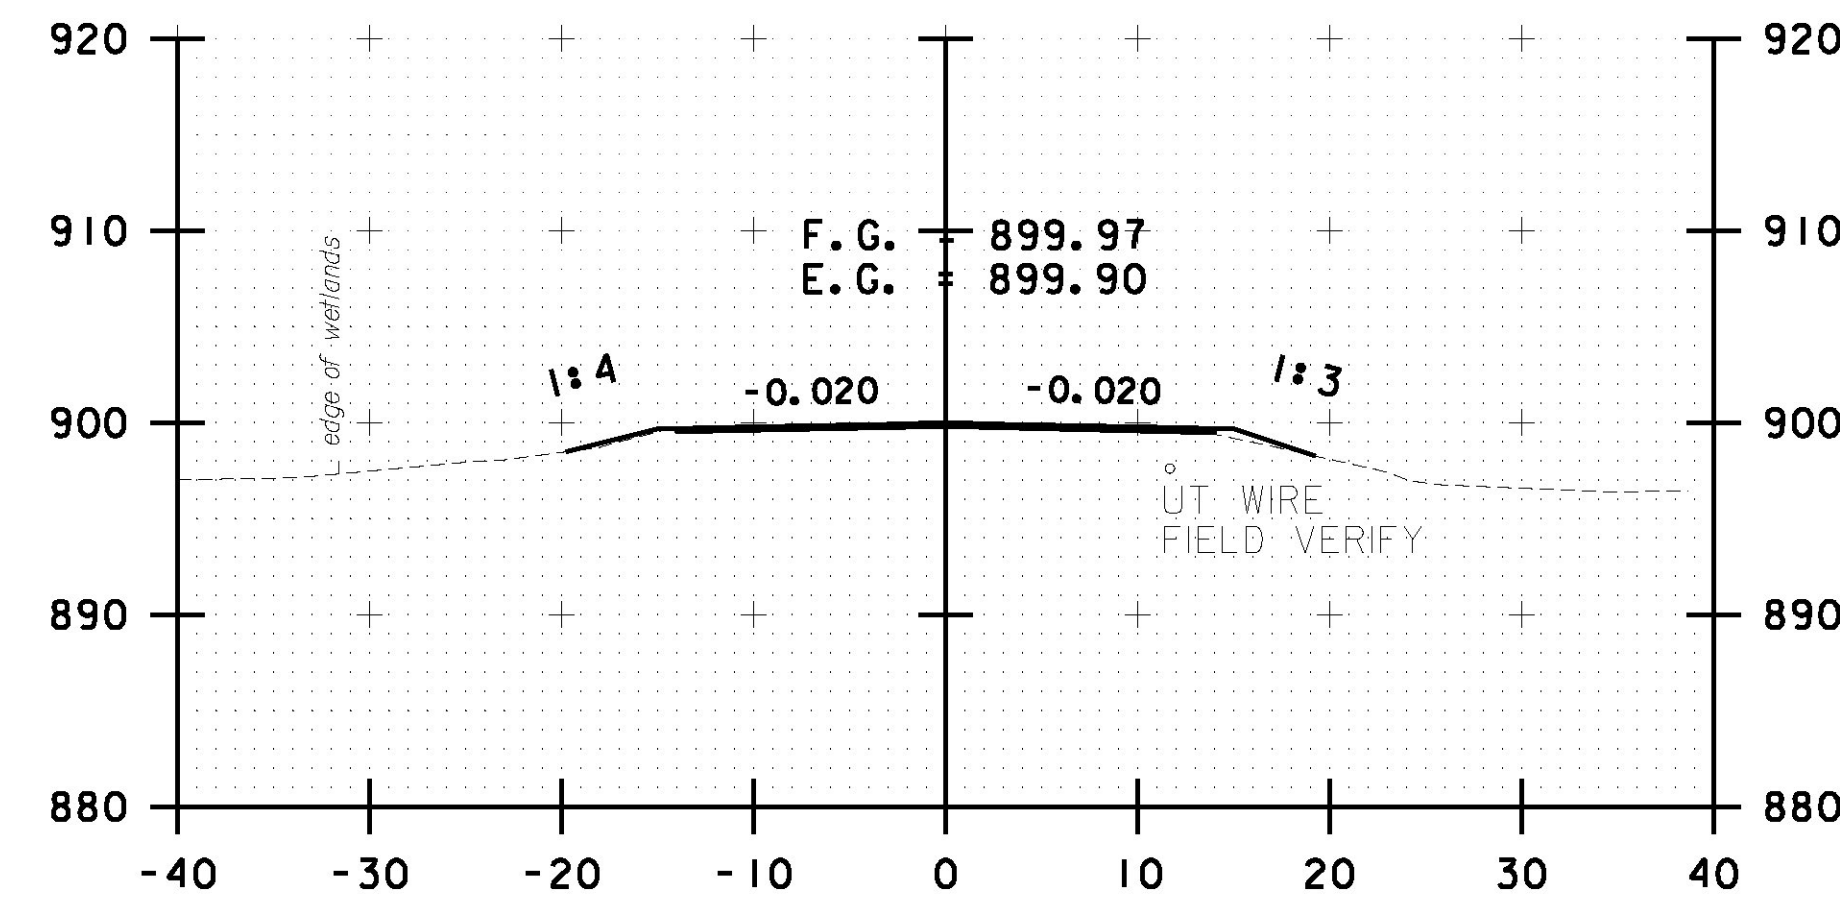


R 382+50.00

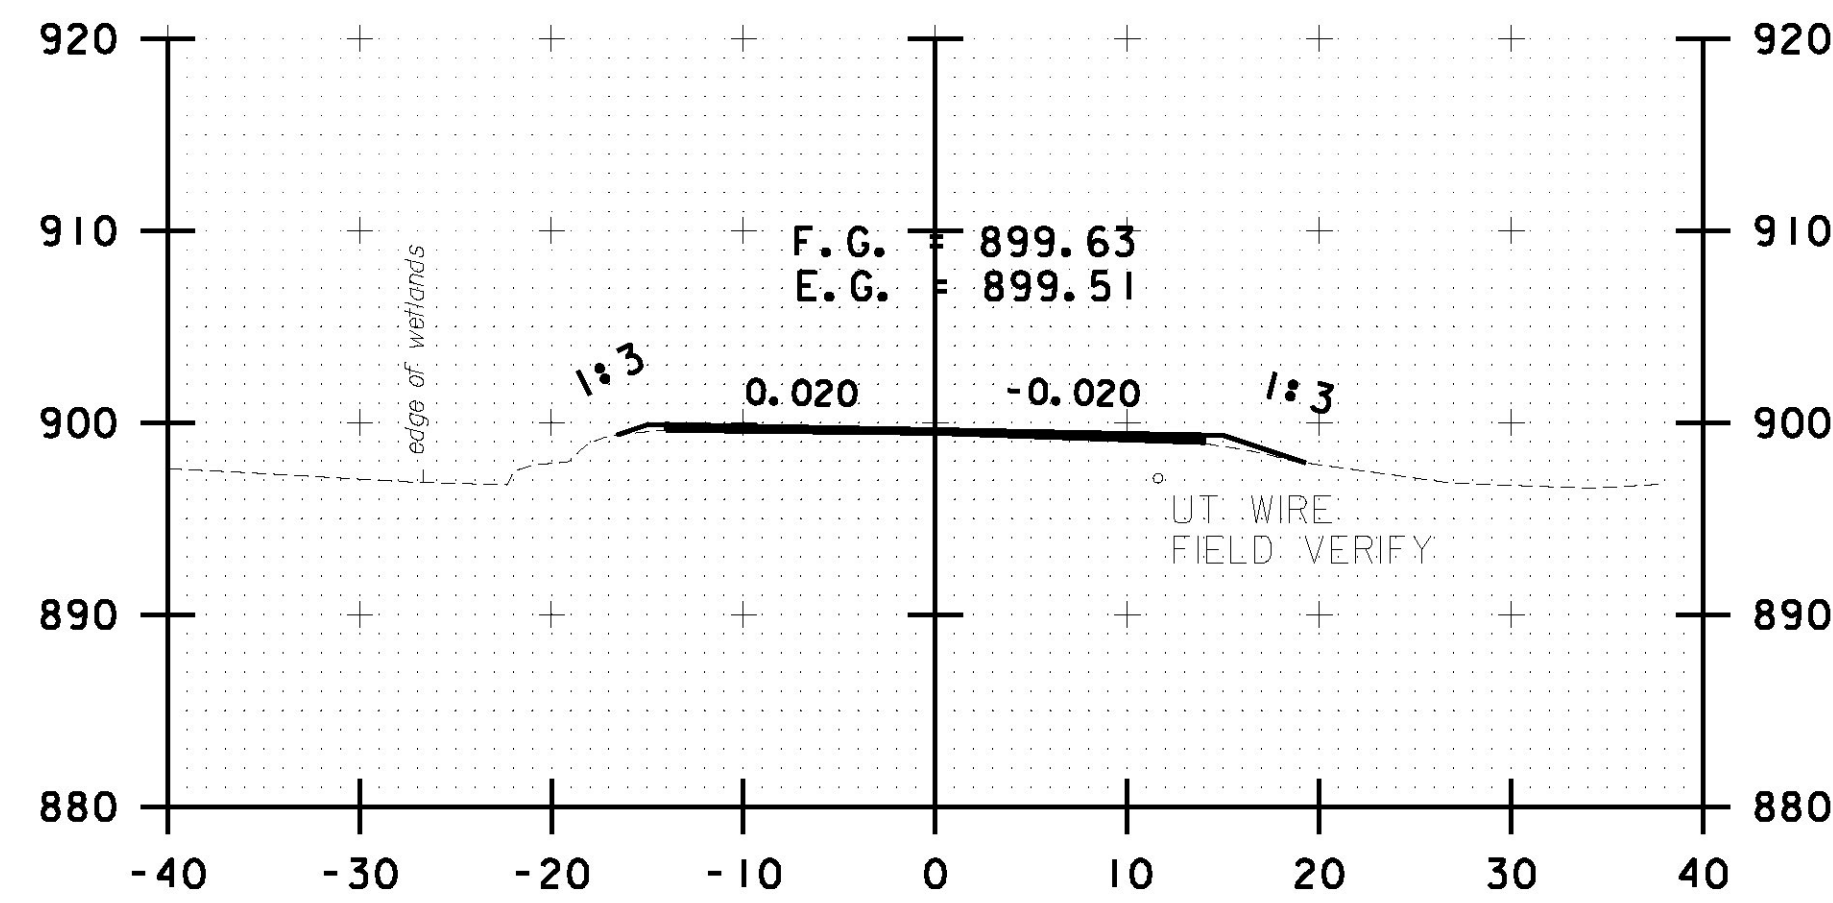


R 383+50.00

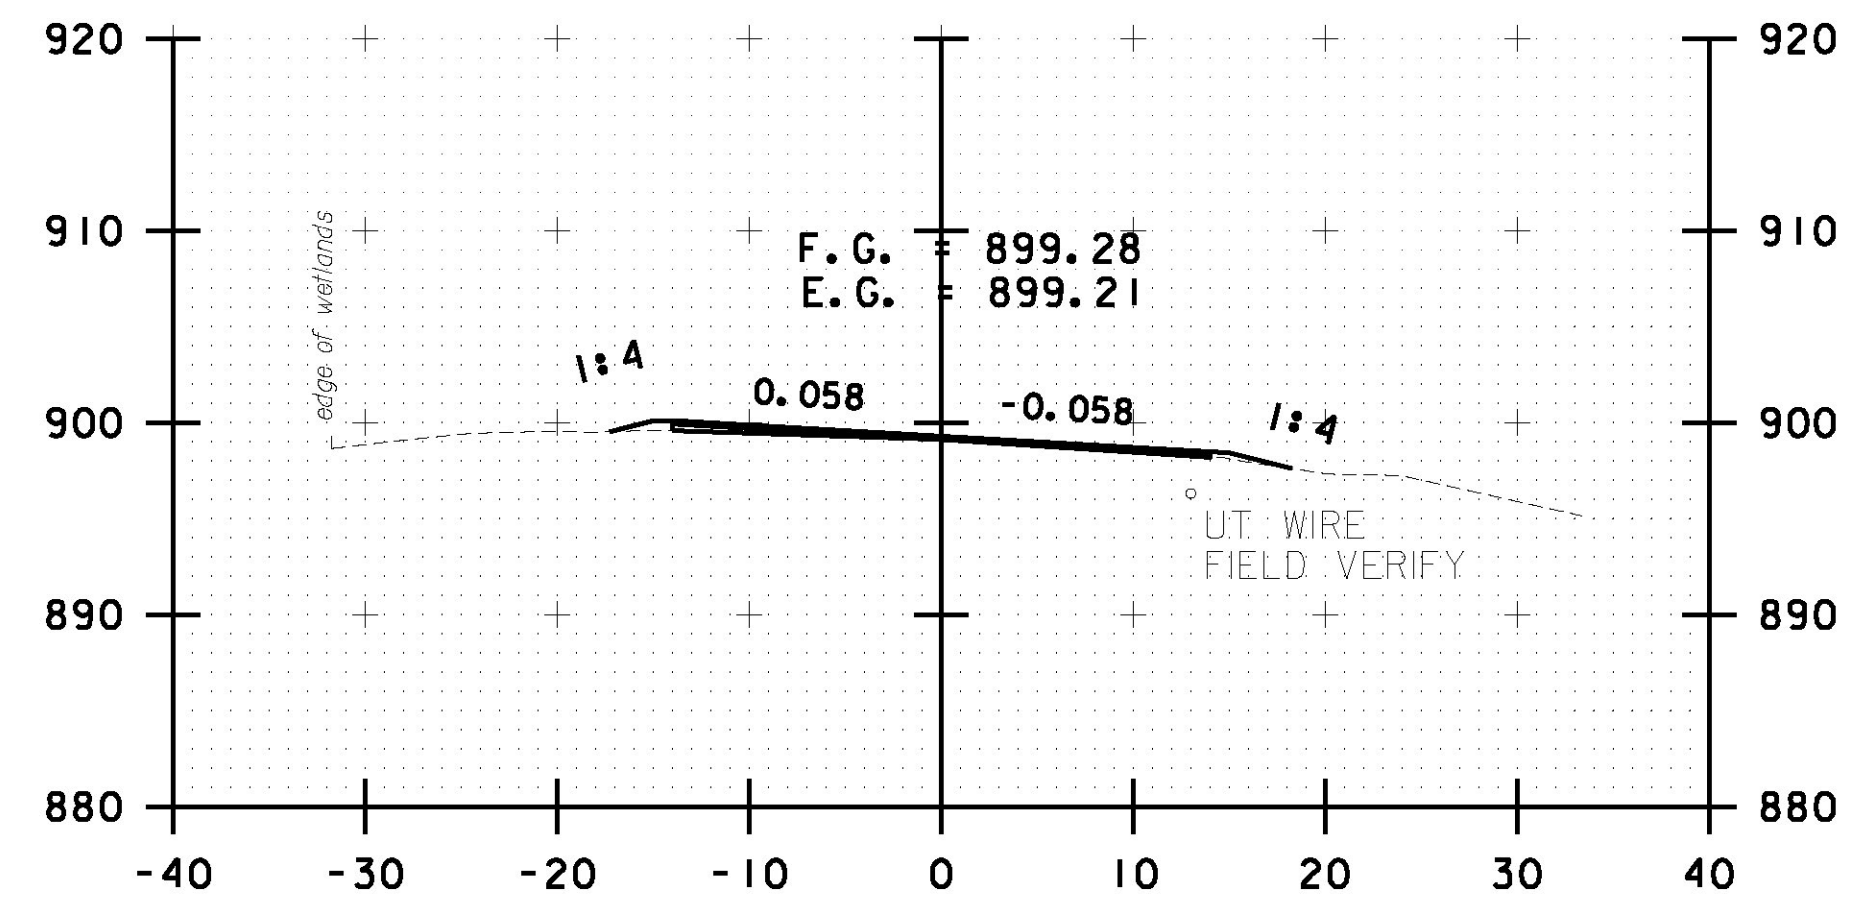


R 384+50.00

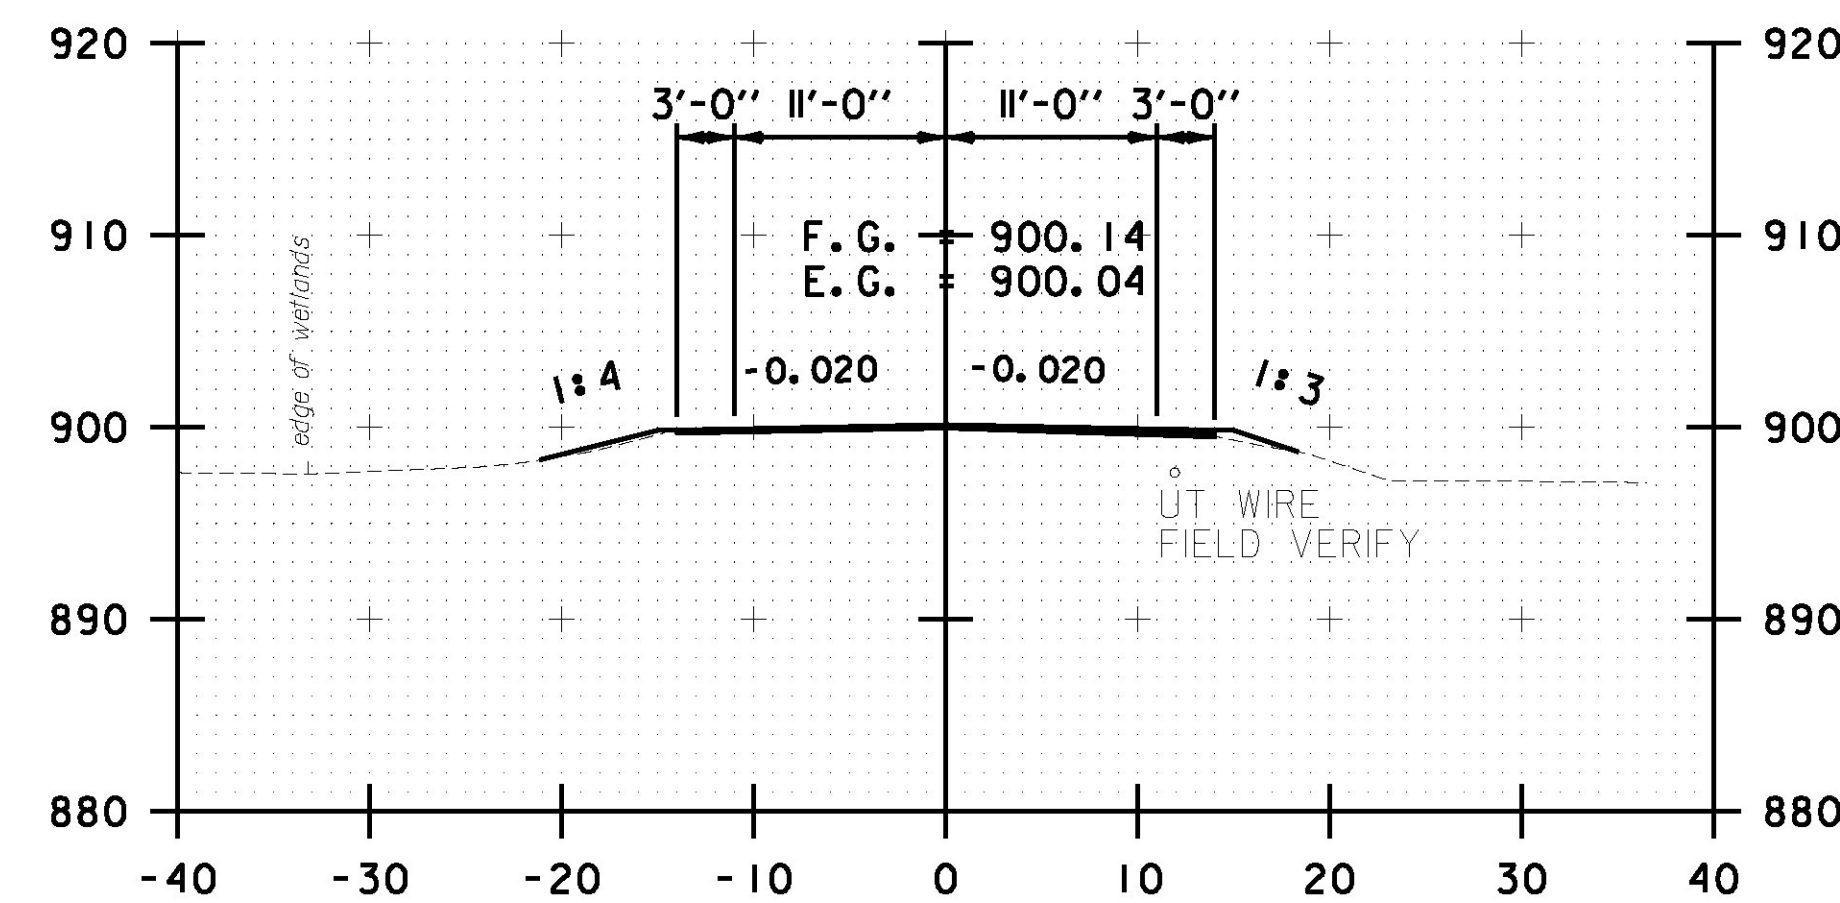


R 382+00.00

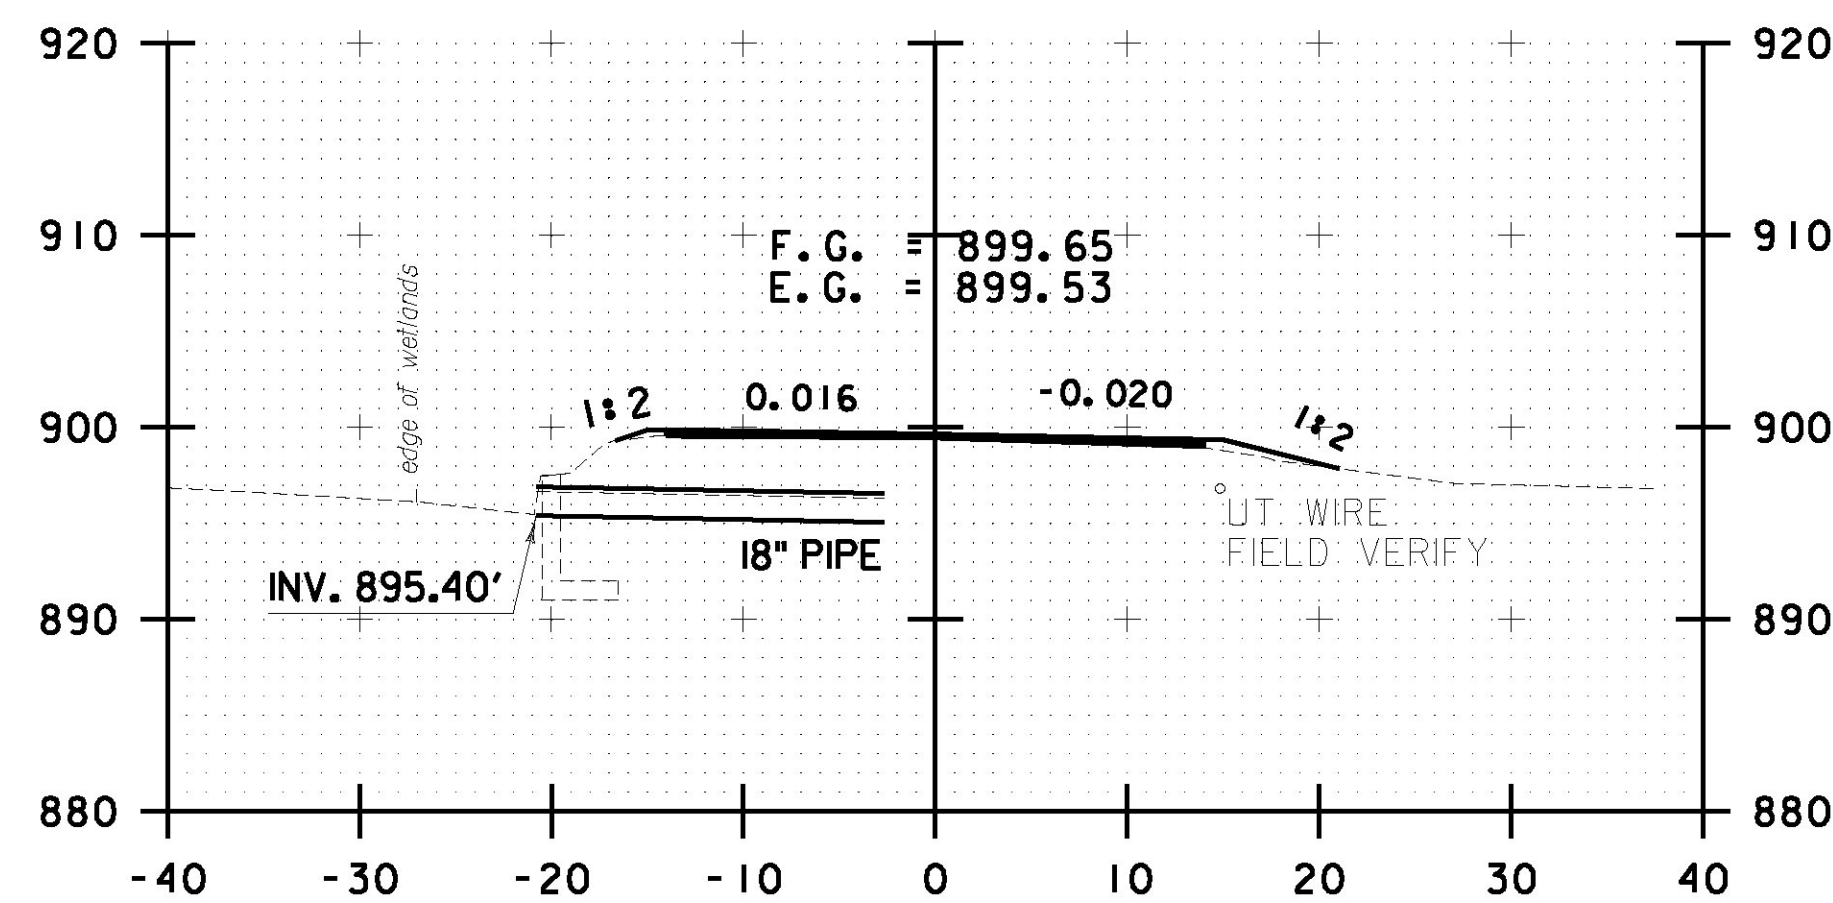

R 383+43.00

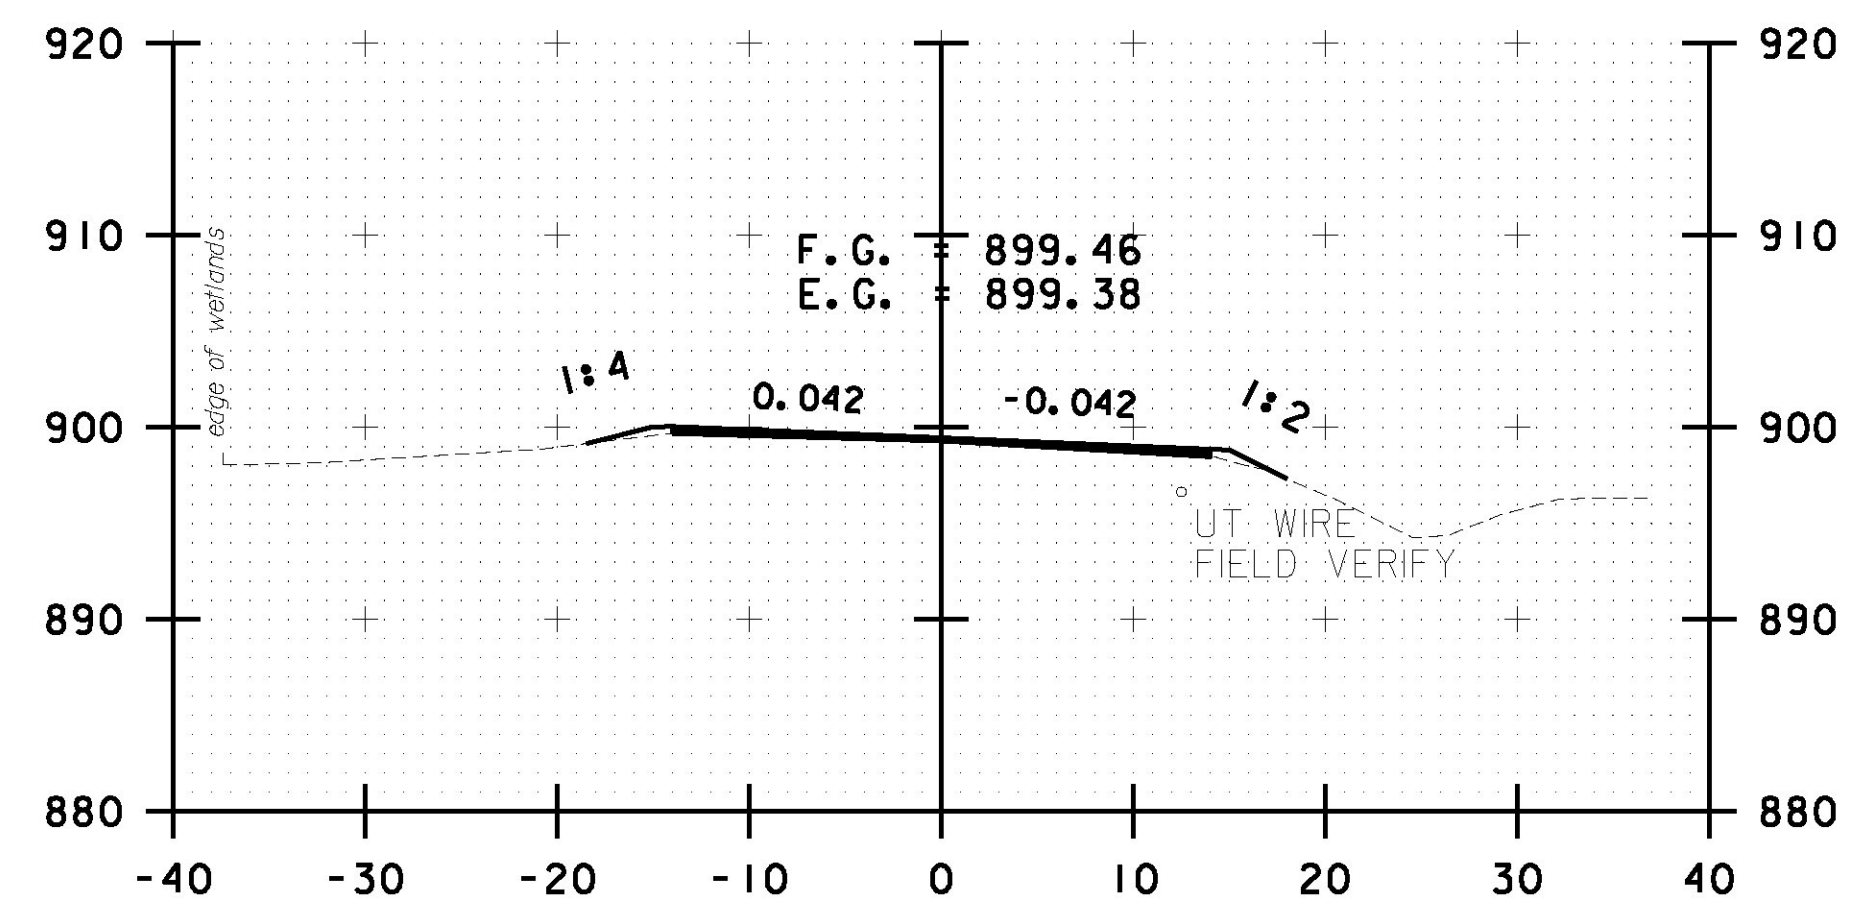

R 384+00.00

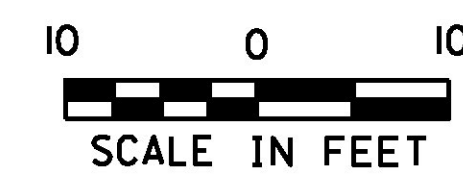

PROJECT NAME: ROCHESTER	
PROJECT NUMBER: ER STP 0162(21)	
FILE NAME: z13cl76xc.dgn	PLOT DATE: 1/12/2017
PROJECT LEADER: D. GOZALKOWSKI	DRAWN BY: J. HEALD
DESIGNED BY: J. OLSEN	CHECKED BY: J. SHIELDS
ROCHESTER CROSS SECTION SHEET #132	SHEET 321 OF 360