




R 392+50.00

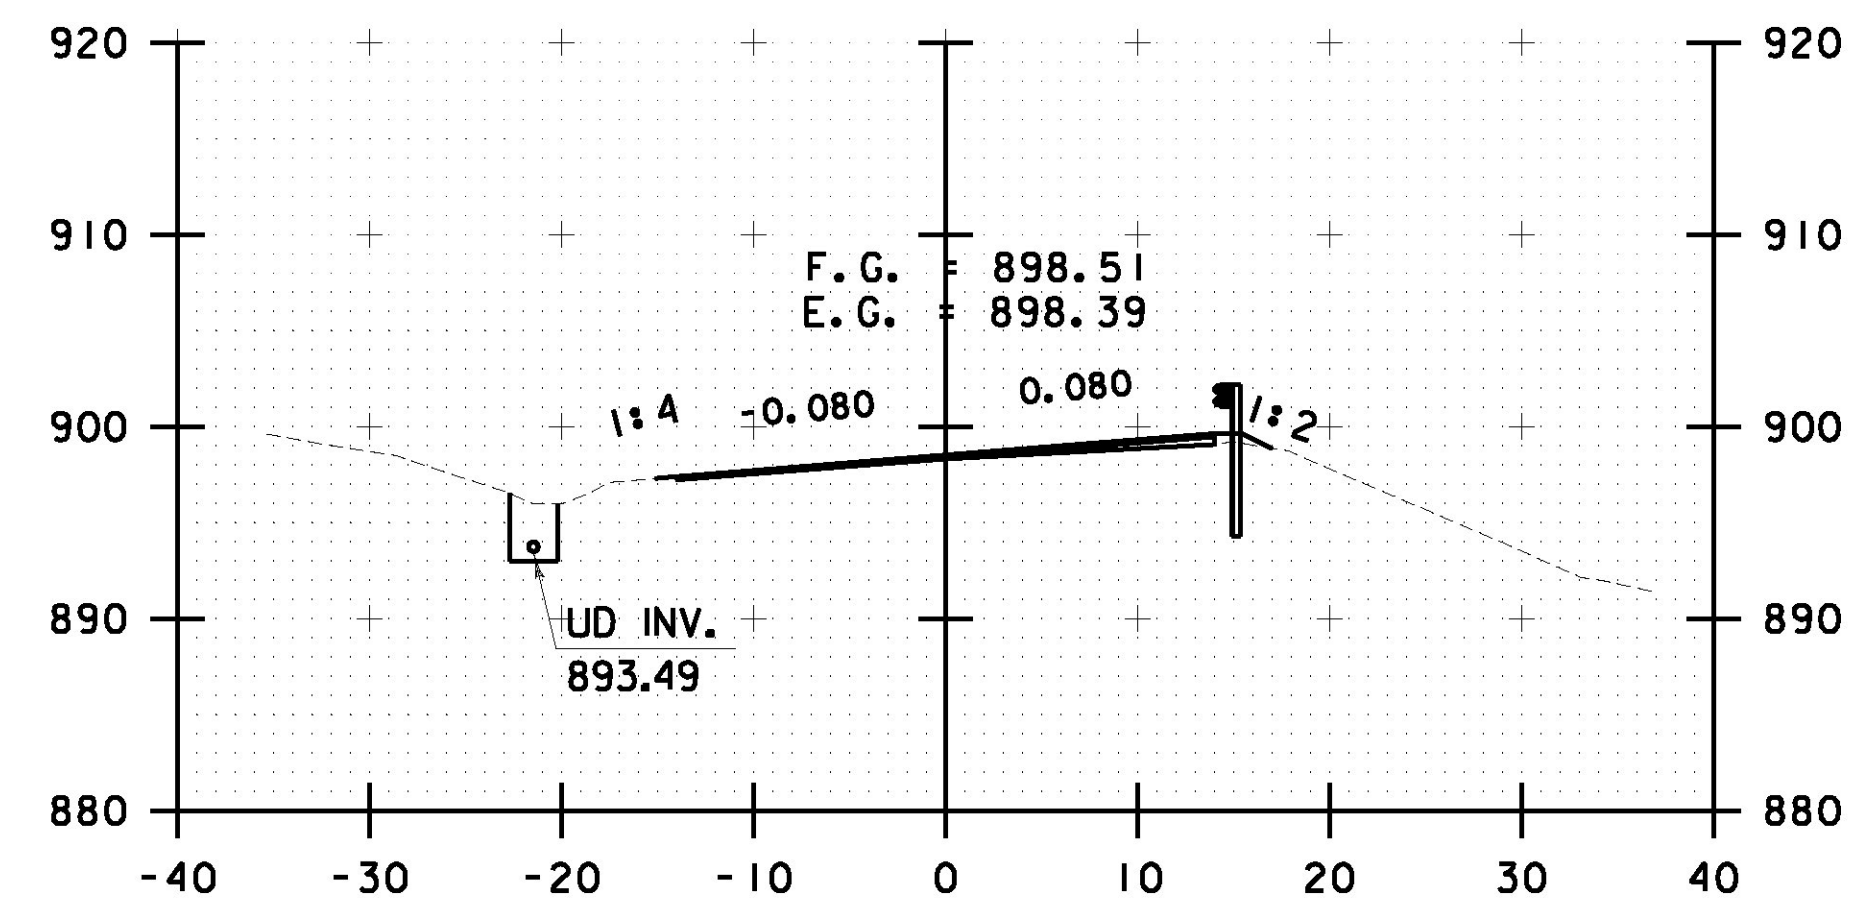


R 392+00.00

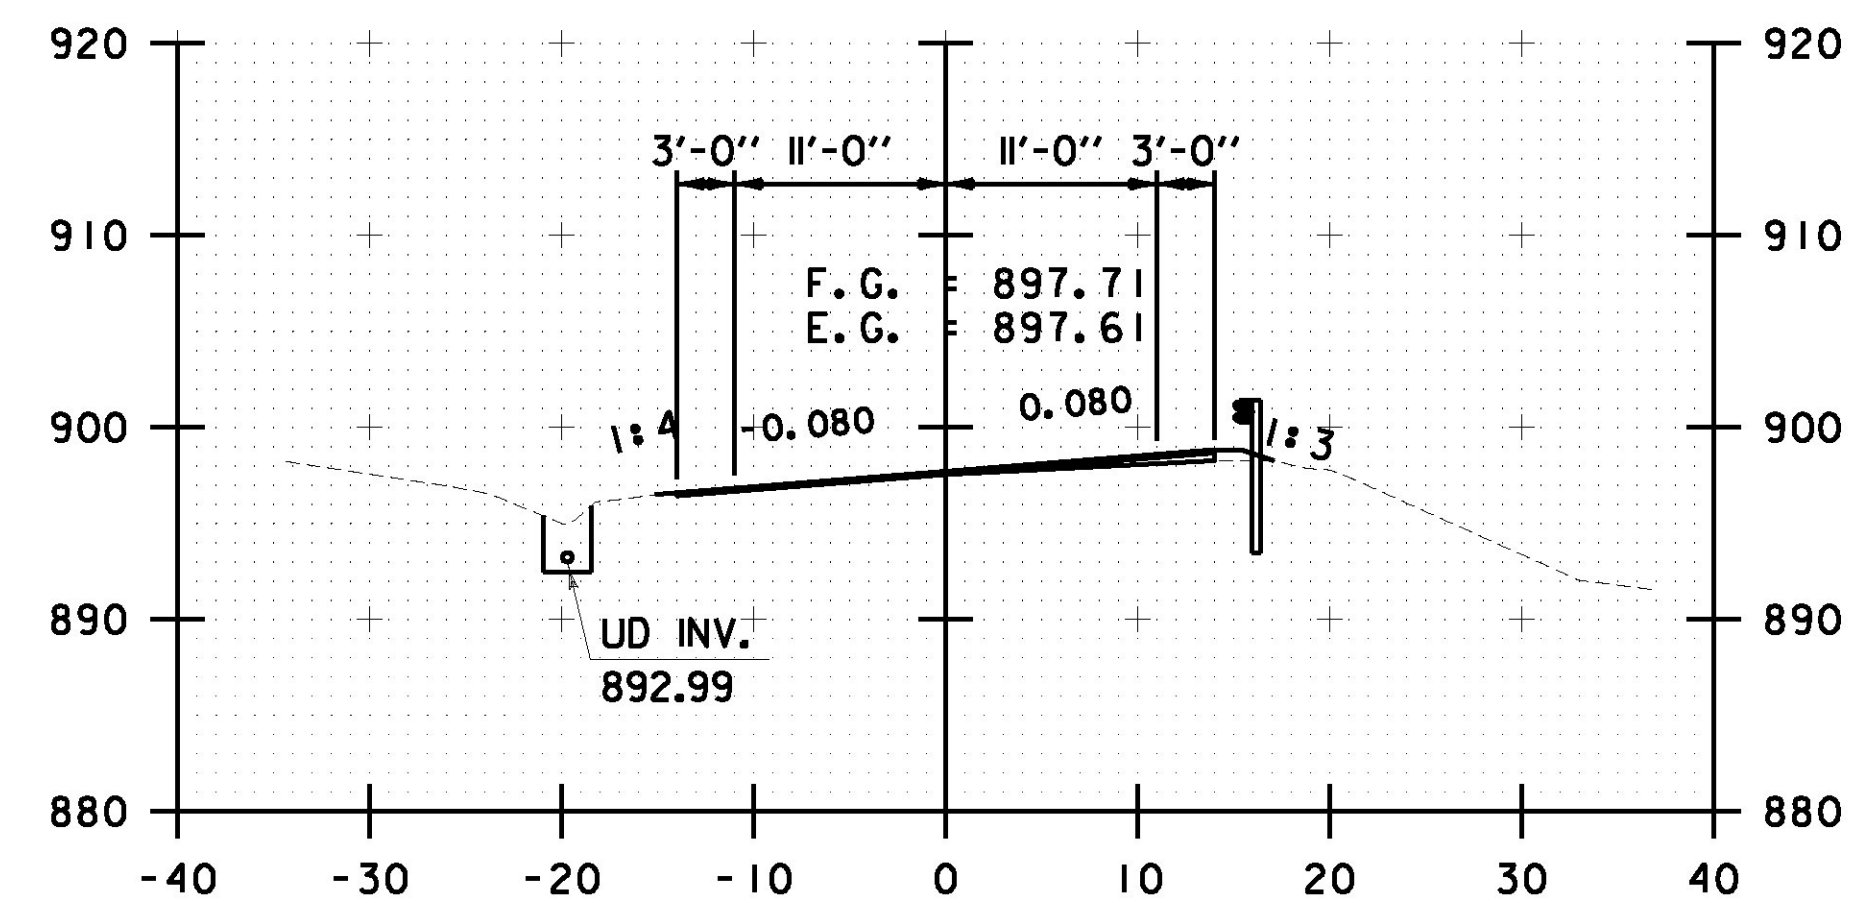


R 391+50.00

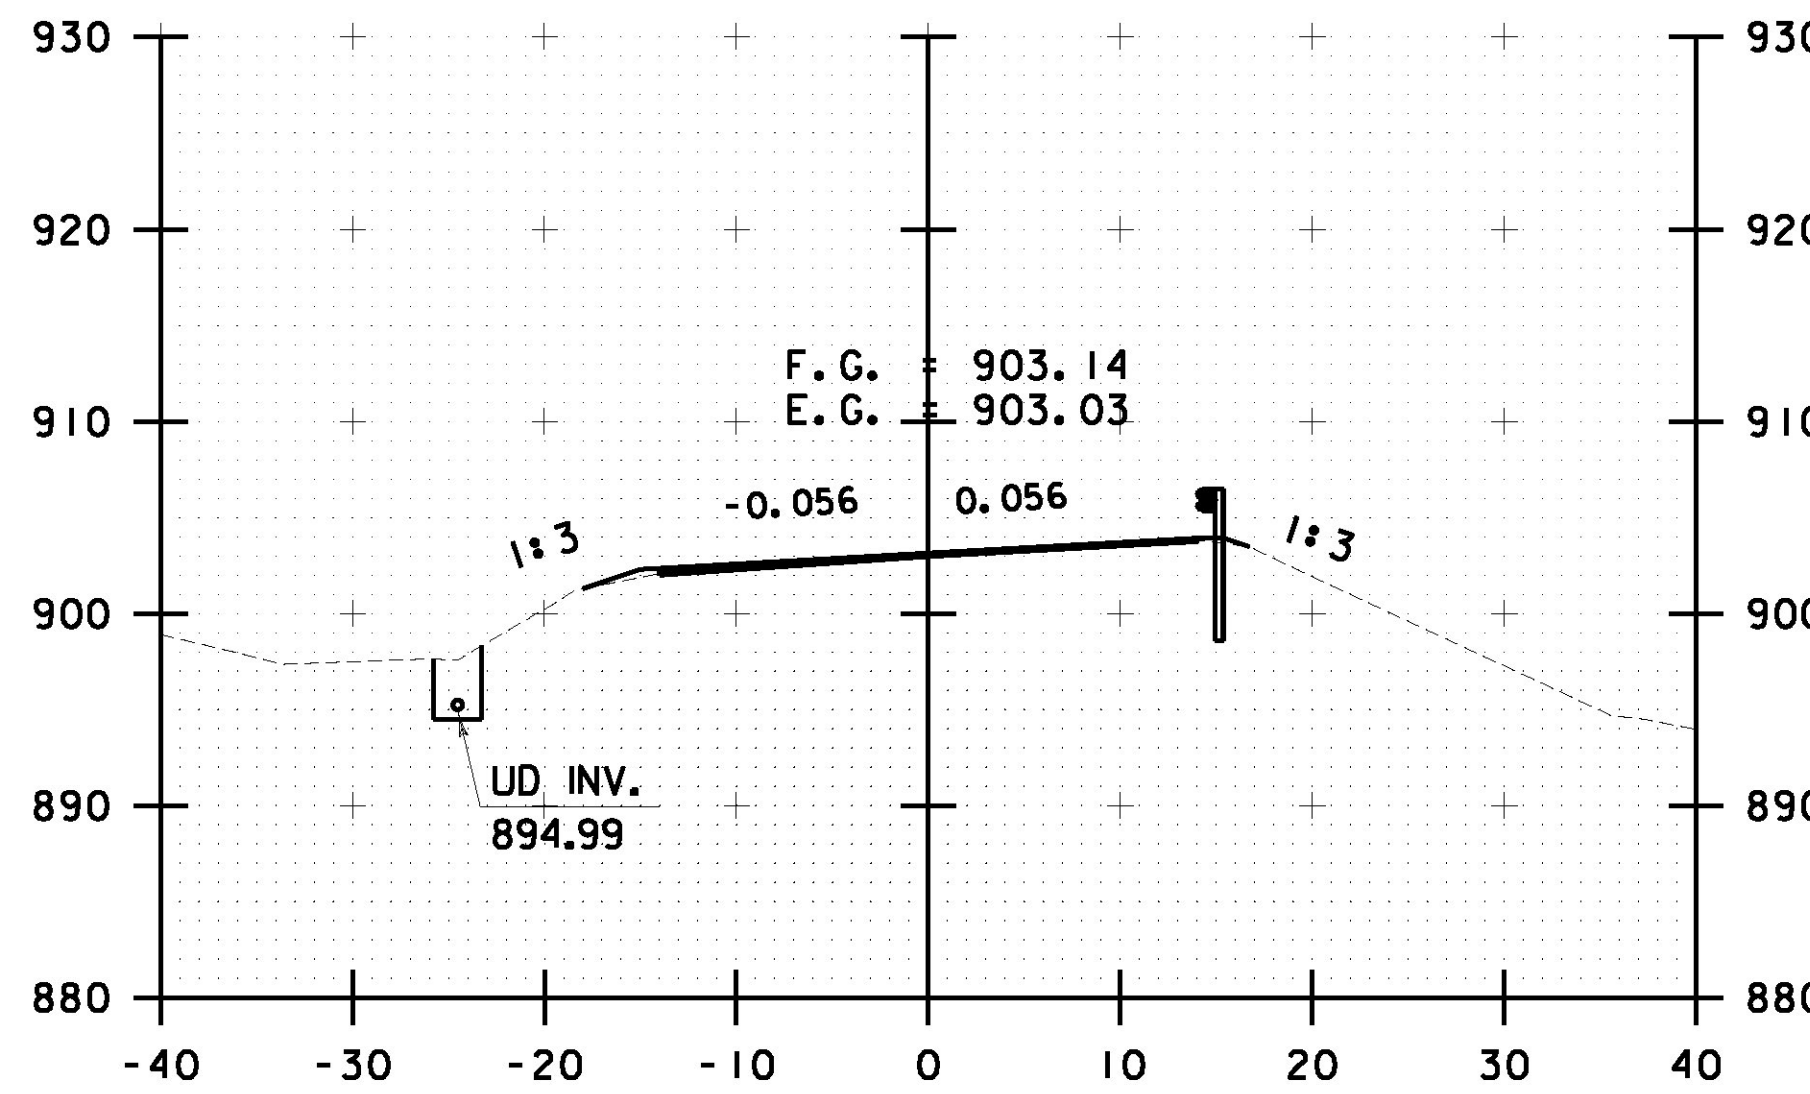


R 393+50.00

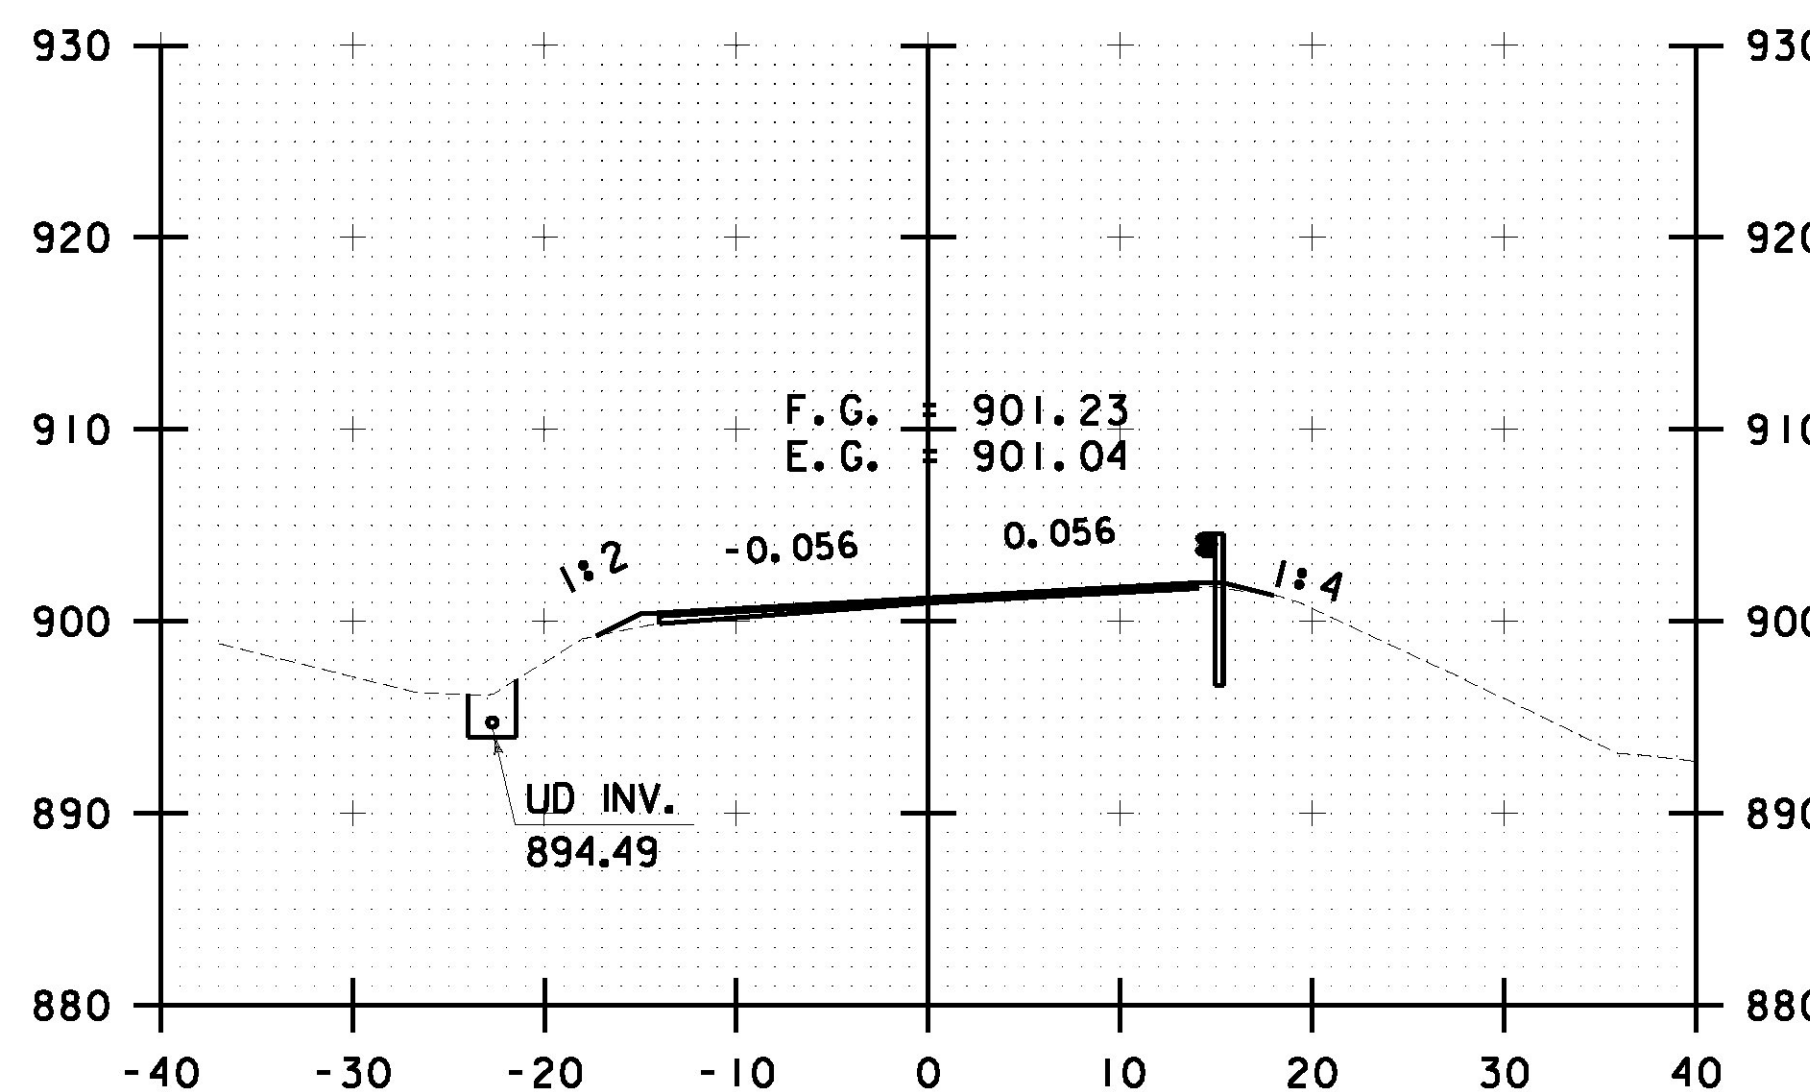


R 393+00.00

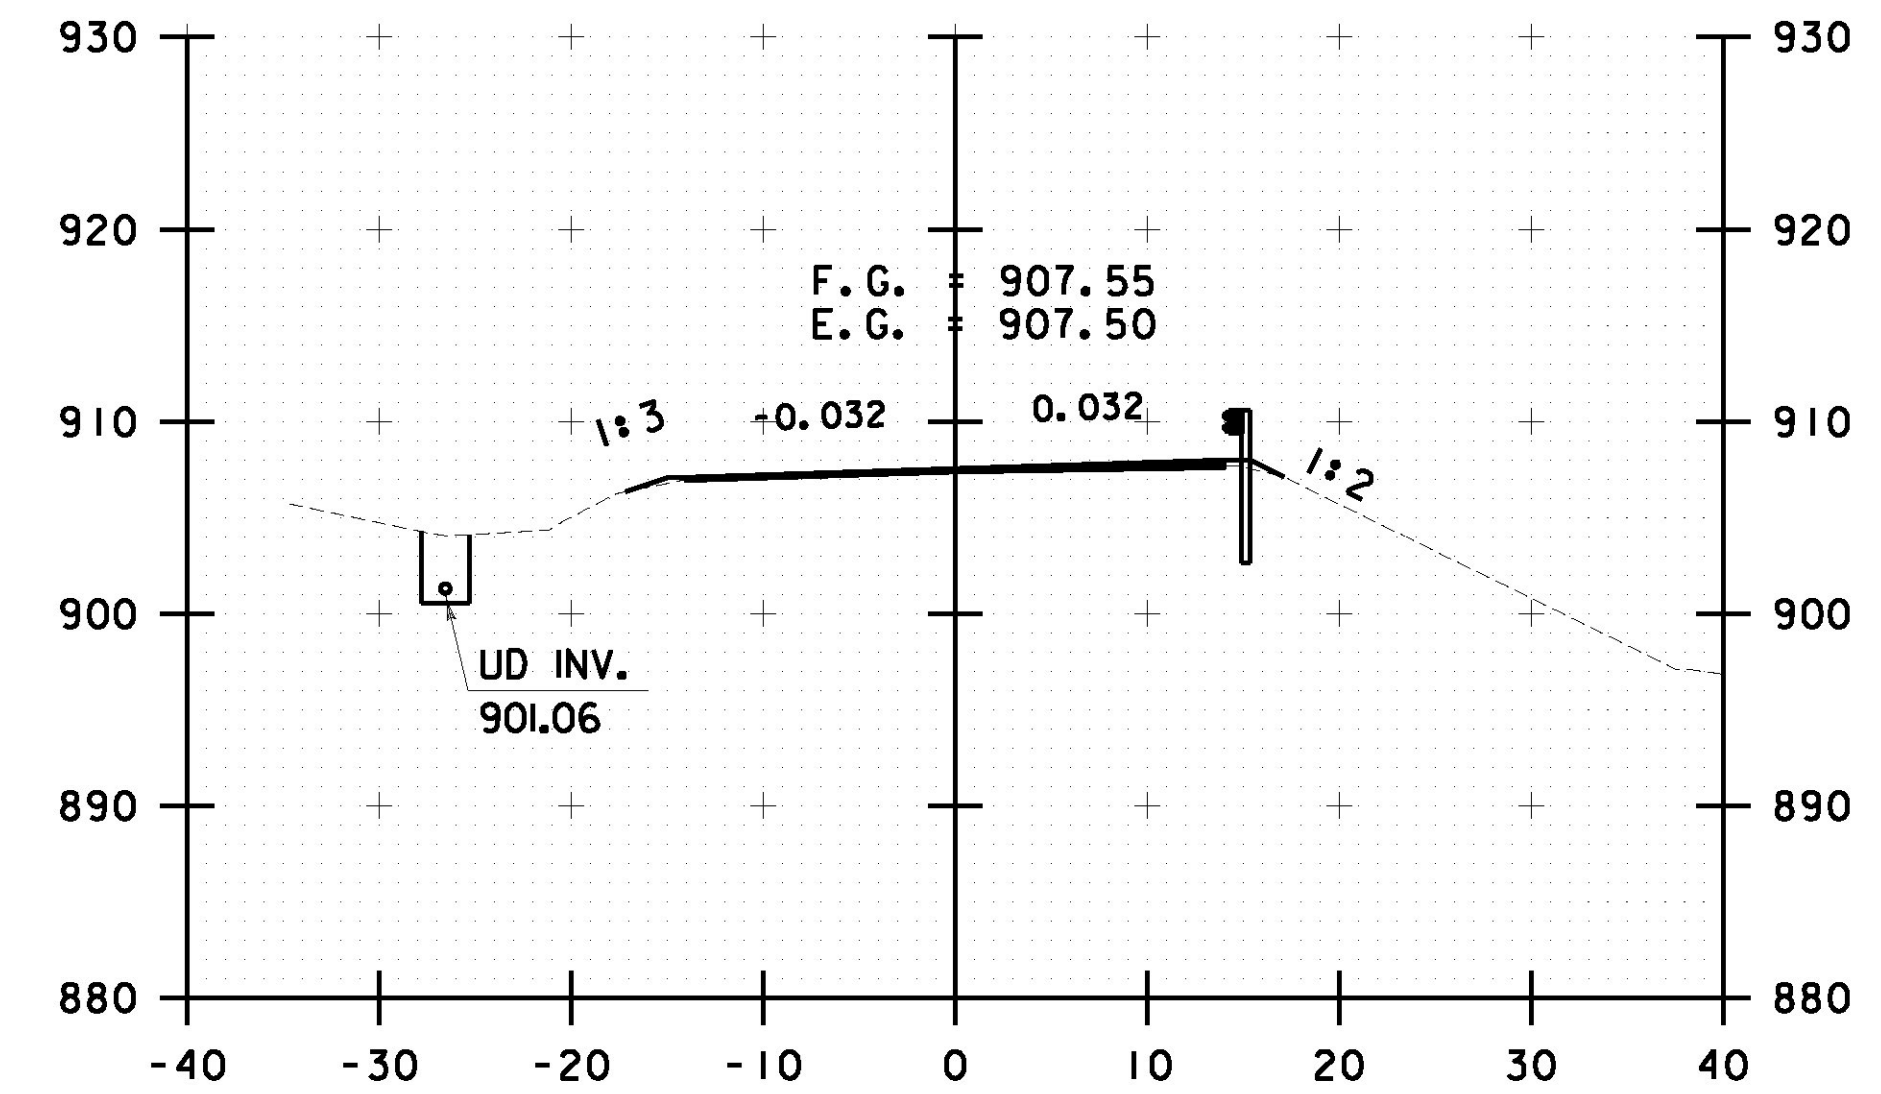

R 394+50.00

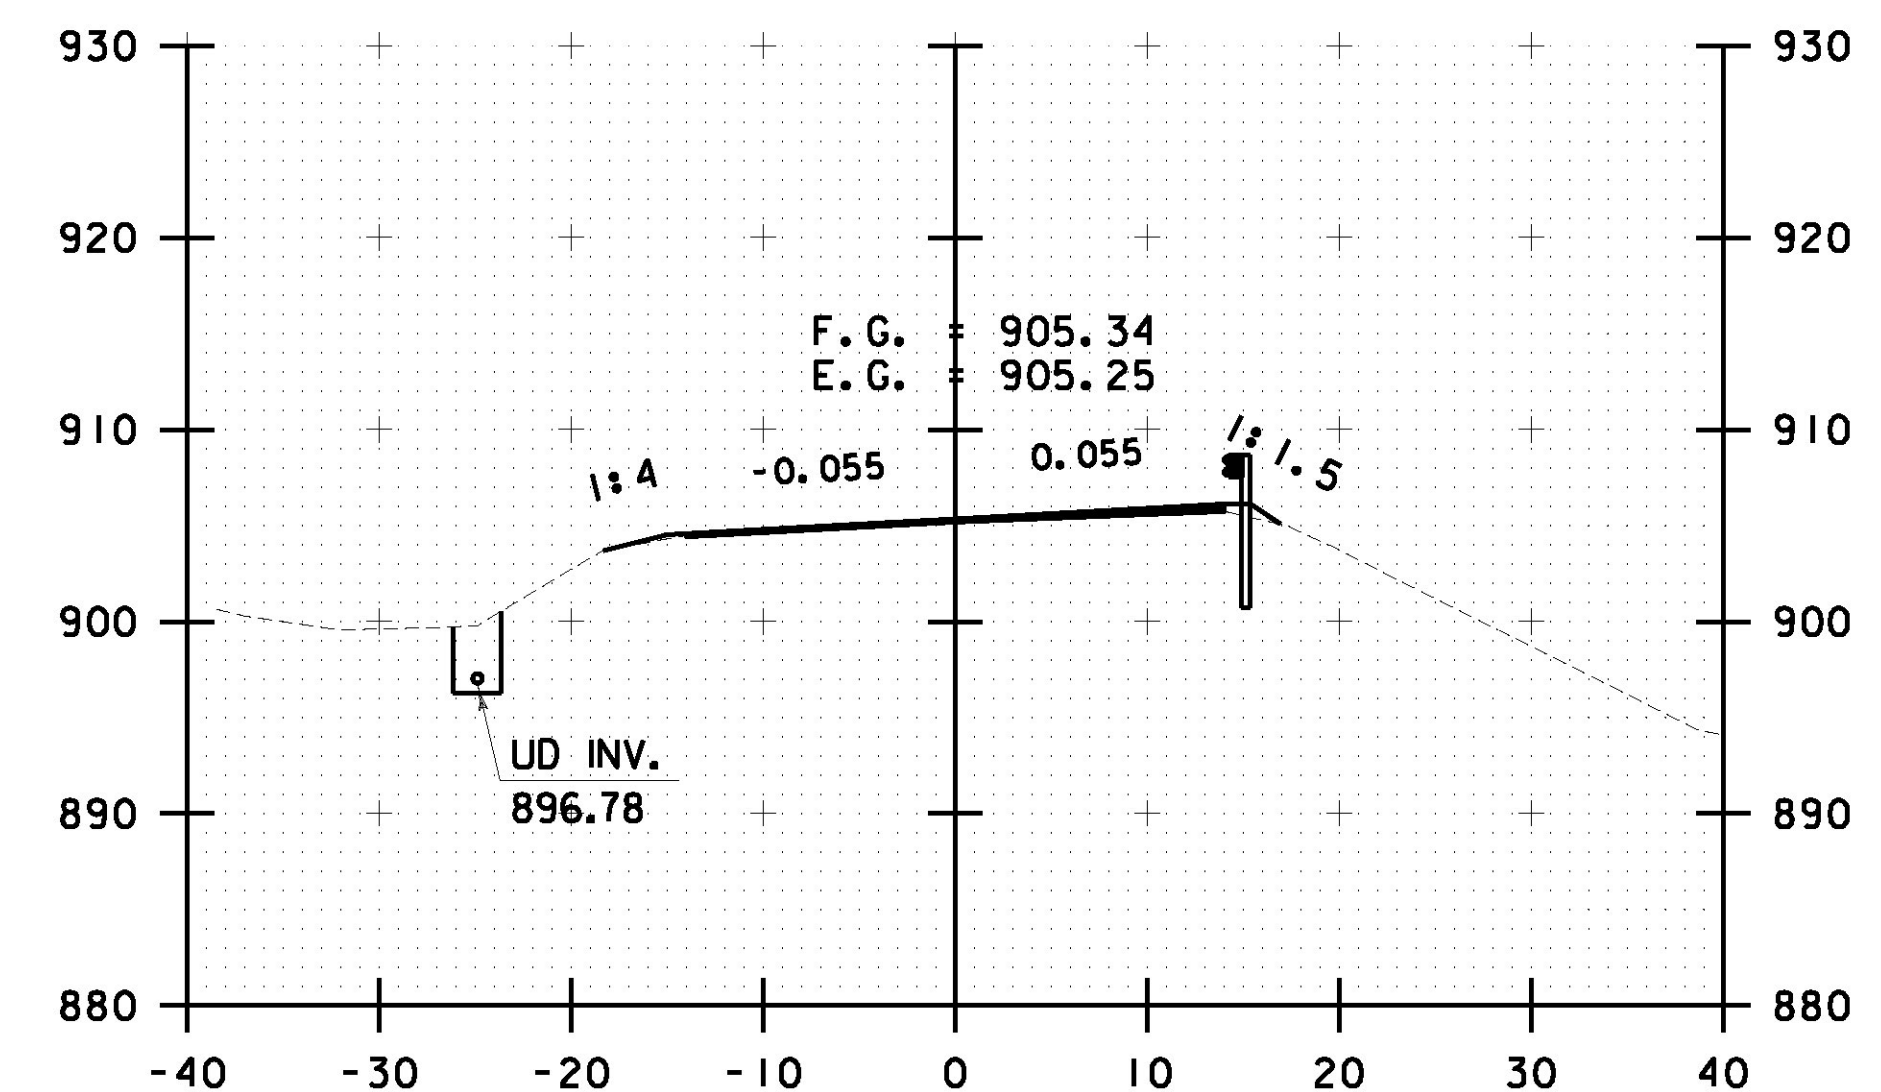

R 394+00.00

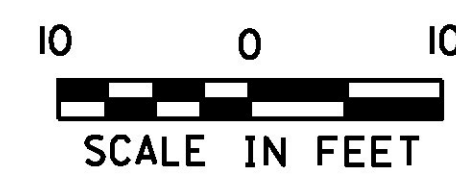

PROJECT NAME: ROCHESTER
PROJECT NUMBER: ER STP 0162(21)

FILE NAME: z13cl76xc.dgn
PROJECT LEADER: D. GOZALKOWSKI
DESIGNED BY: J. OLSEN
ROCHESTER CROSS SECTION SHEET #135

PLOT DATE: 1/12/2017
DRAWN BY: J. HEALD
CHECKED BY: J. SHIELDS
SHEET 324 OF 360