




R 411+50.00

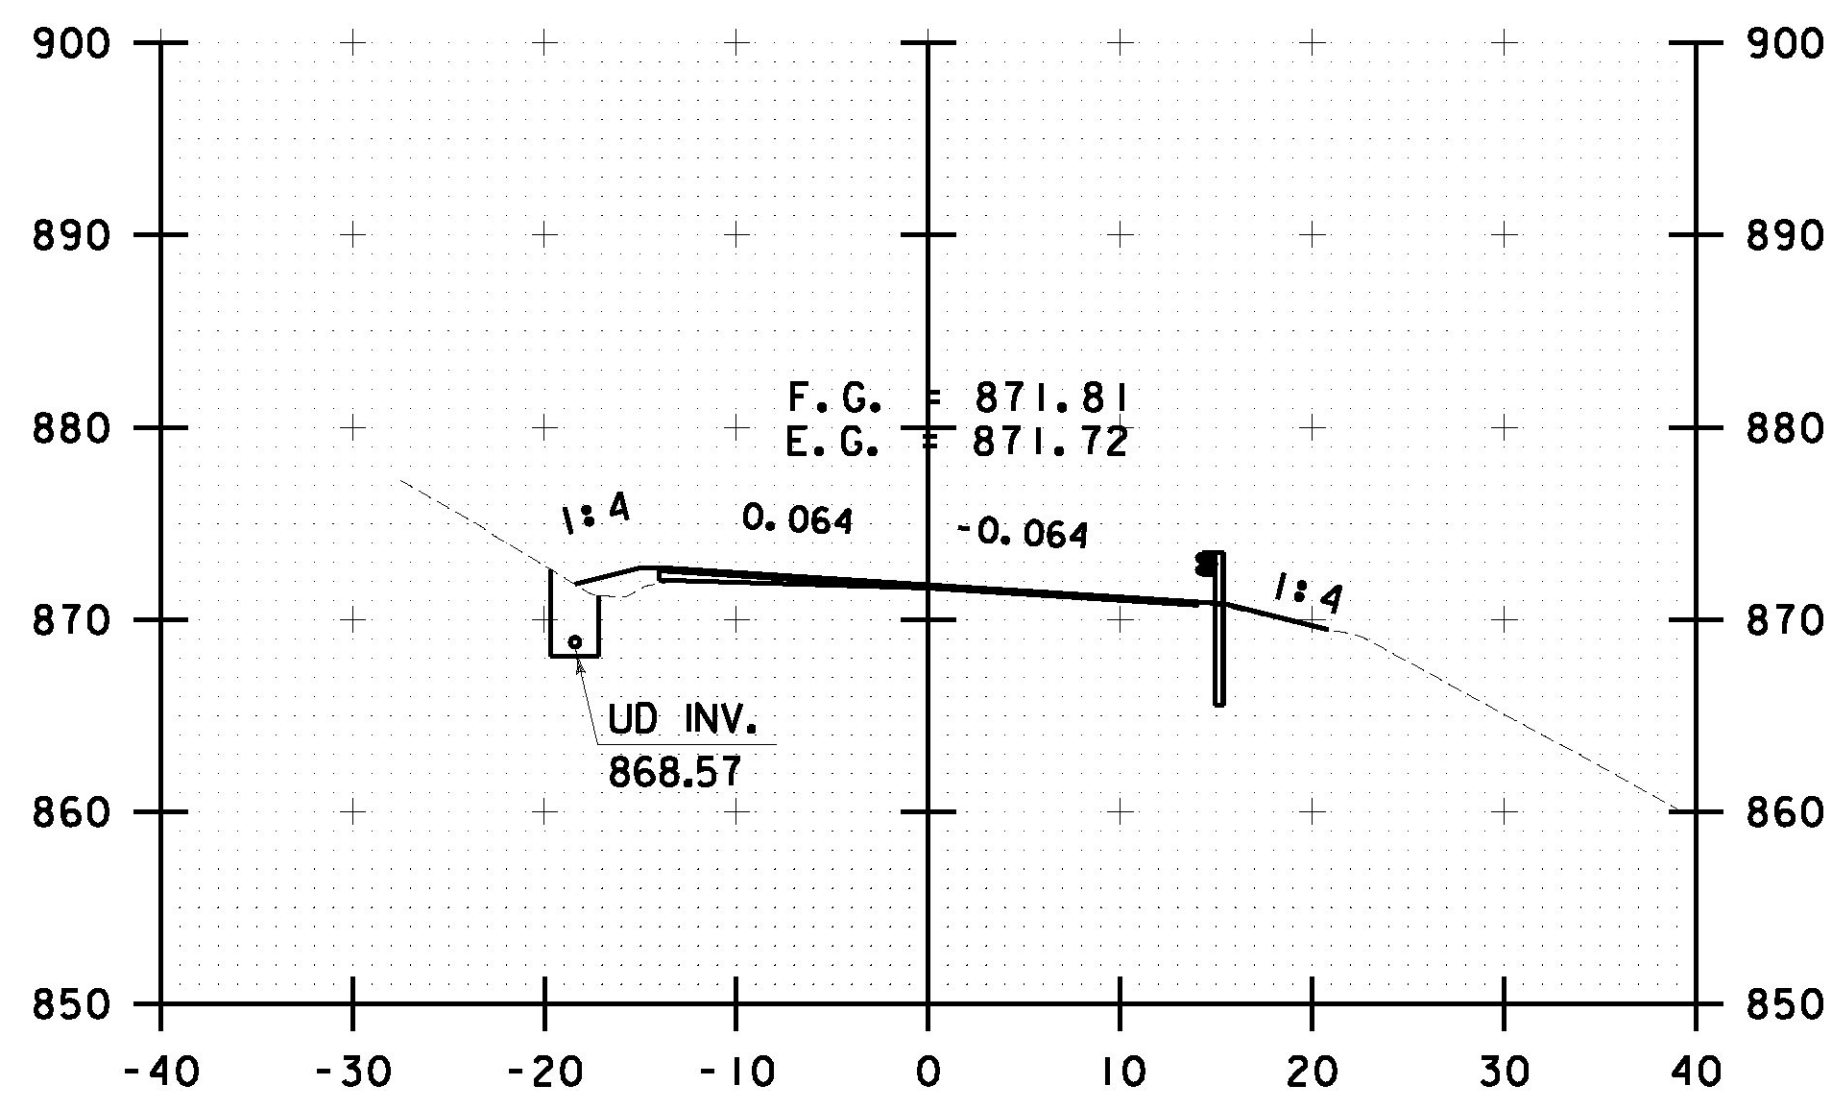


R 412+50.00

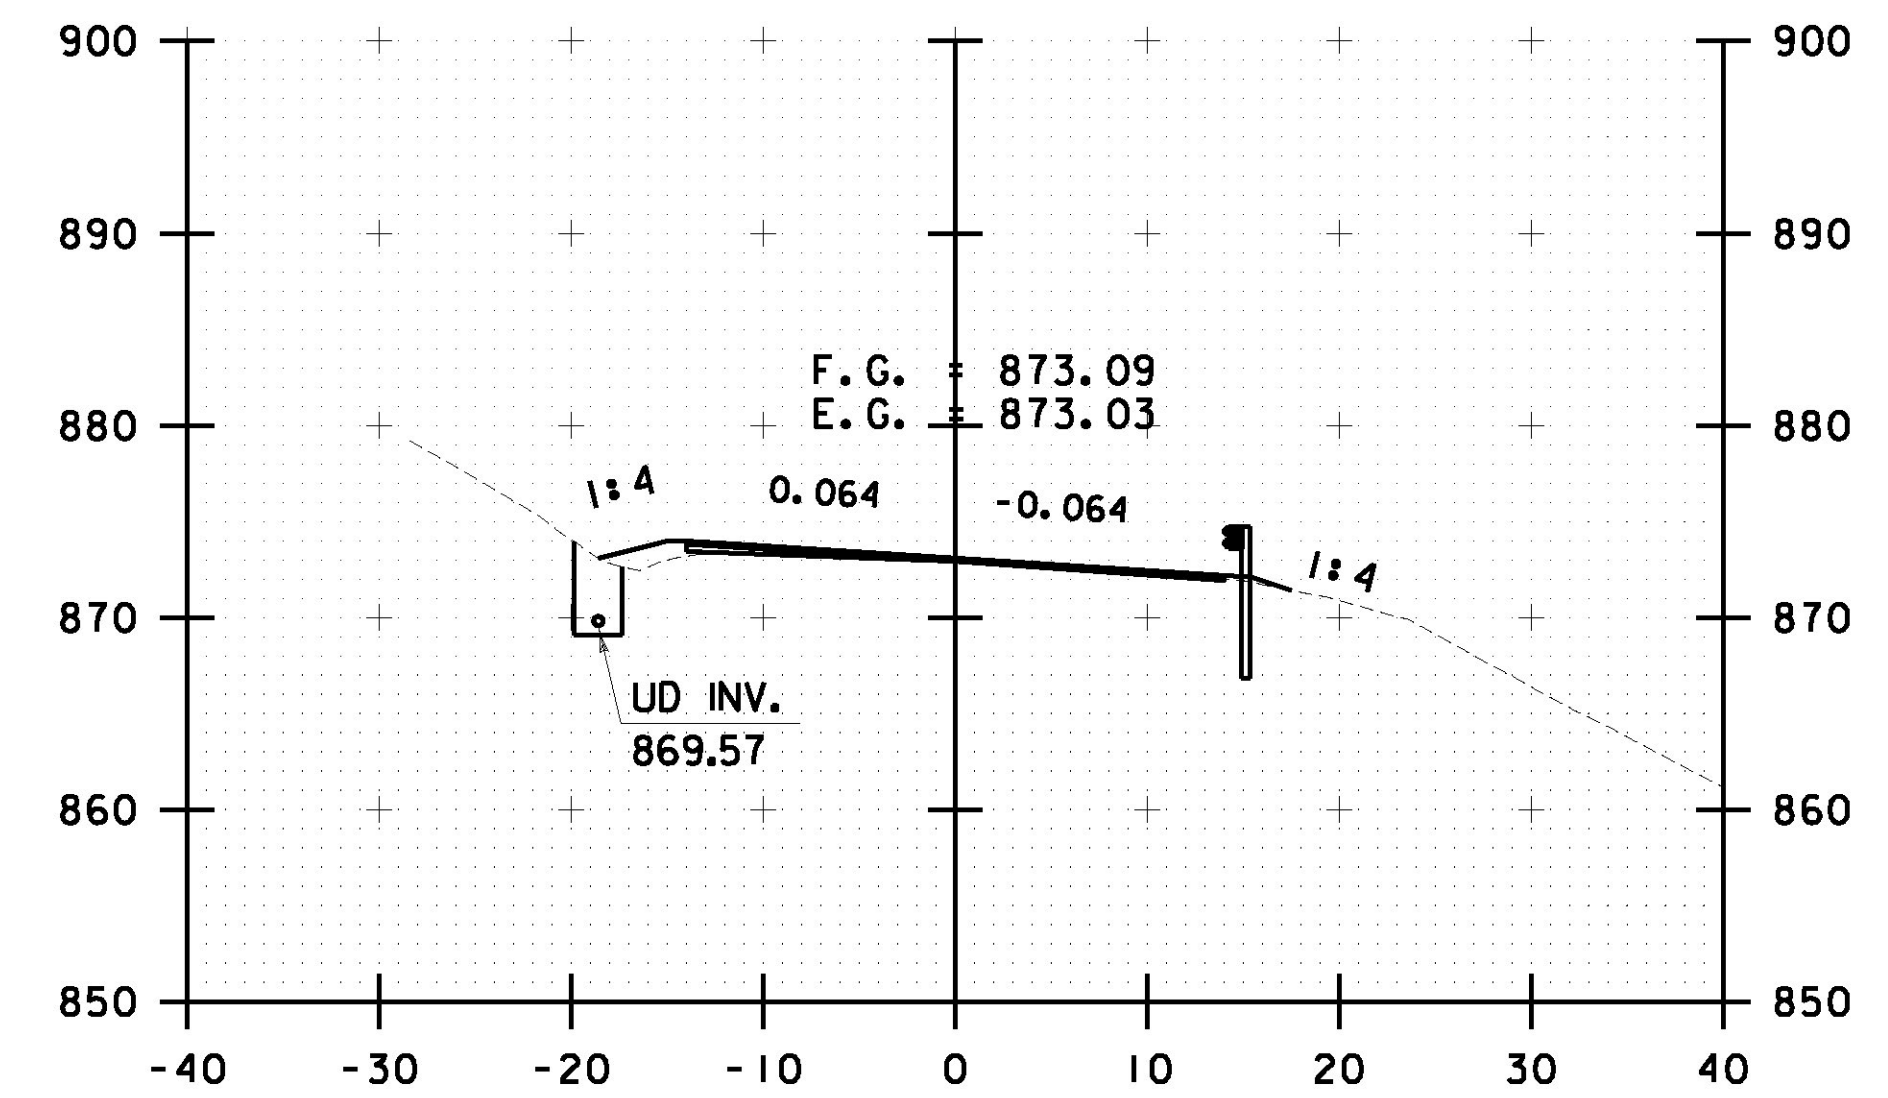


R 413+50.00

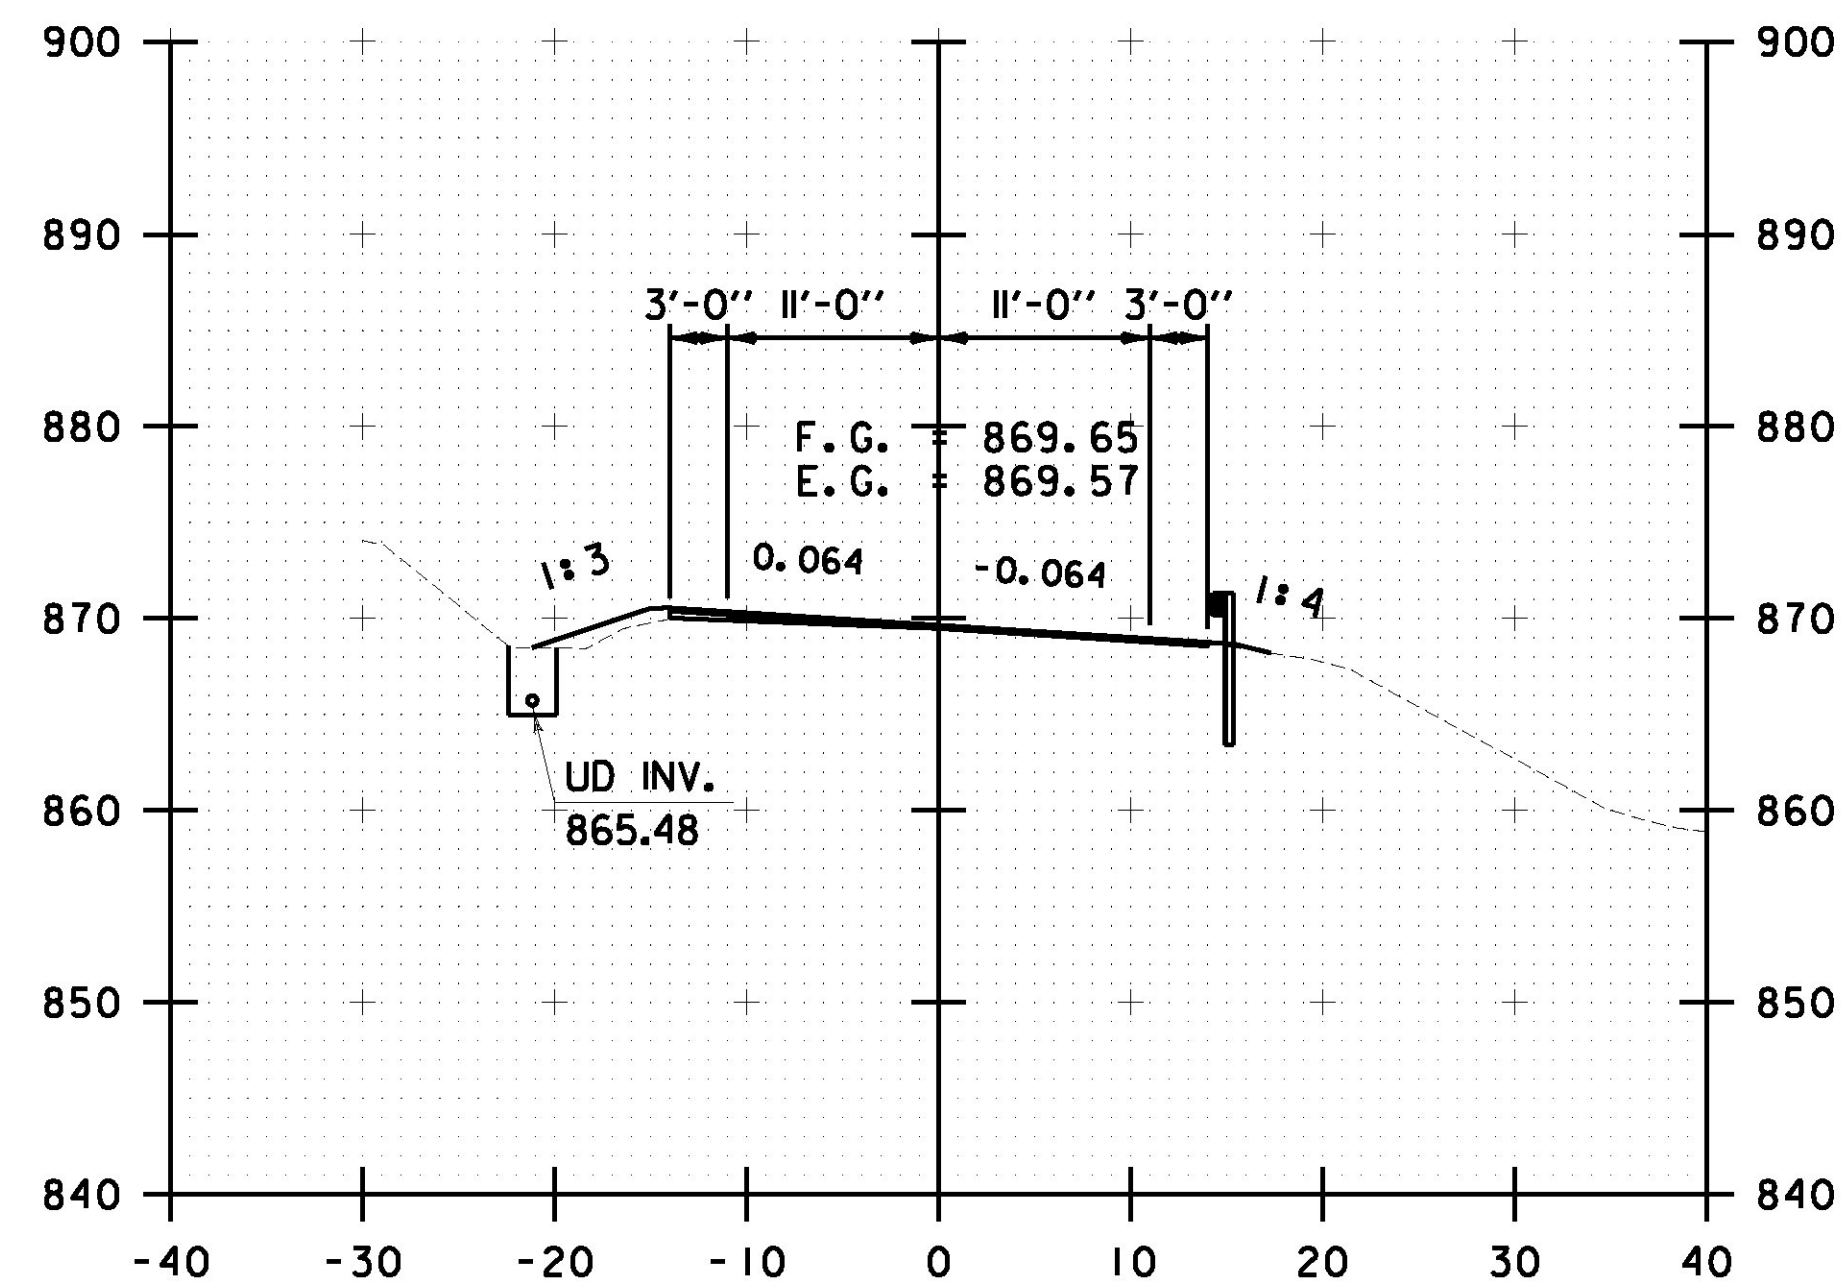


R 411+00.00

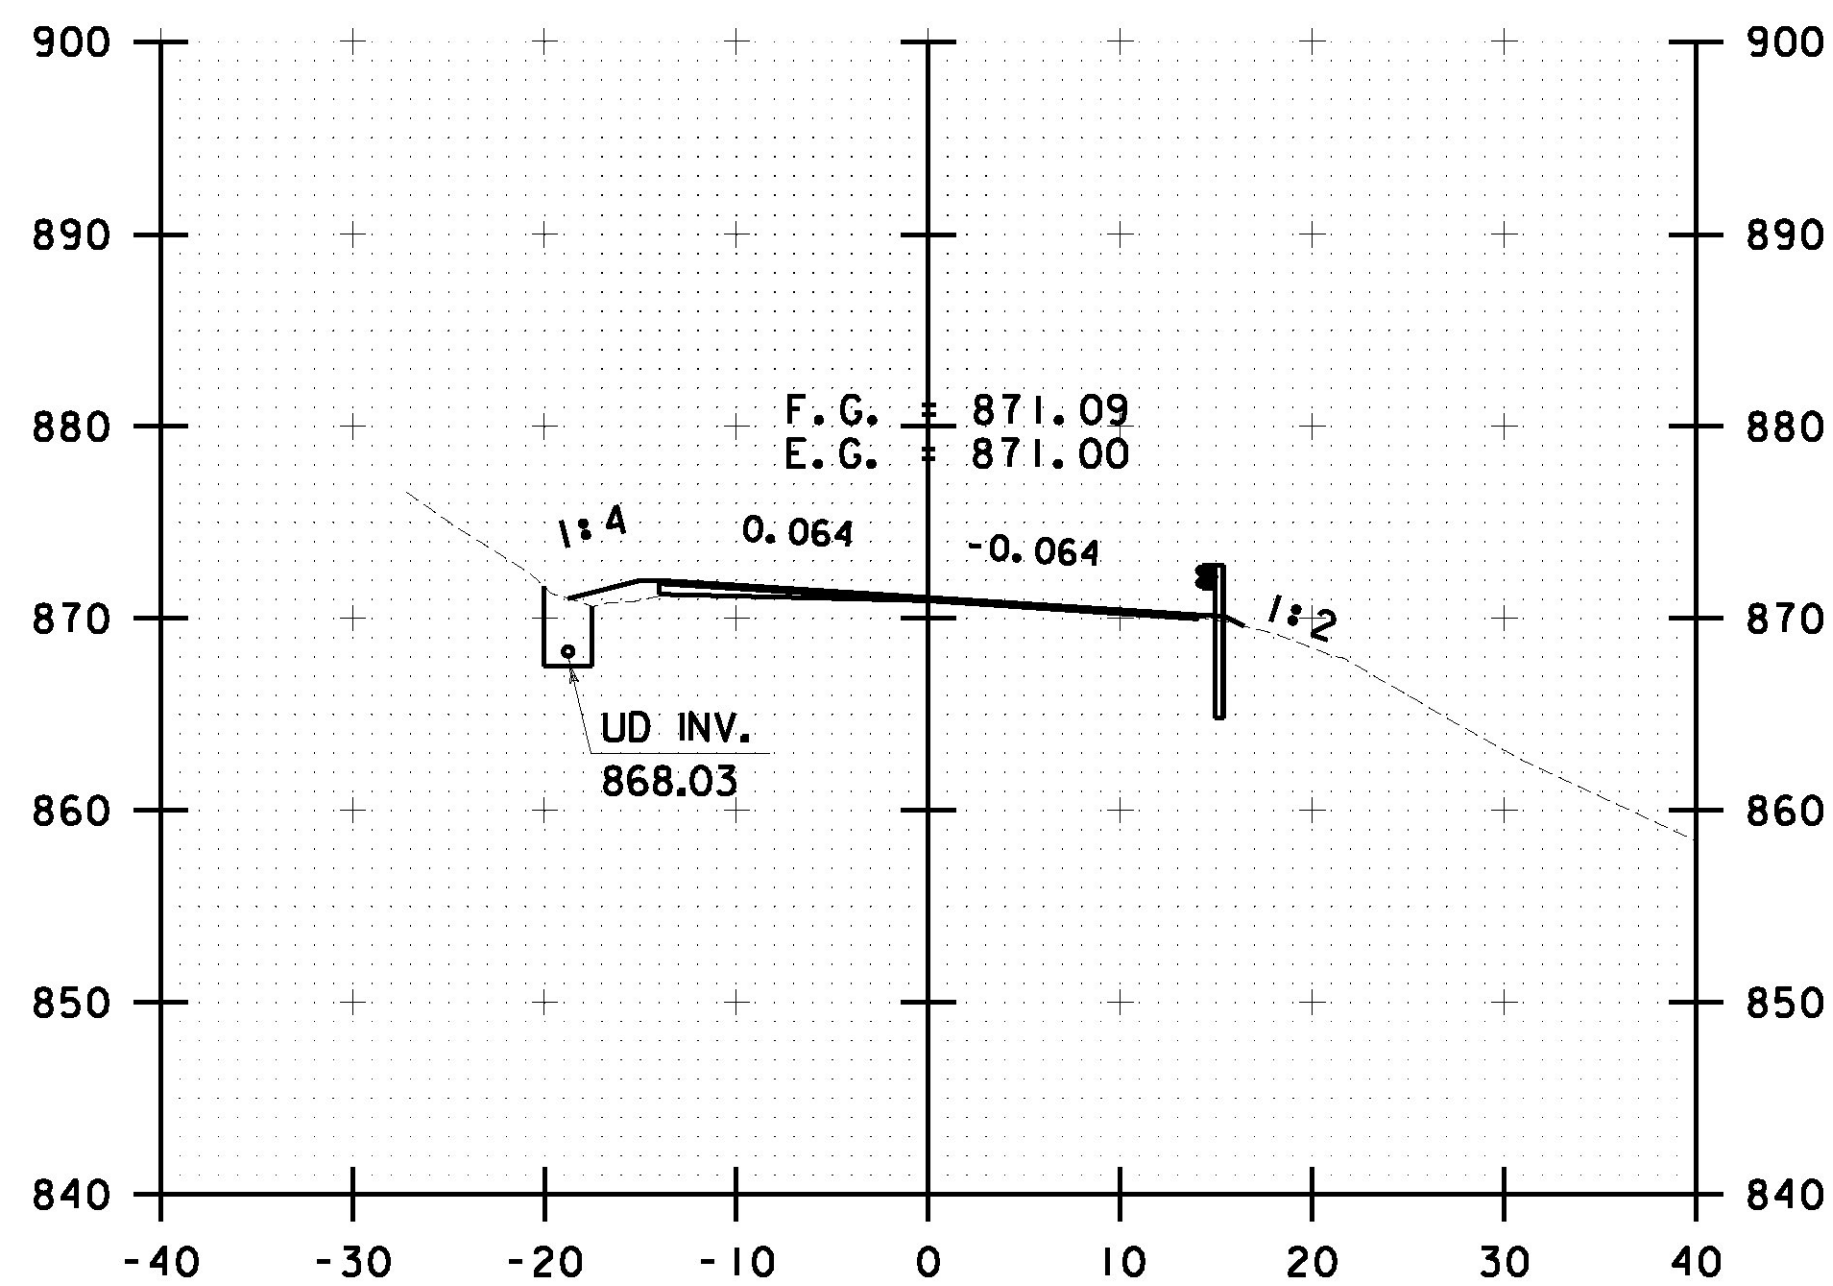

R 412+00.00

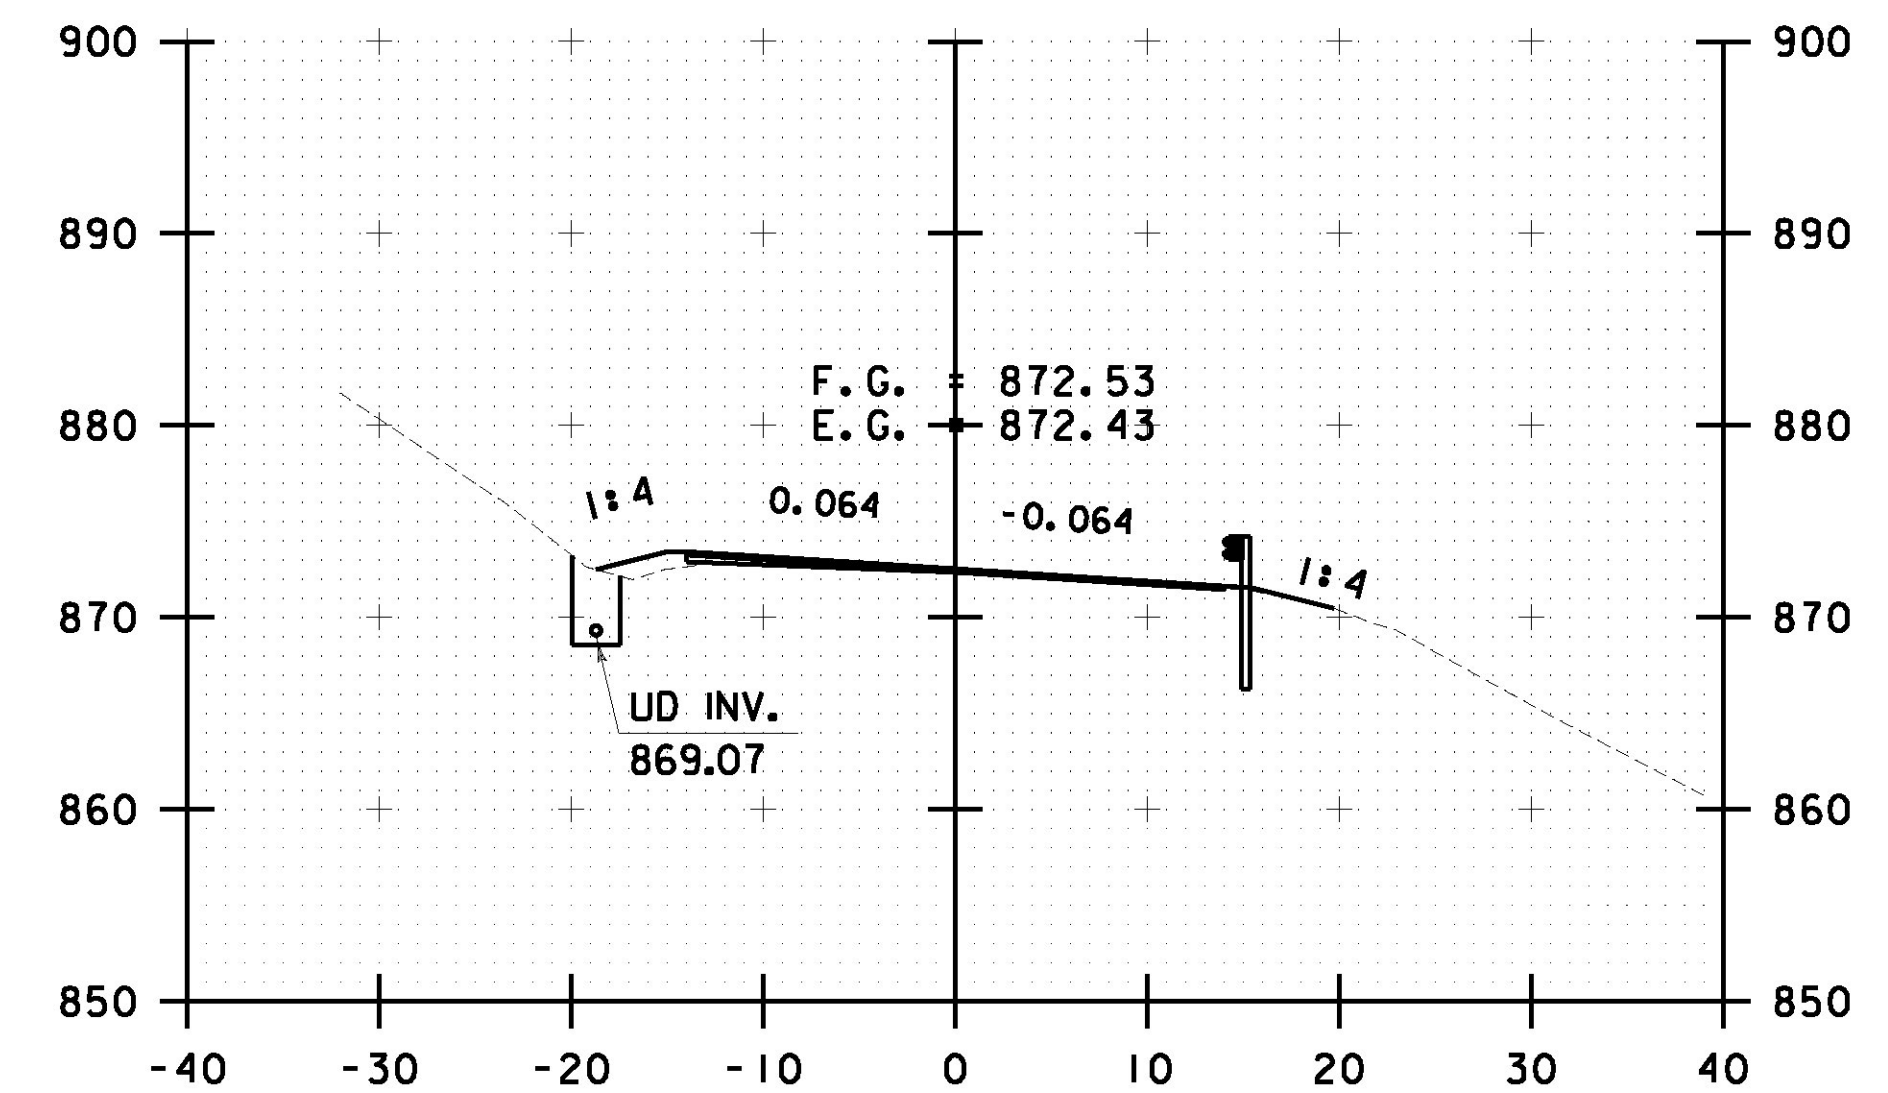

R 413+00.00

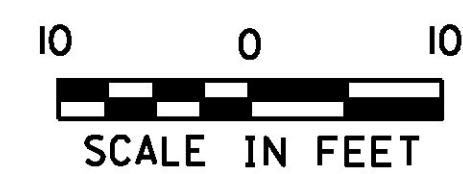

| | |
|------------------------------------|------------------------|
| PROJECT NAME: ROCHESTER | |
| PROJECT NUMBER: ER STP 0162(21) | |
| FILE NAME: z13cl76xc.dgn | PLOT DATE: 1/12/2017 |
| PROJECT LEADER: D. GOZALKOWSKI | DRAWN BY: J. HEALD |
| DESIGNED BY: J. OLSEN | CHECKED BY: J. SHIELDS |
| ROCHESTER CROSS SECTION SHEET #142 | SHEET 331 OF 360 |