




R 425+50.00

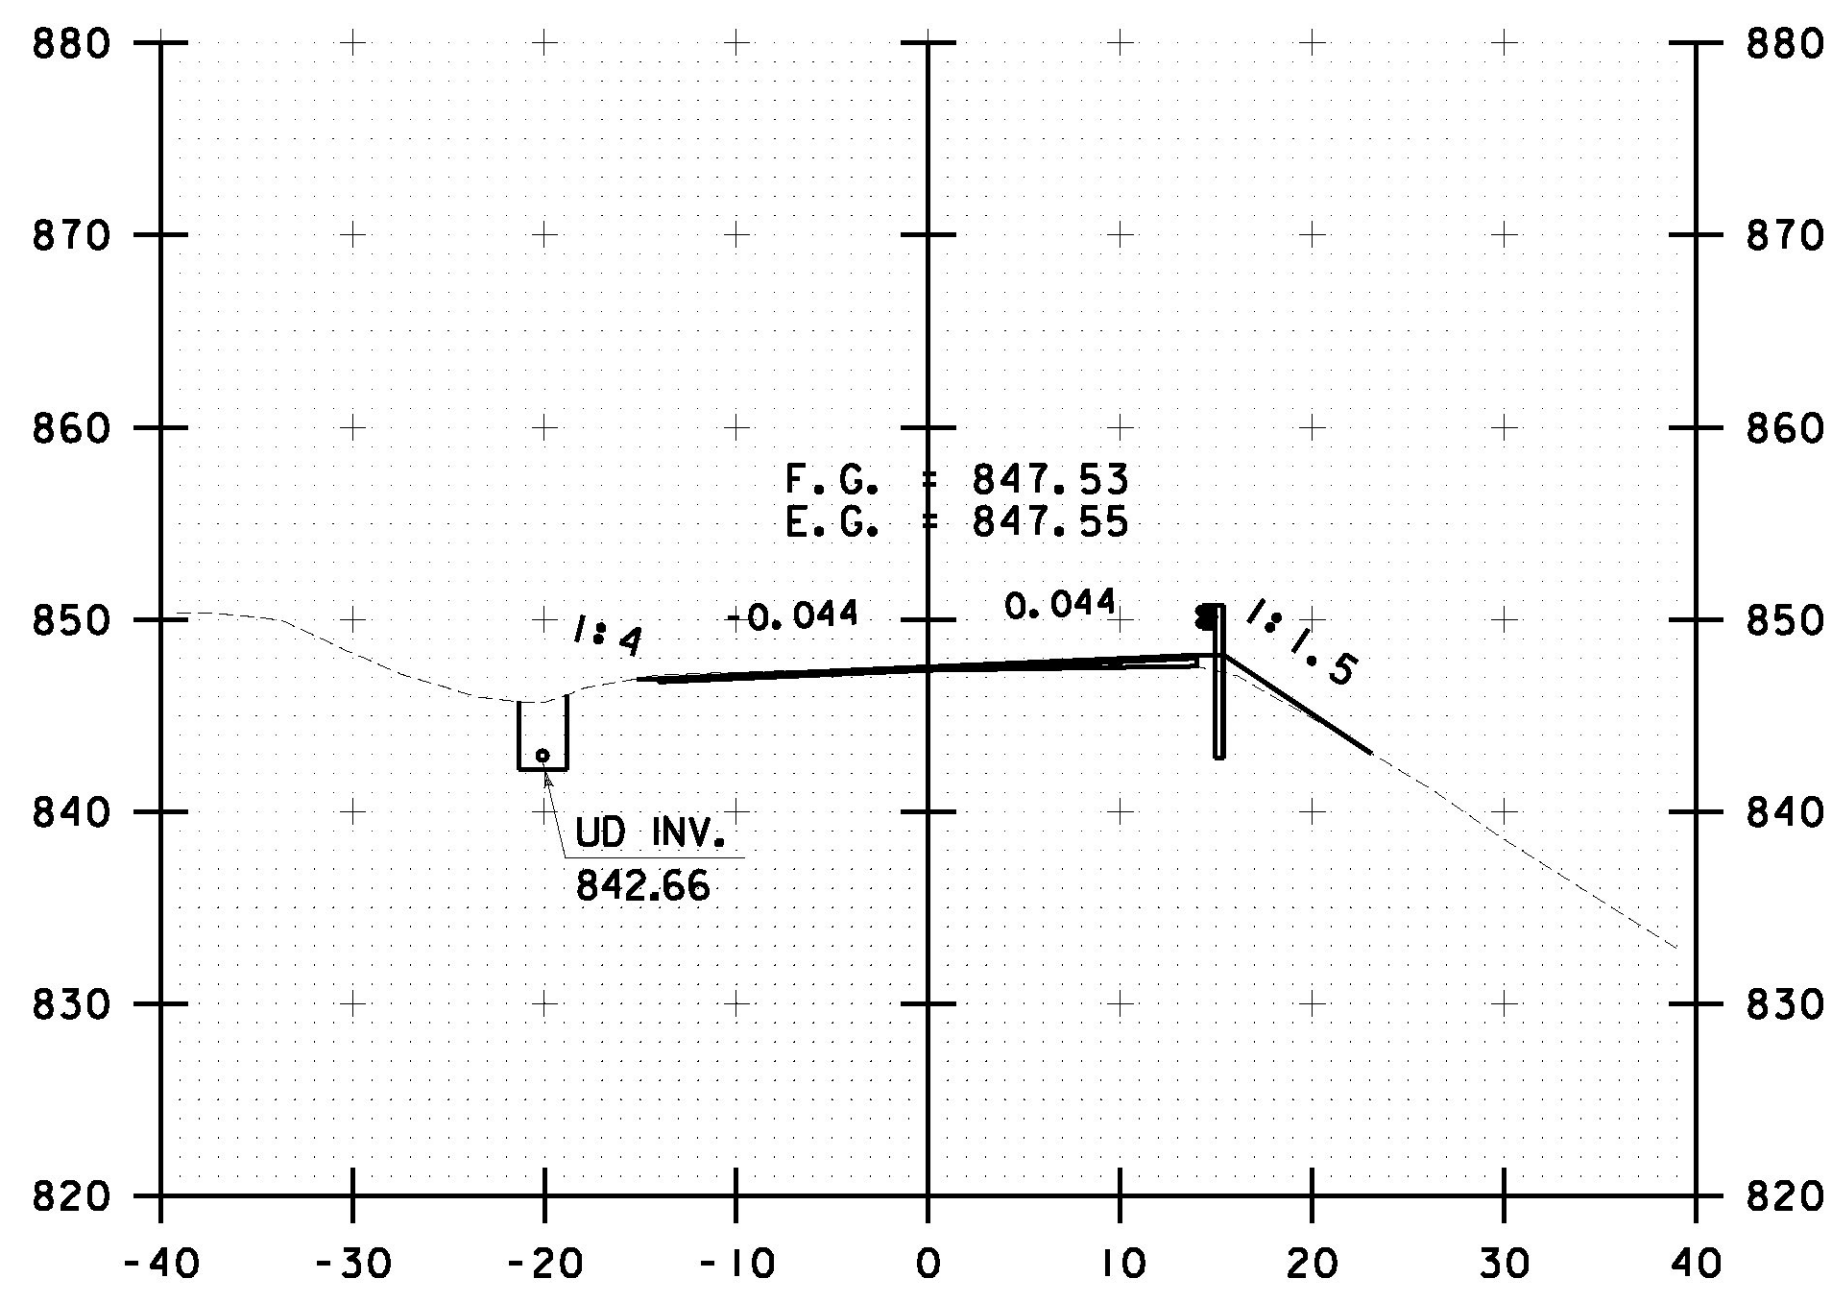


R 426+50.00

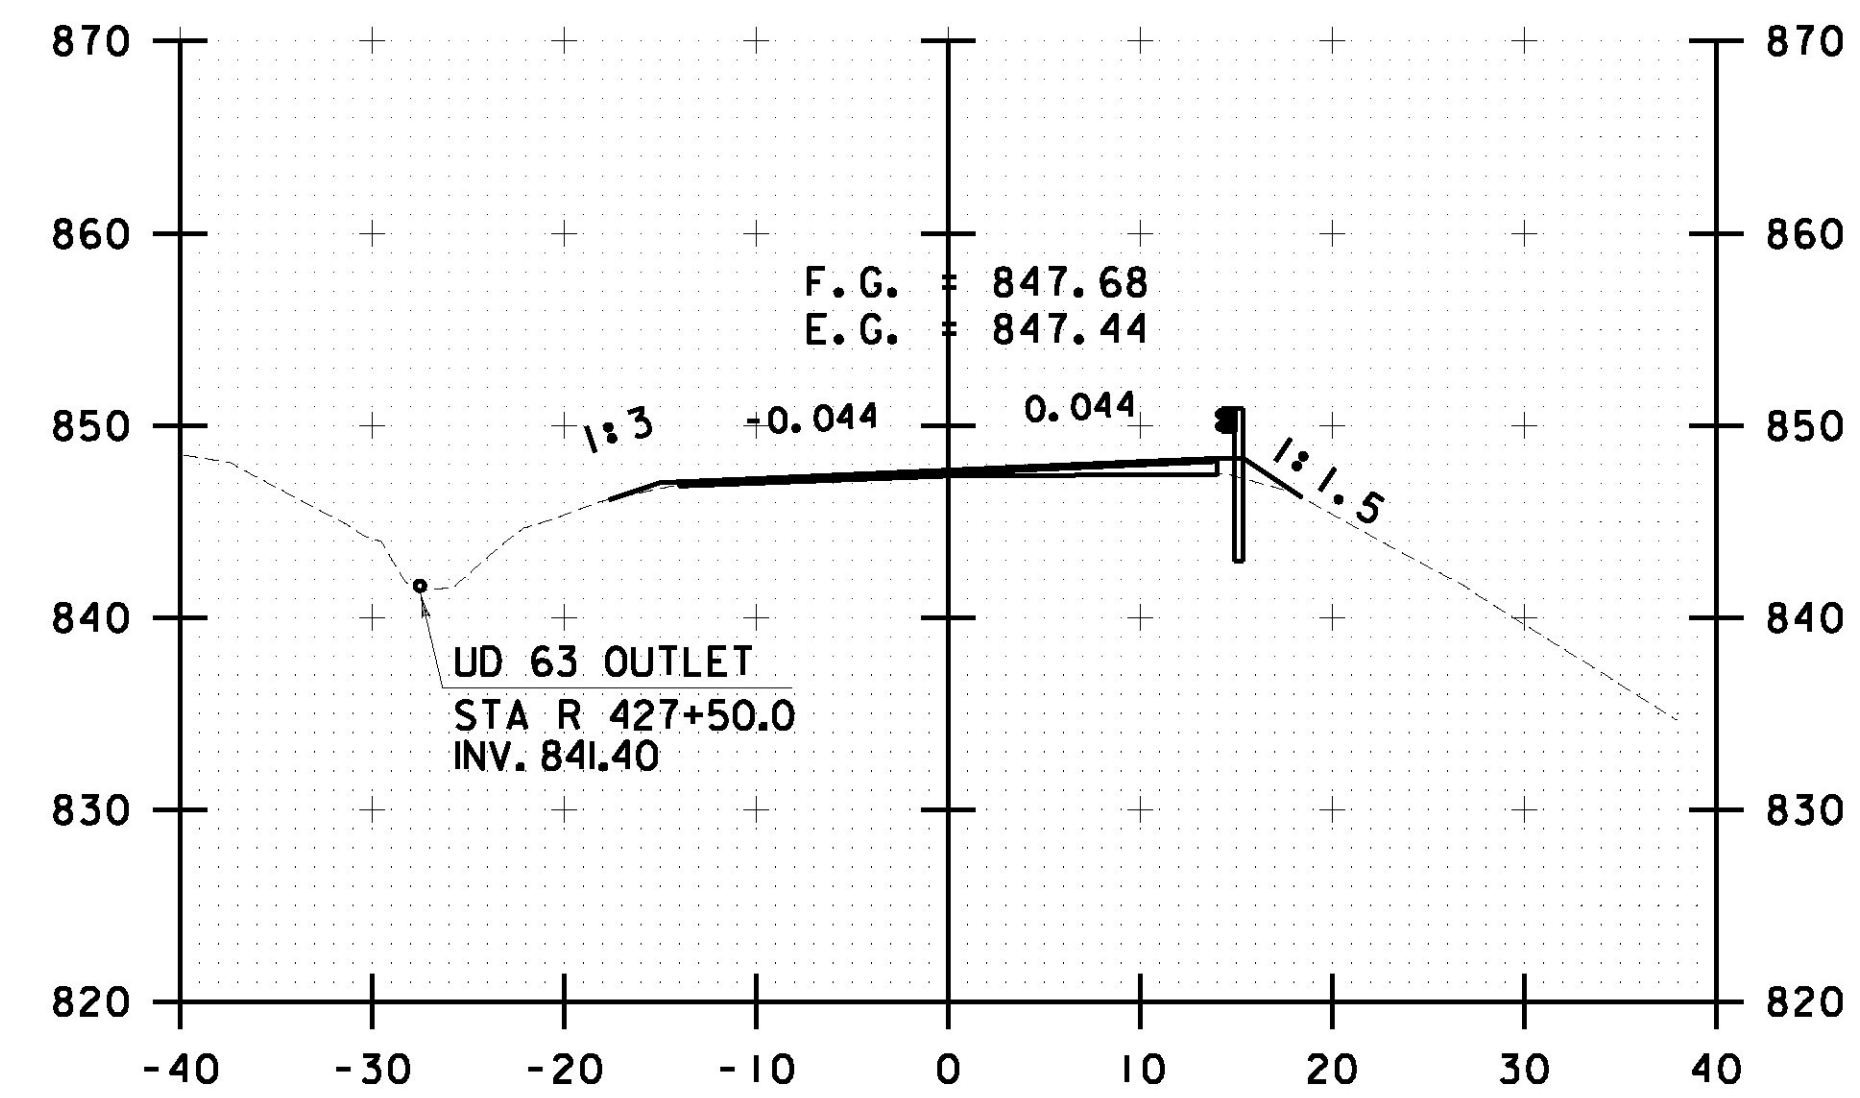


R 427+50.00

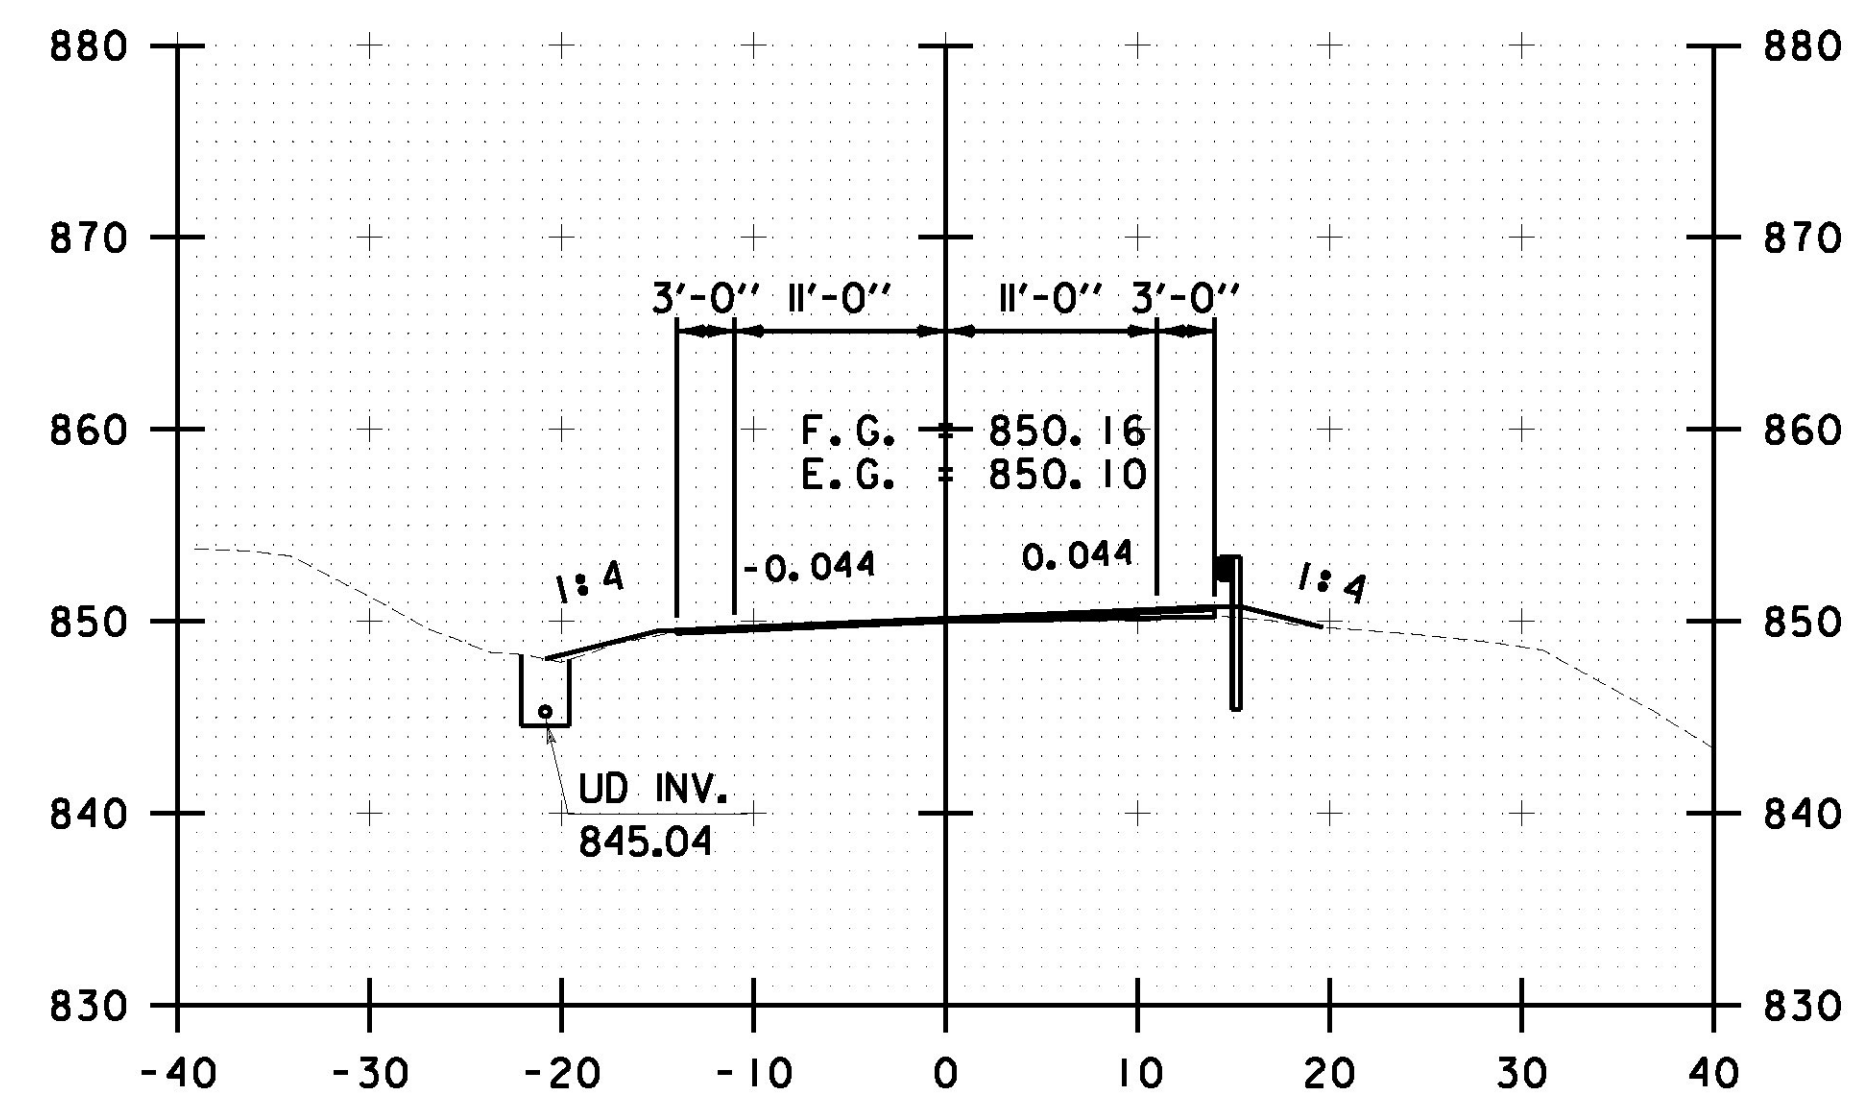


R 425+00.00

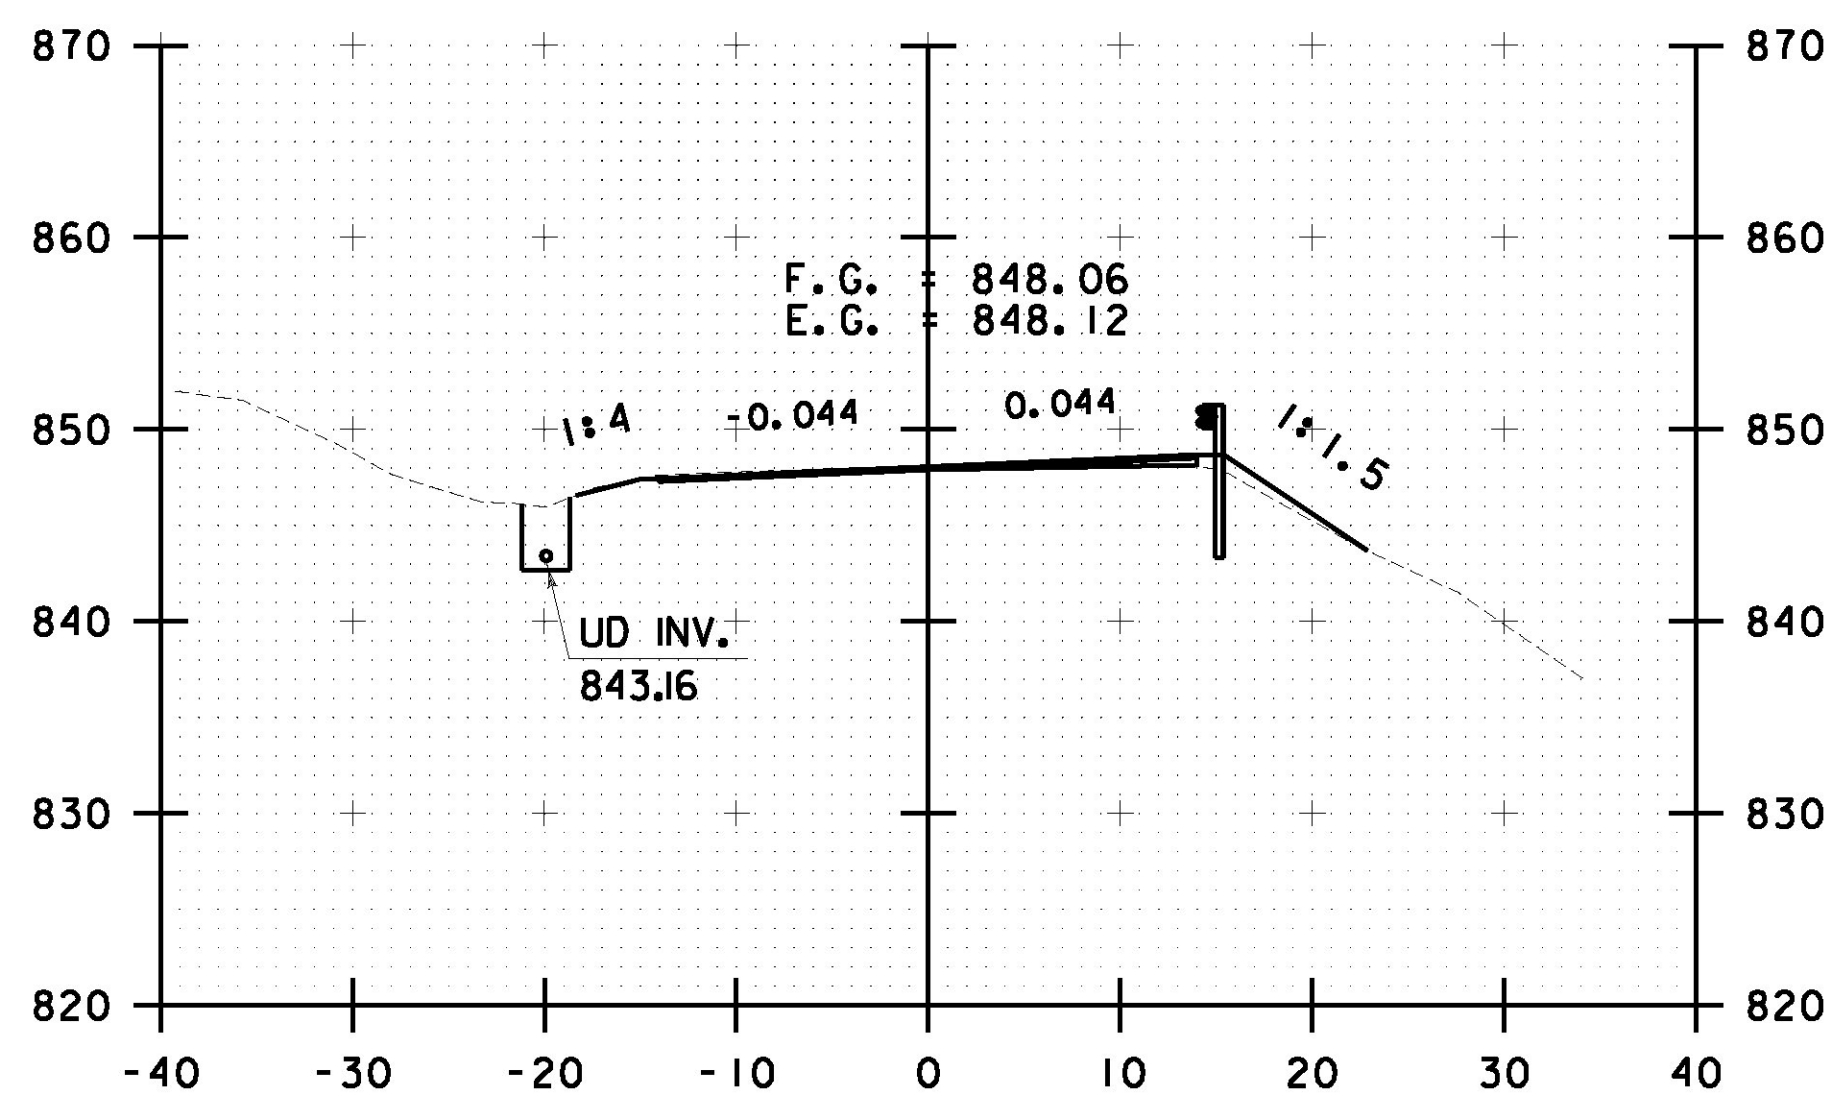

R 426+00.00

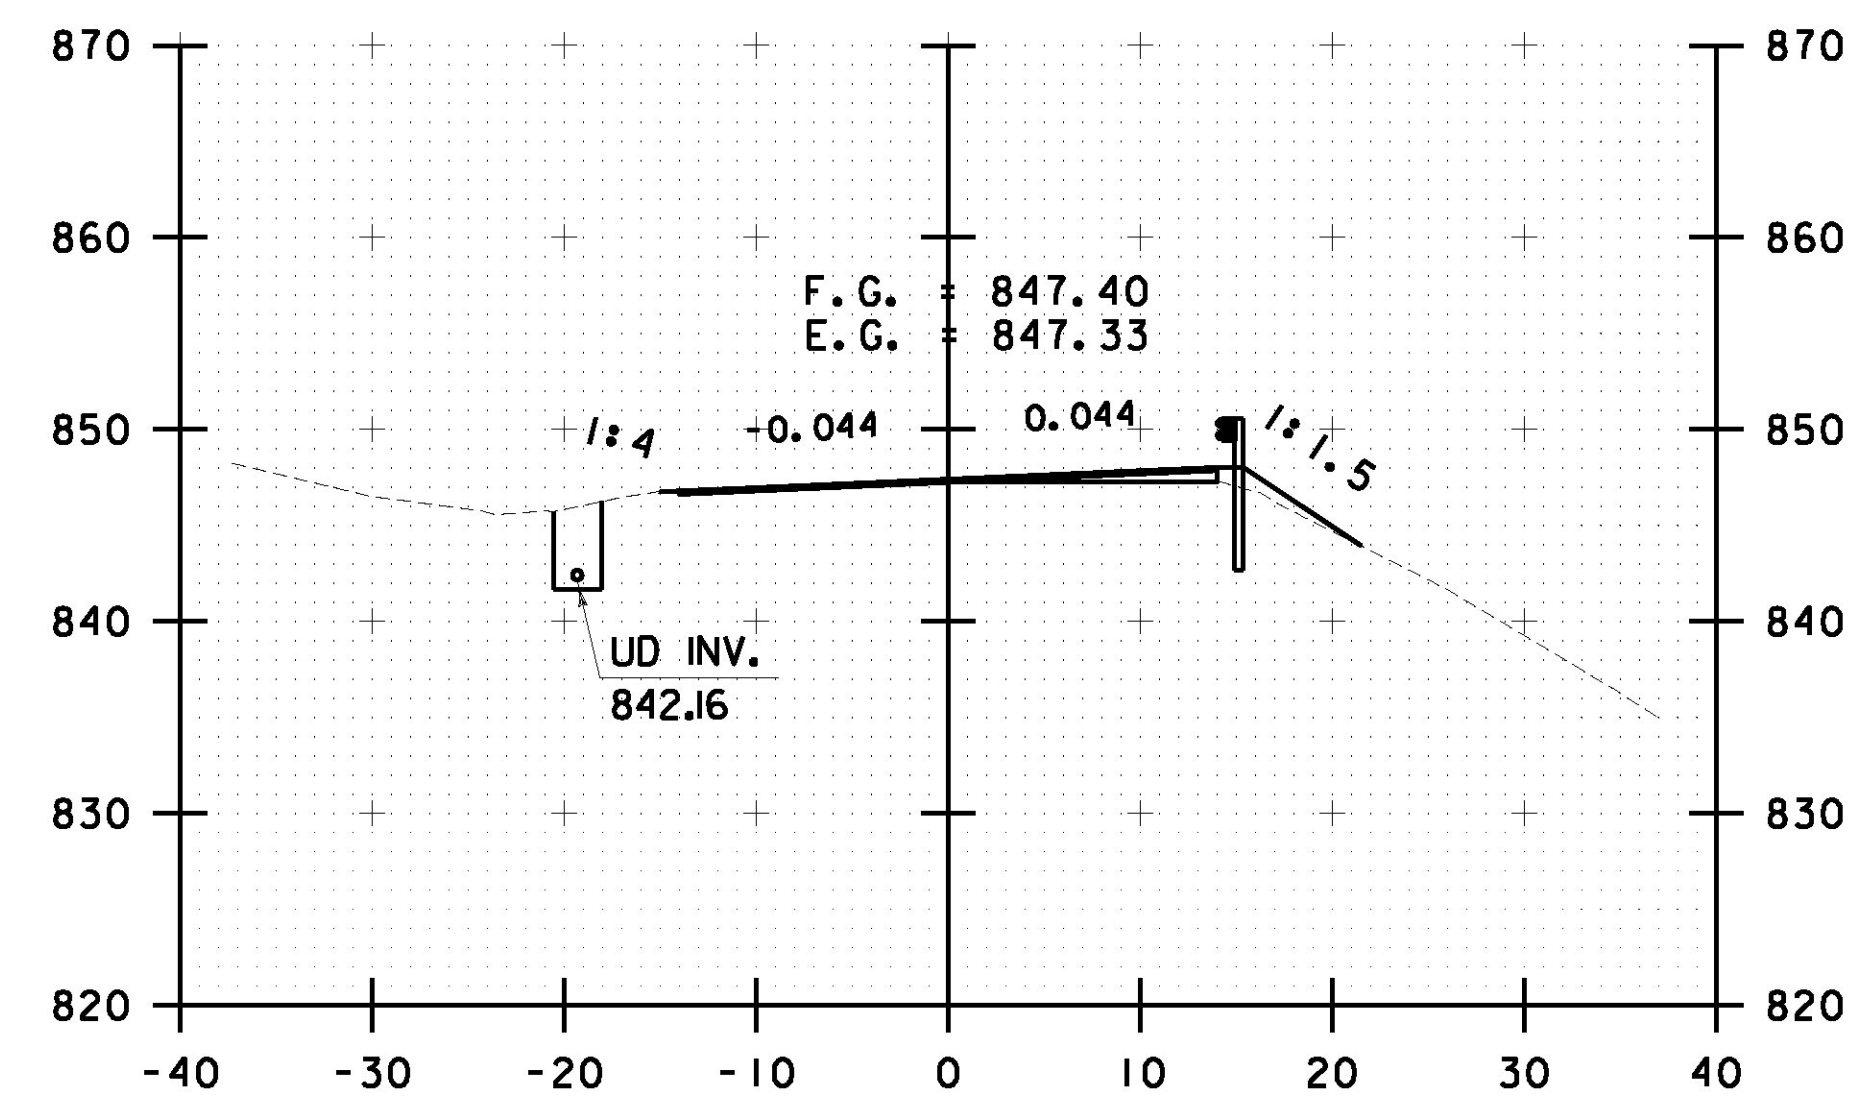

R 427+00.00

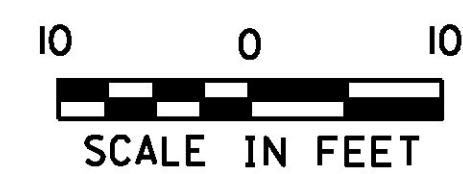

|                                    |                        |
|------------------------------------|------------------------|
| PROJECT NAME: ROCHESTER            |                        |
| PROJECT NUMBER: ER STP 0162(21)    |                        |
| FILE NAME: z13cl76xc.dgn           | PLOT DATE: 1/12/2017   |
| PROJECT LEADER: D. GOZALKOWSKI     | DRAWN BY: J. HEALD     |
| DESIGNED BY: J. OLSEN              | CHECKED BY: J. SHIELDS |
| ROCHESTER CROSS SECTION SHEET #147 | SHEET 336 OF 360       |