


**BR 17 ROCHESTER MM 6.983 = STA R 368+70.24**

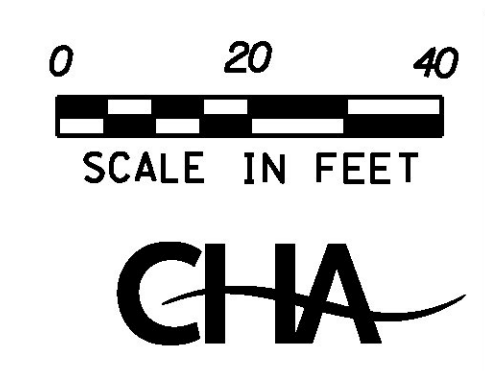

PROJECT NAME: ROCHESTER	
PROJECT NUMBER: ER STP 0162(21)	
FILE NAME: z13cl76bd+03.dgn	PLOT DATE: 1/11/2017
PROJECT LEADER: D. GOZALKOWSKI	DRAWN BY: J. HEALD
DESIGNED BY: J. OLSEN	CHECKED BY: J. SHIELDS
BRIDGE DETAIL SHEET 3	SHEET 360 OF 360