



**APPROACH AREA DETAIL**

RANDOLPH STA. 20+53.92 - BEGIN RECLAMATION  
 BRAINTREE STA. 177+31.00 - RAILROAD CROSSING BEGIN  
 BRAINTREE STA. 178+89.00 - RAILROAD CROSSING END  
 BRAINTREE STA. 203+02.31 - STOP RECLAMATION (BR #6)  
 BRAINTREE STA. 206+19.88 - RESUME RECLAMATION (BR #6)

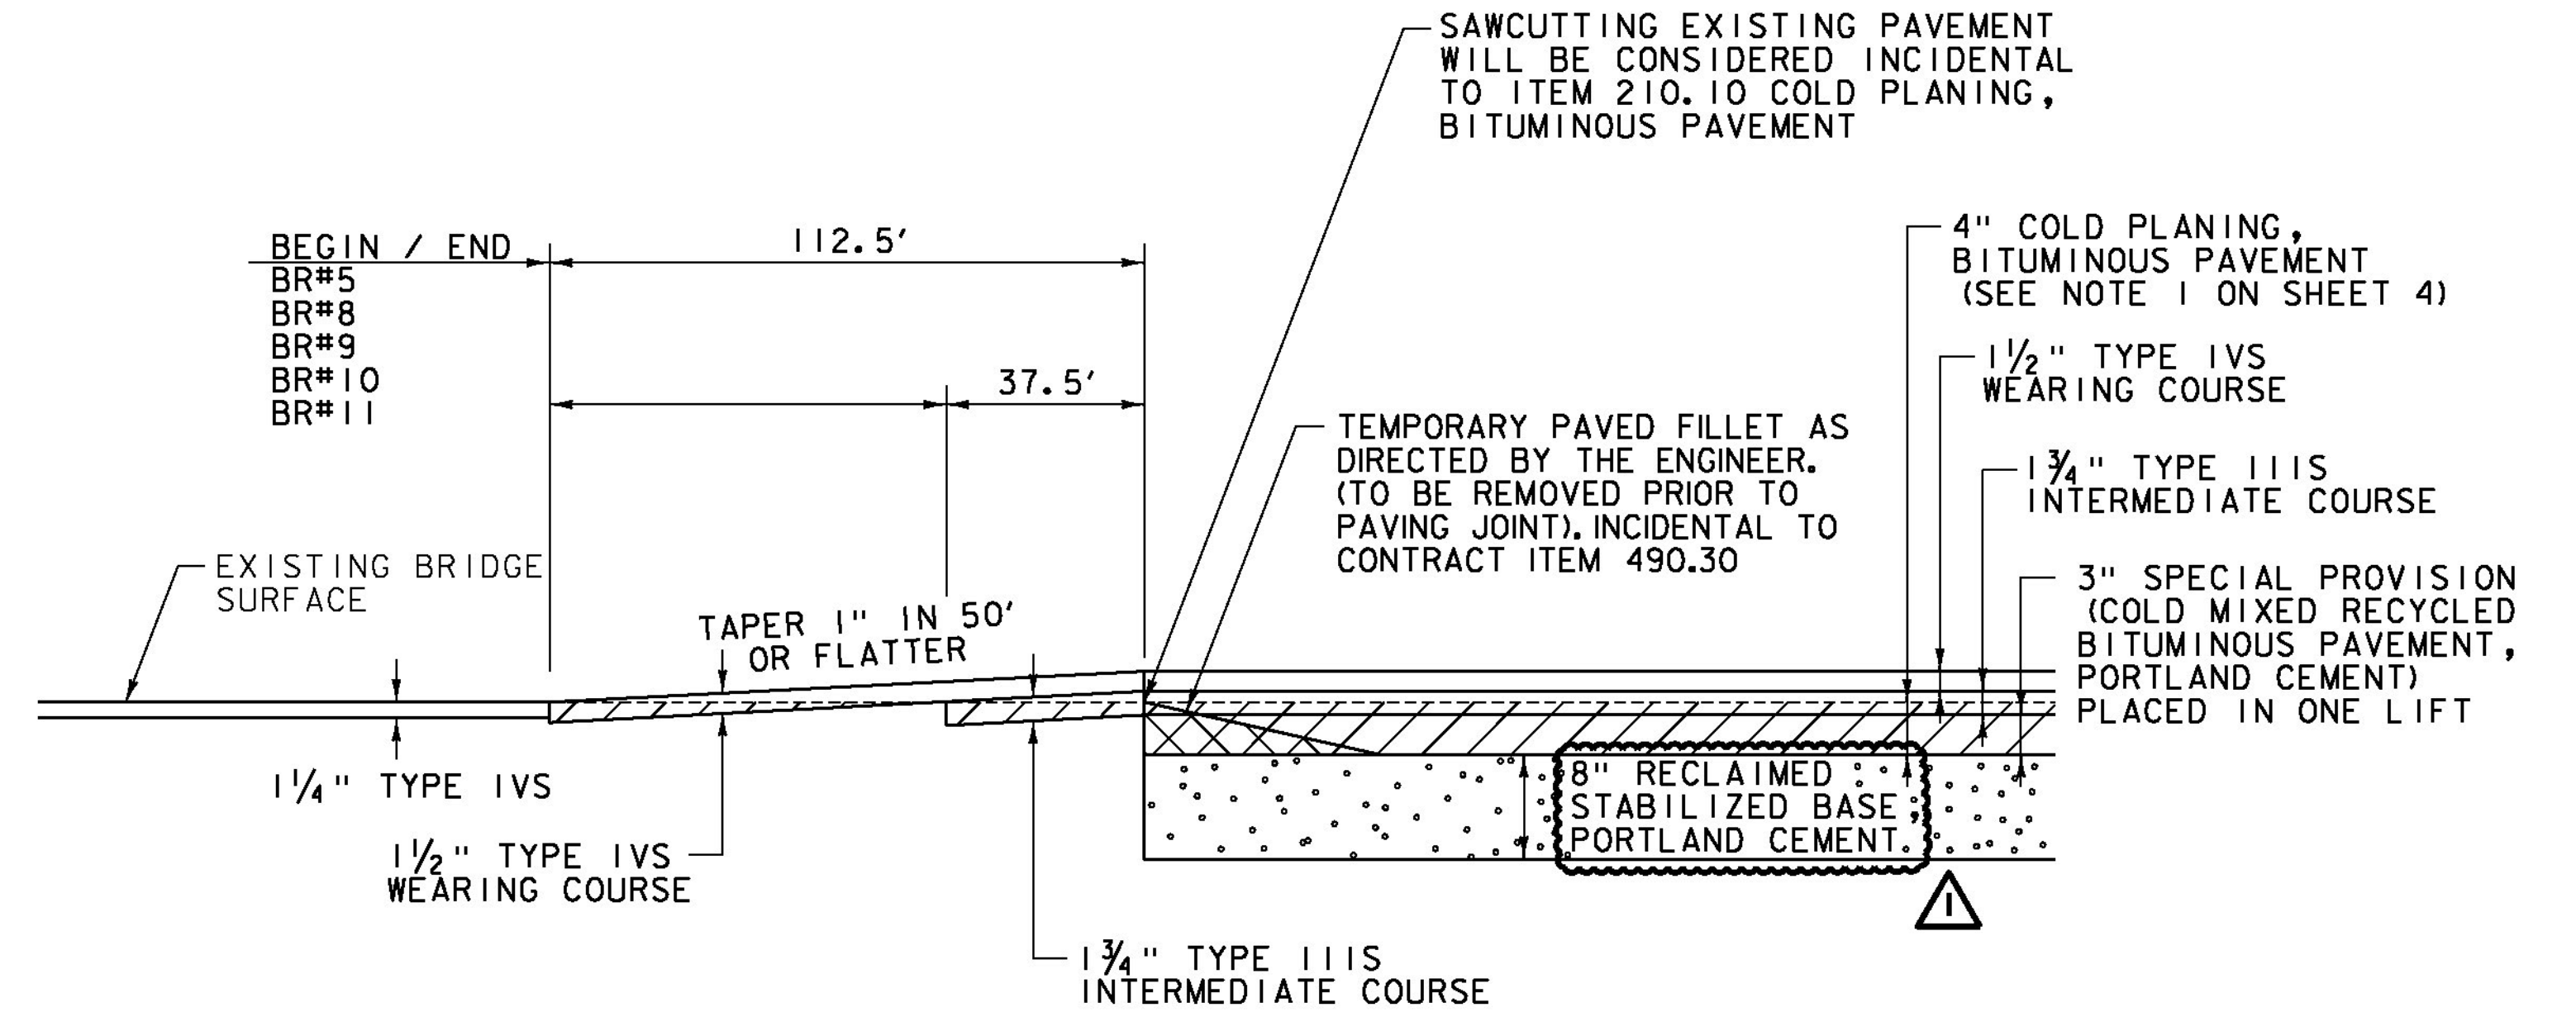

**BRIDGE APPROACH DETAIL**

BRAINTREE STA. 147+00 - BEGIN BR#5  
 BRAINTREE STA. 147+26 - END BR#5  
 BRAINTREE STA. 232+00 - BEGIN BR#8  
 BRAINTREE STA. 232+30 - END BR#8  
 BRAINTREE STA. 285+00 - BEGIN BR#9  
 BRAINTREE STA. 285+41 - END BR#9  
 BRAINTREE STA. 292+15 - BEGIN BR#10  
 BRAINTREE STA. 292+40 - END BR#10  
 BRAINTREE STA. 328+45 - BEGIN BR#11  
 BRAINTREE STA. 328+85 - END BR#11  
 GRANVILLE STA. 22+93 - BEGIN BR#12  
 GRANVILLE STA. 23+22 - END BR#12  
 GRANVILLE STA. 66+96 - BEGIN BR#14  
 GRANVILLE STA. 67+25 - END BR#14  
 ROXBURY STA. 35+32.32 - END PROJECT

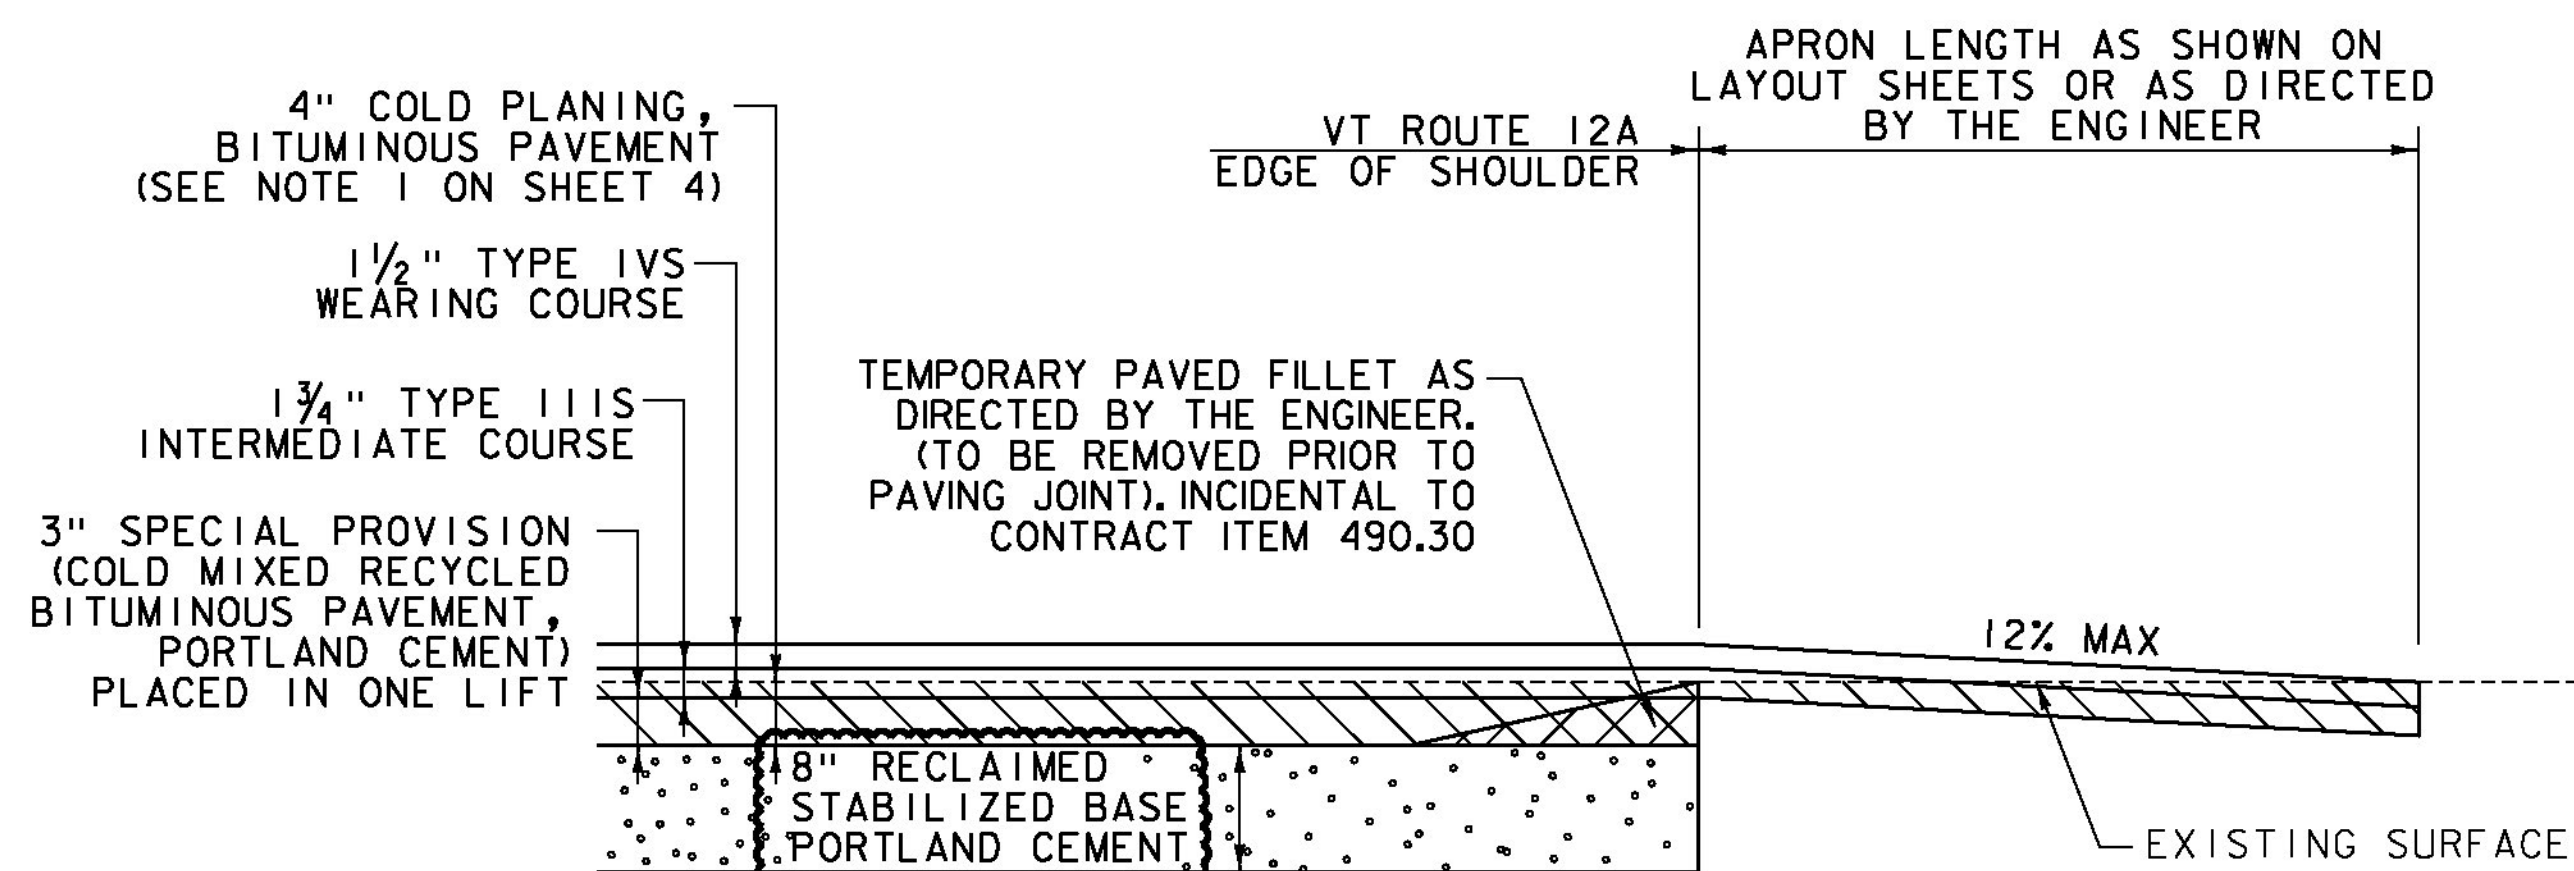

**SIDE ROAD DETAIL - TOWN HIGHWAYS**  
 FULL WIDTH OF TOWN HIGHWAY


NOTE: THIS DETAIL SHALL BE USED FOR THE SIDE ROADS LISTED BELOW AS DIRECTED BY THE ENGINEER.

**RANDOLPH**  
 STA. 44+56, RT (WALLACE HILL RD)  
 STA. 47+63, RT (BRAINTREE HILL RD)

**BRAINTREE**  
 STA. 5+17, LT (ALLEN DR)  
 STA. 36+85, LT (MOBILE ACRES)  
 STA. 65+15, LT (RIFORD BROOK ROAD)  
 STA. 88+81, RT (BRUORTON HILL RD)

**BRAINTREE (CONT.)**  
 STA. 94+80, RT (DUCLOS RD)  
 STA. 96+57, RT (DUCLOS RD)  
 STA. 141+77, RT (BENT HILL RD)  
 STA. 237+28, RT (SOUTH RD)  
 STA. 239+77, RT (NORTH RD)  
 STA. 240+13, RT (NORTH RD)  
 STA. 292+51, RT (THRESHER RD)  
 STA. 329+84, RT (LEMERY ROAD)

**GRANVILLE**  
 STA. 9+13, RT (HANDLY RD)

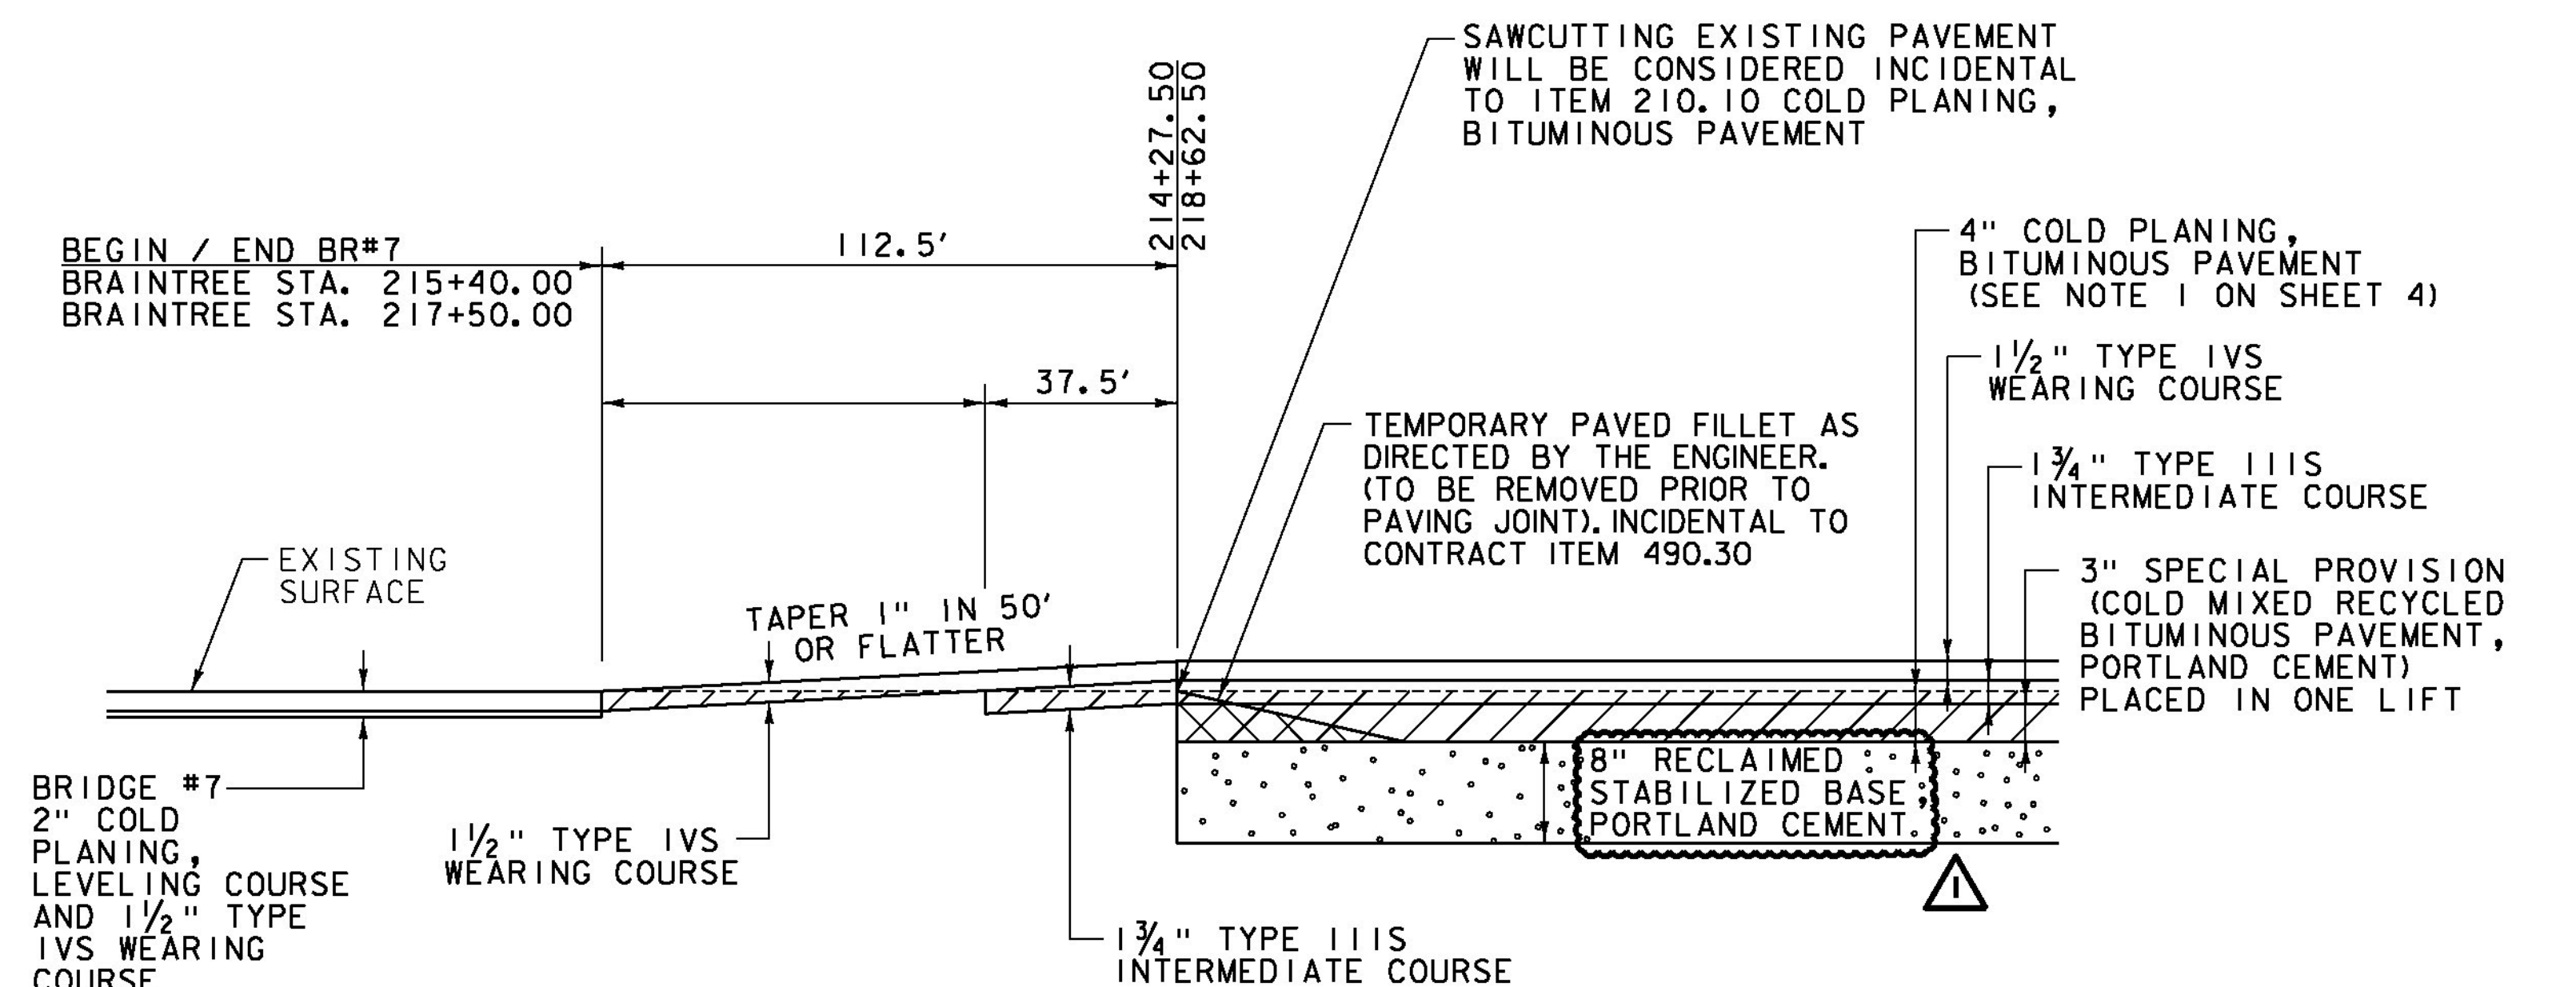

**BRIDGE #7 APPROACH DETAIL**

BRAINTREE STA. 215+40.00 - BEGIN BR#7 COLD PLANE AREA  
 BRAINTREE STA. 217+50.00 - END BR#7 COLD PLANE AREA

REV	DESCRIPTION	DATE
1	NOTE CLARIFICATION	1-16-2015



PROJECT NAME: RANDOLPH-ROXBURY	PLOT DATE: 1/16/2015
PROJECT NUMBER: ER STP 0187(II)	DRAWN BY: G. BURMEIER
FILE NAME: z13c182frm.dgn	CHECKED BY: M. FOISY
DESIGNED BY: I. MAYNARD	SHEET 6 OF 545
<b>DETAIL SHEET 2</b>	