

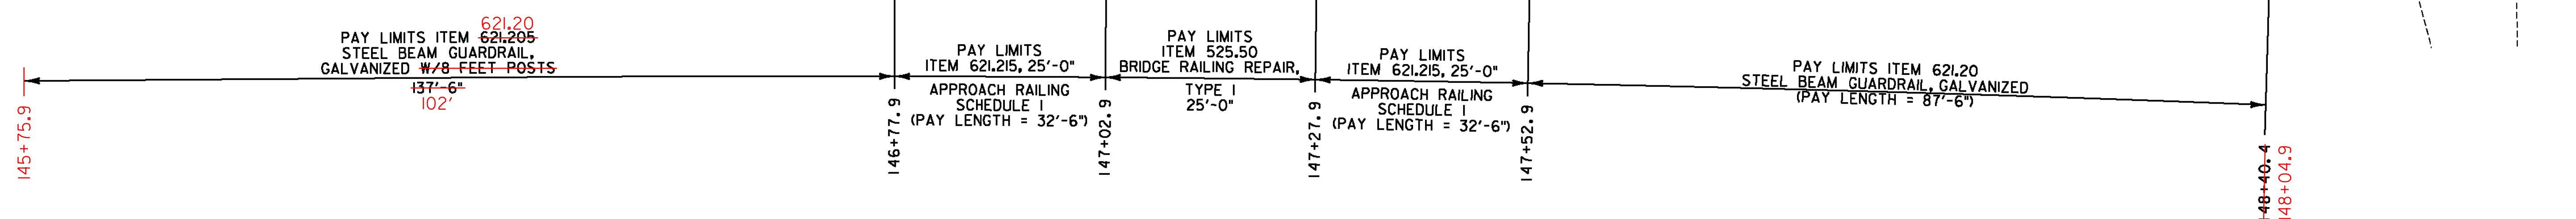
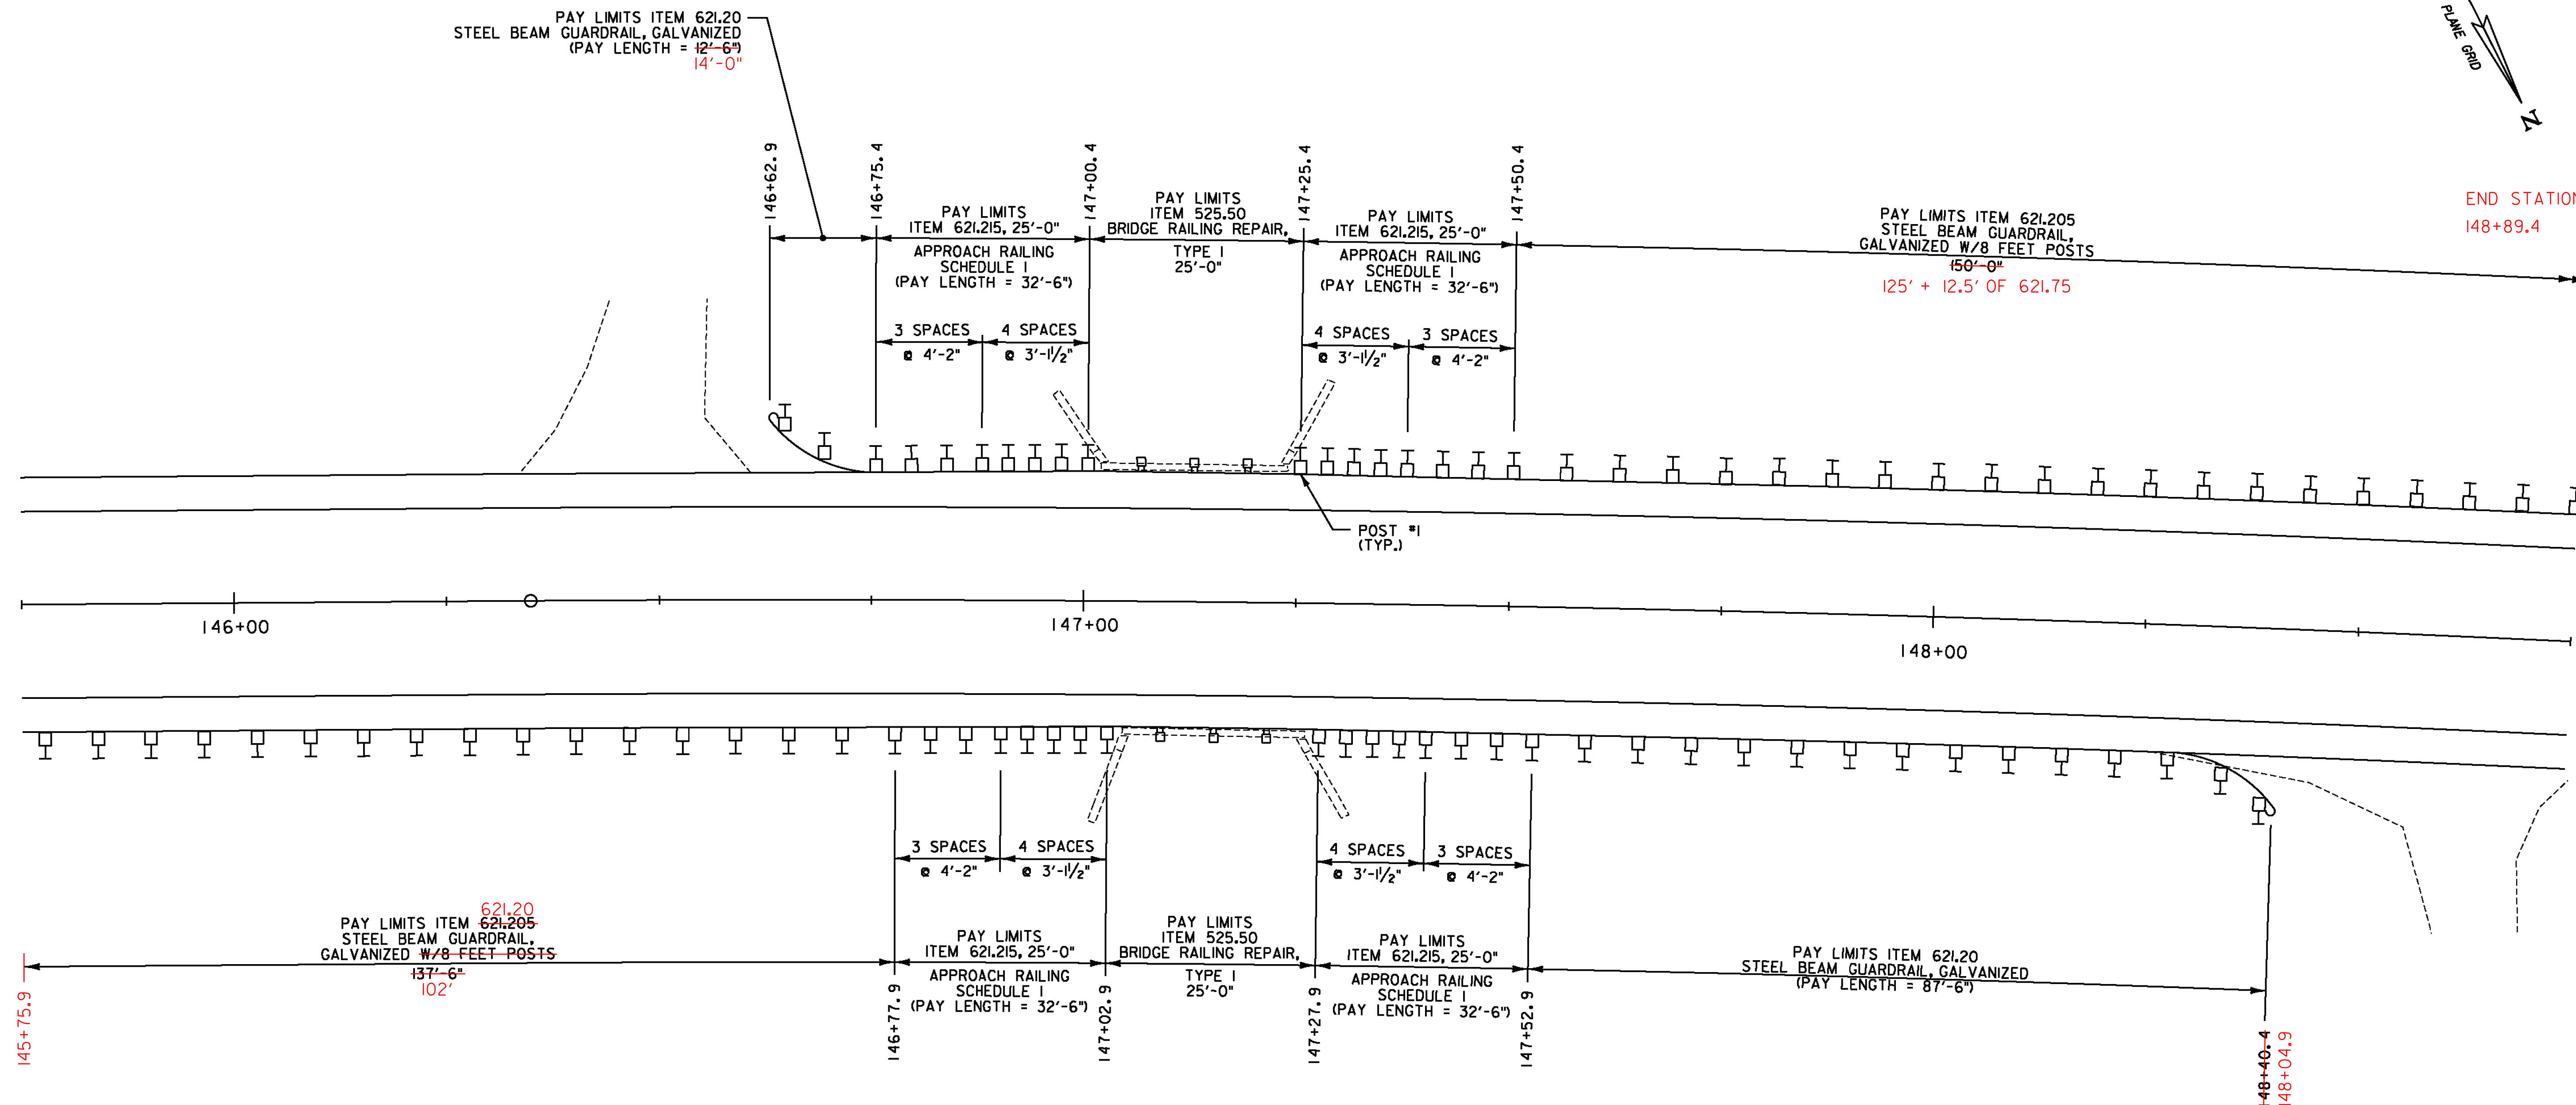


REMOVAL OF EXISTING BRIDGE RAILING
 STA. 147+00.4 TO 147+25.4, LT
 STA. 147+02.9 TO 147+27.9, RT

BRIDGE RAILING REPAIR, TYPE I
 STA. 147+00.4 TO 147+25.4, LT
 STA. 147+02.9 TO 147+27.9, RT

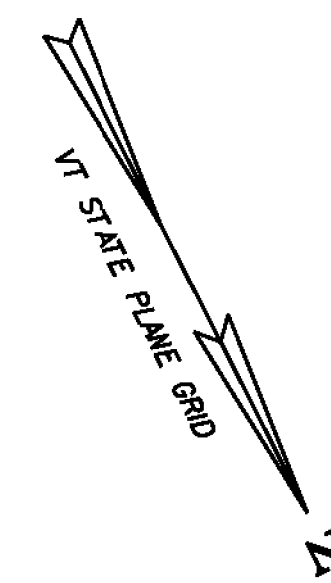

BR 5 BRAINTREE MM 2.786 = STA. 147+10

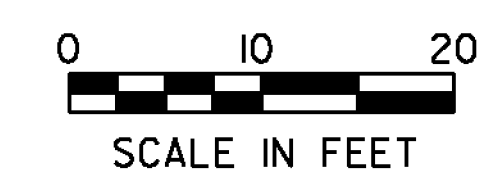

PROJECT NAME: RANDOLPH-ROXBURY	
PROJECT NUMBER: ER STP 0187(II)	
FILE NAME: z13cl82frm.dgn	PLOT DATE: 11/17/2014
PROJECT LEADER: M. FOISY	DRAWN BY: I. MAYNARD
DESIGNED BY: I. MAYNARD	CHECKED BY: M. FOISY
GUARDRAIL DETAIL SHEET 3	SHEET 13 OF 545