
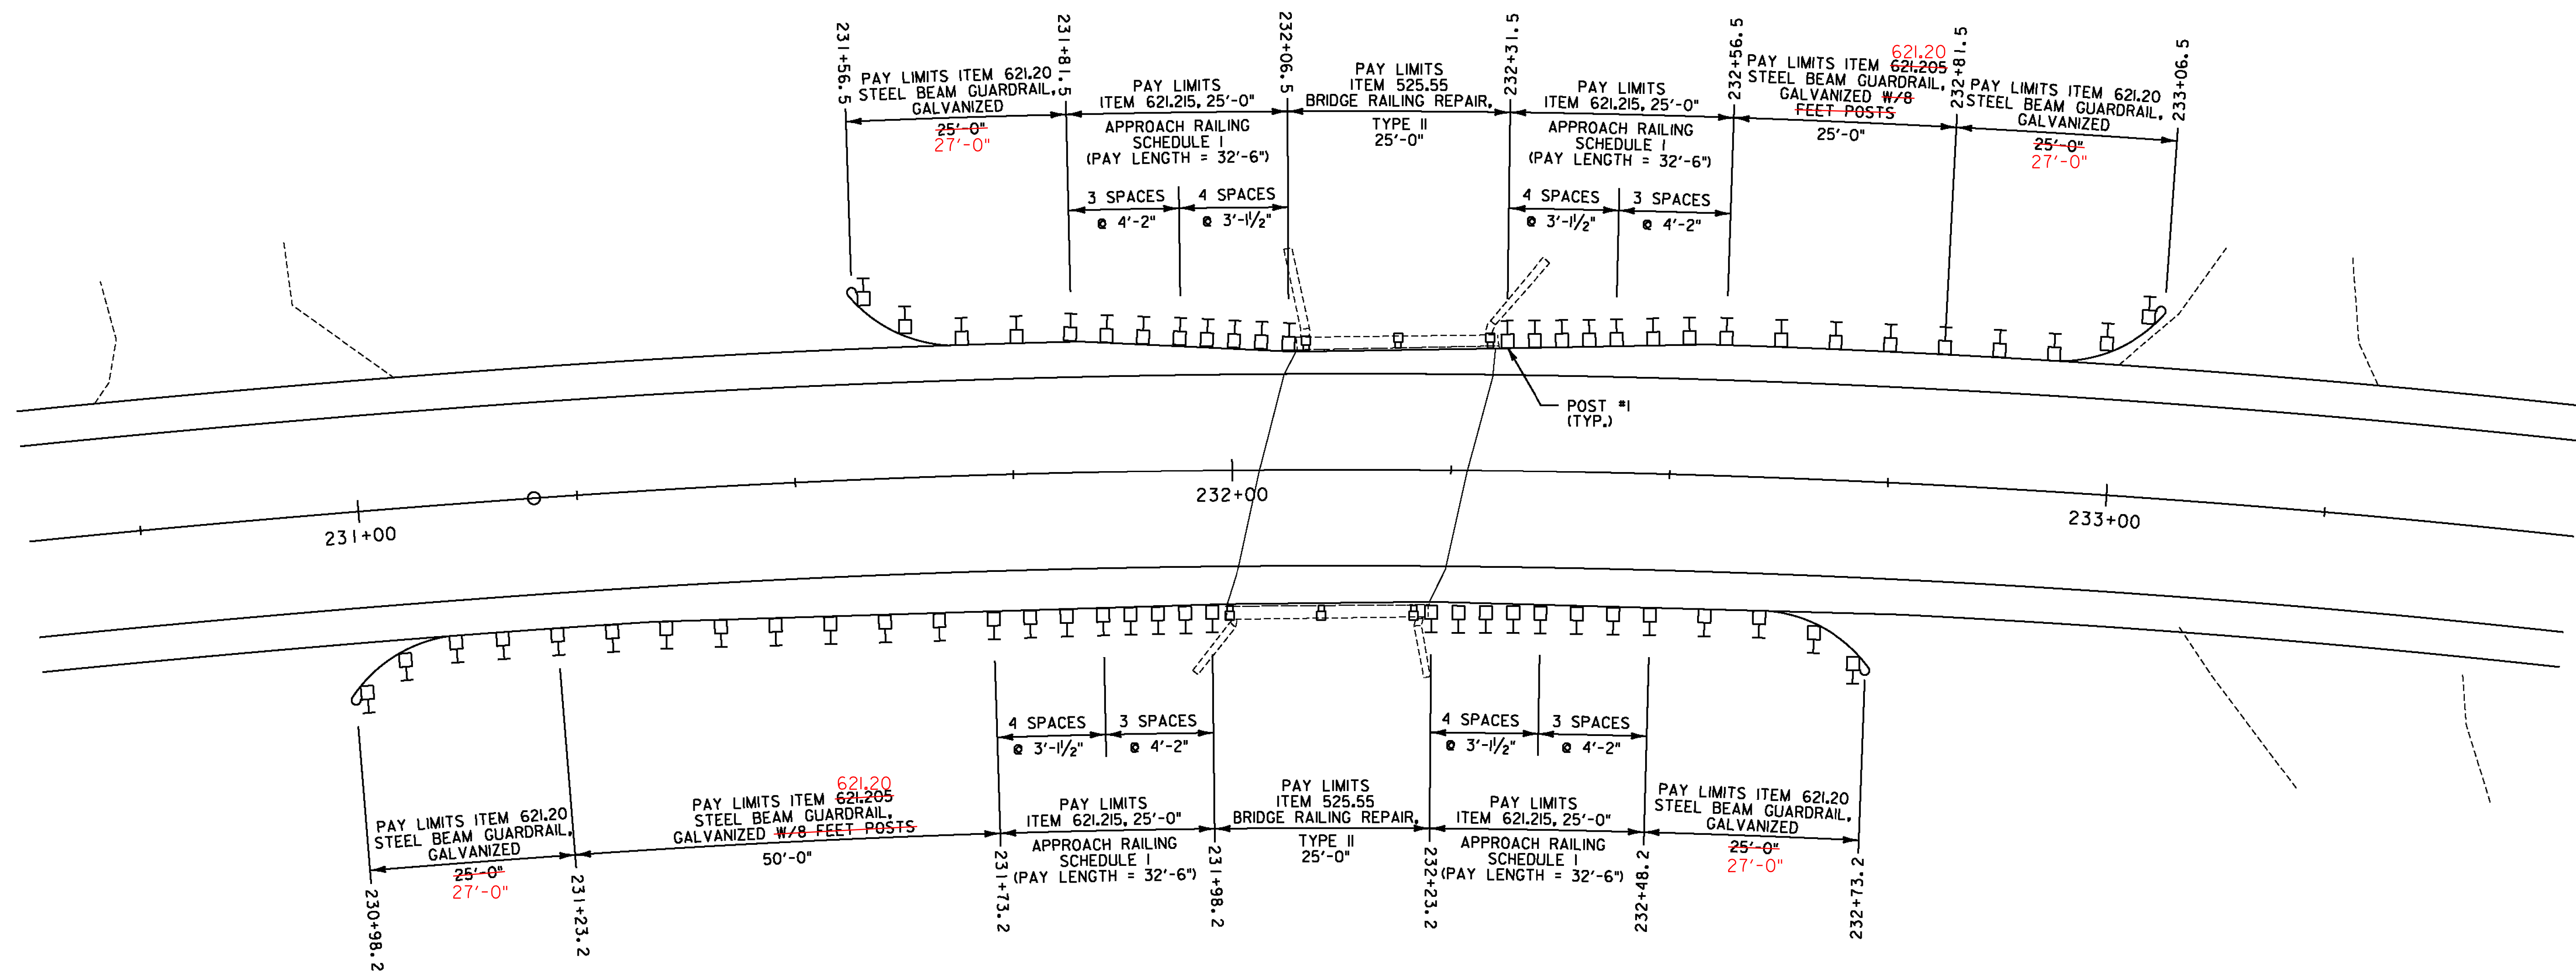



REMOVAL OF EXISTING BRIDGE RAILING
 STA. 231+98.2 TO 232+23.2, RT
 STA. 232+06.5 TO 232+31.5, LT

BRIDGE RAILING REPAIR, TYPE II
 STA. 231+98.2 TO 232+23.2, RT
 STA. 232+06.5 TO 232+31.5, LT

RAPID SETTING CONCRETE REPAIR MATERIAL WITH COARSE AGGREGATE
 STA. 232+02.3 TO 232+27.4

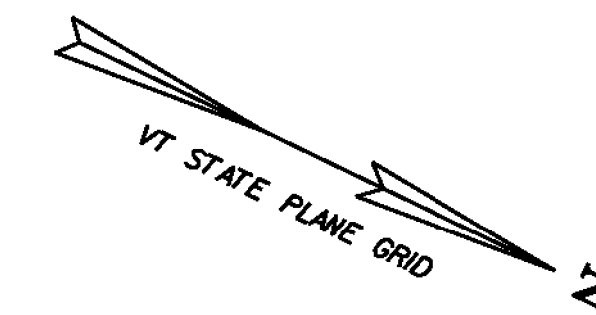

BR 8 BRAINTREE MM 4.397 = STA. 232+16

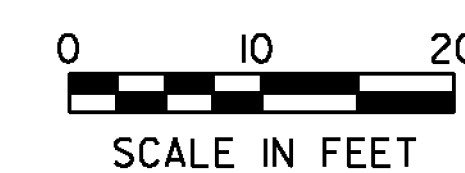

PROJECT NAME: RANDOLPH-ROXBURY	PLOT DATE: 11/17/2014
PROJECT NUMBER: ER STP 0187(II)	DRAWN BY: I. MAYNARD
FILE NAME: z13cl82frm.dgn	DESIGNED BY: I. MAYNARD
PROJECT LEADER: M. FOISY	CHECKED BY: M. FOISY
GUARDRAIL DETAIL SHEET 4	SHEET 14 OF 545