
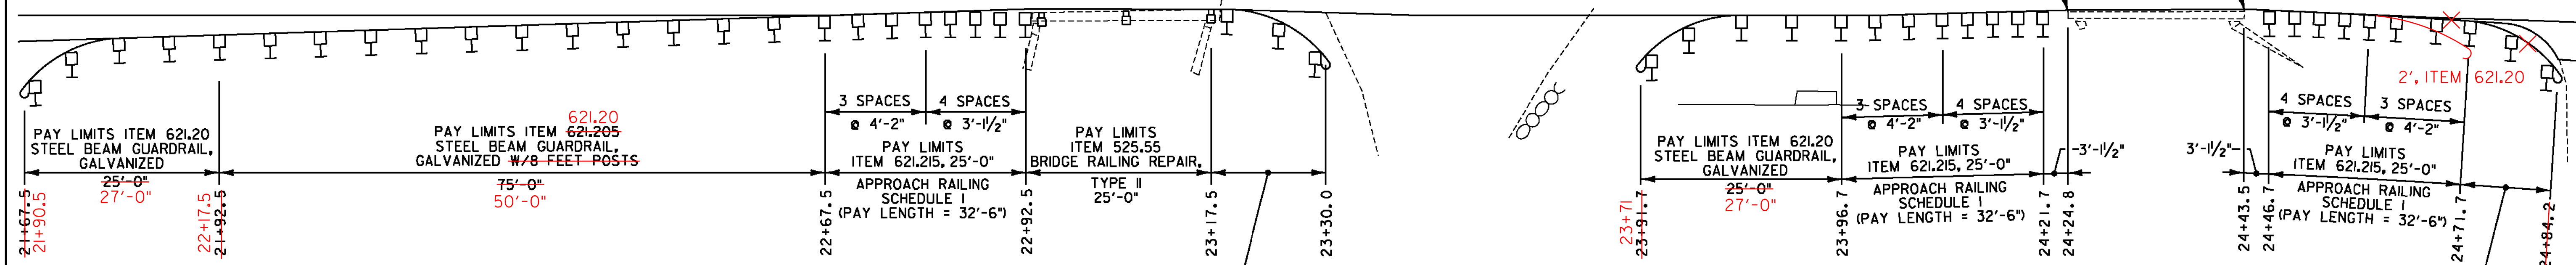
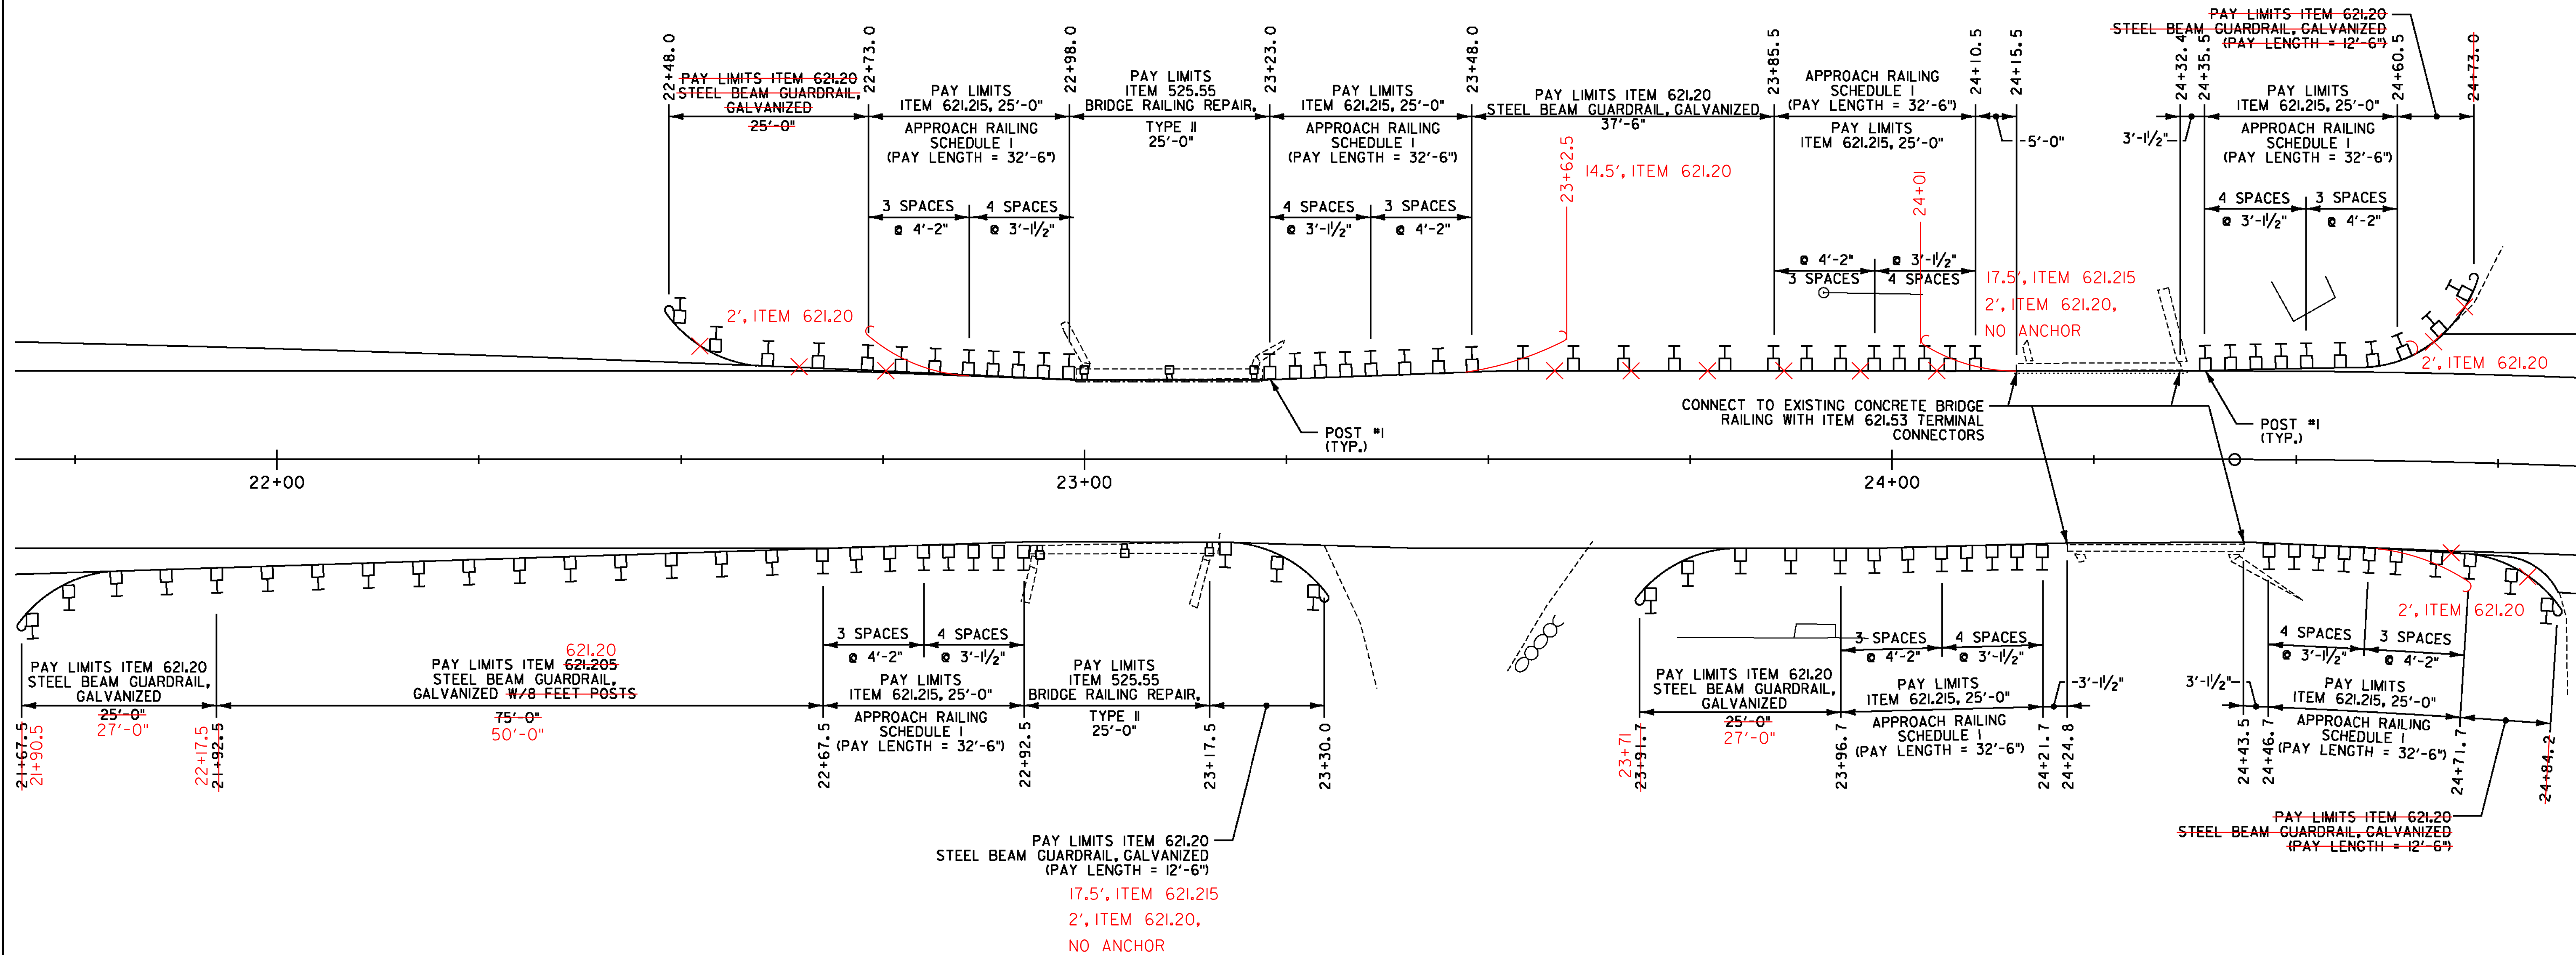


REMOVAL OF EXISTING BRIDGE RAILING
 STA. 22+92.5 TO 23+17.5, RT
 STA. 22+98.0 TO 23+23.0, LT

BRIDGE RAILING REPAIR, TYPE II
 STA. 22+92.5 TO 23+17.5, RT
 STA. 22+98.0 TO 23+23.0, LT

RAPID SETTING CONCRETE REPAIR MATERIAL WITH COARSE AGGREGATE
 STA. 22+95.2 TO 23+20.2

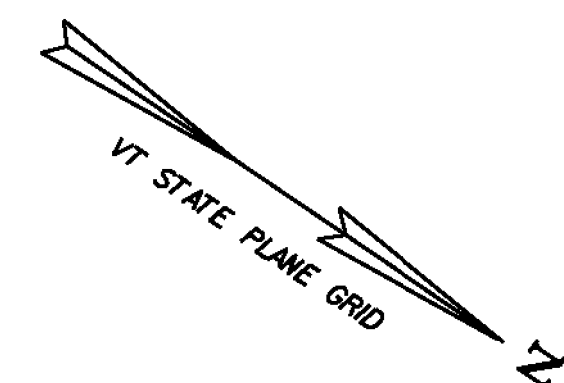

BR 12 GRANVILLE MM 0.441 = STA. 23+28
 BR 13 GRANVILLE MM 0.460 = STA. 24+29



PROJECT NAME: RANDOLPH-ROXBURY	PLOT DATE: 11/17/2014
PROJECT NUMBER: ER STP 0187(II)	DRAWN BY: I. MAYNARD
FILE NAME: z13c182frm.dgn	CHECKED BY: M. FOISY
PROJECT LEADER: M. FOISY	DESIGNED BY: I. MAYNARD
GUARDRAIL DETAIL SHEET 8	
SHEET 18 OF 545	